



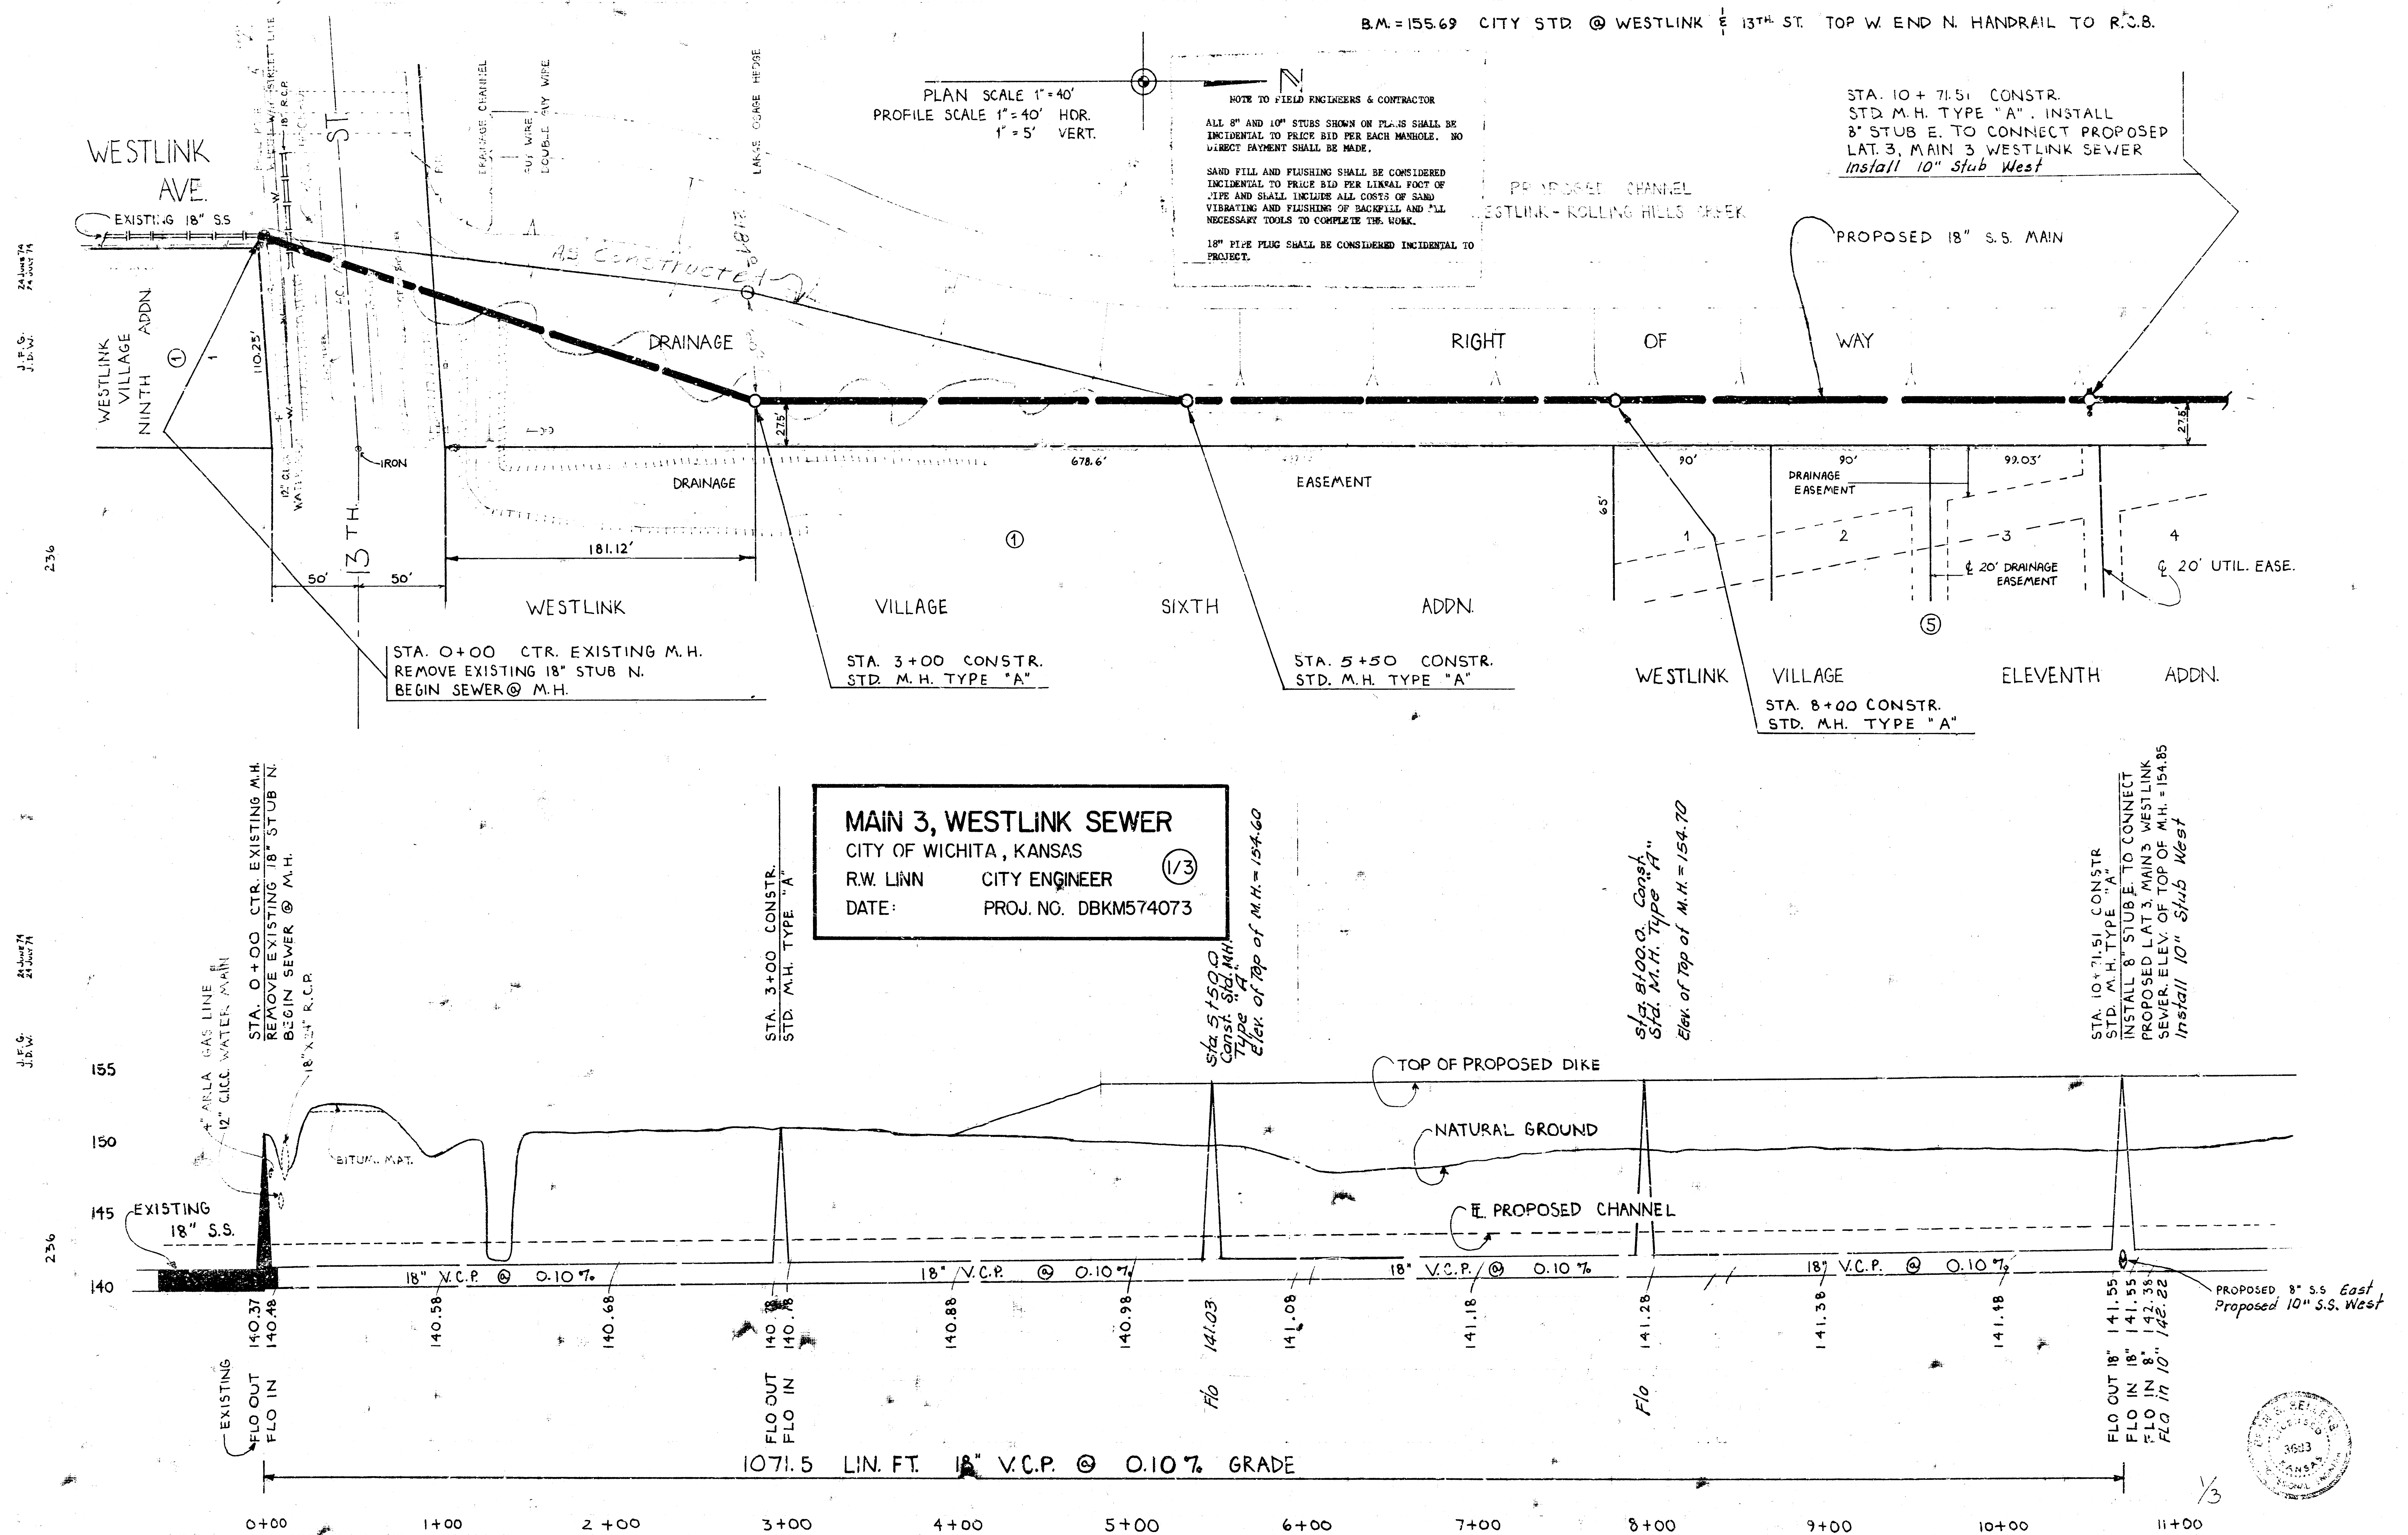

PLAN SCALE 1" = 40'
 PROFILE SCALE 1" = 40' HOR.
 1" = 5' VERT.



B.M. = 155.69 CITY STD @ WESTLINK E 13" TOP W. END N. HANDRAIL TO R.C.B.

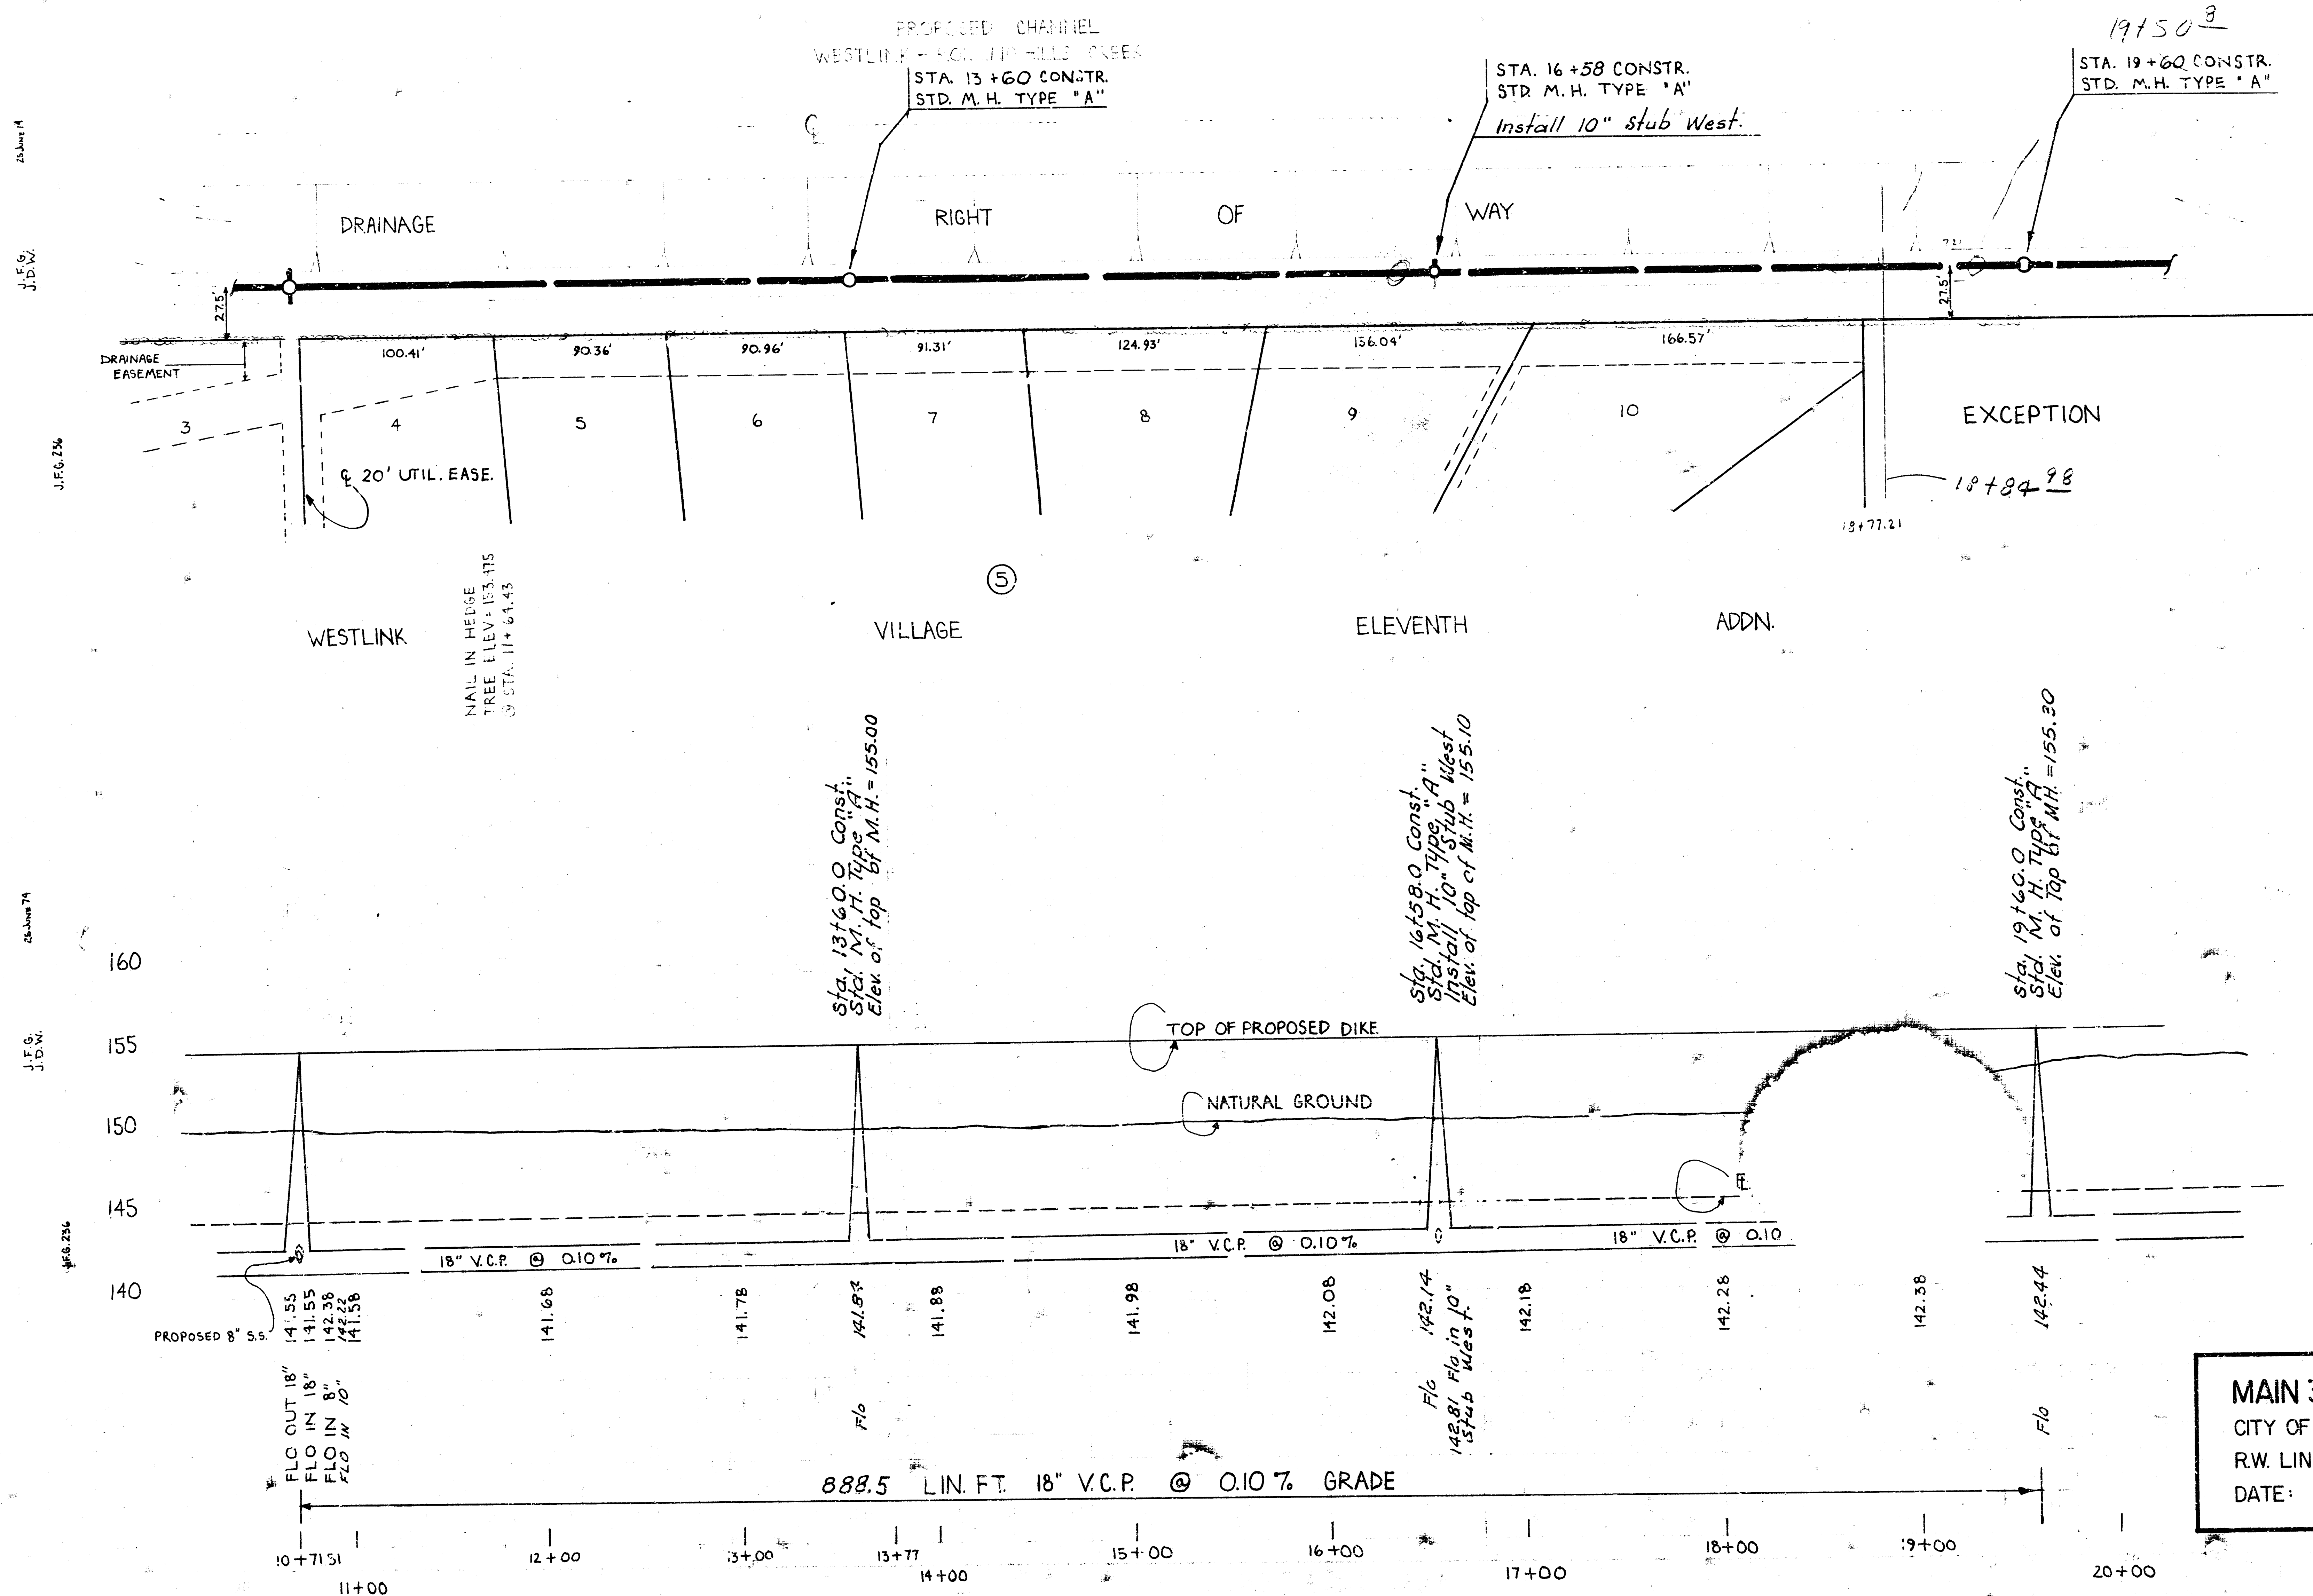

MAIN 3, WESTLINK SEWER
 CITY OF WICHITA, KANSAS
 R.W. LINN CITY ENGINEER
 PROJ. NO. DBKM574073

B.M. = 155.69 CITY STR @ WESTLINK @ 13TH ST. TOP W. END N. HANDRAIL TO R.C.B.

PLAN SCALE 1" = 40'
 PROFILE SCALE 1" = 40' HOR.
 1" = 5' VERT.

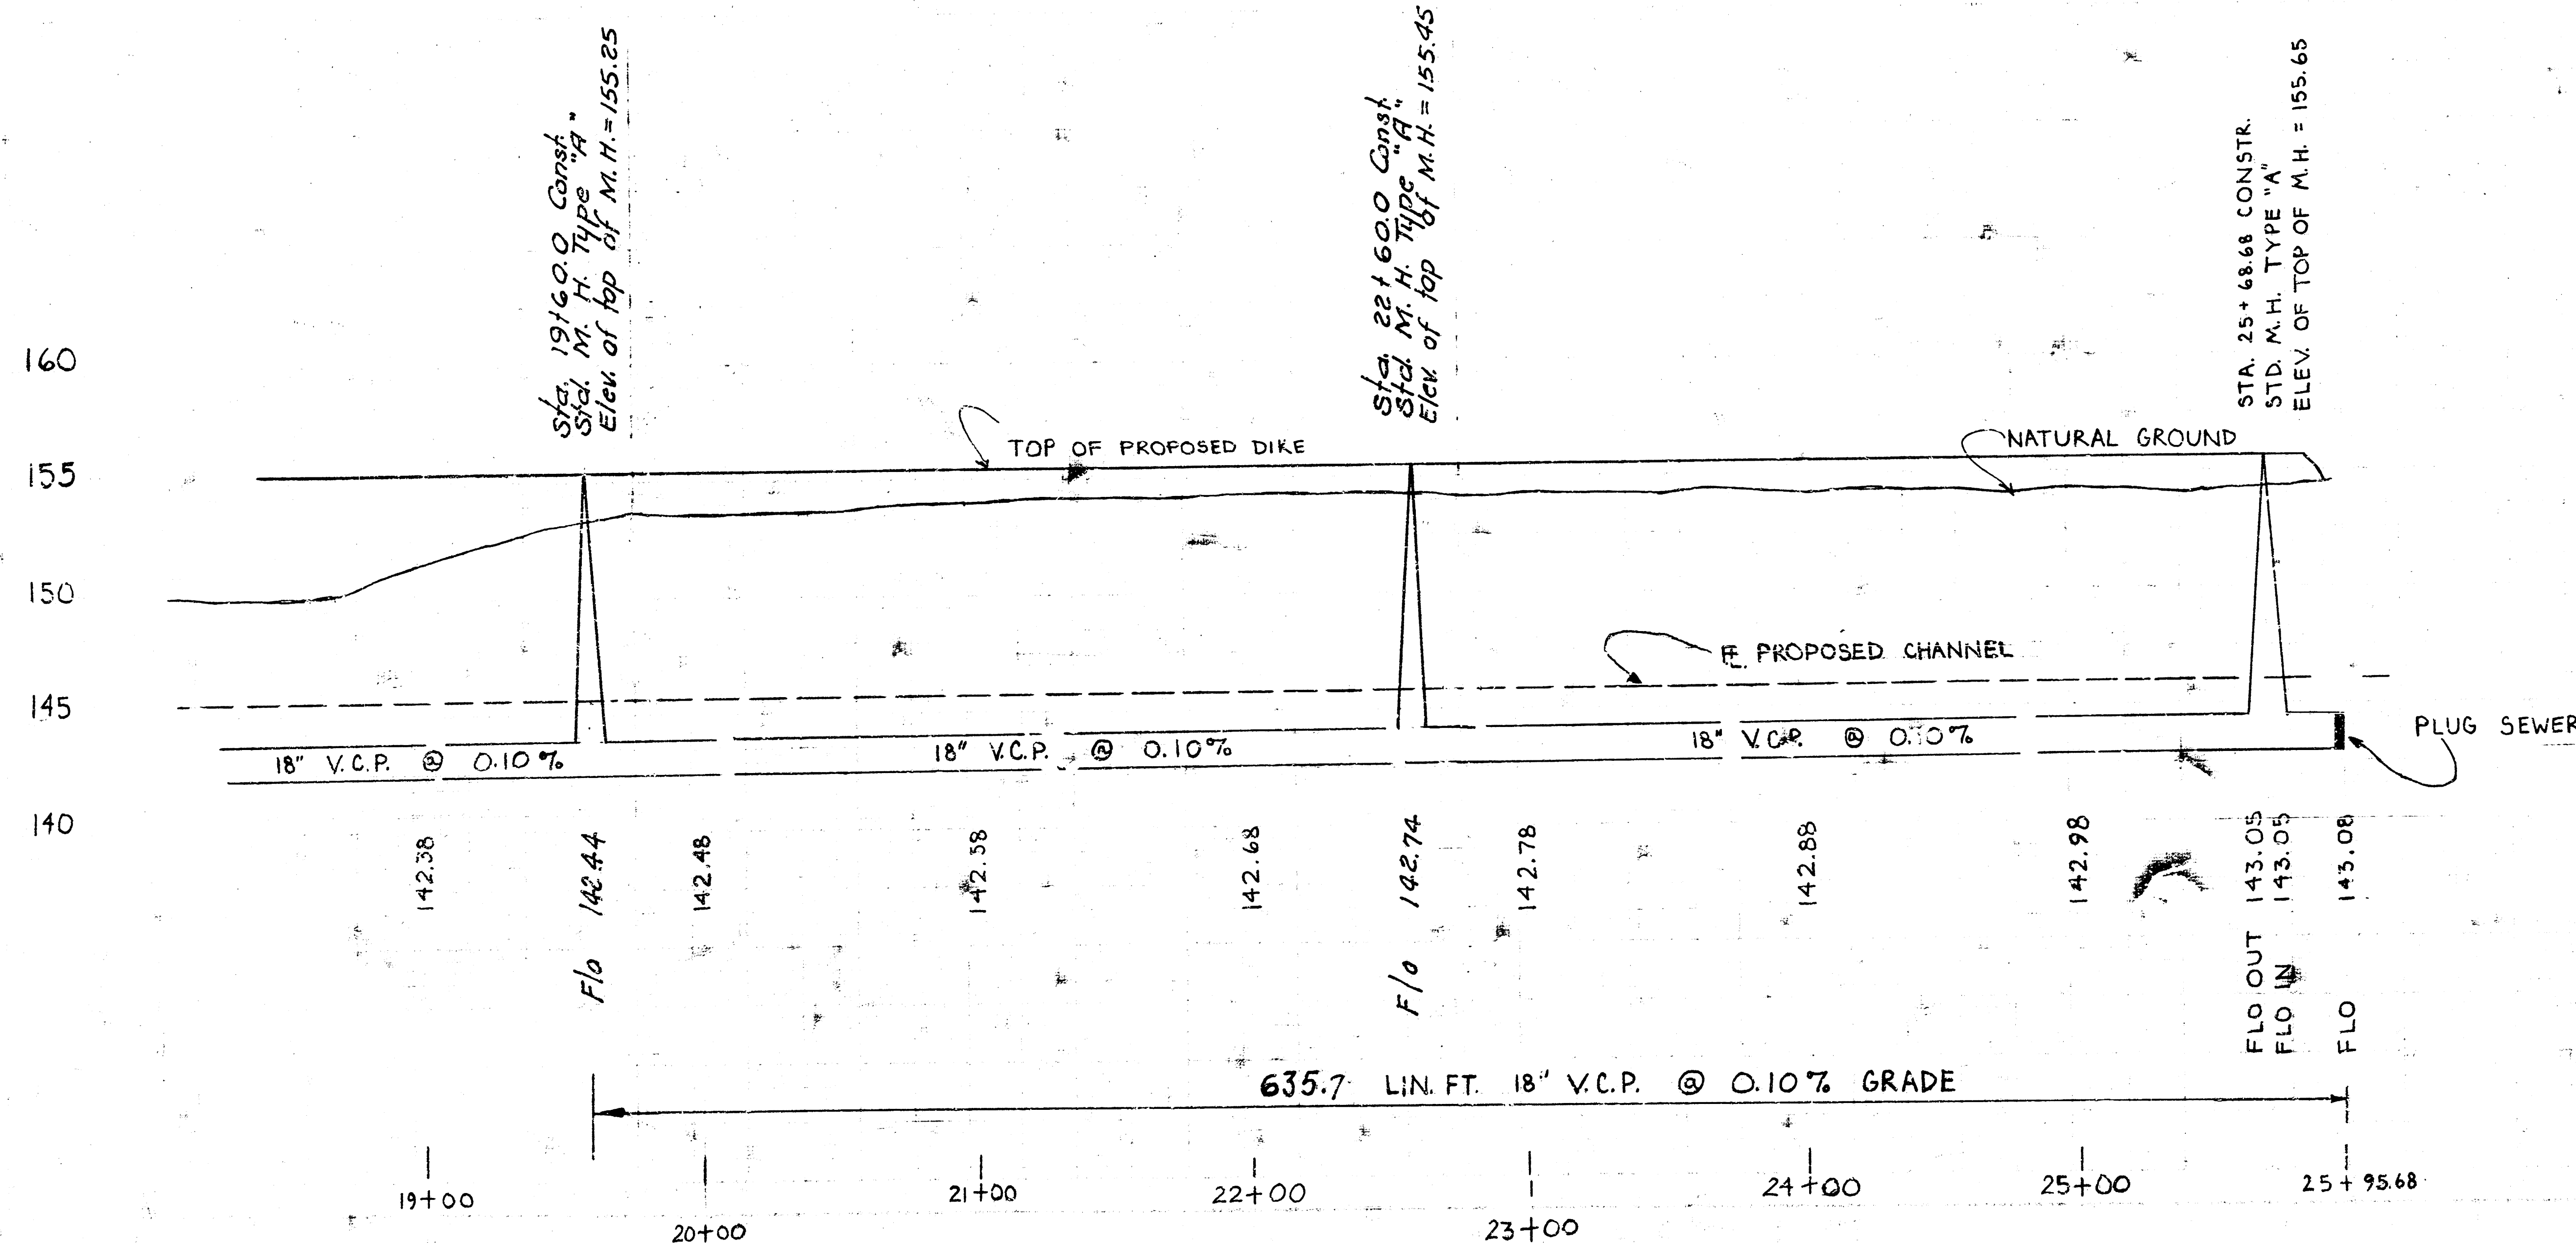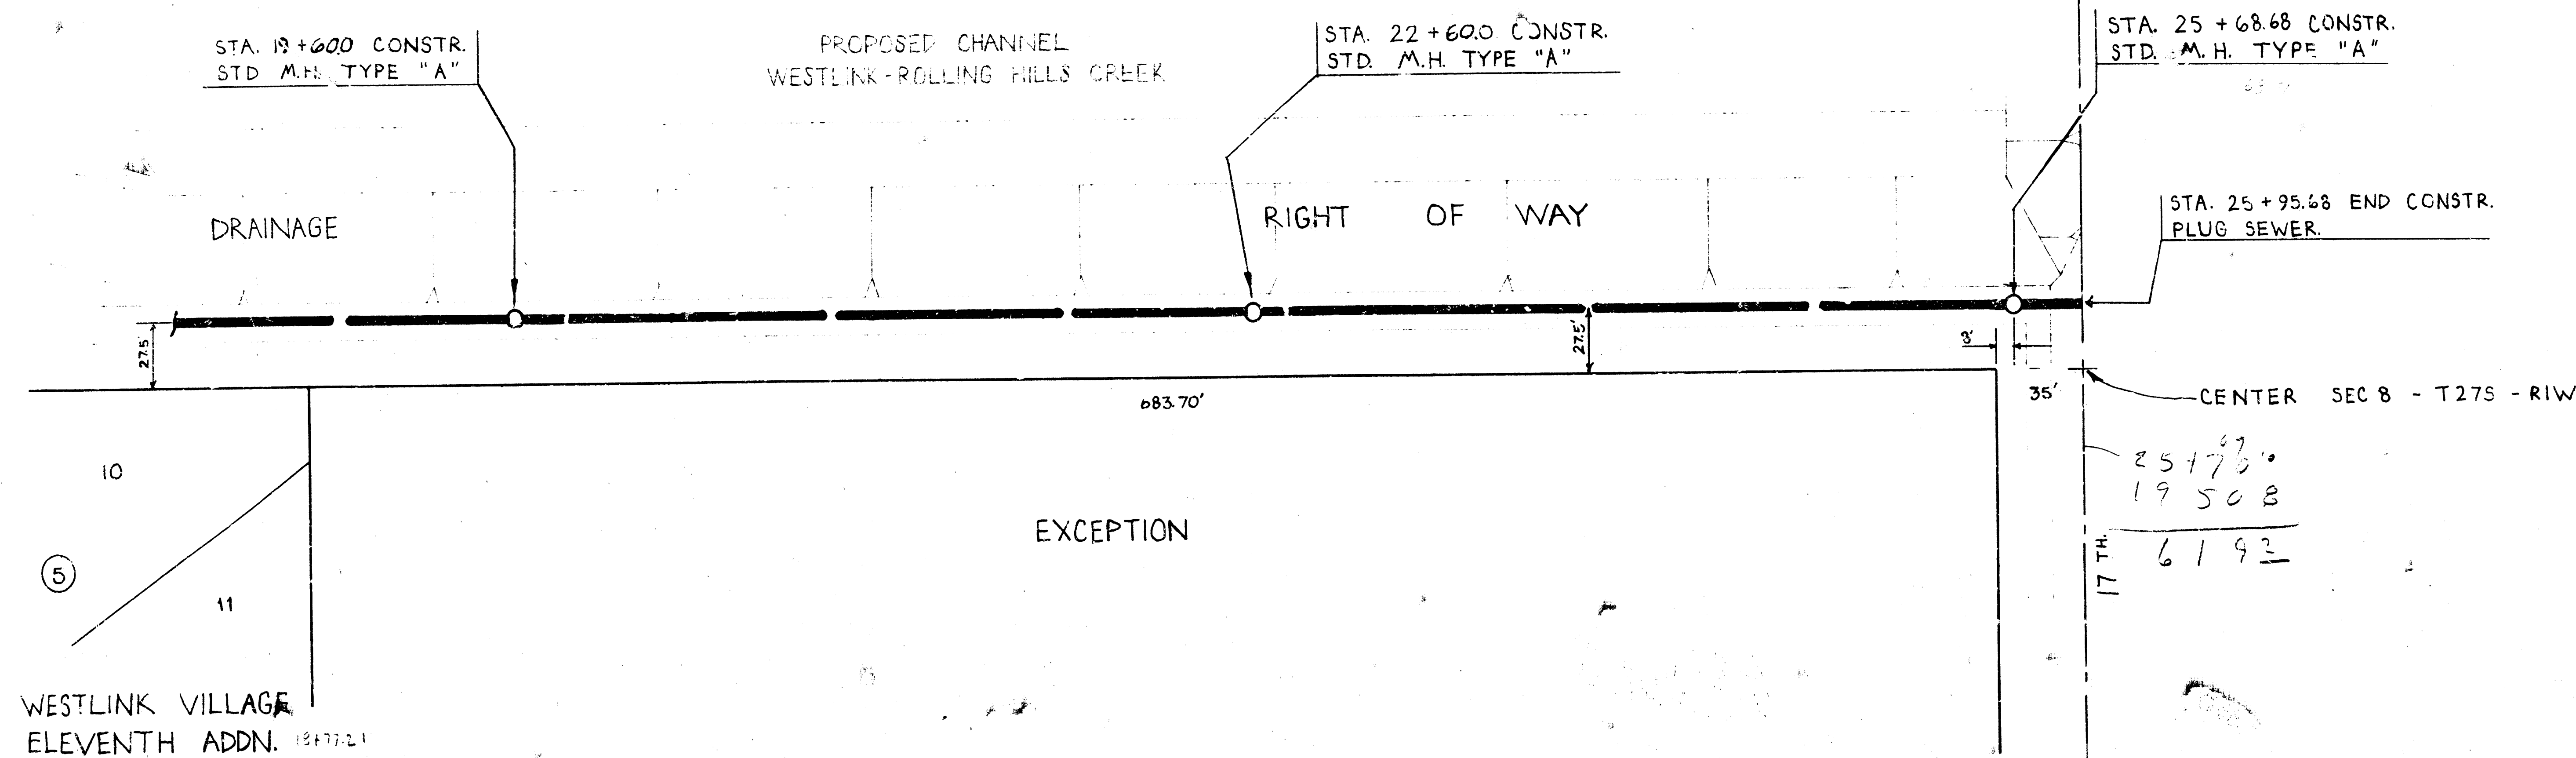

MAIN 3, WESTLINK SEWER
 CITY OF WICHITA, KANSAS 3/3
 R.W. LINN CITY ENGINEER
 DATE: PROJ. NO. DBKM574073