



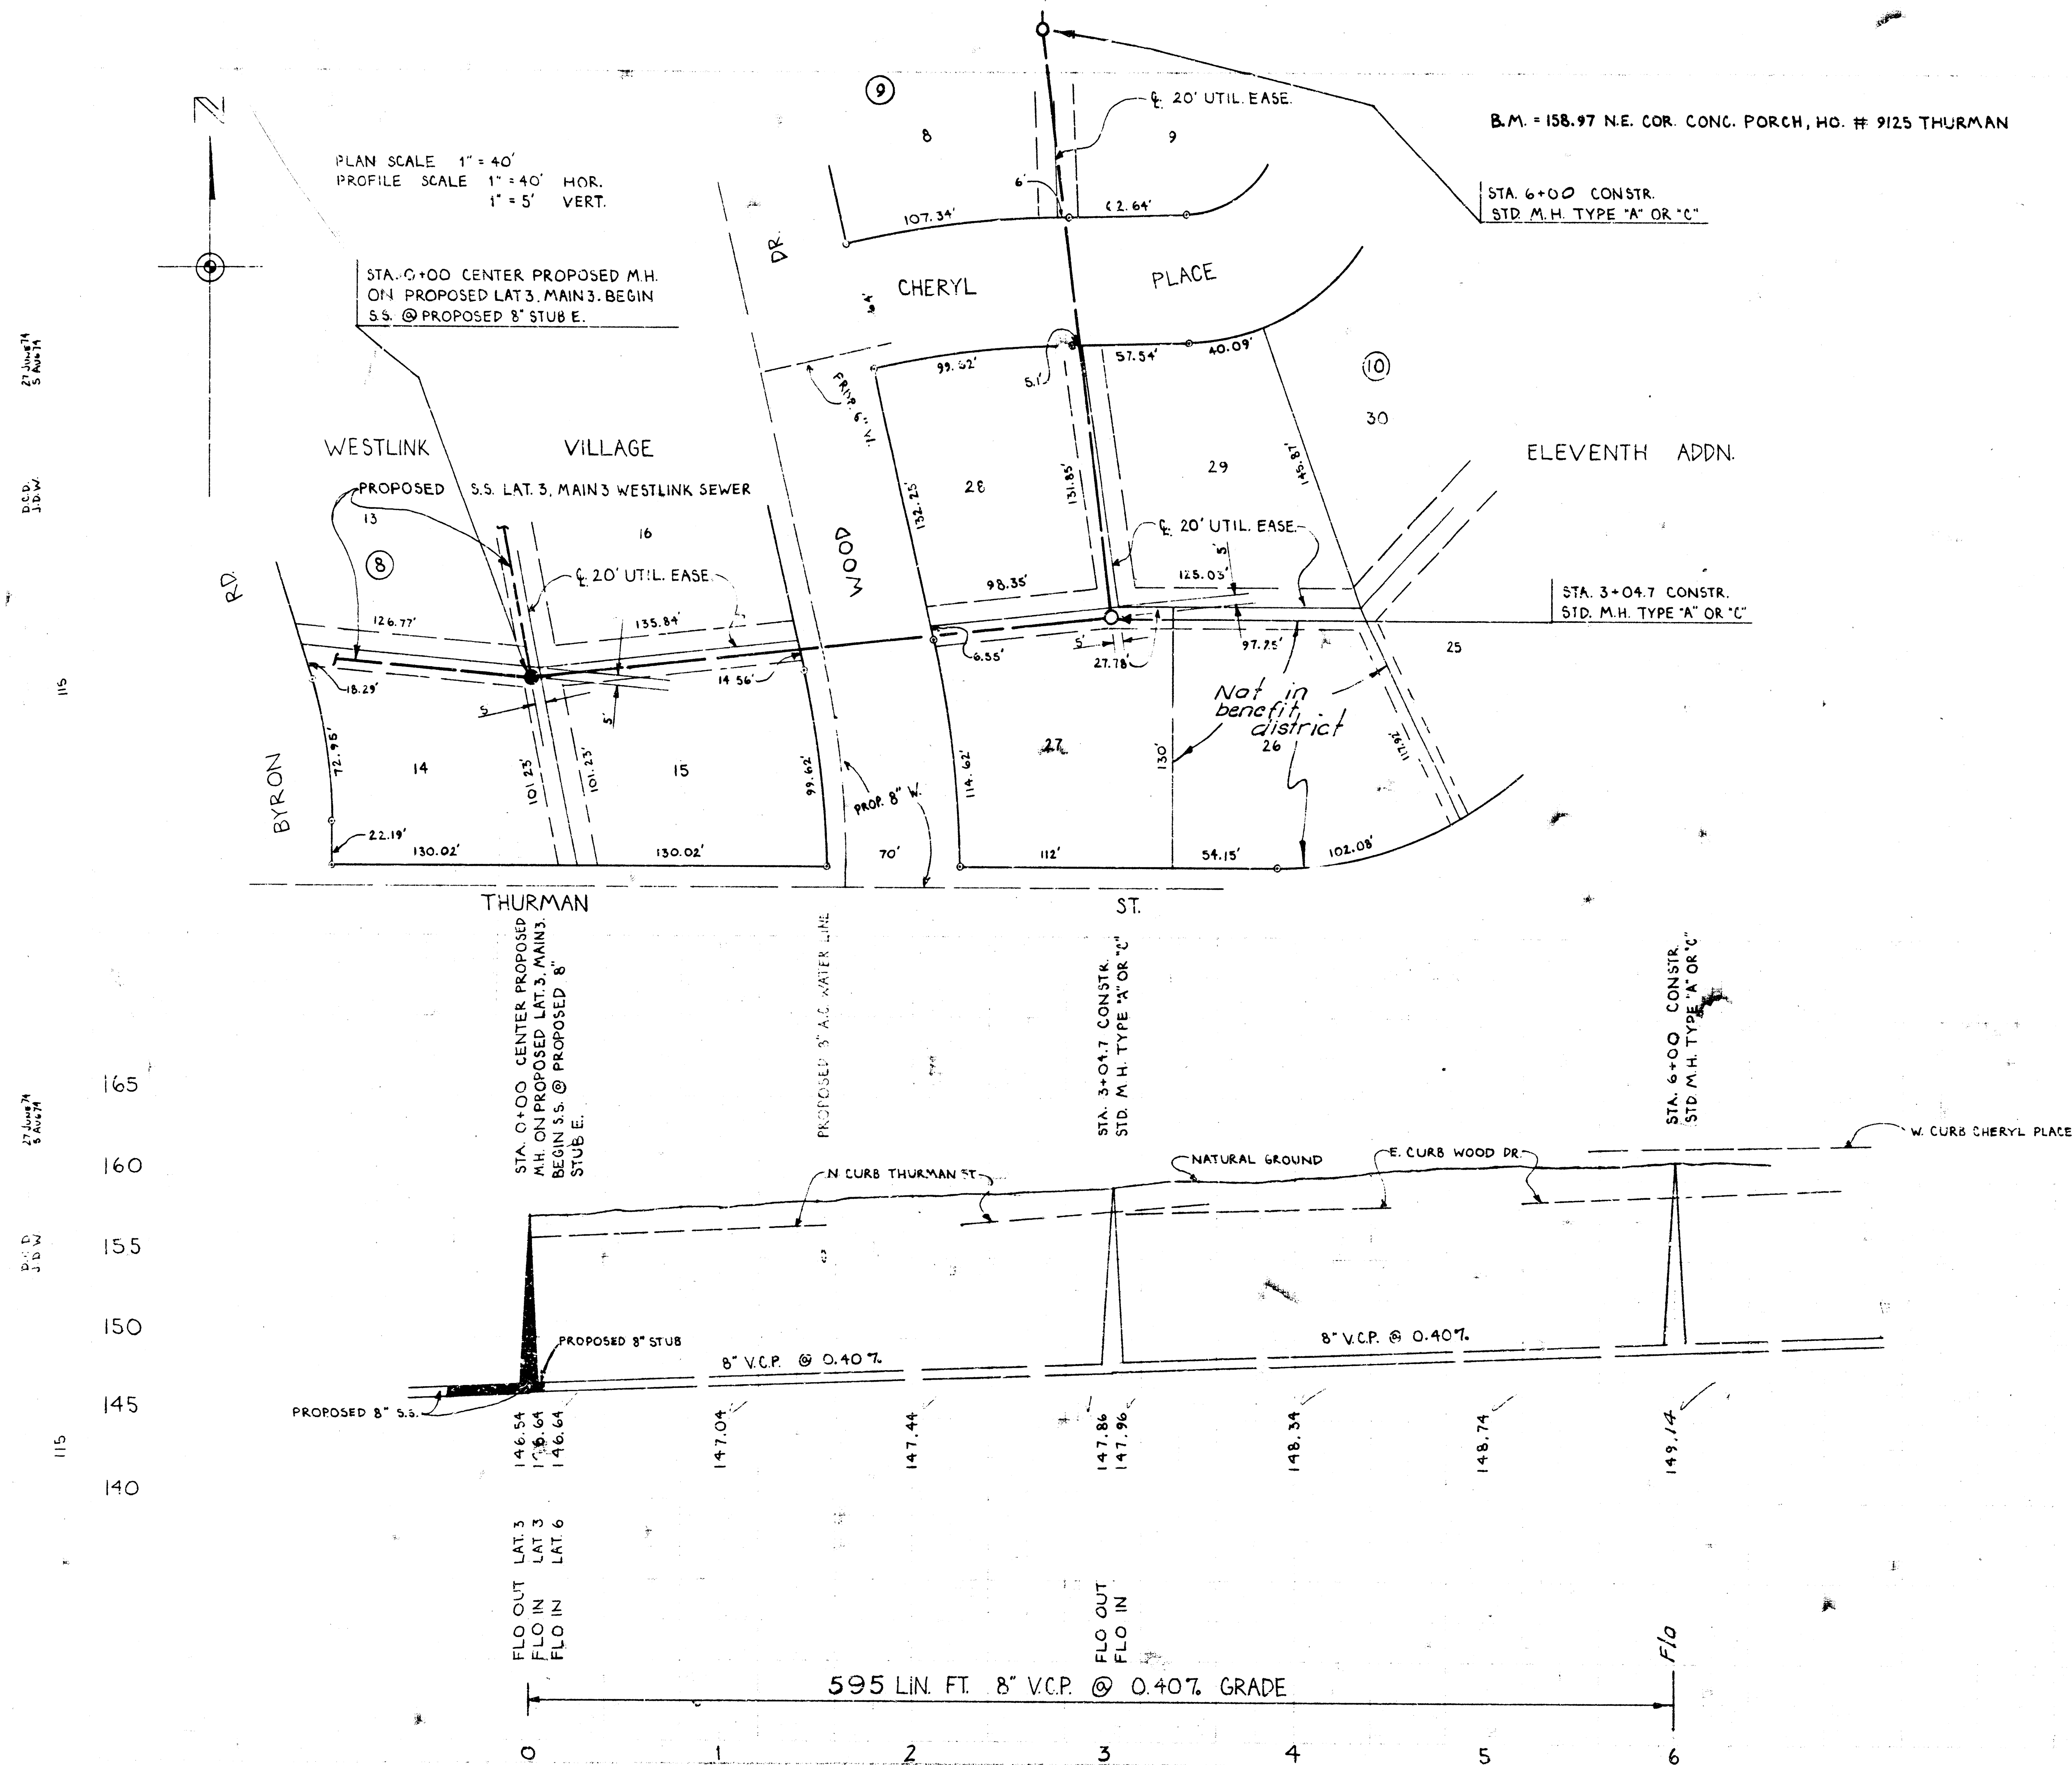

LAT. 6, MAIN 3, WESTLINK SEWER
 CITY OF WICHITA, KANSAS
 R.W. LINN CITY ENGINEER
 DATE: PROJ. NO. DBKL574030

B.M. = 158.97 N.E. COR. CONC. PORCH, HC. # 9125 THURMAN

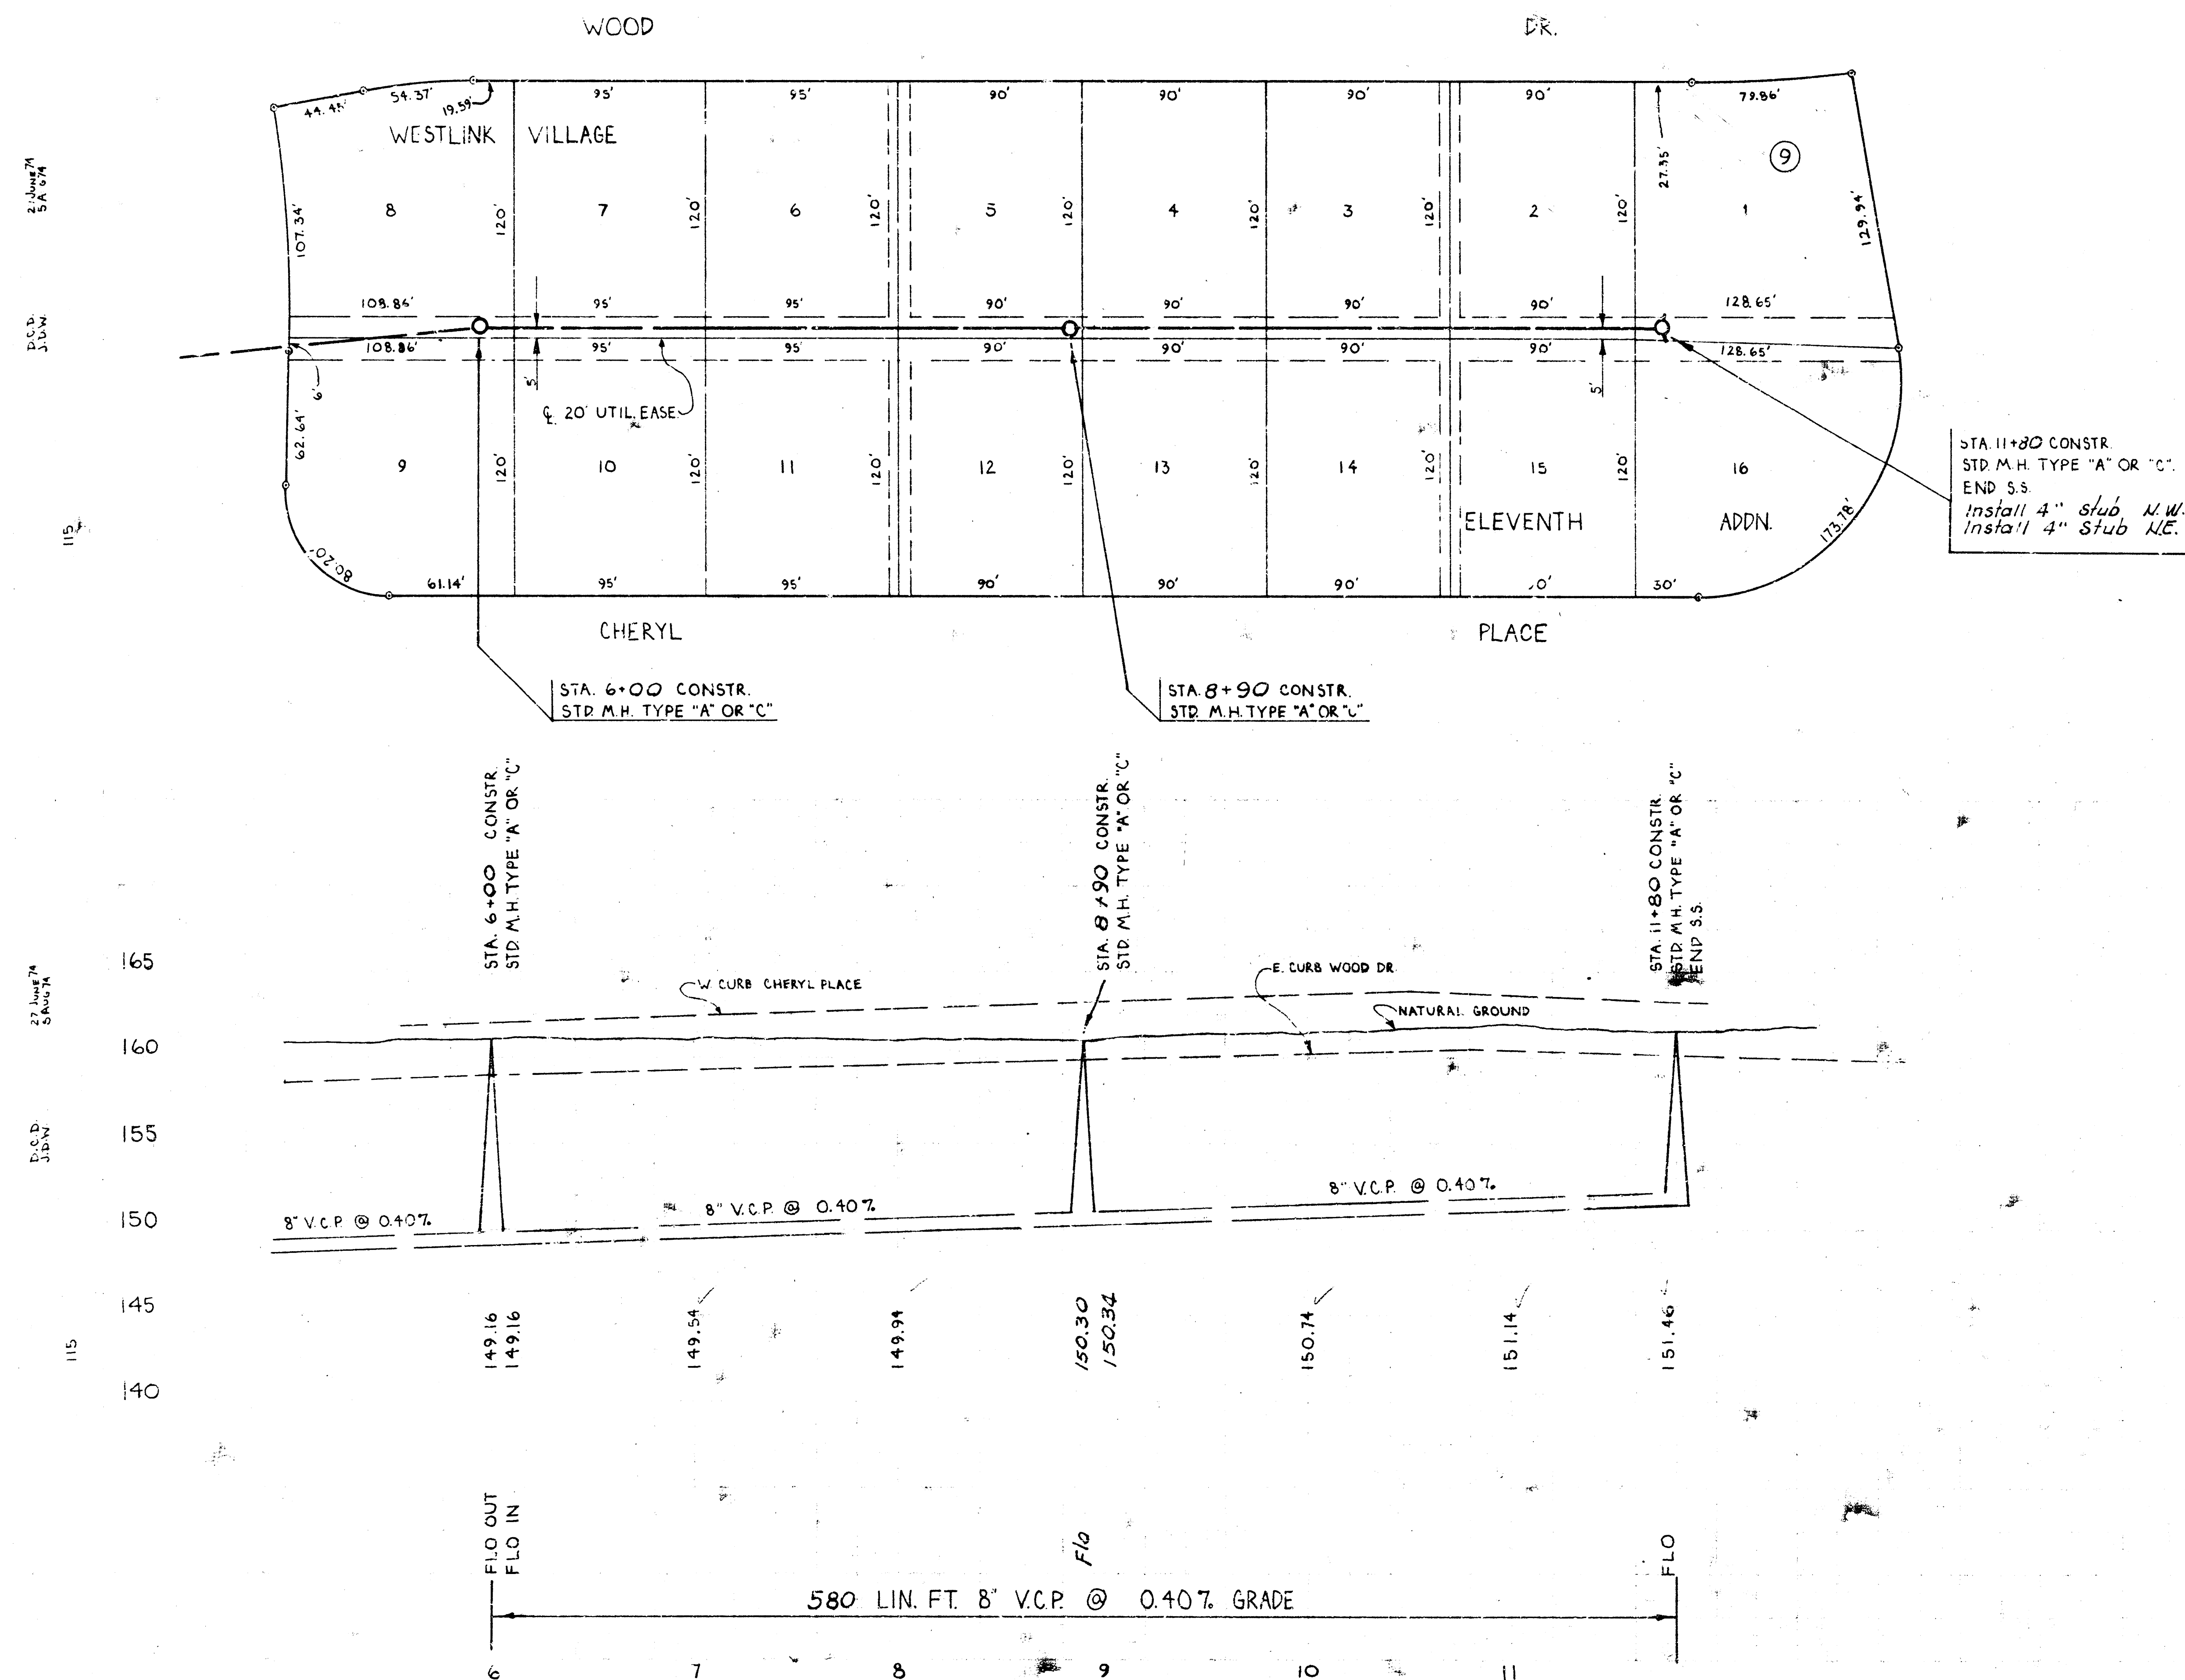

LAT. 6, MAIN 3, WESTLINK SEWER
CITY OF WICHITA, KANSAS
R.W. LINN CITY ENGINEER
DATE: PROJ. NO. DBKL574030