




BM 155.90 "a" cut top East curb of Westfield 10' South of S.L. Wood Drive
 BM 172.48 City Std. at Tyler & 17th St. North 36' East of 31' South of
 NE corner SE 1/4 Sec. 8-27-1W.

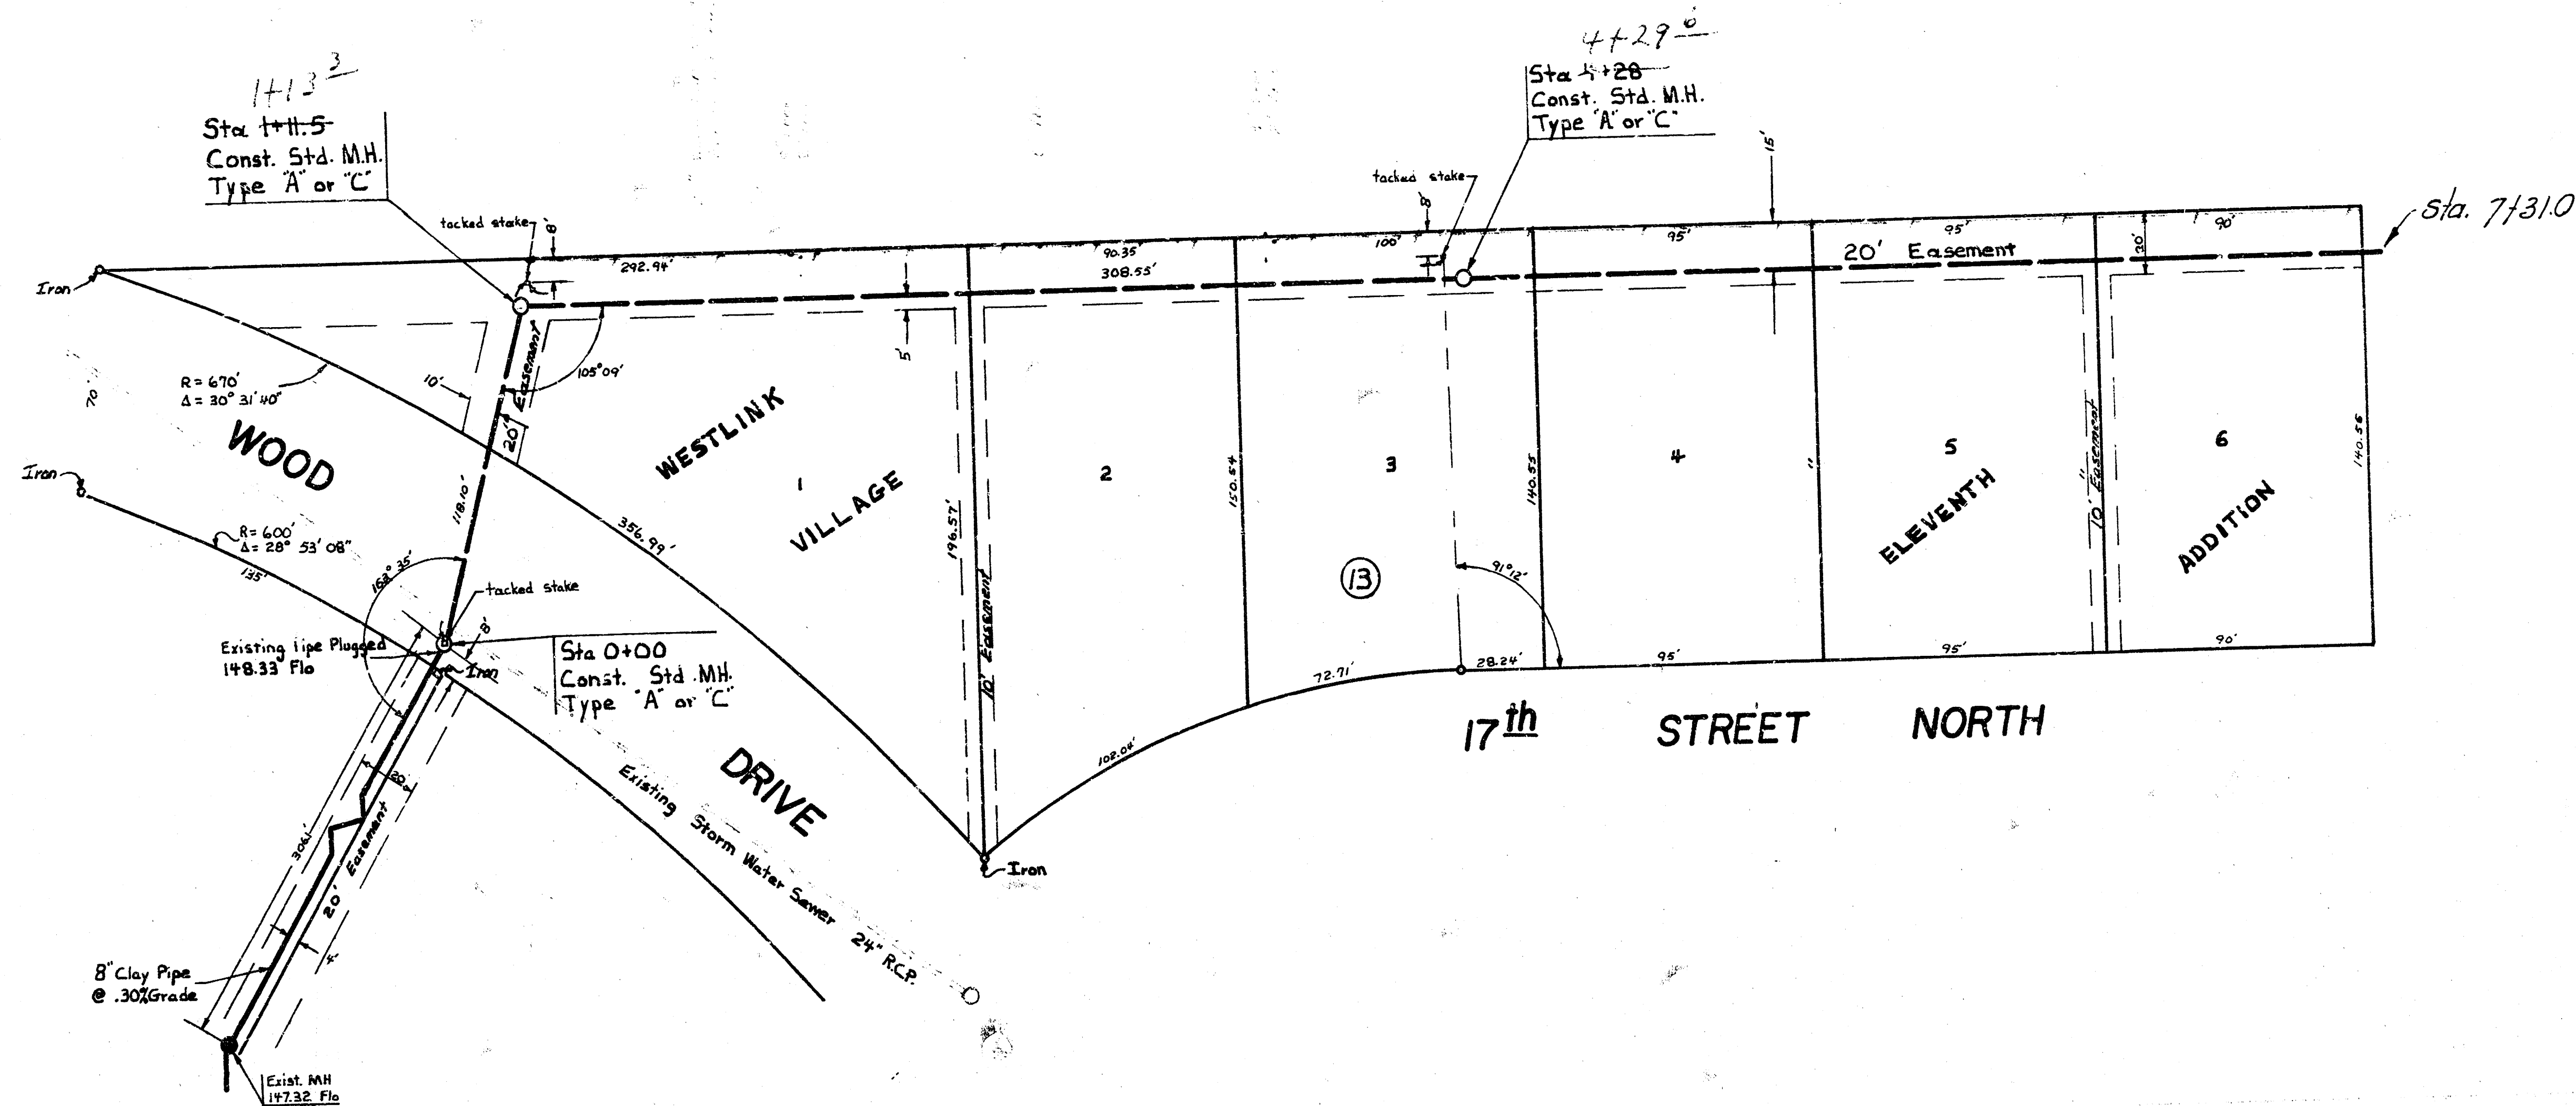


Plan Scale 1" = 40'
 Profile Scale 1" = 40' Horiz.
 1" = 5' Vert.

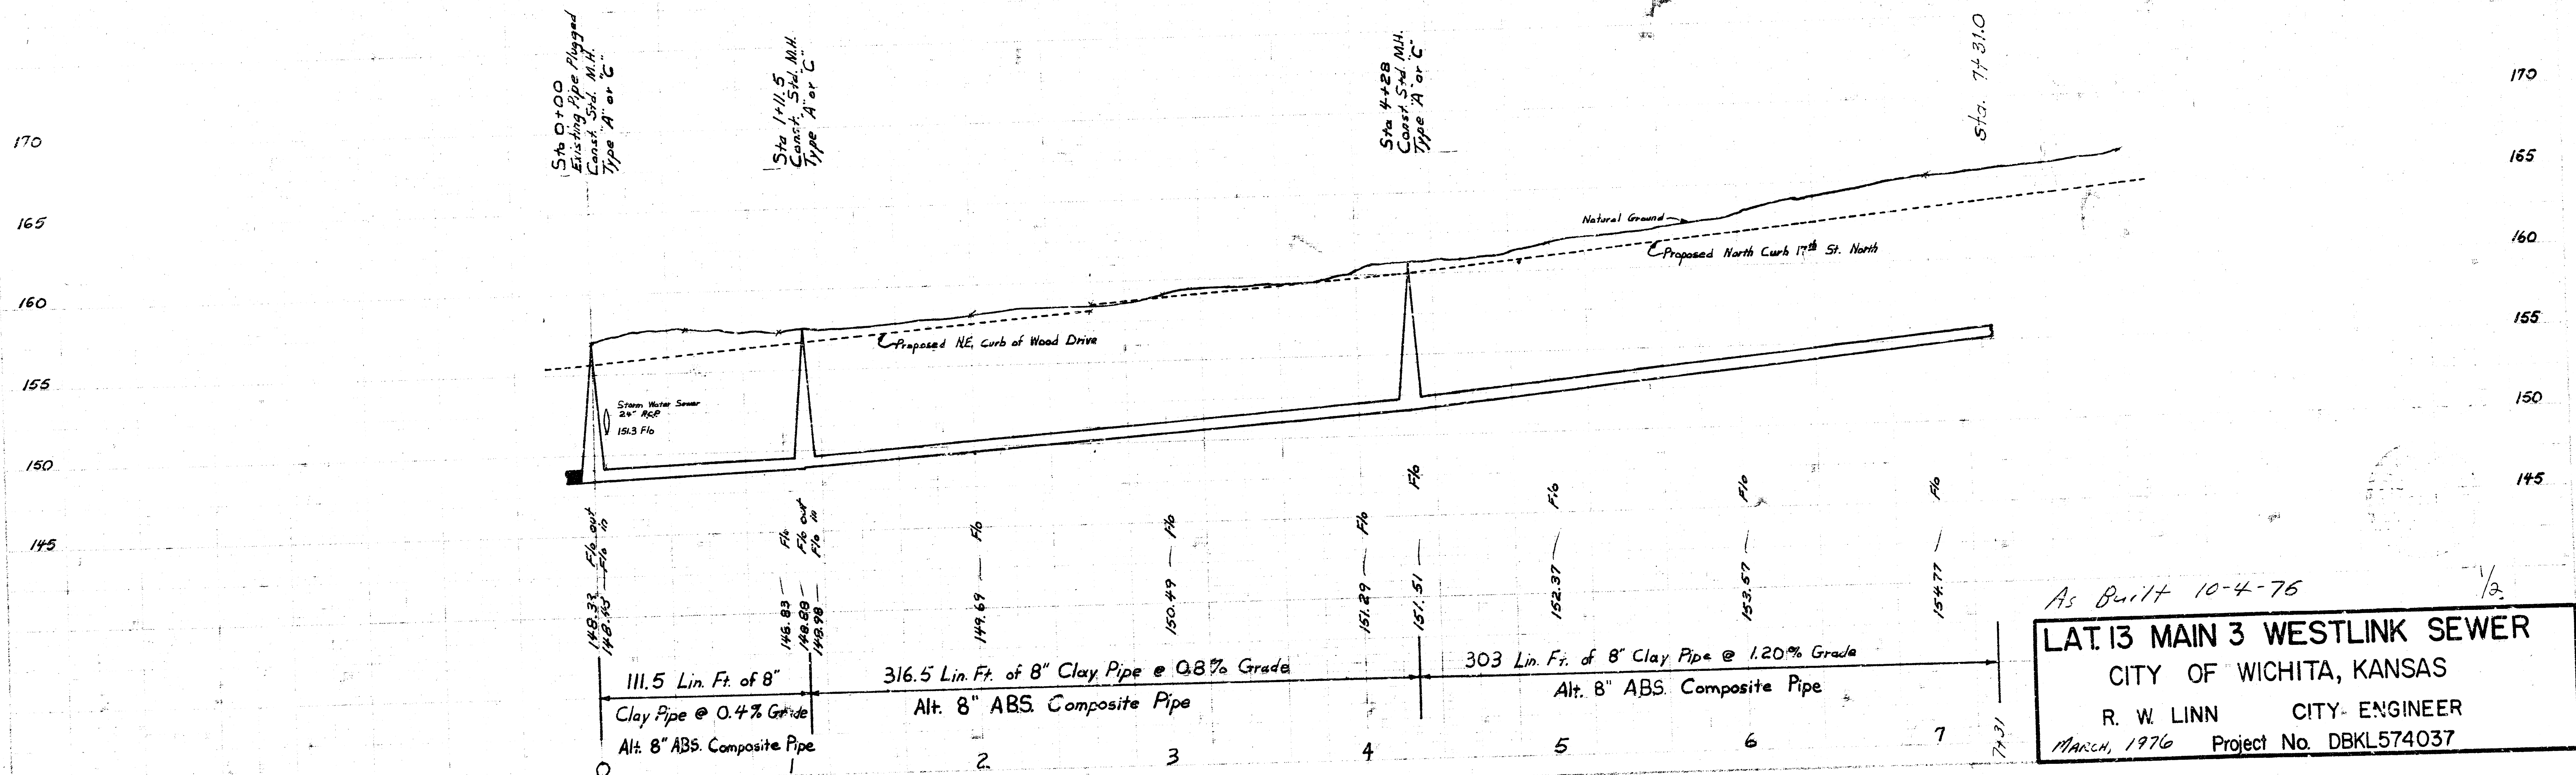

BM 155.90 "a" cut top East curb of Westfield 10' South of S.L. Wood Drive

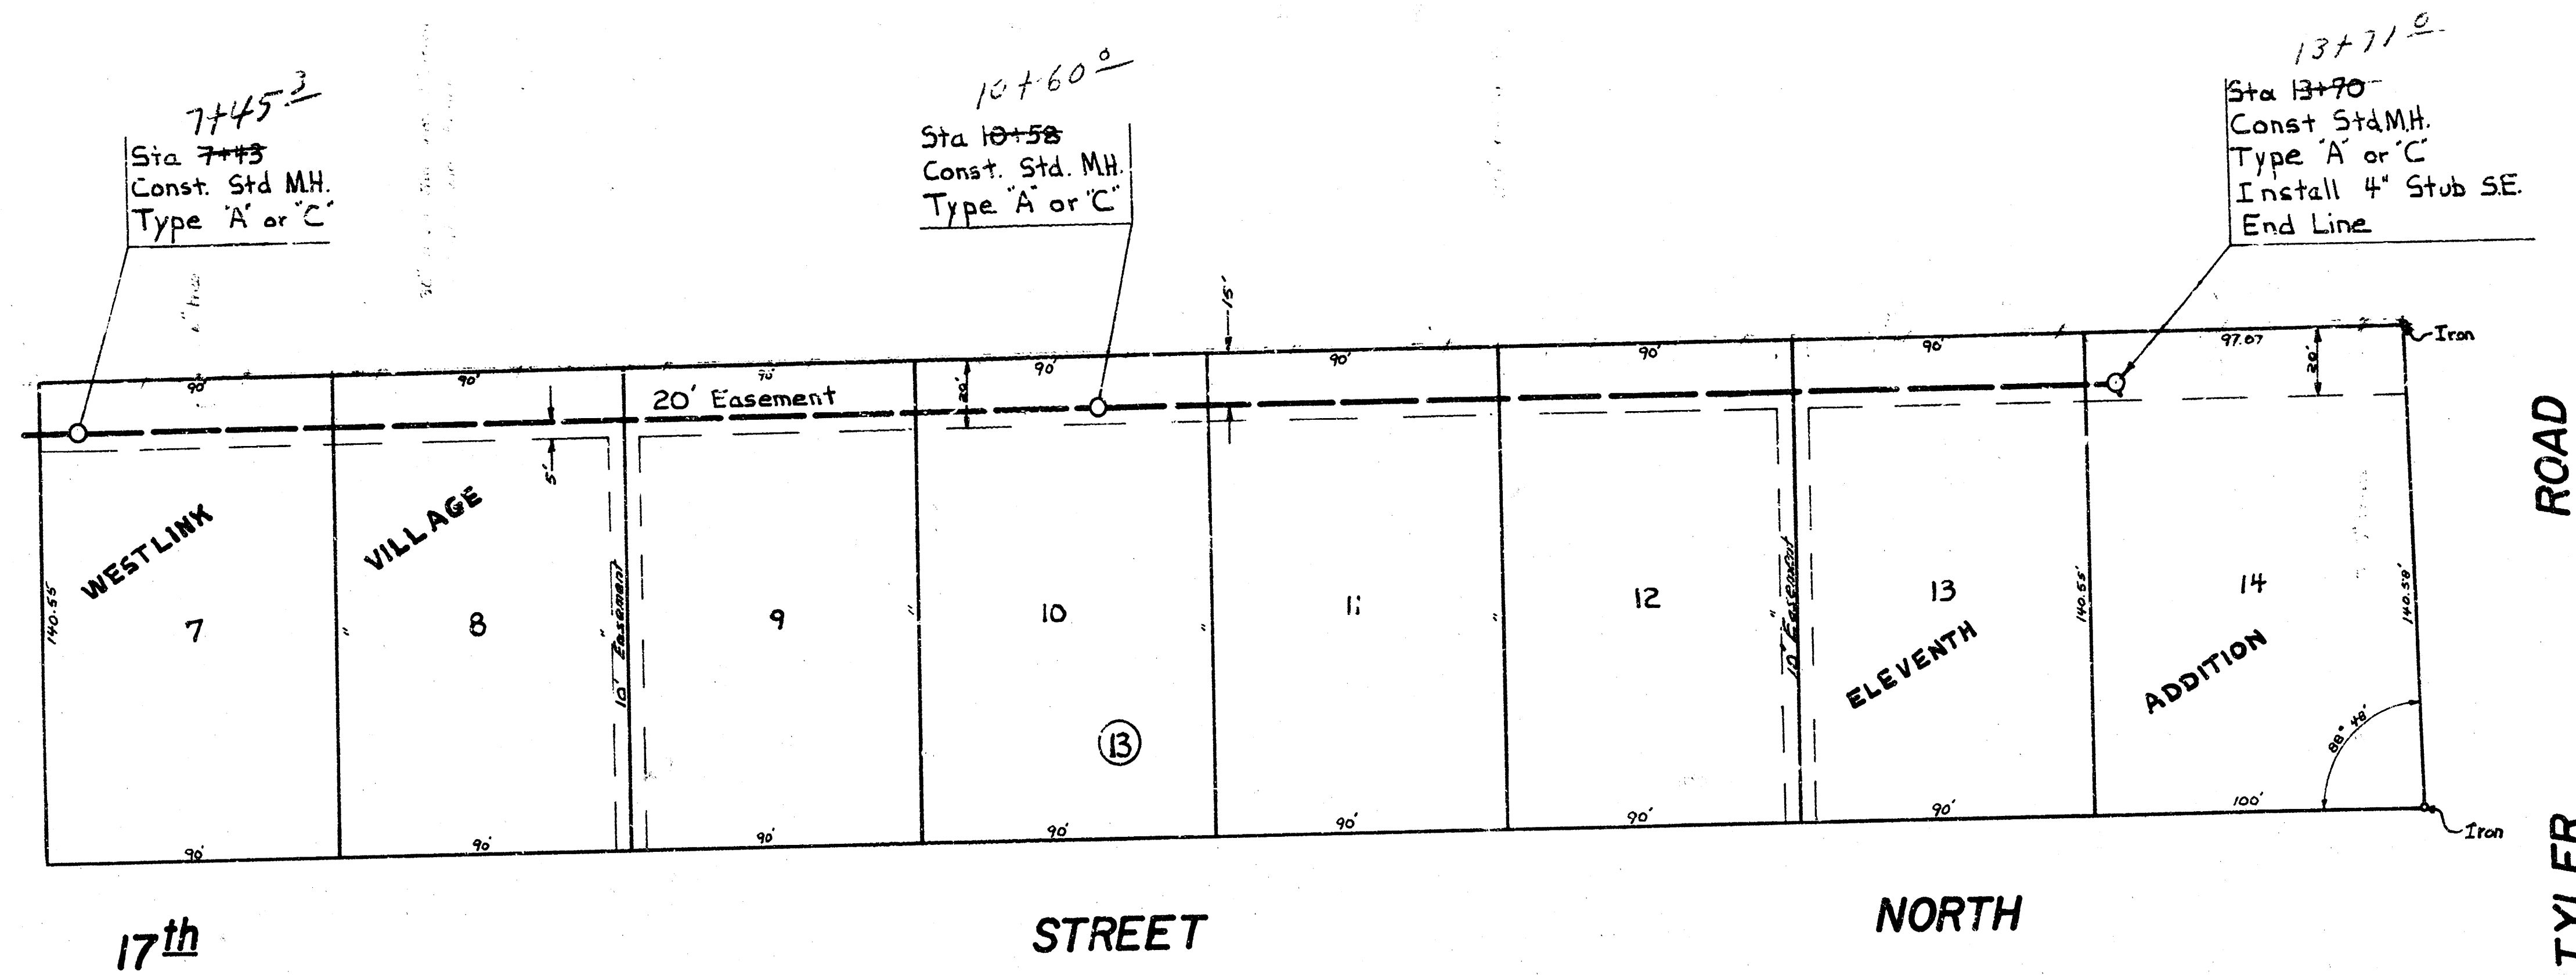

Plan Scale 1" = 40'
 Profile Scale 1" = 40' Horz.
 1" = 5' Vert.

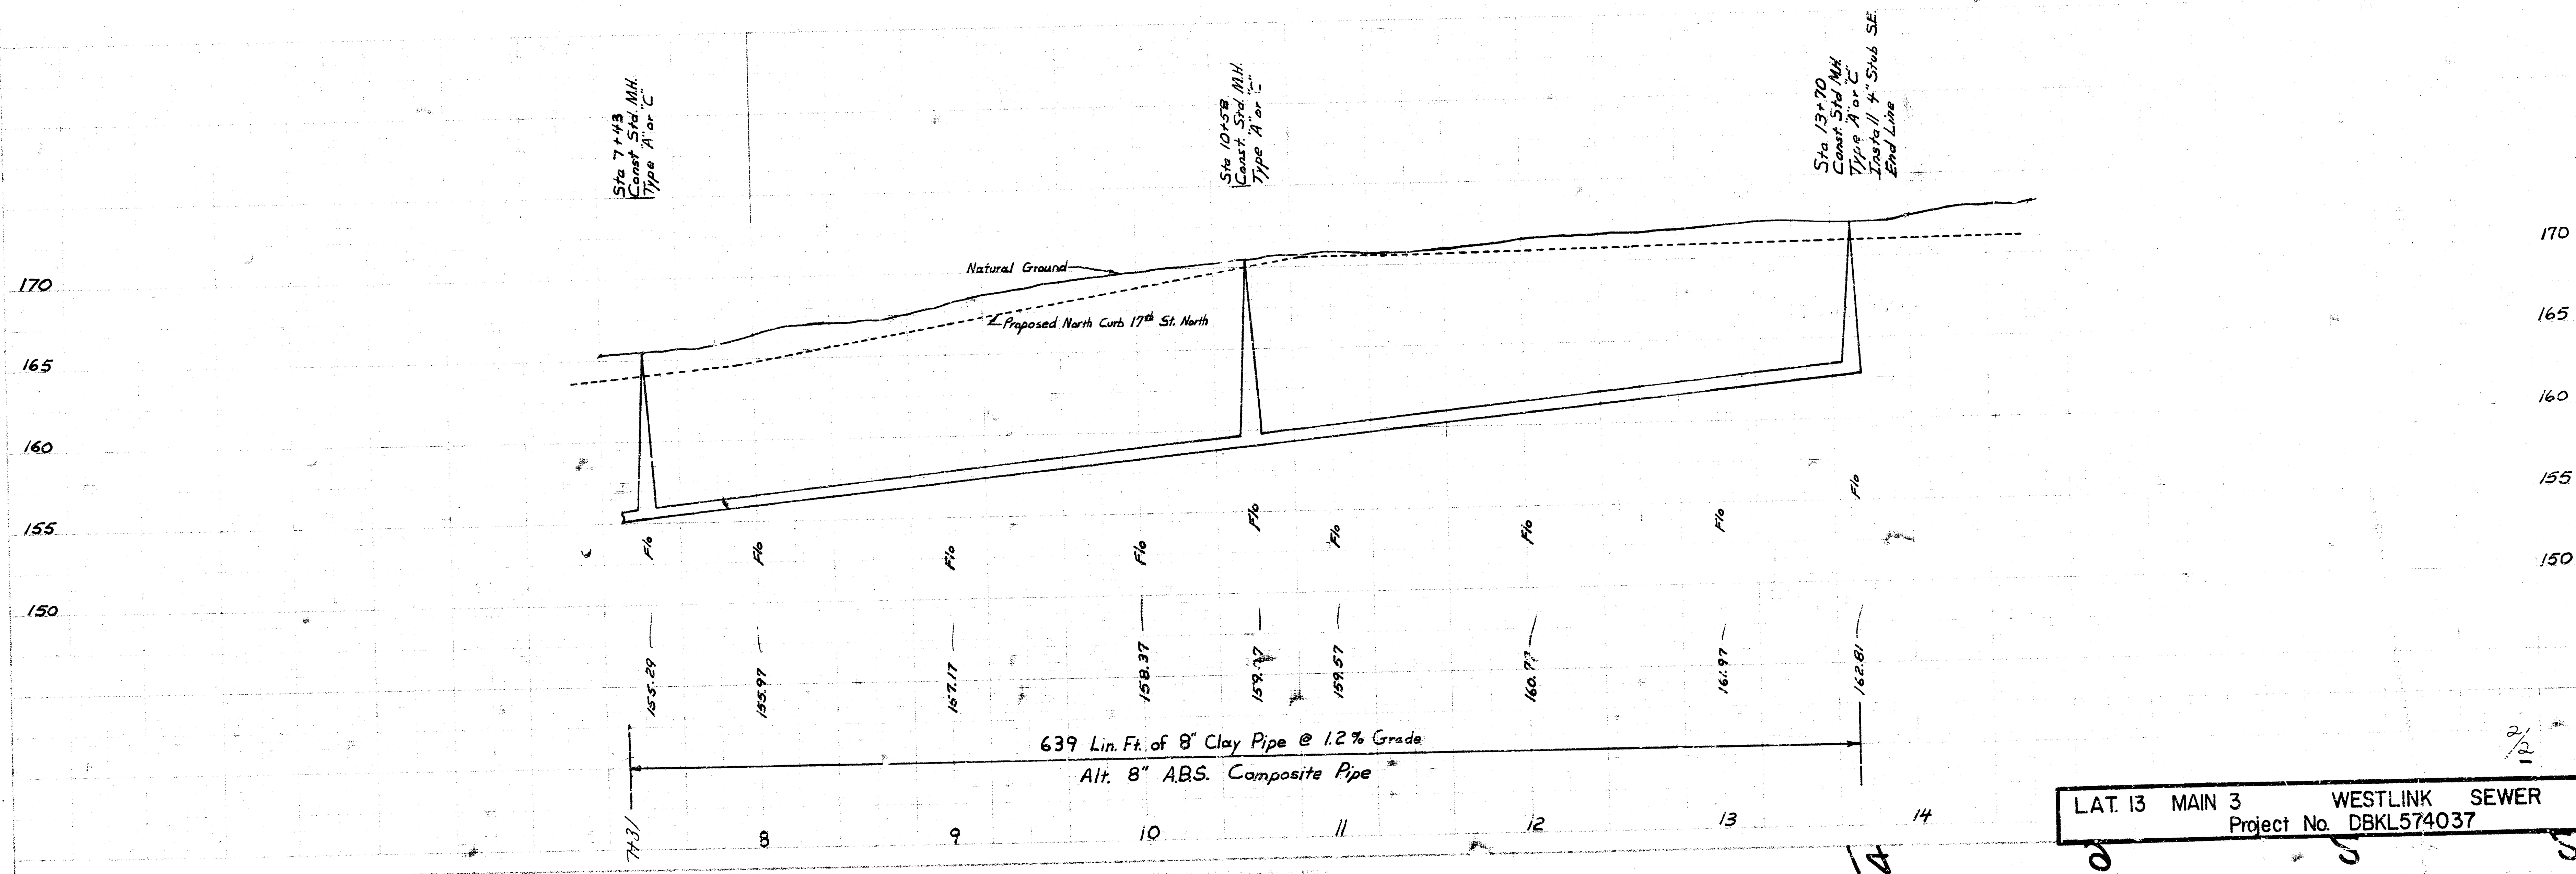

LAT. 13 MAIN 3 WESTLINK SEWER
 Project No. DBKL574037