



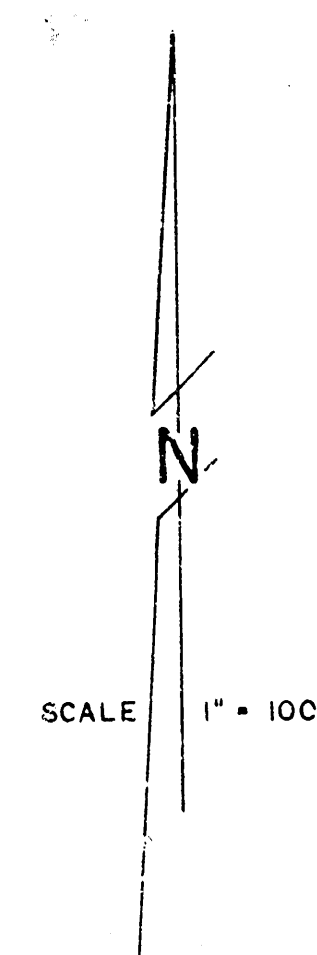


City of WICHITA, KANSAS Dean Sellers — City Engineer

Project No. 468-76-245-80206-000-000-001

Date : _____

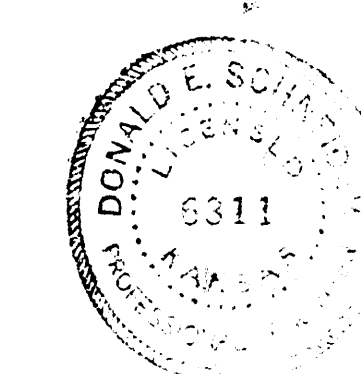


5806 JONATHAN ROAD 10 19
W3/11

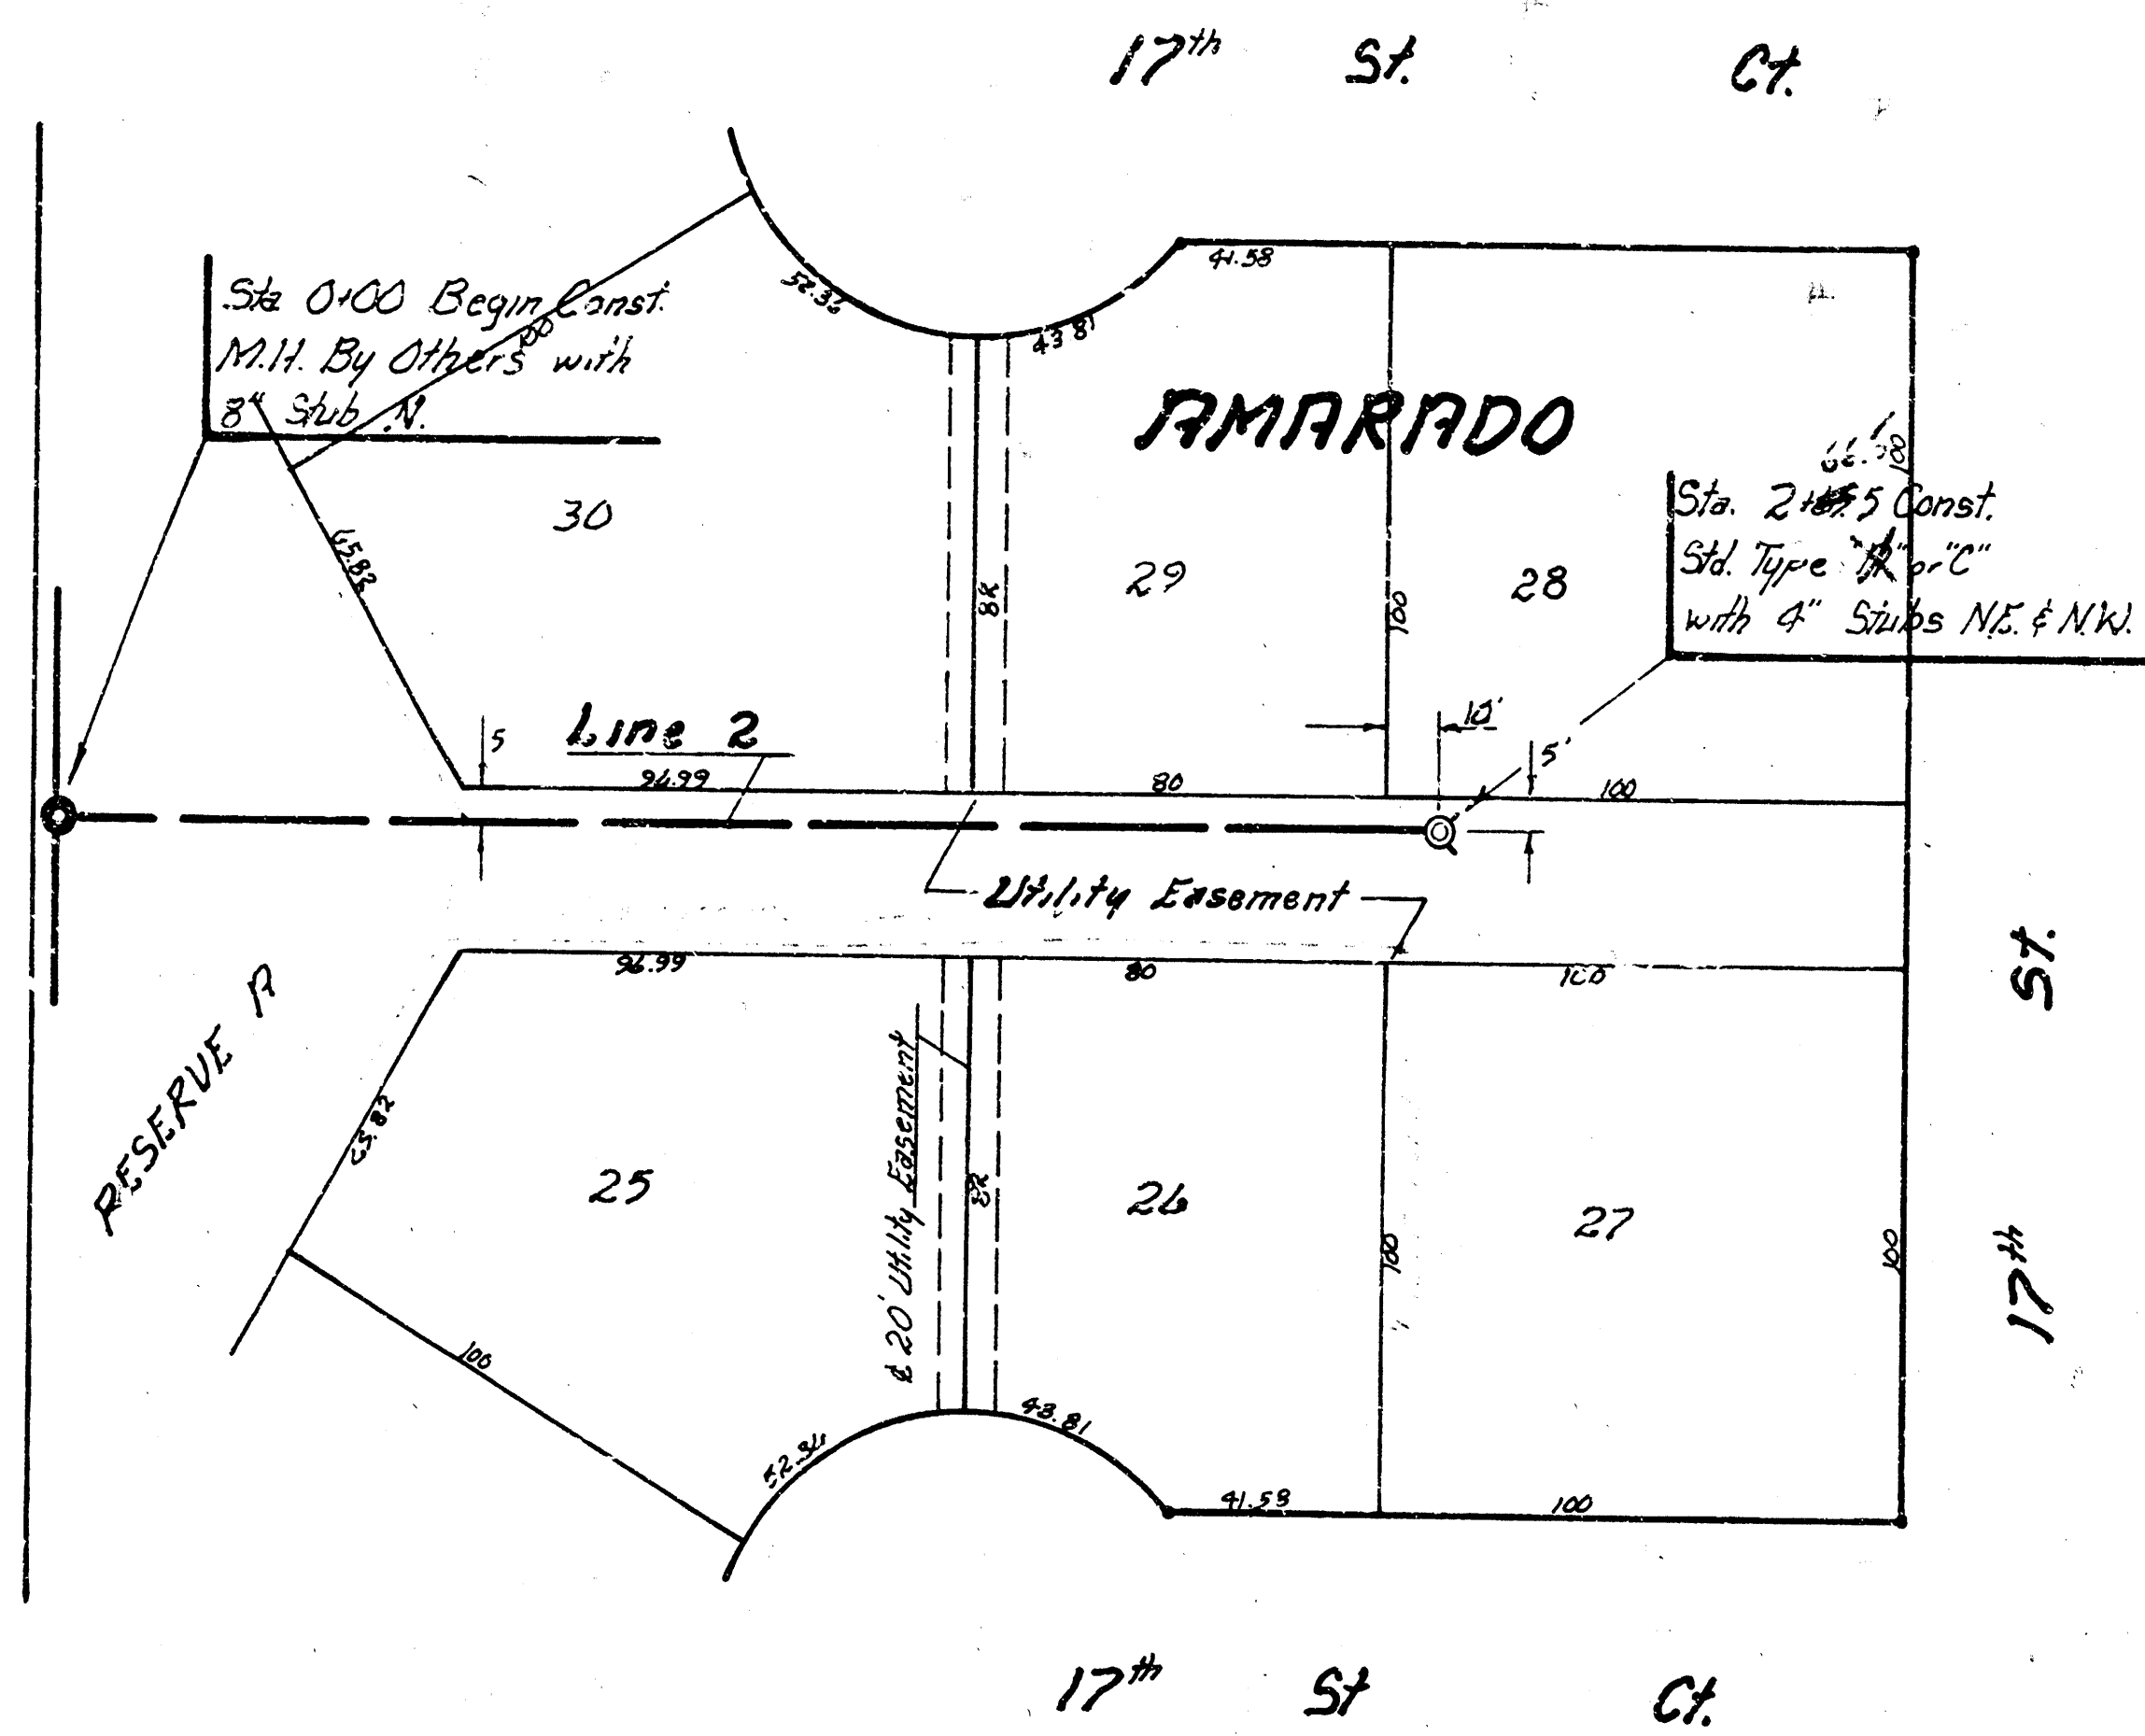


Sta 0+00 Begin Const.
M.H. By Others with
8" Stab N.

Sta 2+65.5 Const.

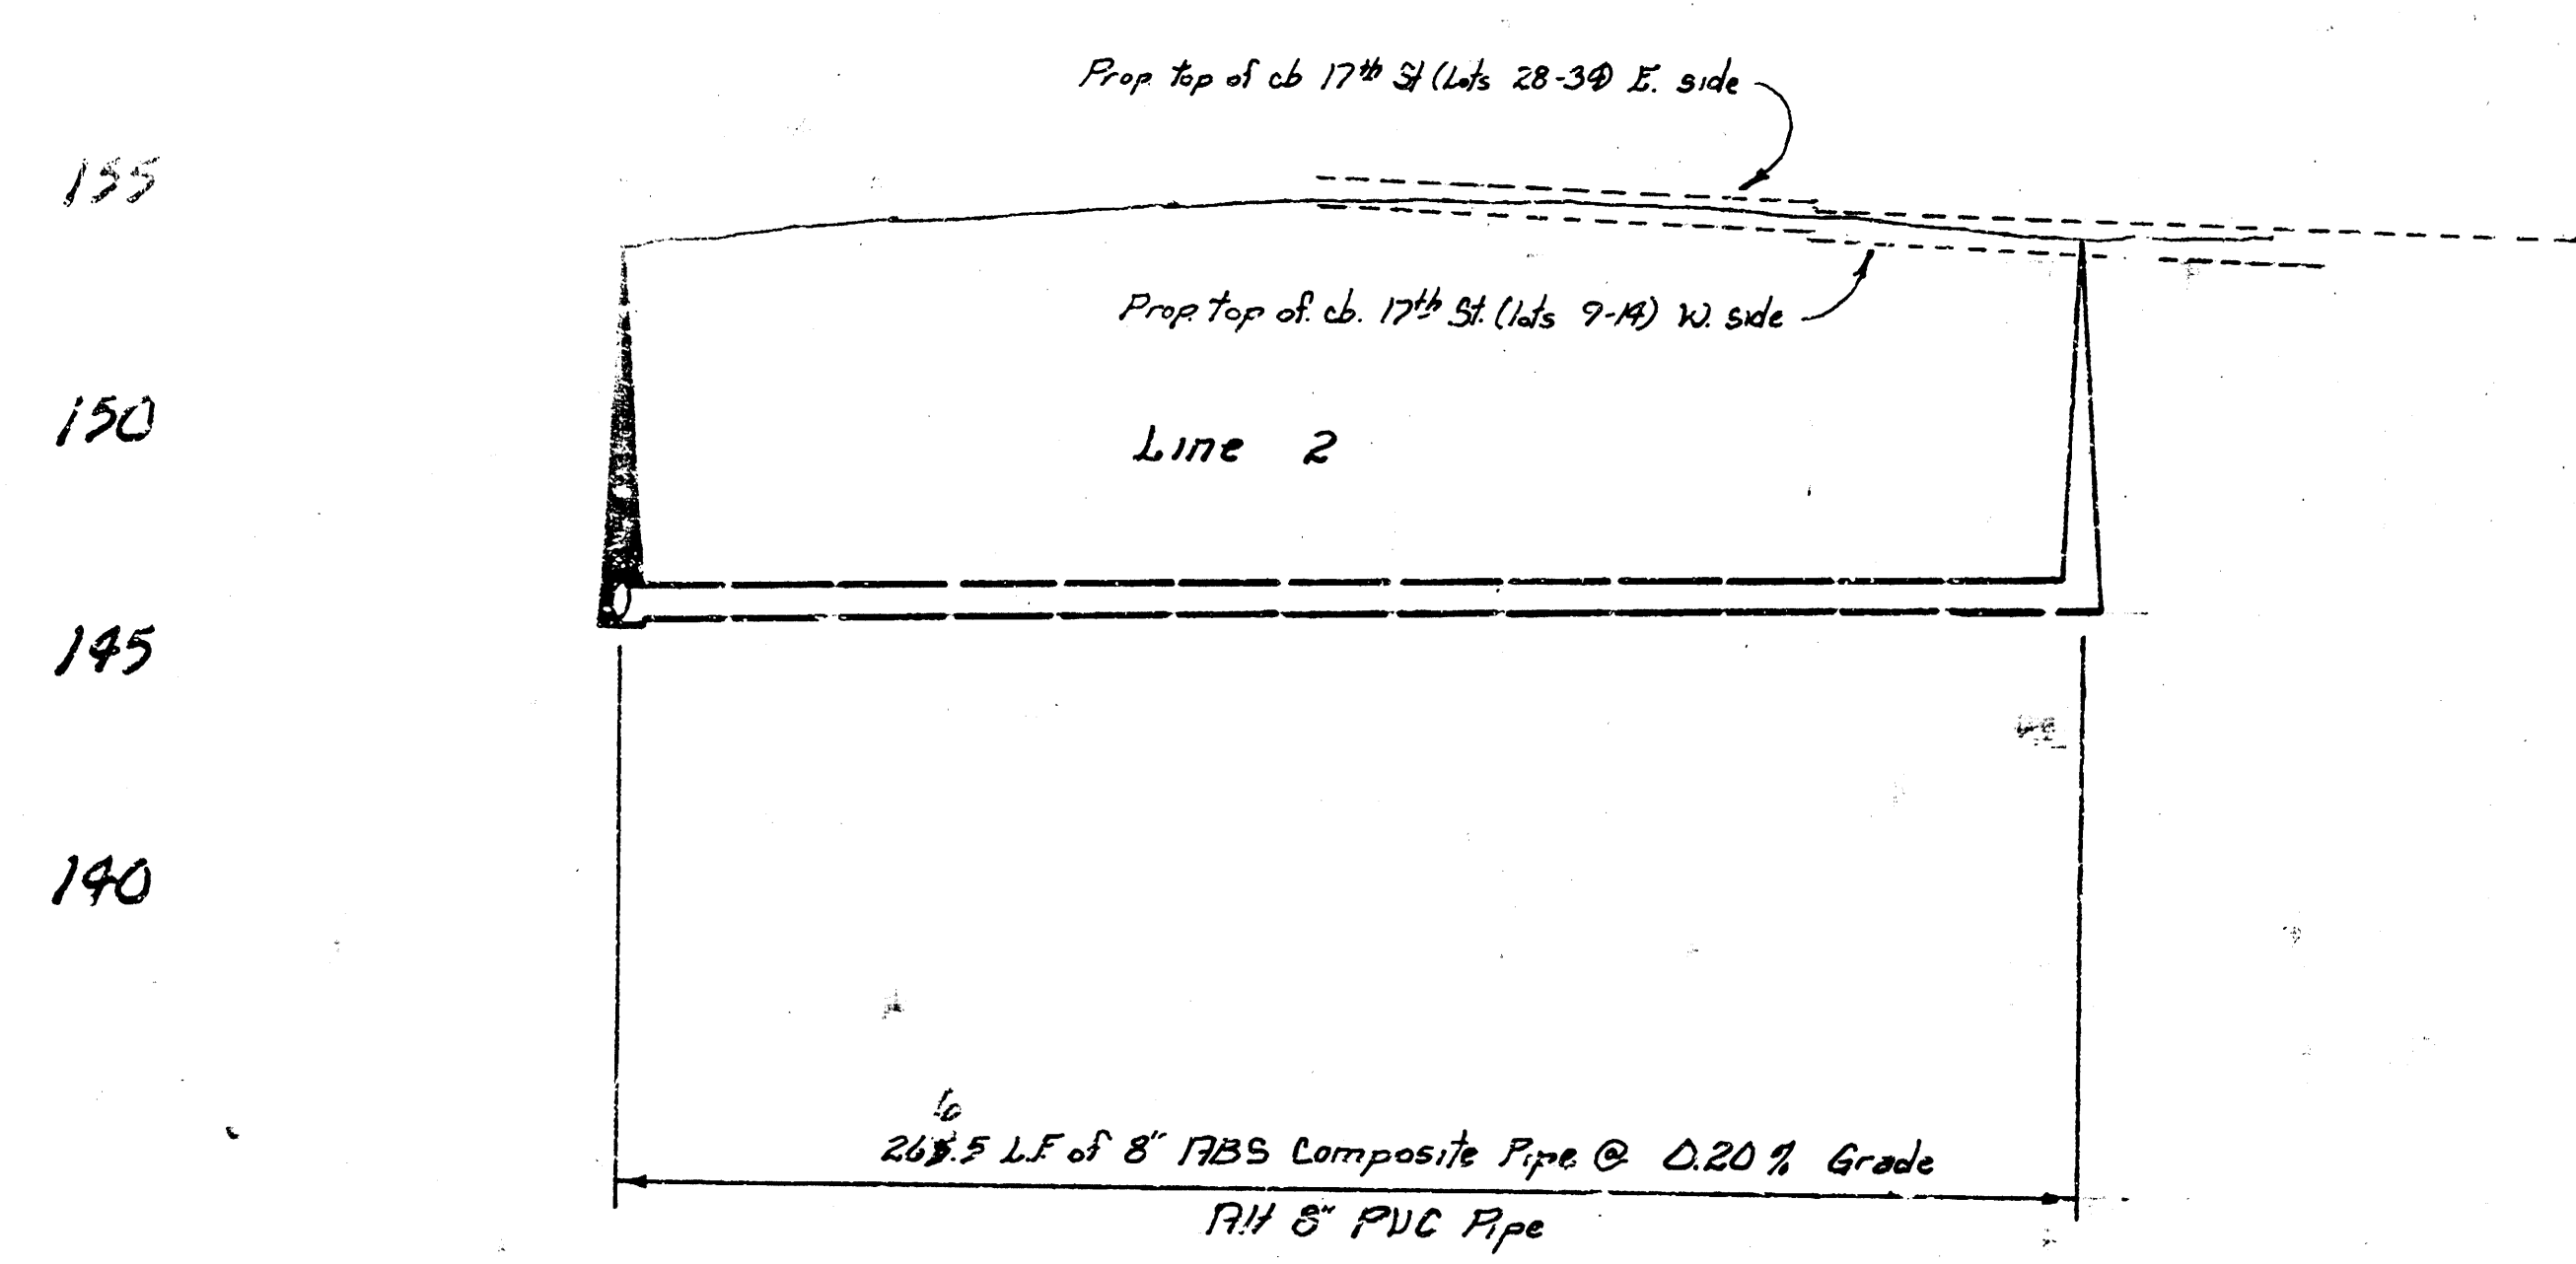


146.93 14.04
147.03 14.14
147.23
147.63
147.56

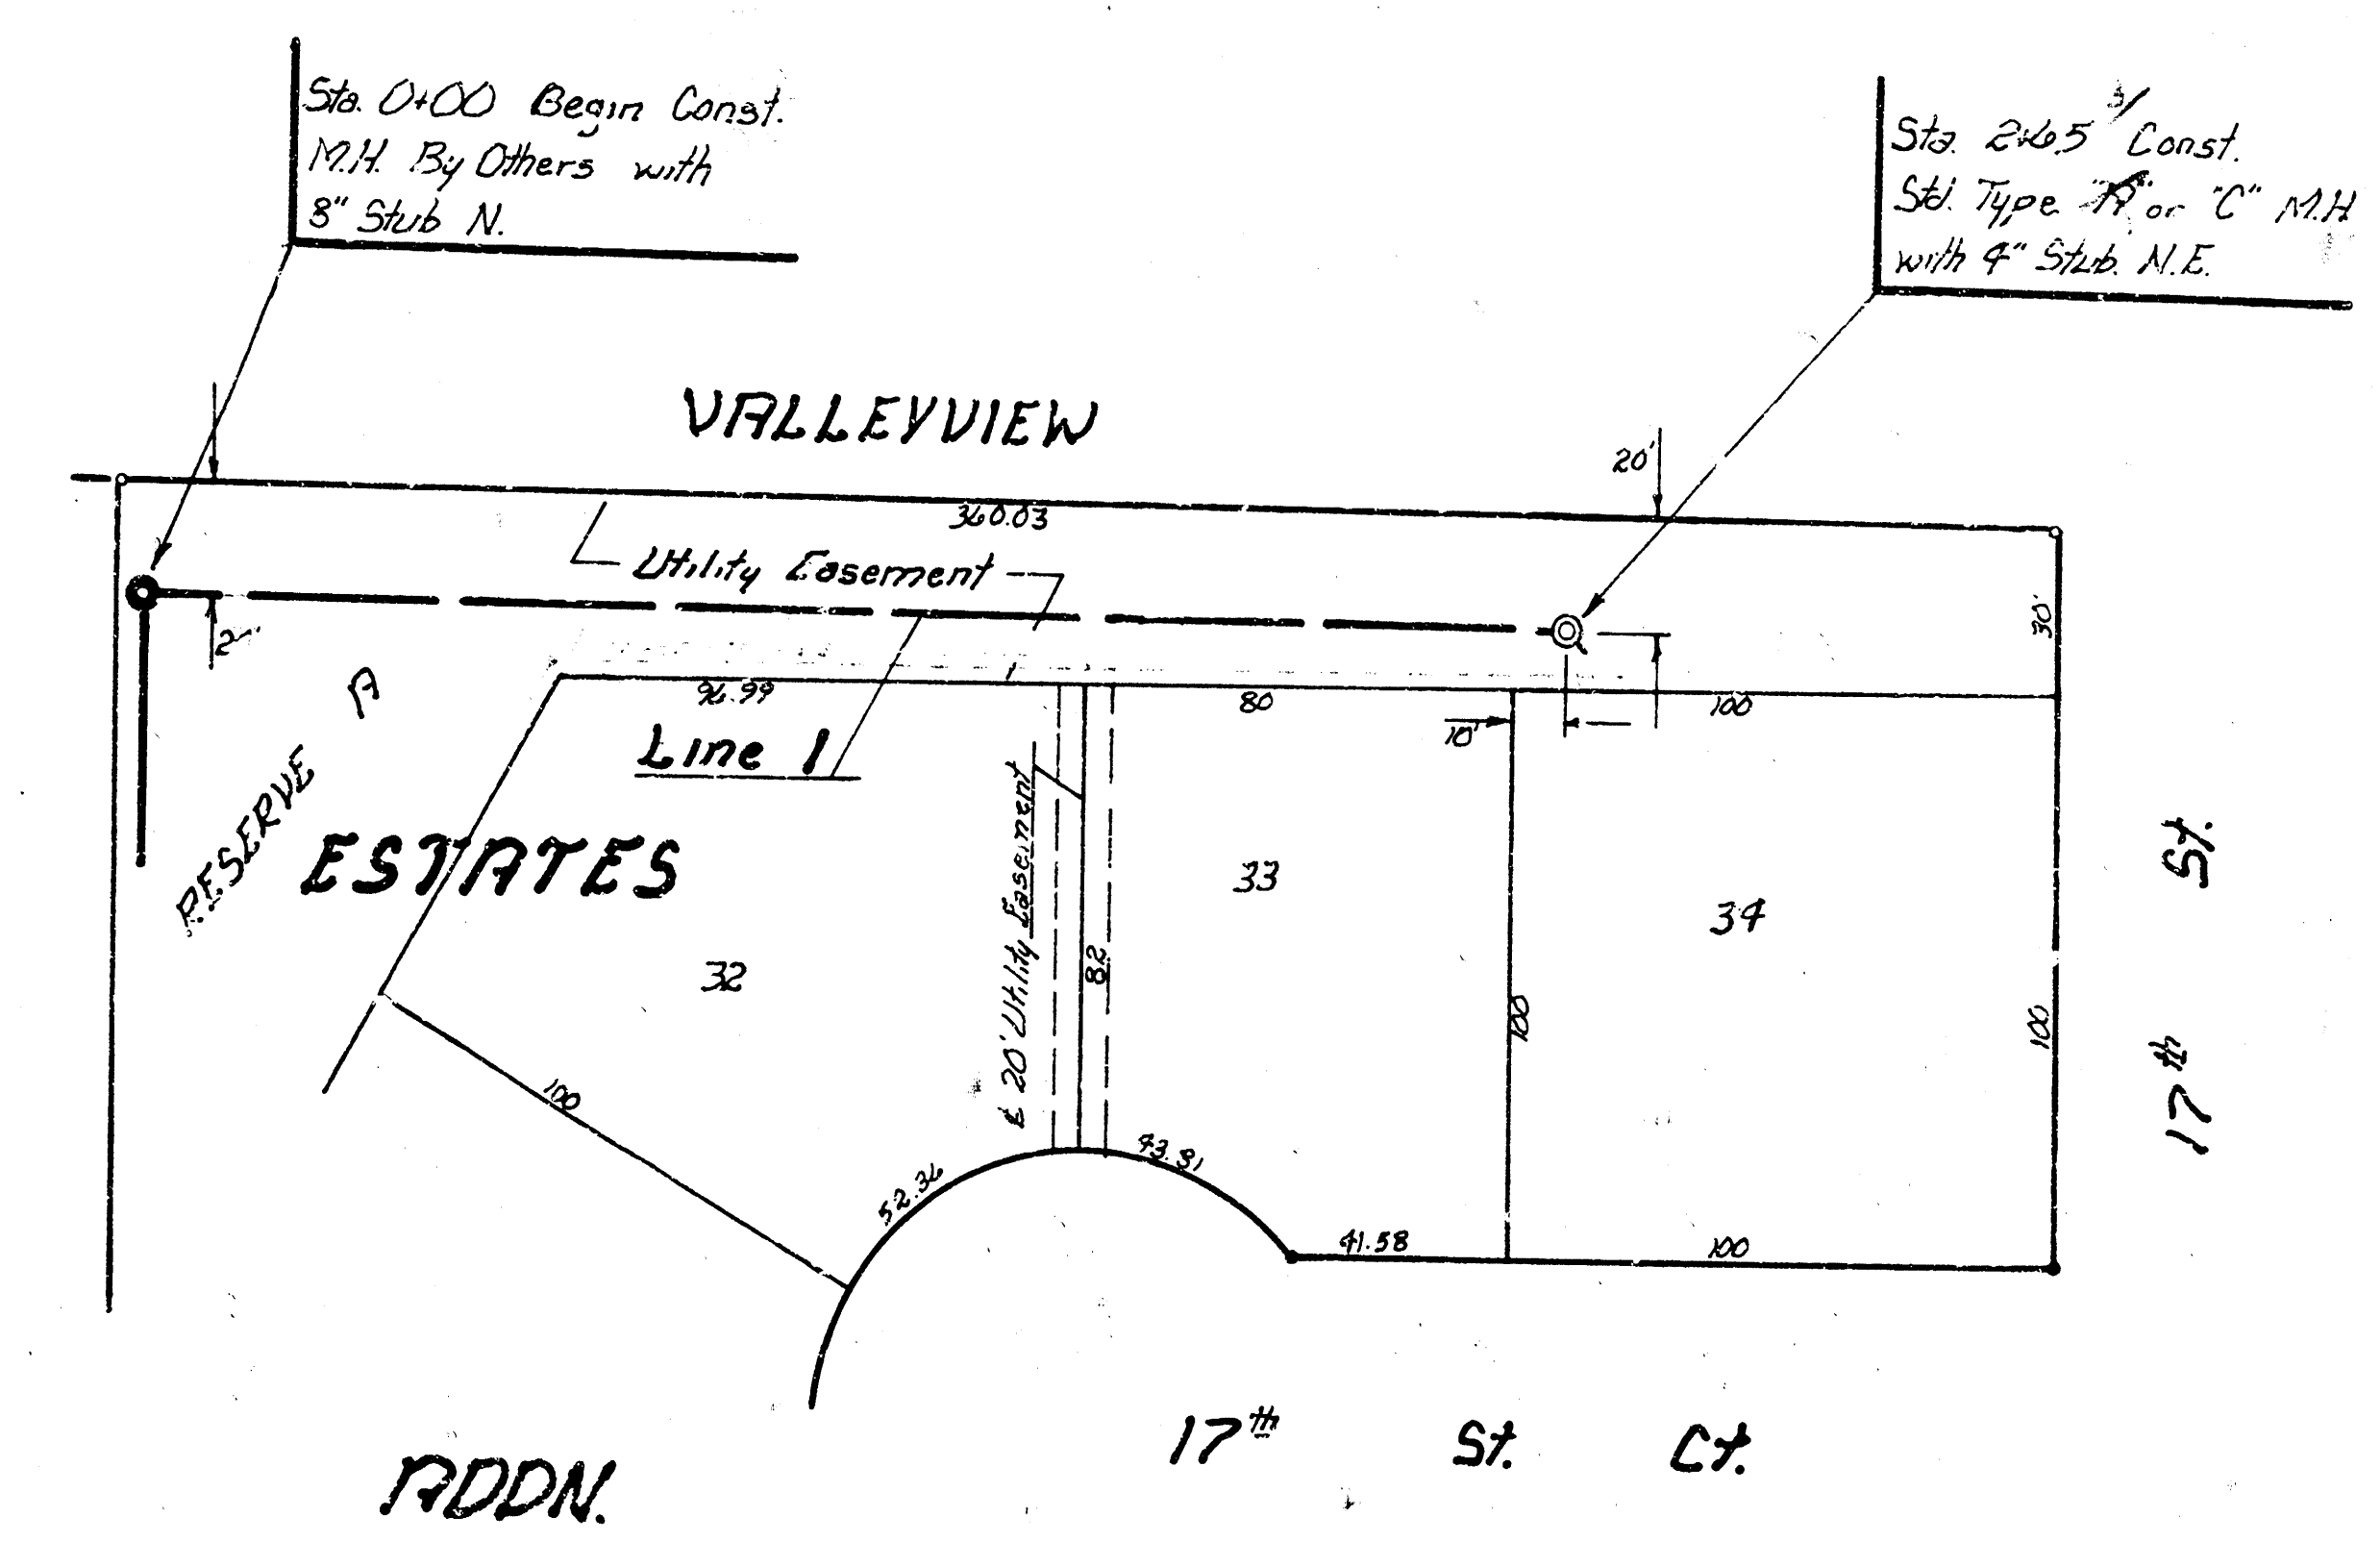

Sta 0+00 Begin Const.
M.H. By Others with
8" Stab N.


Sta 2+65.5 Const.

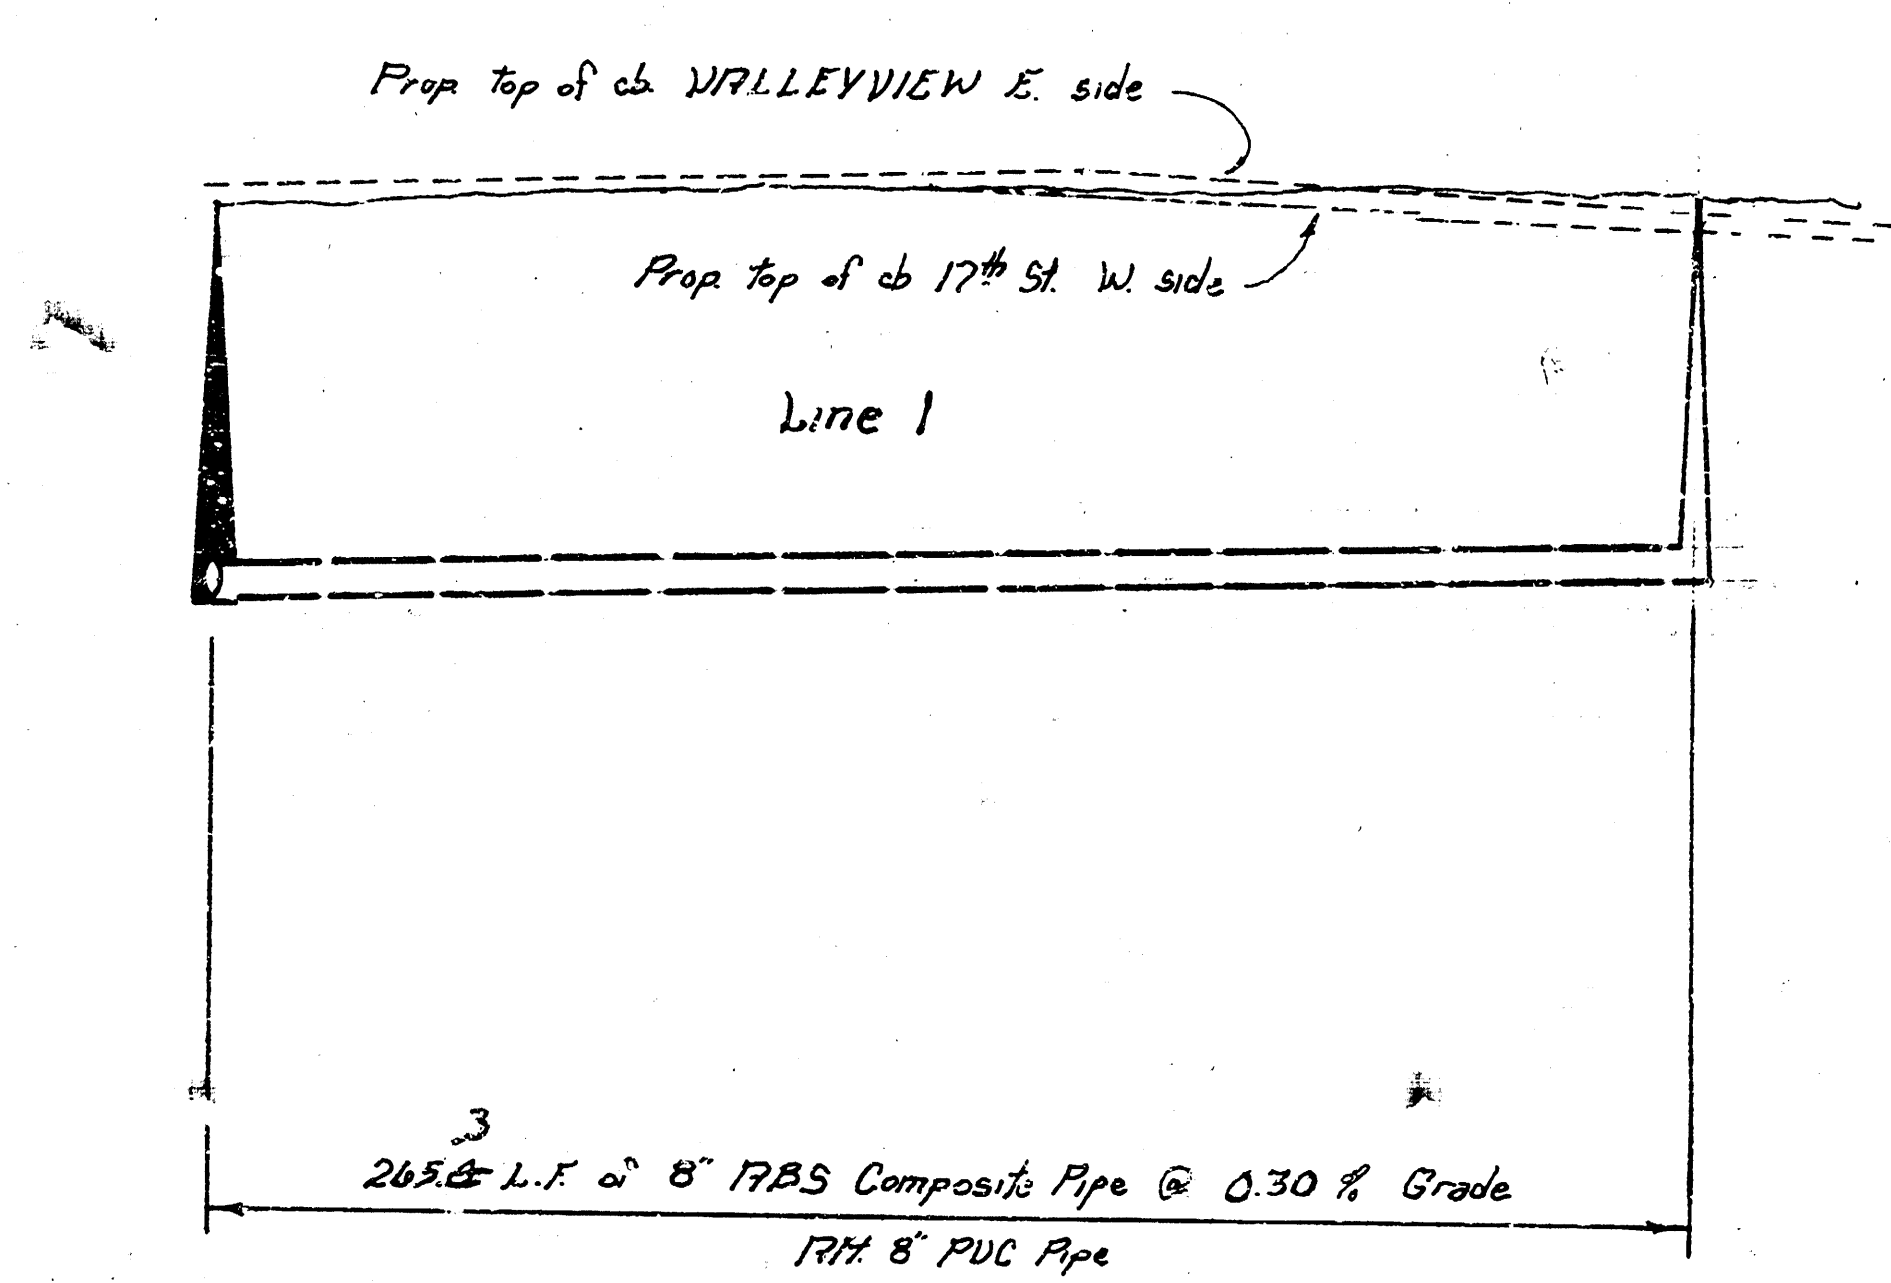

142.78 14.04
142.98 14.14
143.18
143.68
143.68 14.14



SCALE
Plan 1" = 20'
Profile 1" = 5'
Vert 1" = 20'

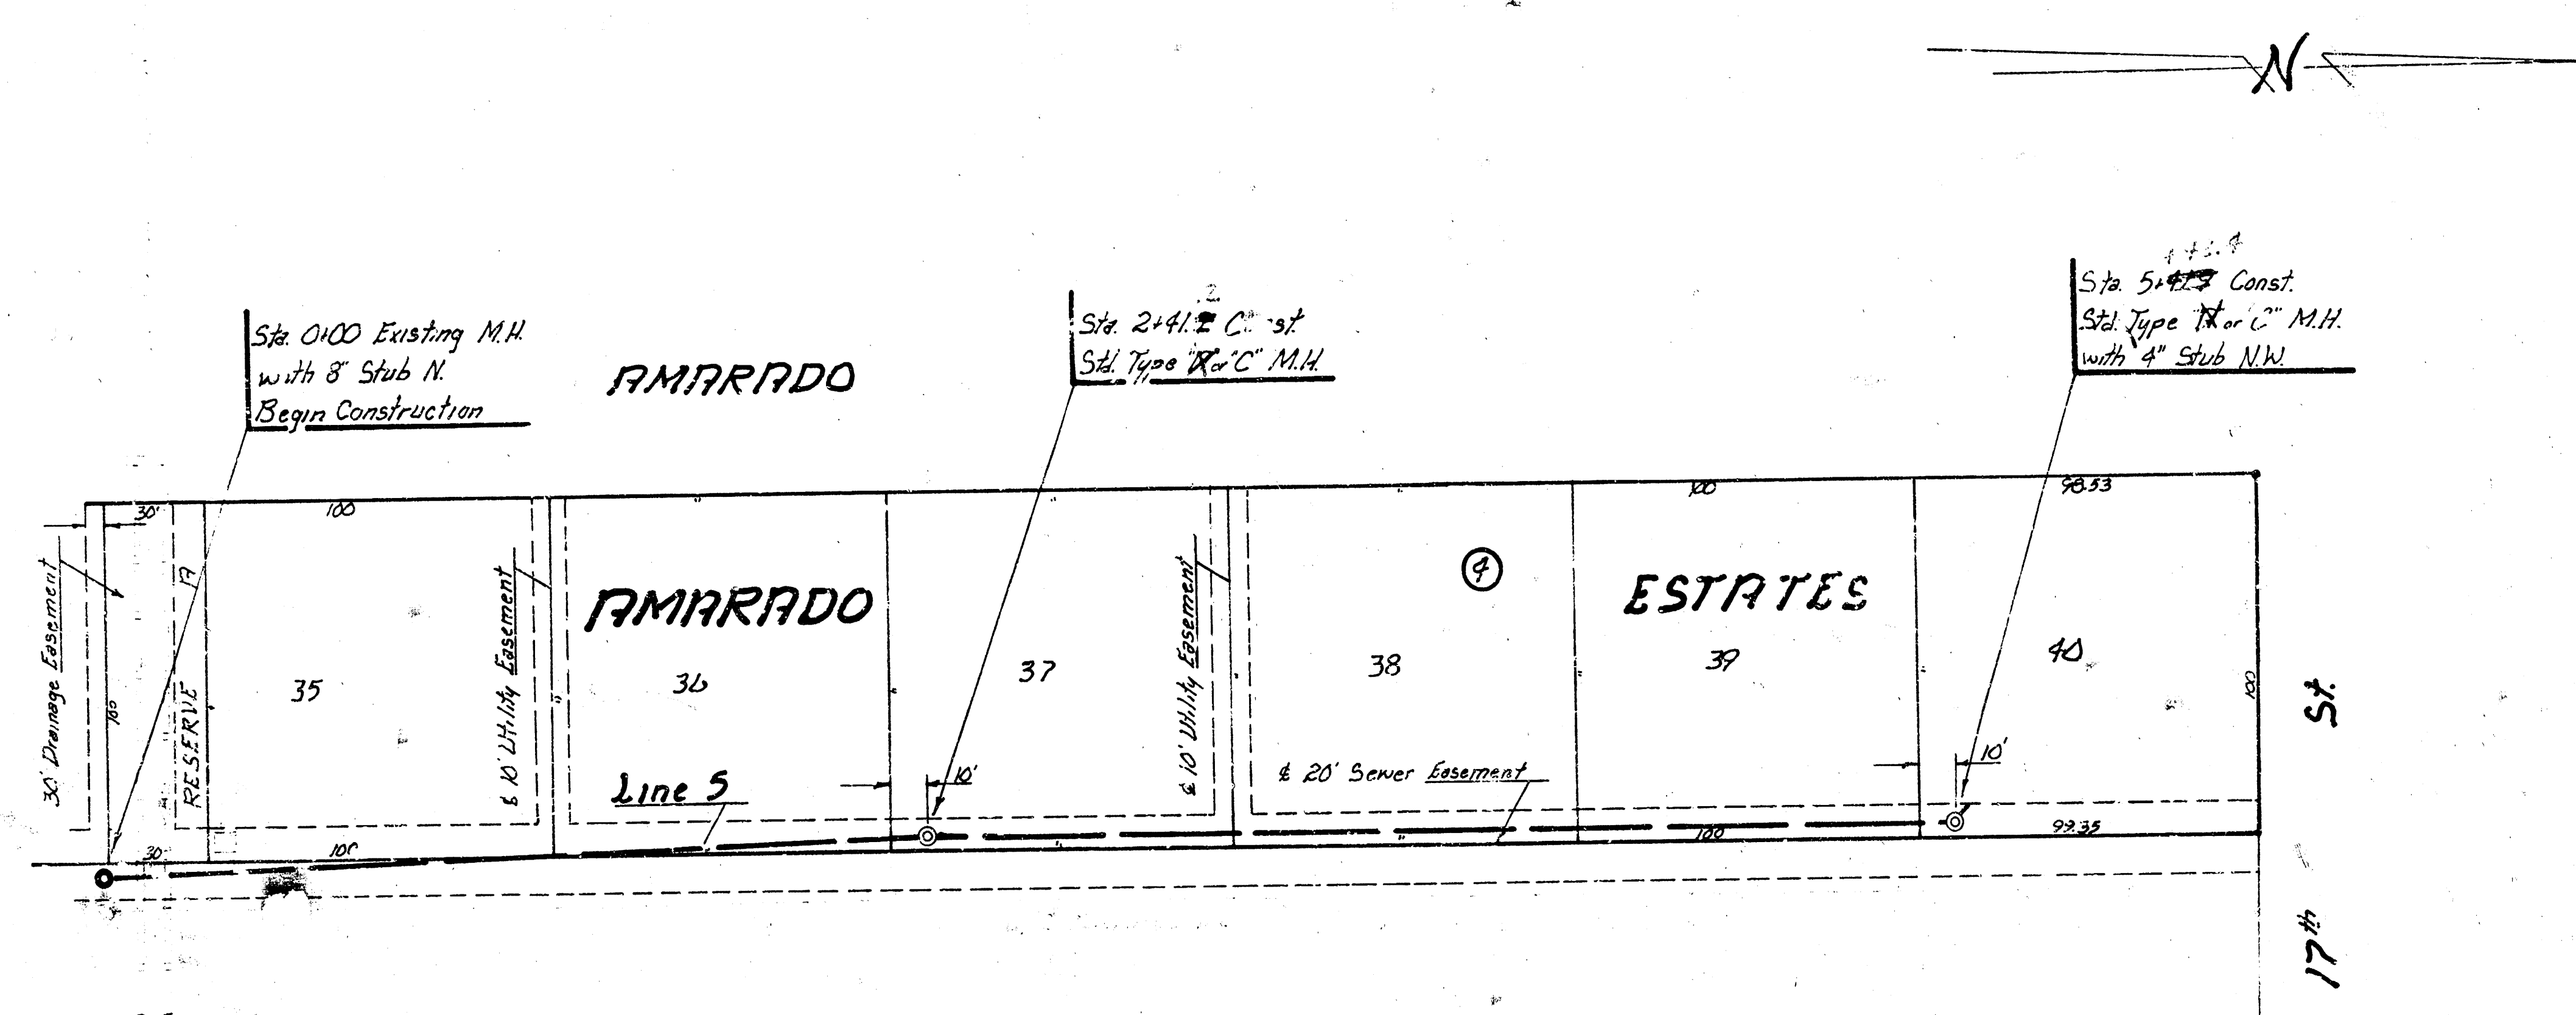

SCALE
 Plan 1" = 20'
 Profile 1" = 5'
 Vert 1" = 5'
 Horiz 1" = 20'

