


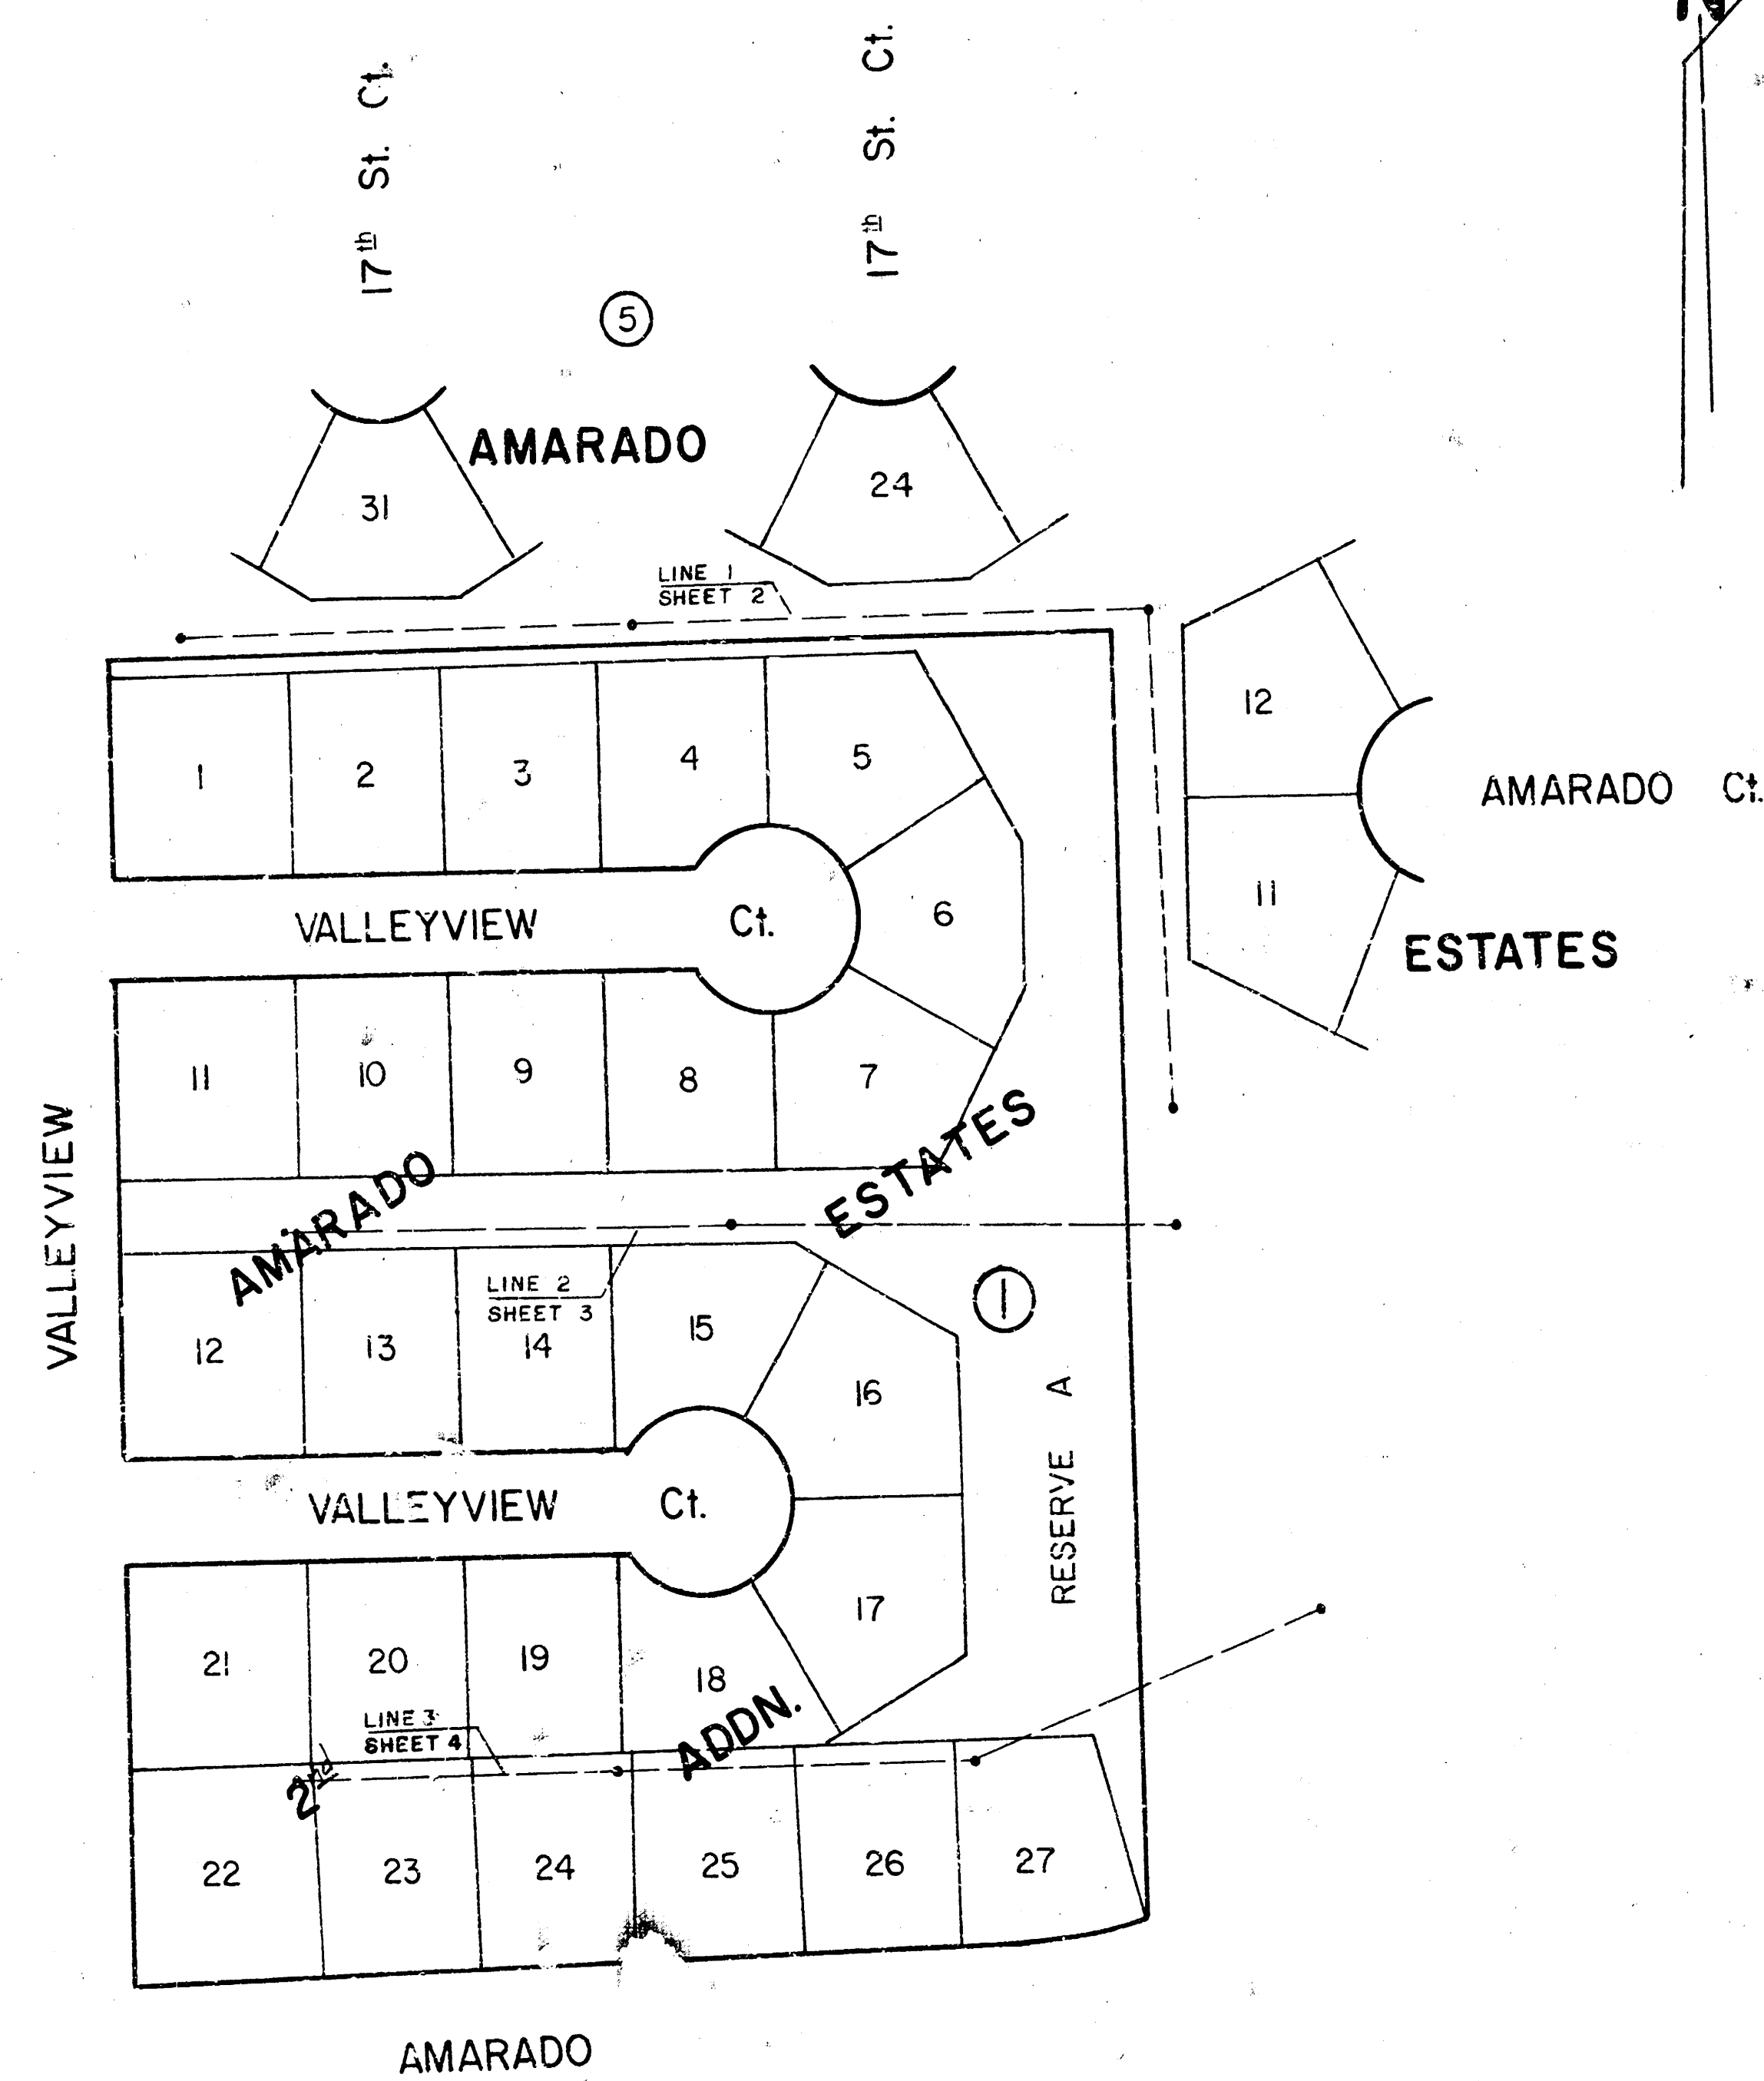



LATERAL 20, MAIN 3, WESTLINK SEWER

City of WICHITA, KANSAS Dean Sellers — City Engineer

Project No. : 468-76-245-80815-000-000-001



Date: _____

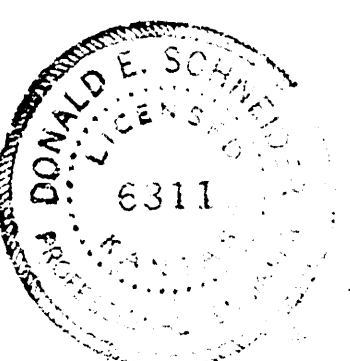


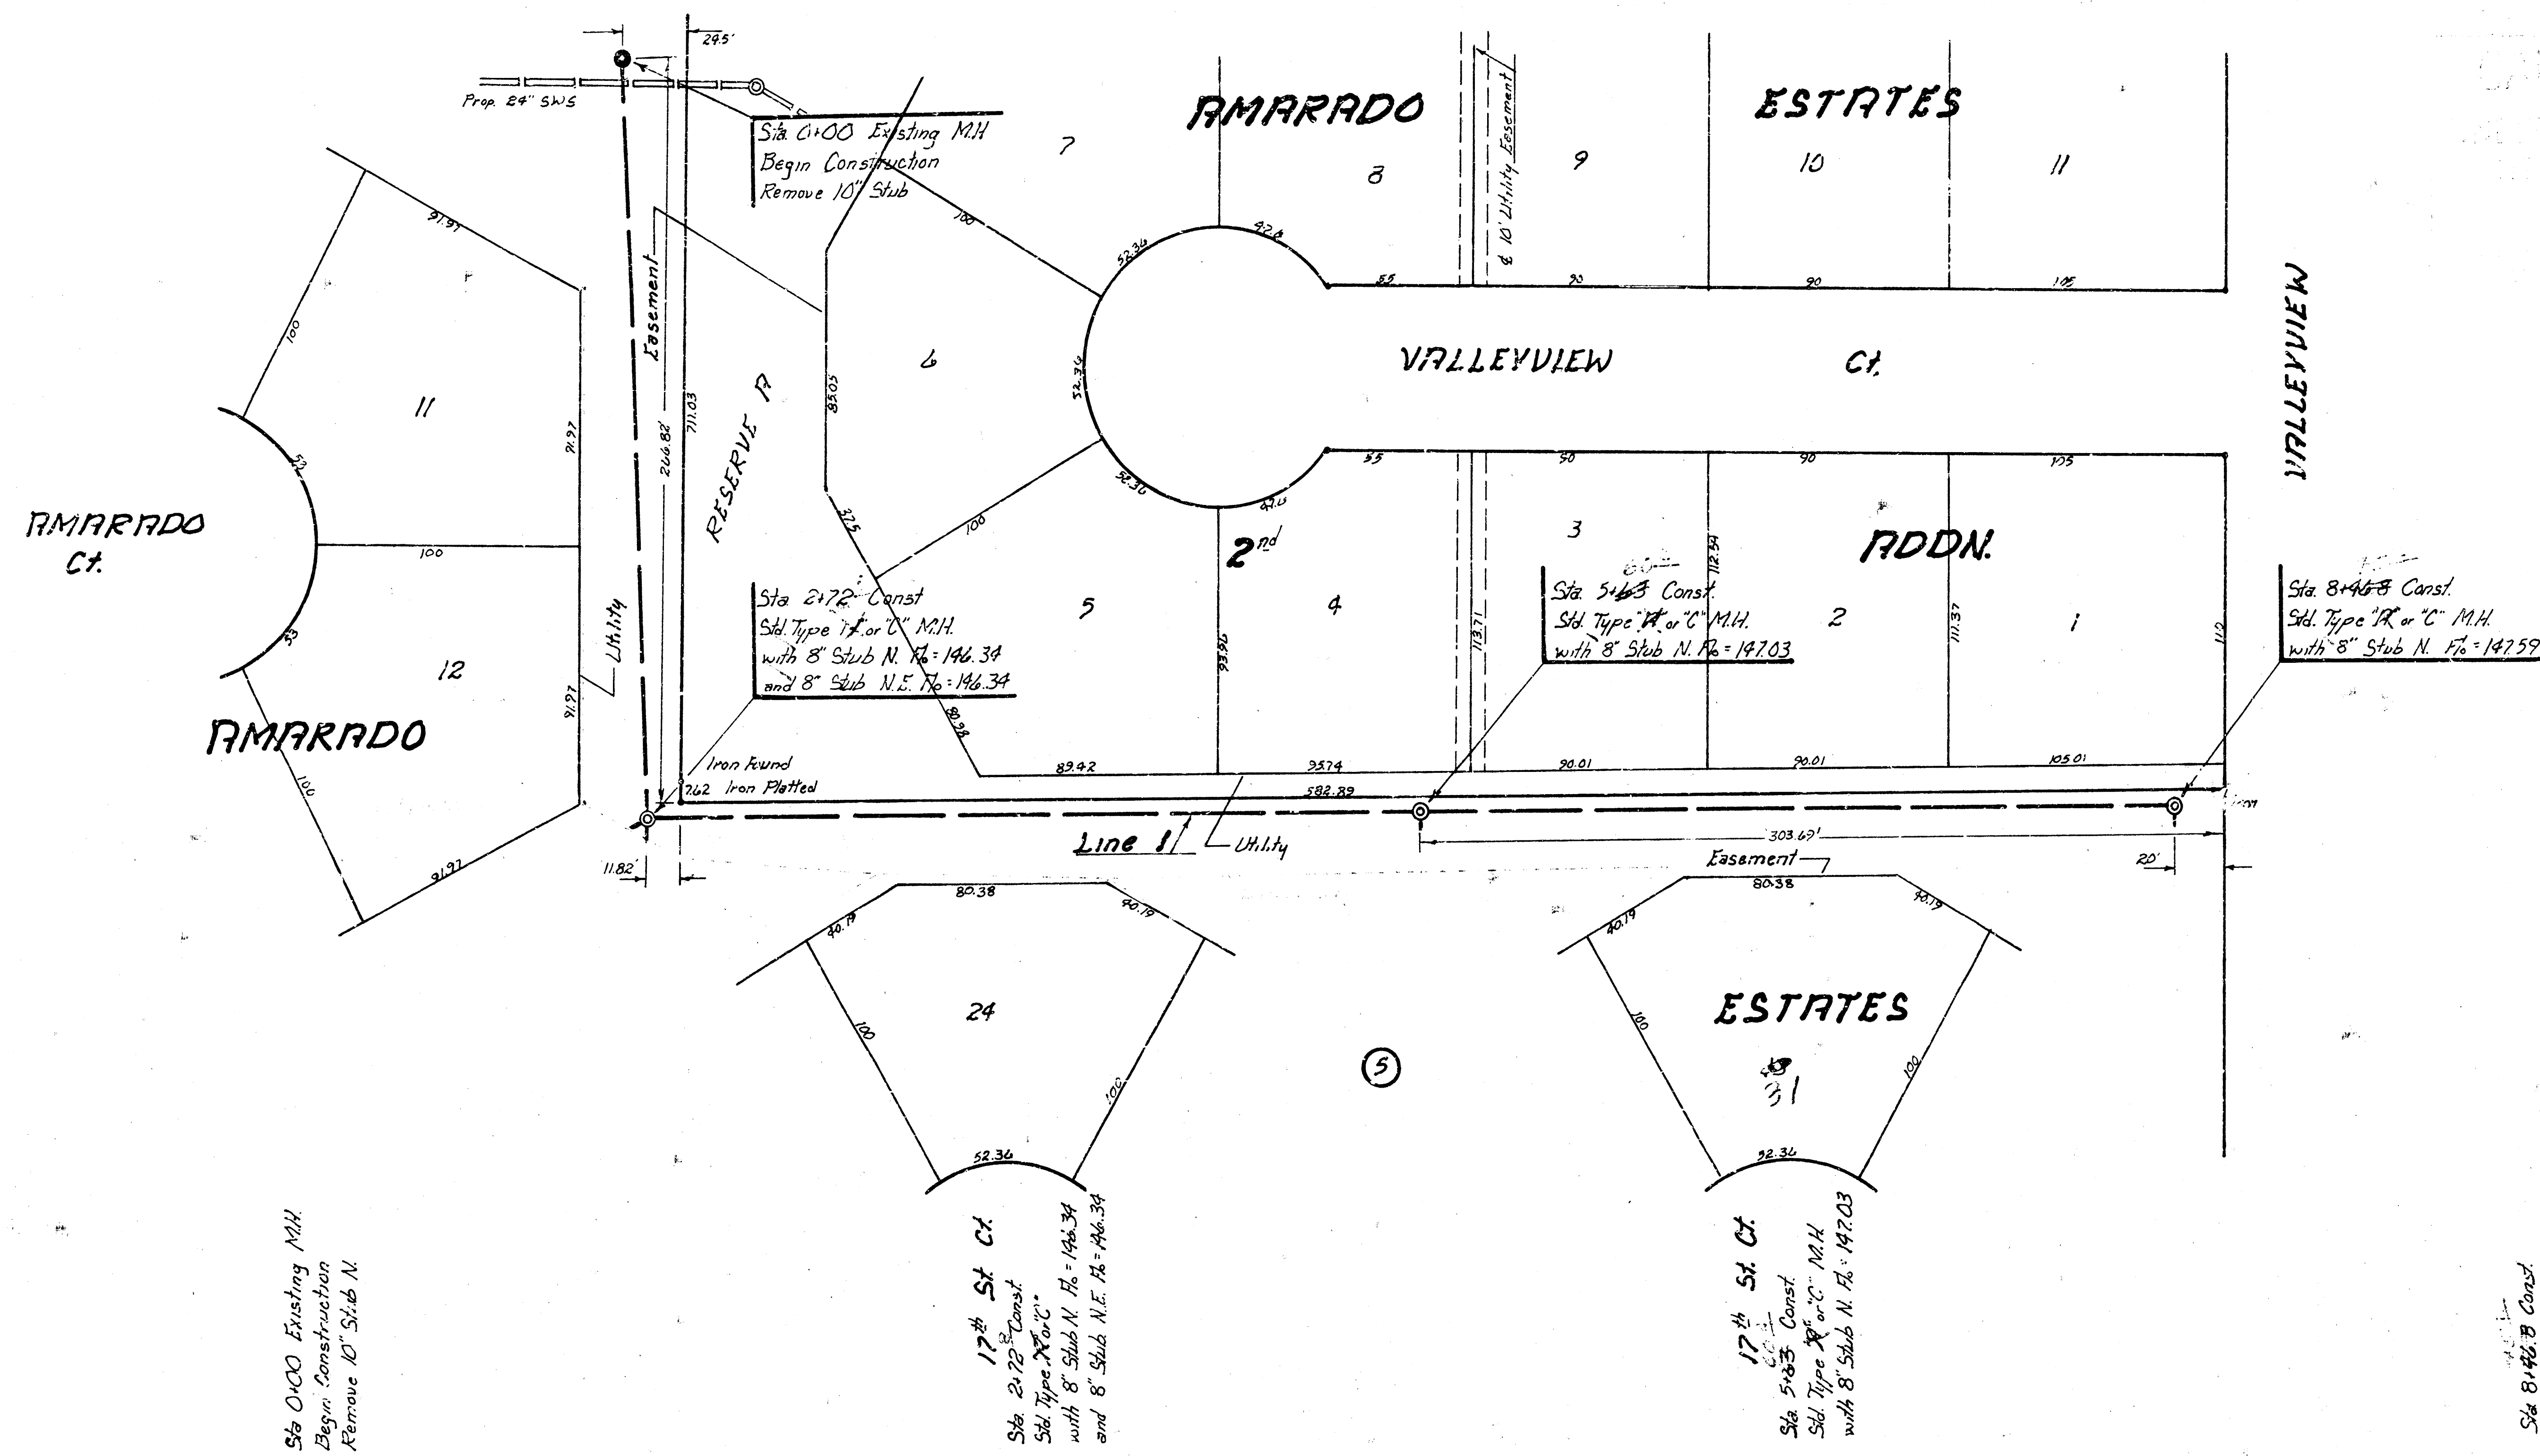

SCALE
Plan 1" = 20'
Profile 1" = 5'
Vert 1" = 5'
Horz 1" = 20'


155
150
145
140

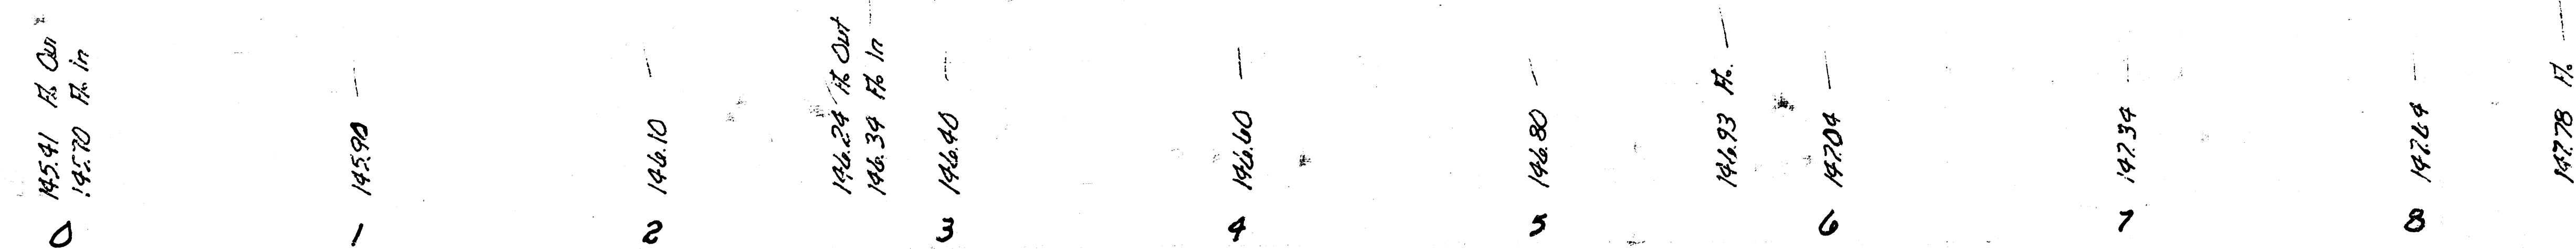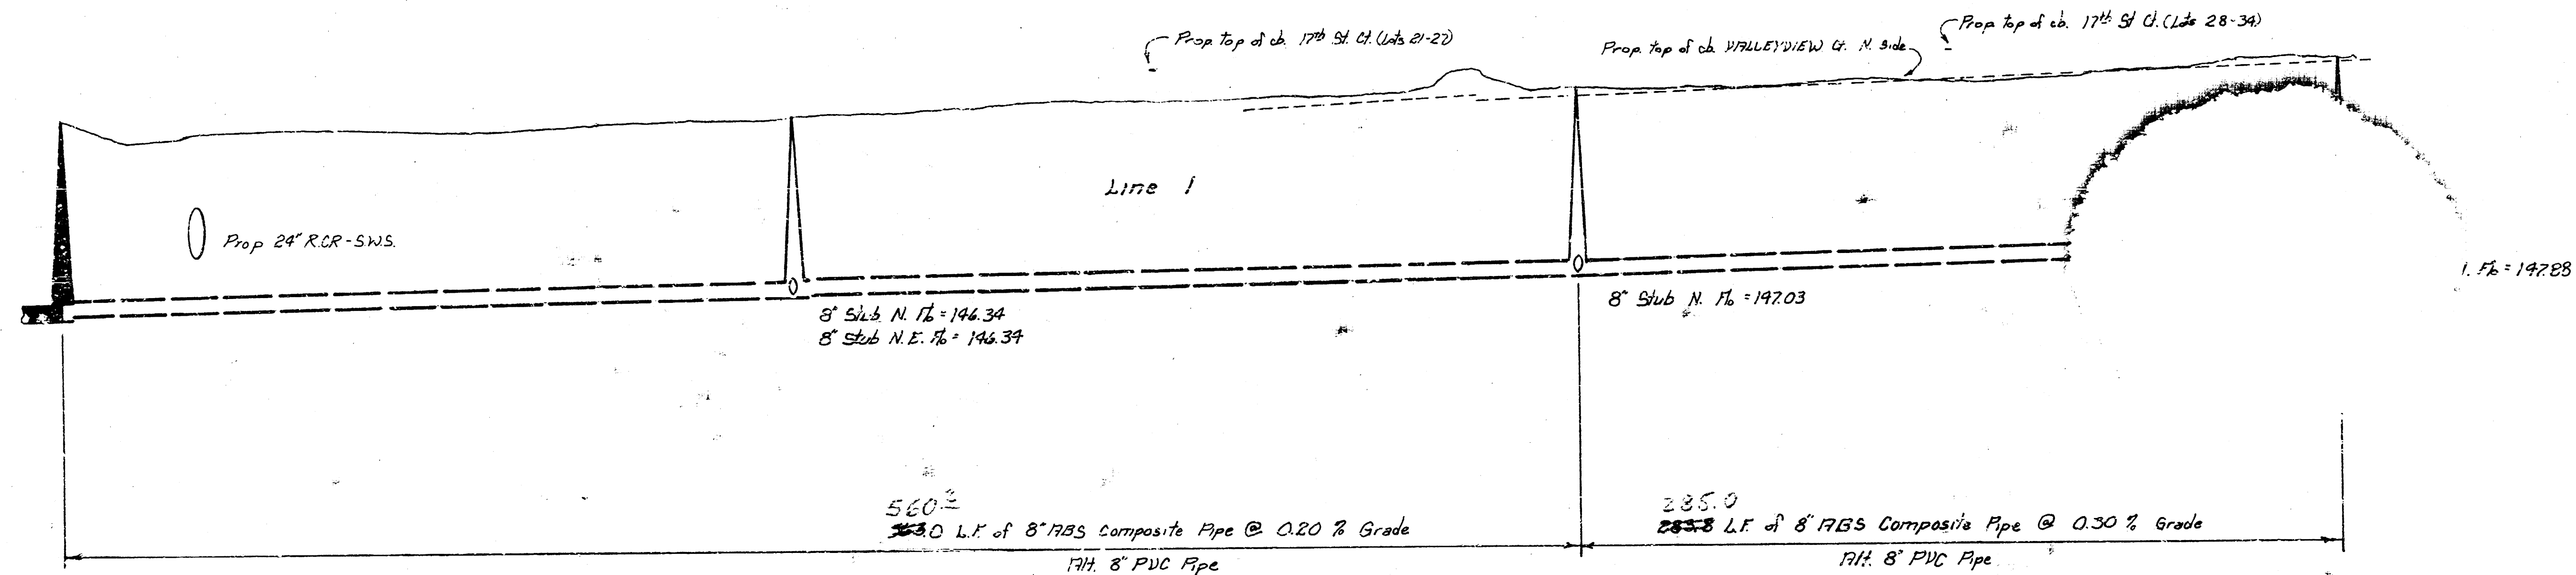

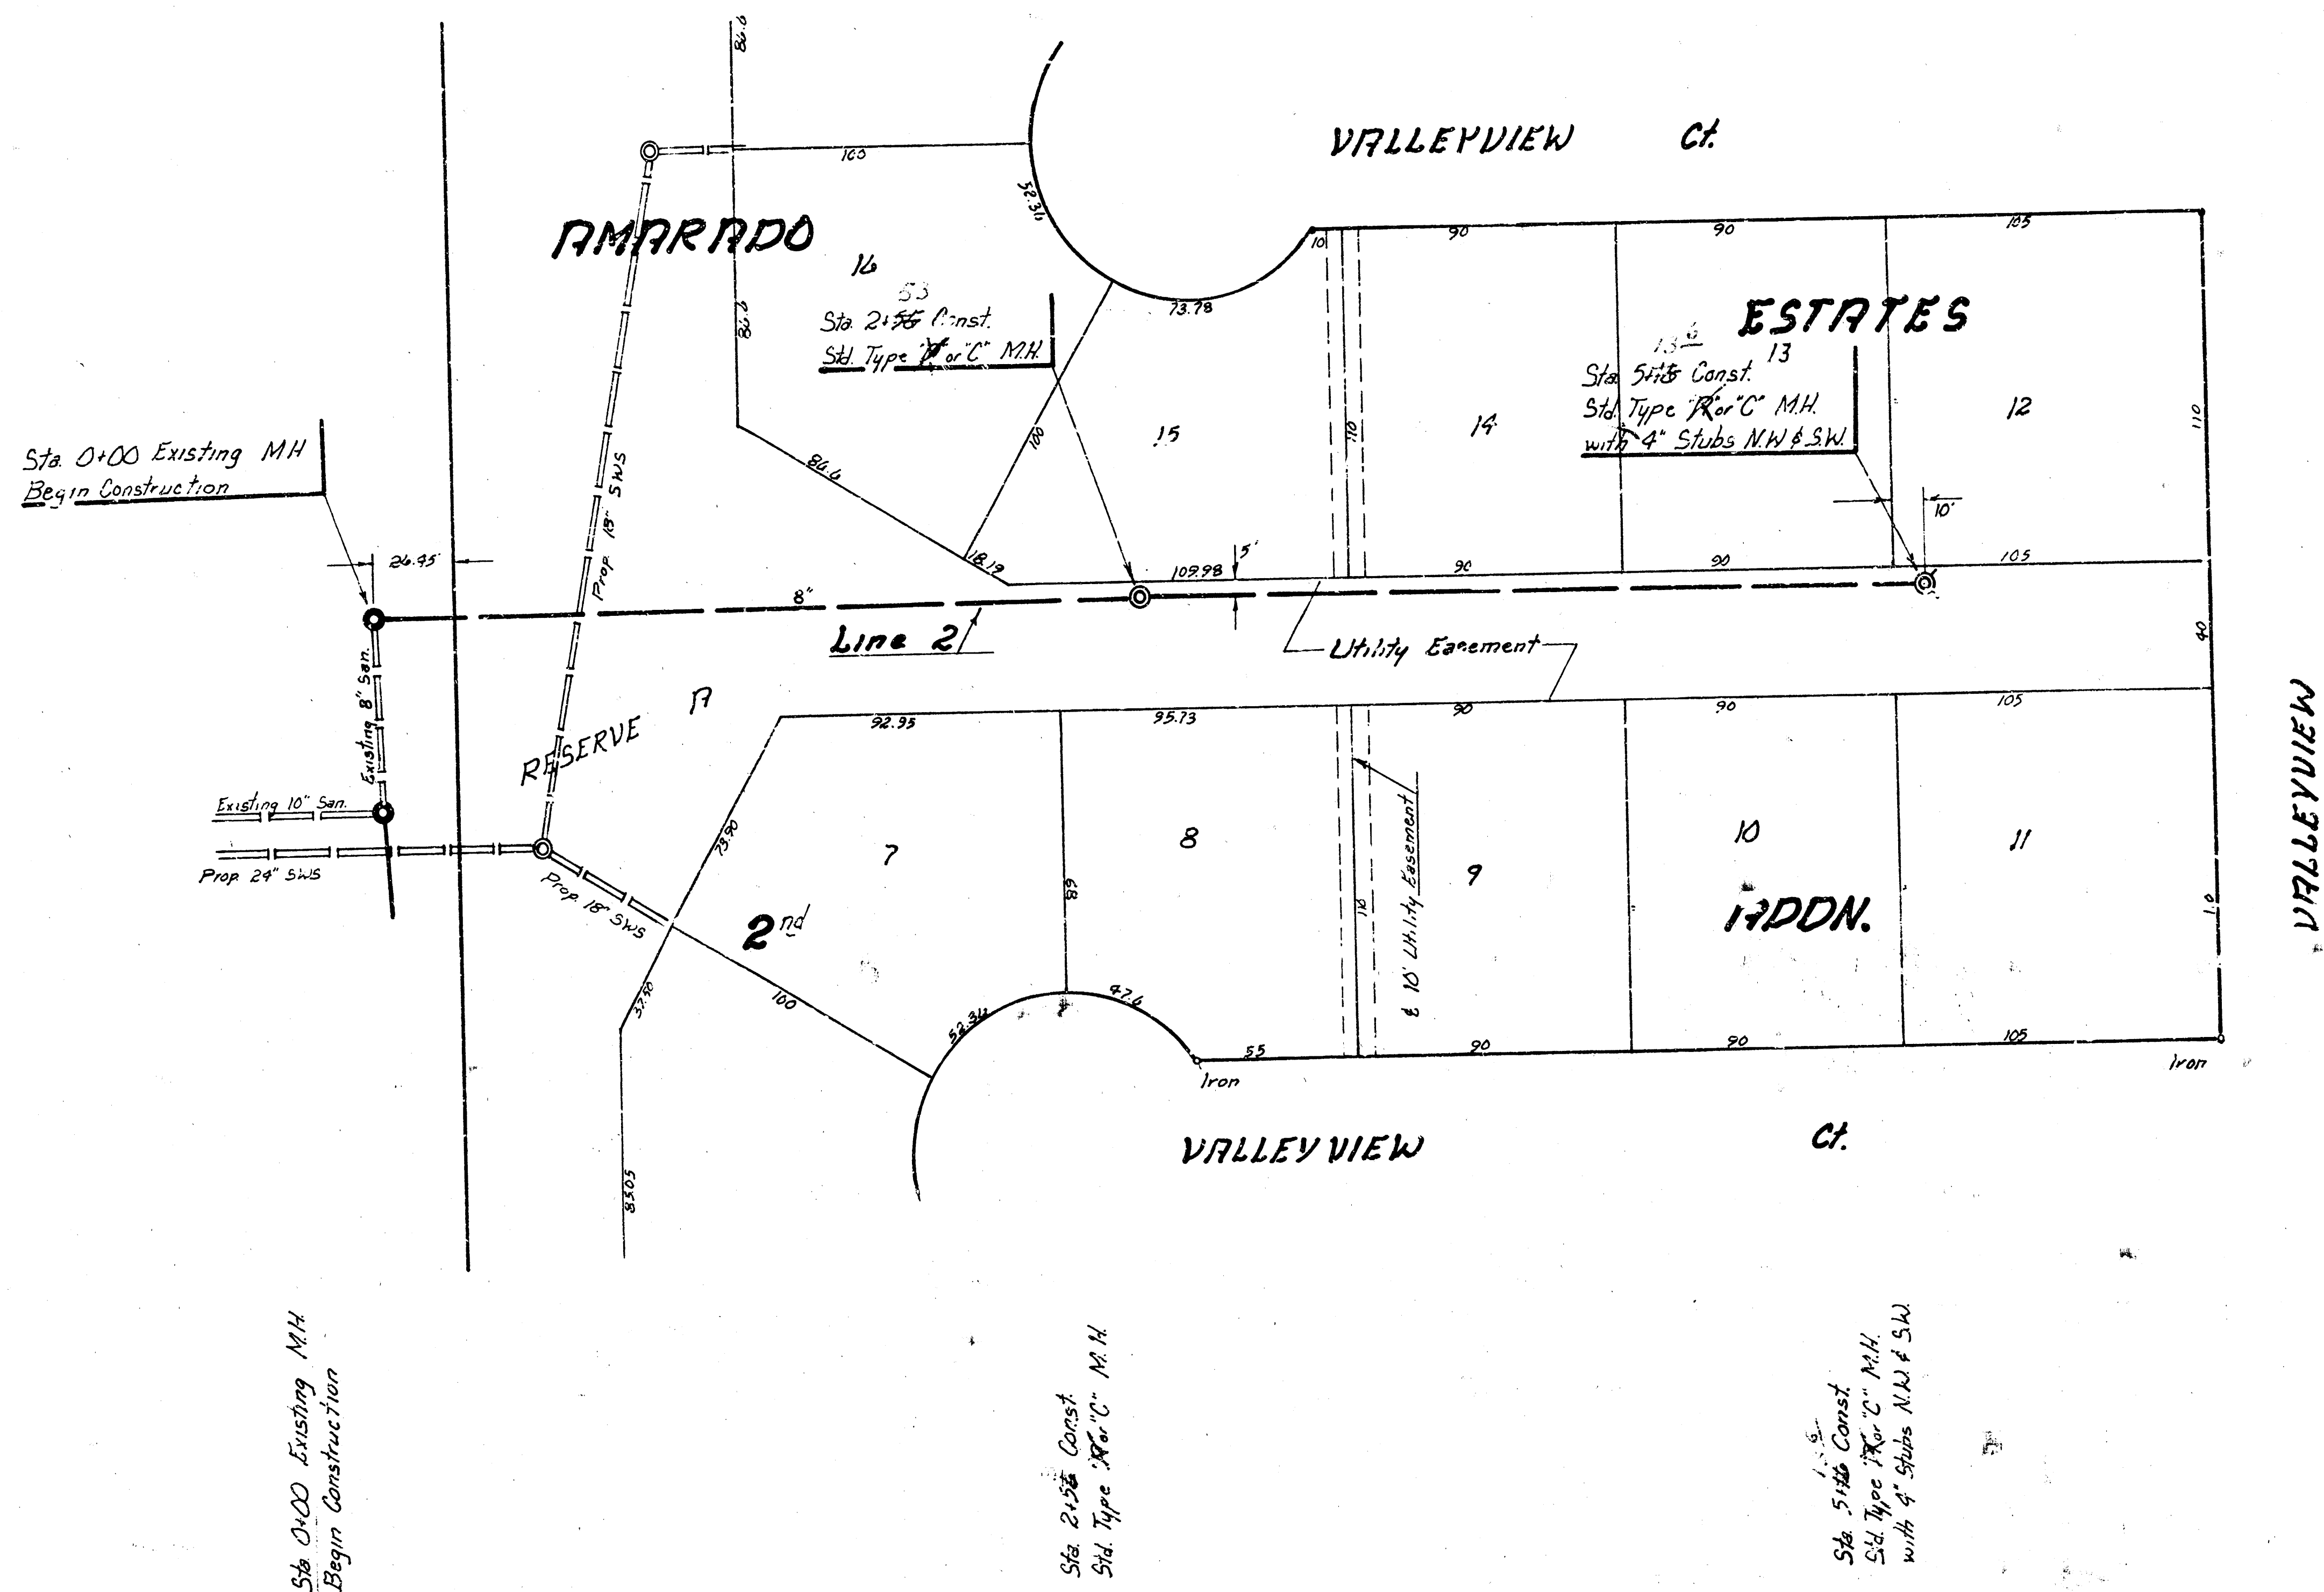


SCALE
 Plan 1" = 20'
 Profile 1" = 5'
 Area 1" = 20'

155
 150
 145
 140

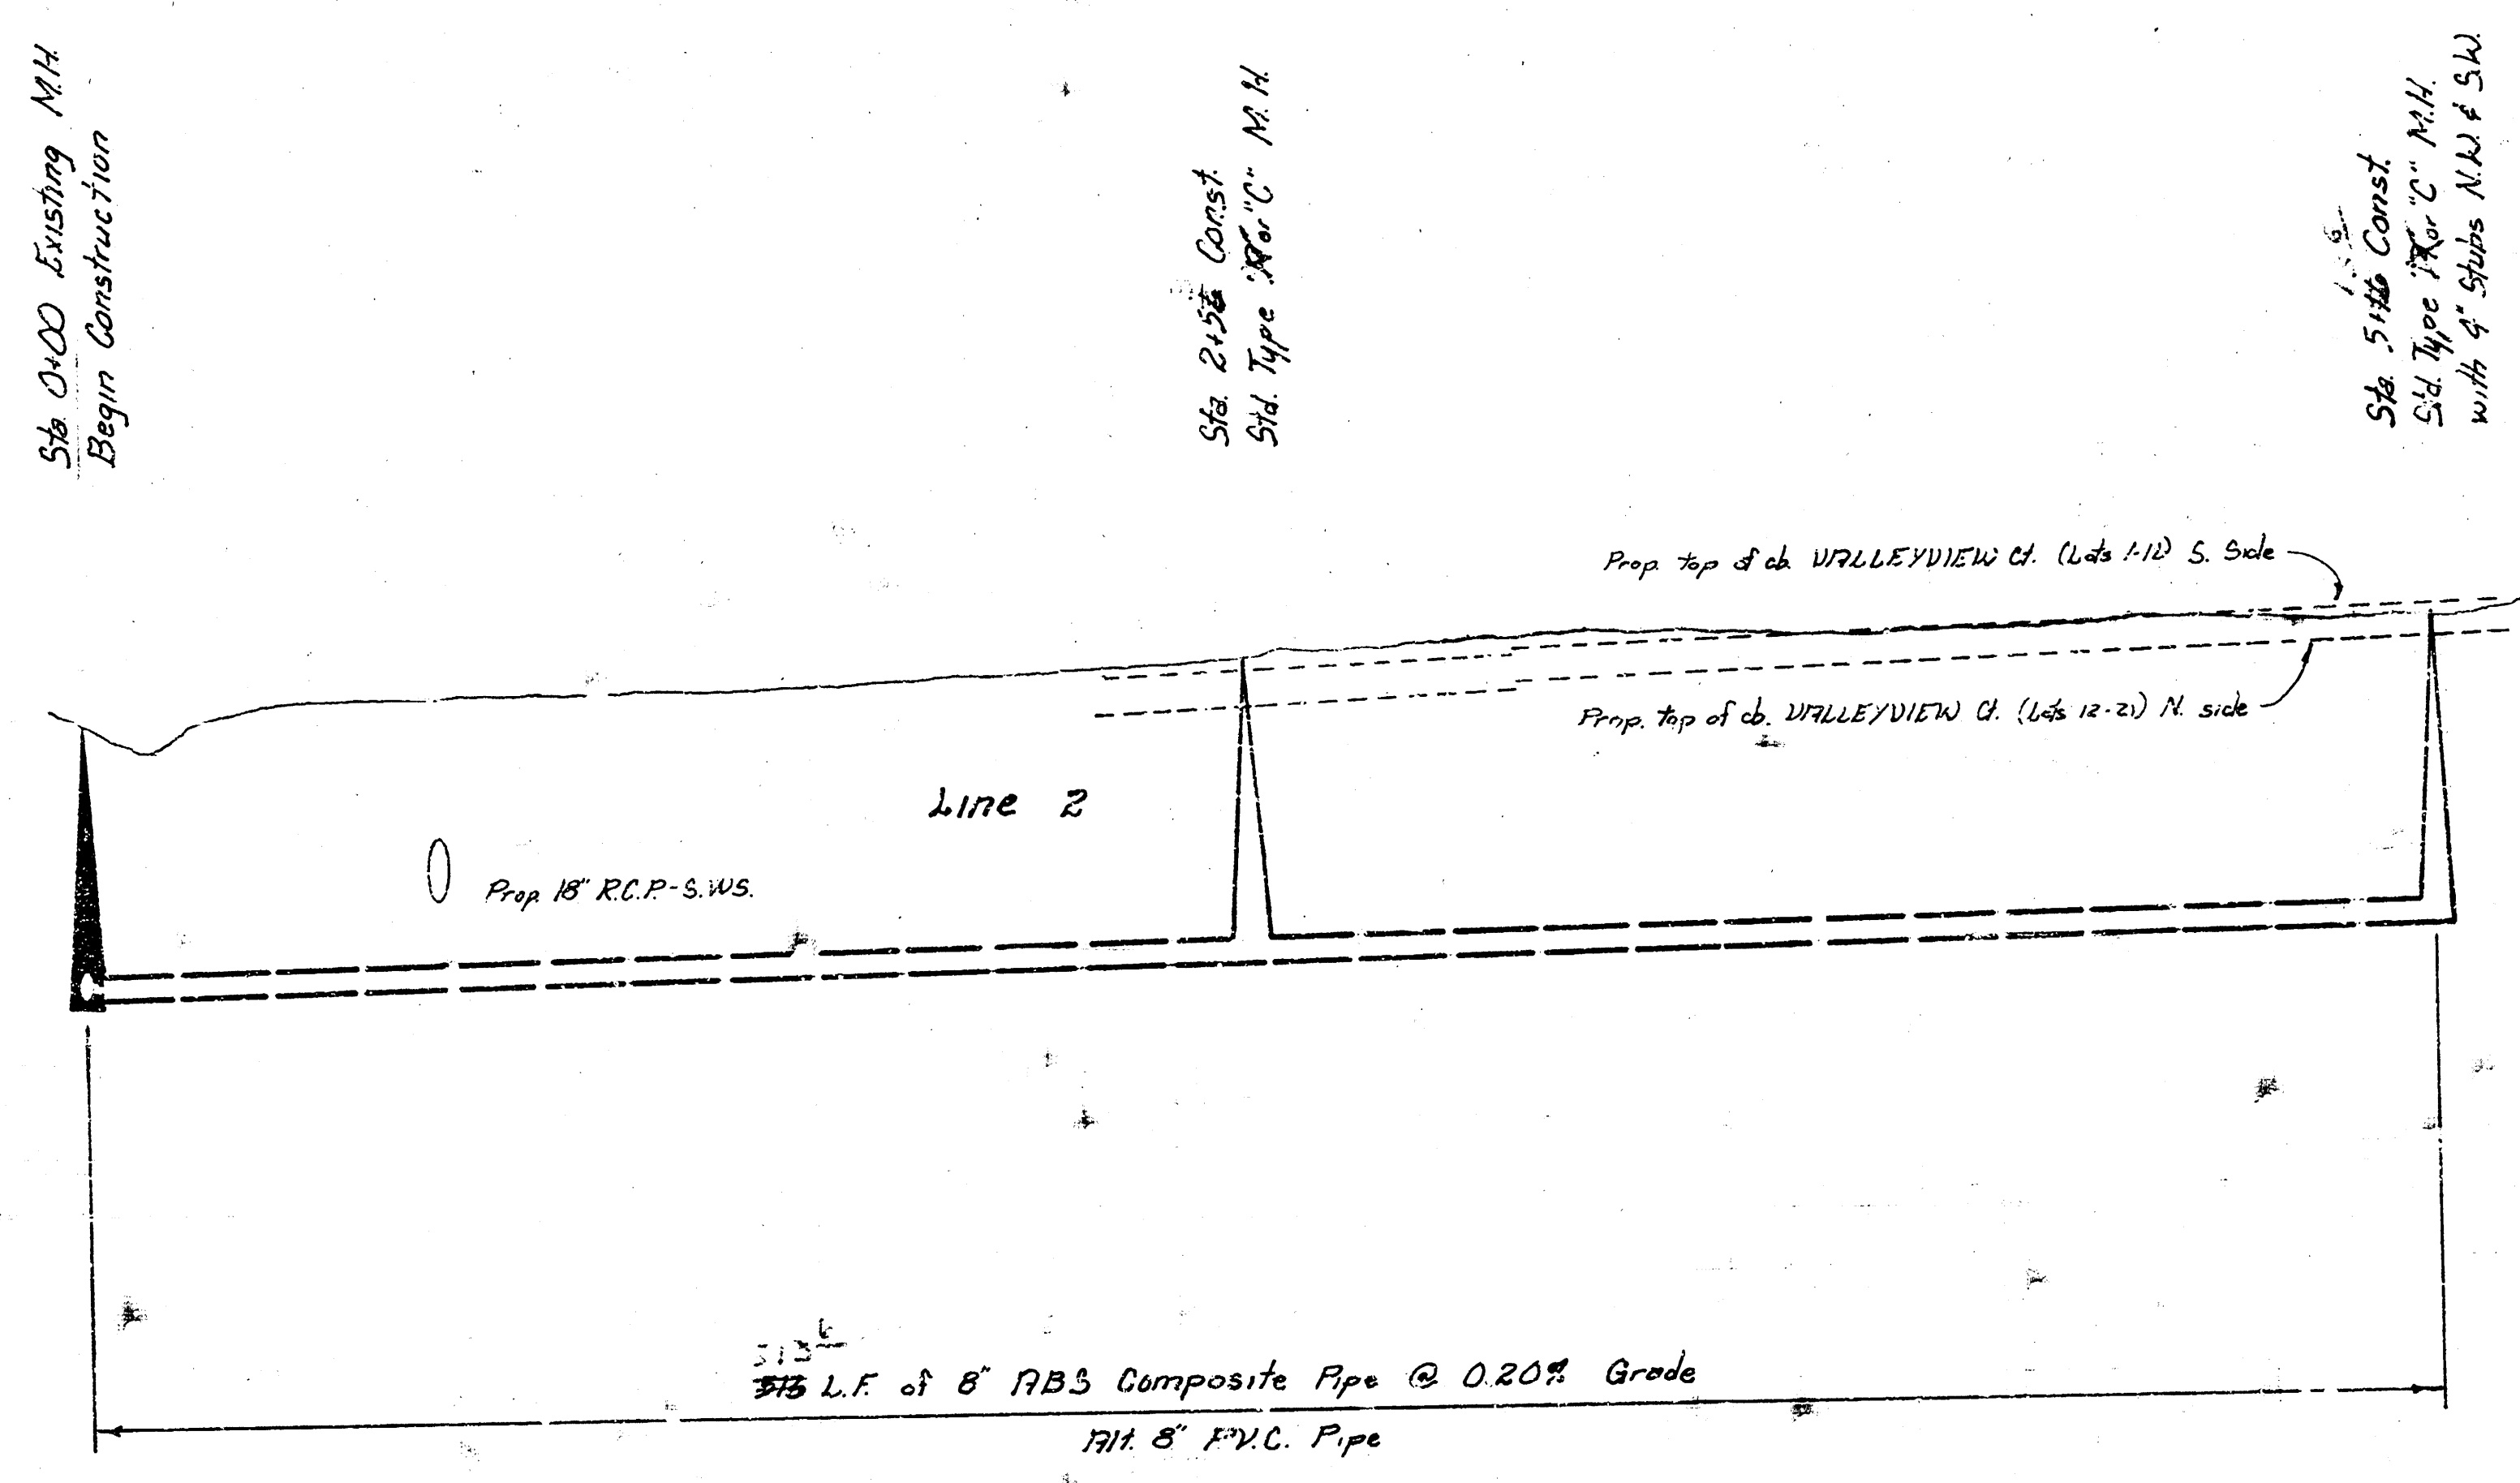

146.00 Ft Out
 146.10 Ft In
 146.30
 146.50
 146.61 Ft
 146.70
 146.90
 147.10
 147.13 Ft


NOTE: CONTRACTOR SHALL GIVE OWNERS OF LOTS 2 & 4 A MINIMUM ADVANCE NOTICE OF 48 HOURS BEFORE BEGINNING CONSTRUCTION ON LINE NO. 3. CONTRACTOR WILL BE REQUIRED TO RESTORE ANY IMPROVEMENTS OR VEGETATION DISTURBED ON THESE LOTS TO A CONDITION EQUAL TO OR BETTER THAN THE ORIGINAL CONDITION. THIS WORK WILL BE PAID FOR AT THE UNIT PRICE \$7.00 FOR SITE PREPARATION AND STORAGE.

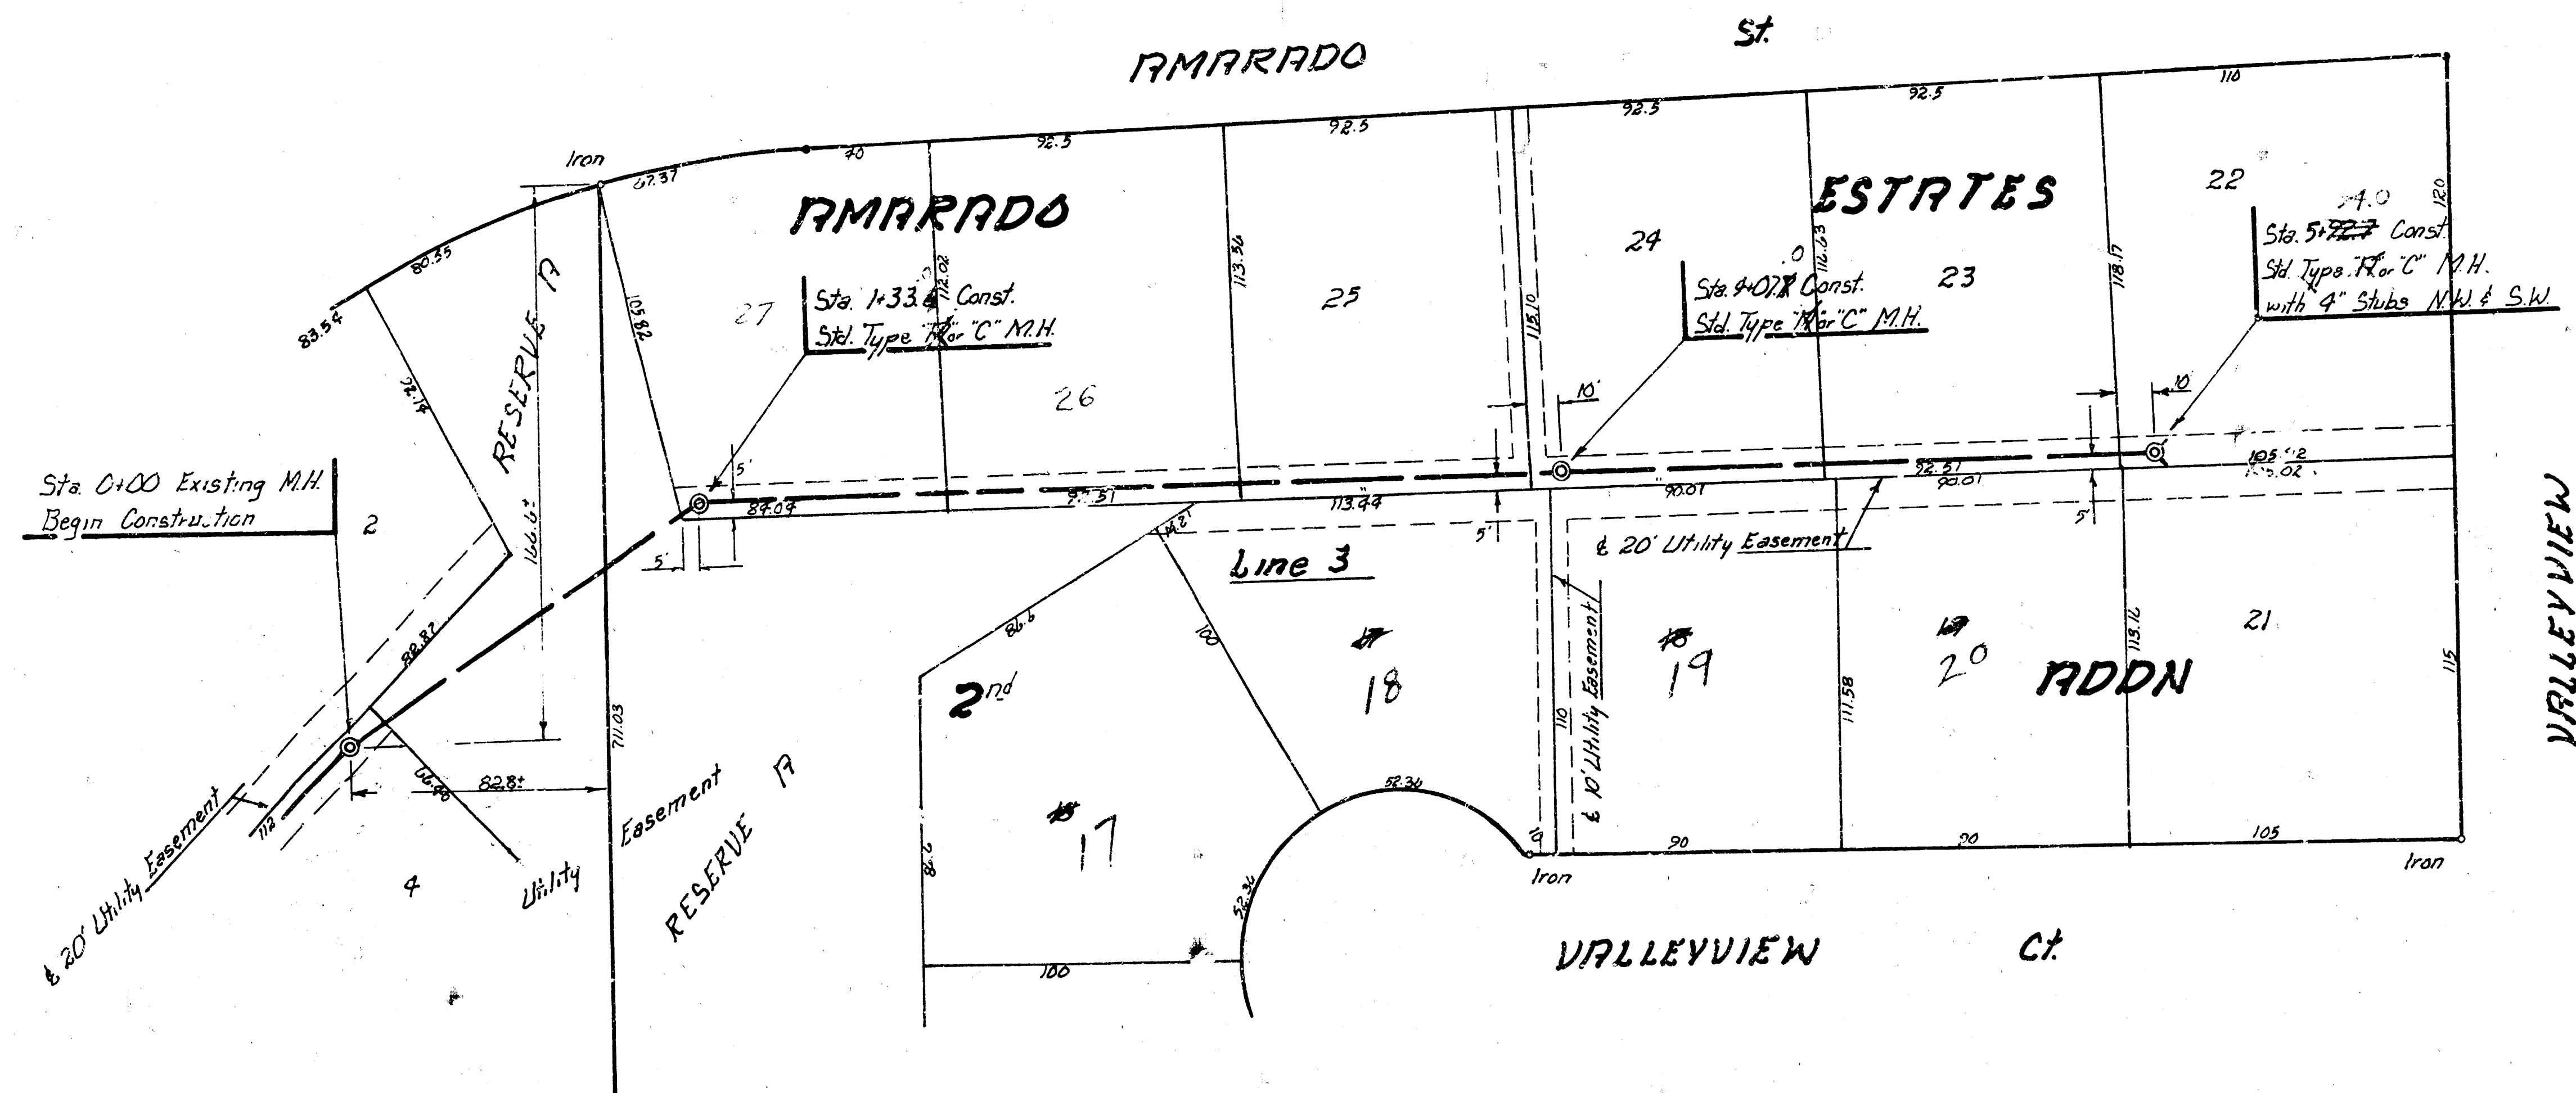

SCALE

Plan 1" = 20'
Profile 1" = 5'
Vert 1" = 5'
Horz 1" = 20'

155
150
145
140

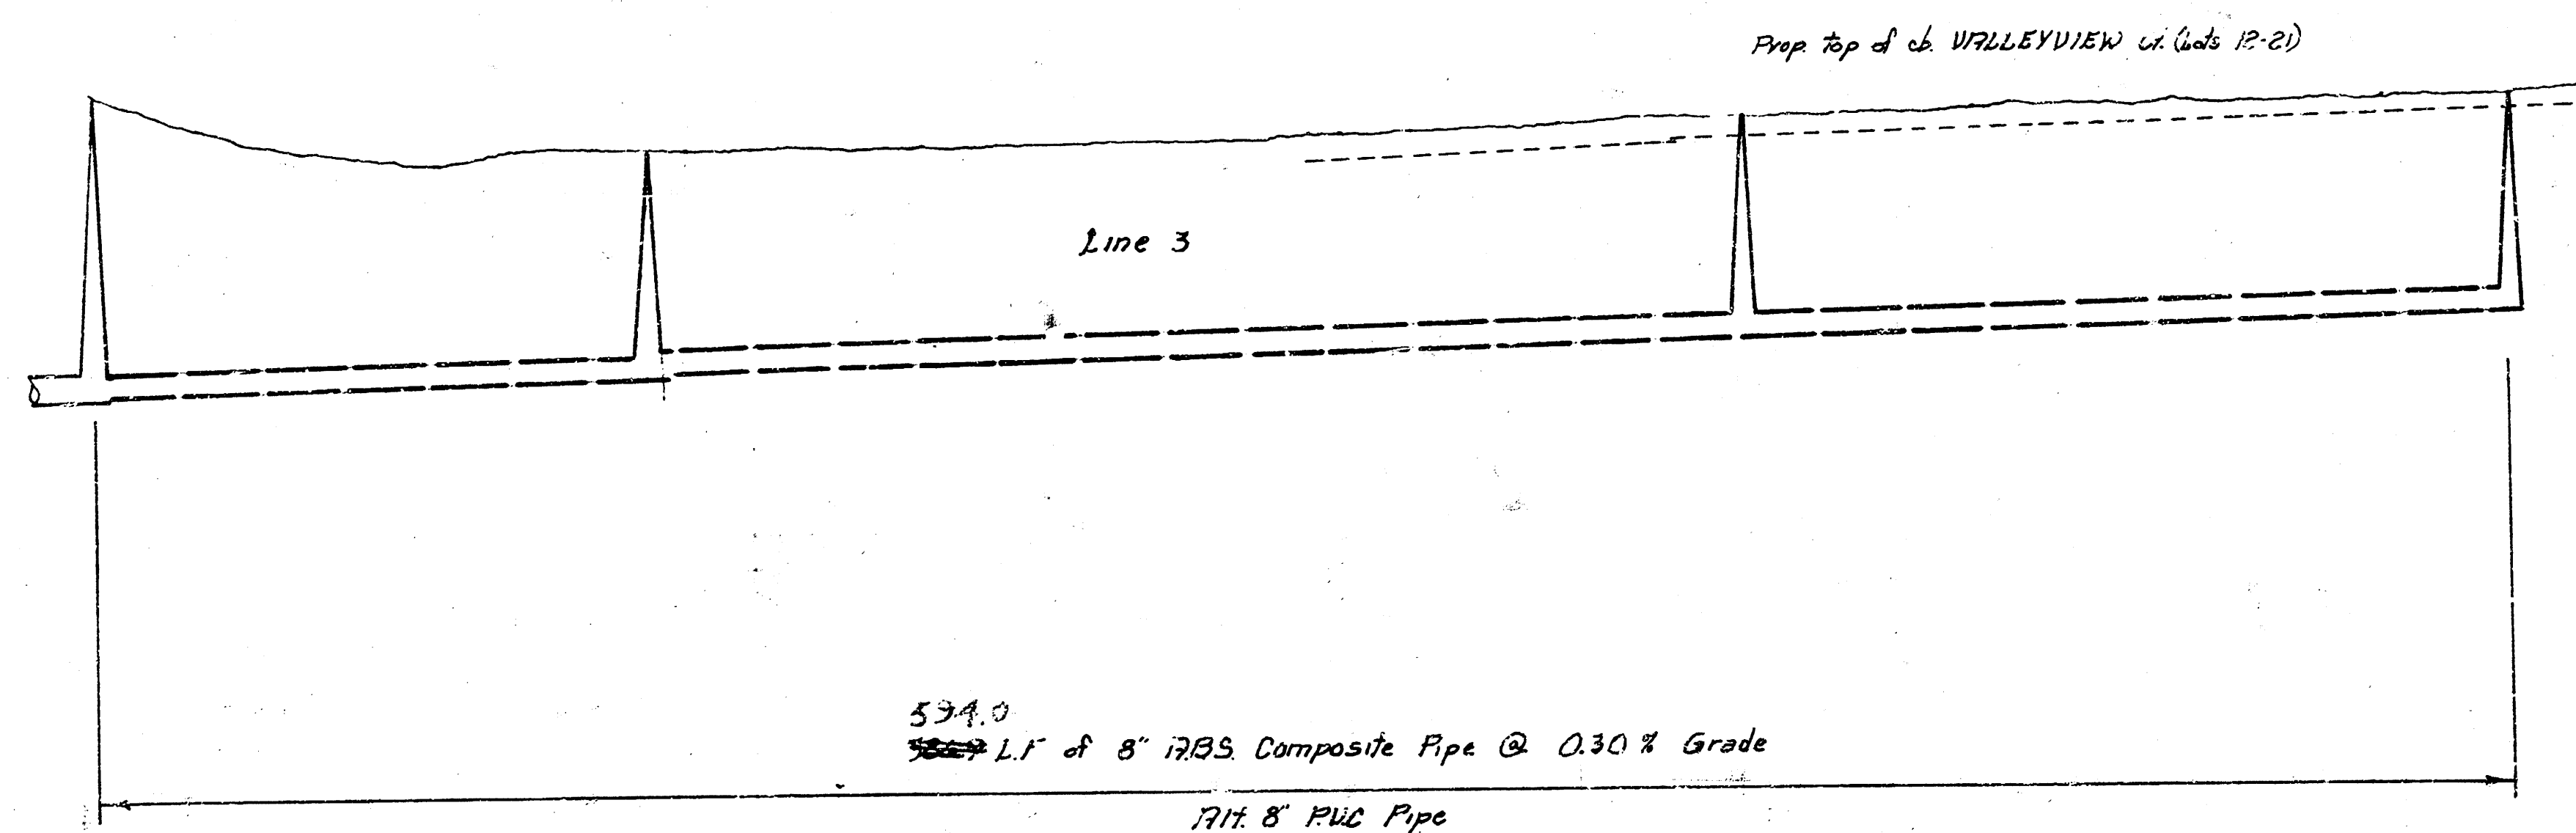

146.95 1% Out
146.65 1% In

146.95

147.05 1% Out
147.15 1% In

2

147.65

147.95

148.25

148.53