LATERAL 4, MAIN 4
WESTLINK SEWER

PROJECT NUMBER
468-76-245-81408-000-000-001

As Built
J.L.L.
8/85

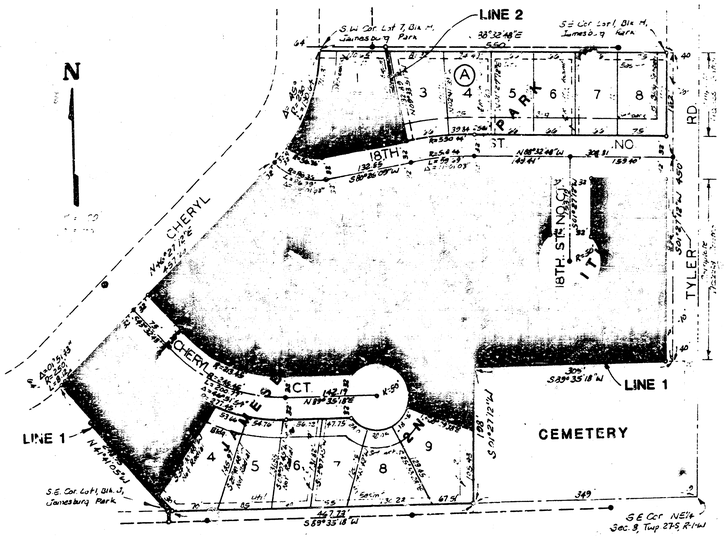

BENEFIT DISTRICT

GENERAL NOTES

The contractor shall be responsible for preserving property irons. The contractor shall be required to re-establish any property irons which are damaged or destroyed by his construction operations. Such irons shall be re-established by a licensed land surveyor or a professional engineer in accordance with state laws.

The contractor shall contact the utility companies for any proposed or existing underground lines which they may have in the vicinity of this project.

The contractor shall co-ordinate sewer construction with the construction of a proposed water line in Cheryl Court.

Contractor shall provide 48 hours notice to owners of developed lots prior to beginning construction. Contractor shall restore to original condition any grassed lawns, flower gardens, etc. Cost shall be incidental to the project.

CITY OF WICHITA, KANSAS
MICHAEL E. LINDEBAK CITY ENGINEER

THOMAS CHARLES PRICE LICENSED 9621 LAND SURVEYOR

BAUGHMAN COMPANY, P.A.
SURVEYING & ENGINEERING
316/262-7271 • 330 LAURA • WICHITA, KANSAS 67211

1/5

BENCH MARK: W. RIM OF MANHOLE, 56' S.E. OF S.W. COR. LOT 4, JAMESBURG PARK 2ND ADD., ELEV. 1656

STA. 0+00 CONSTRUCT TYPE ~~"B"~~ "C" STD. MH OVER EXISTING LINE. TOP 165.55

STA. 1+87.70 CONSTRUCT TYPE "A" OR "B" STD. MH TOP 162.82 161.93

STA. 0+212 CONSTRUCT TYPE "A" OR "C" STD. MH TOP 165.39

STA. 4+75.89 CONSTRUCT TYPE ~~"B"~~ "C" STD. MH TOP ~~163.89~~ 163.09

ADD

11th

JAMESBURG

PARK

WESTLINK

VILLAGE

20' UTILITY EASEMENT

30' UTILITY EASEMENT

CHERYL

2ND

ADD.

CHERYL COURT

20' SEWER EASEMENT (BY SEP. INSTR.)

PROPOSED PAVT.

PROPOSED WATER MAIN

AS BUILT J.L.L. 8-95

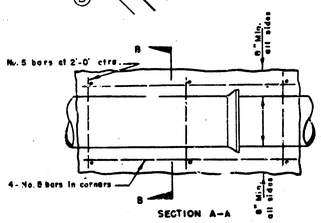

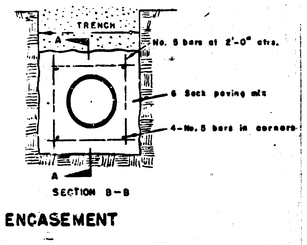

REINFORCED CONCRETE ENCASEMENT FOR STRENGTH

LINE 1

PLAN SCALE 1"=40'
PROFILE SCALE
1"=40' HORIZ.
1"=5' VERT.

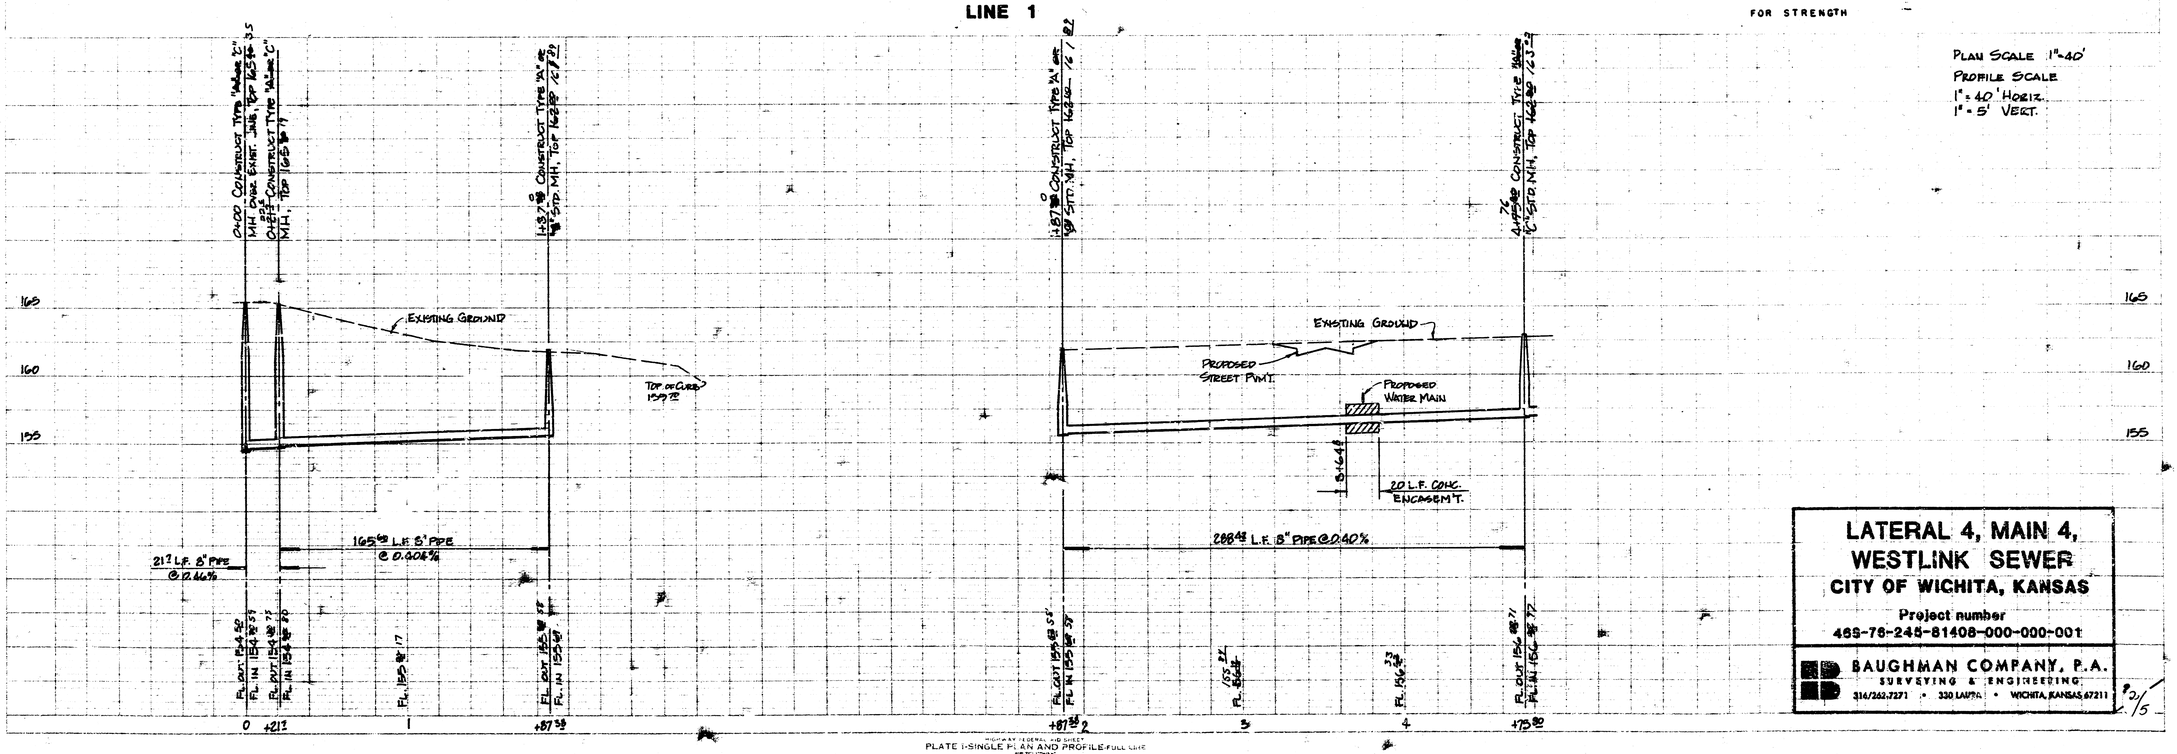

PROFILE
NOTE: ALL ELEVATIONS ARE BASED ON M.S.L. DATUM
Ref. Dr. 223

HIGHWAY FEDERAL AID SHEET
PLATE I-SINGLE PLAN AND PROFILE-FULL SIZE
METRIC
PRINTED IN U.S.A.

LATERAL 4, MAIN 4, WESTLINK SEWER
CITY OF WICHITA, KANSAS
Project number
465-78-245-81408-000-000-001

BAUGHMAN COMPANY, P.A.
SURVEYING & ENGINEERING
316/262-7271 • 330 LAURA • WICHITA, KANSAS, 67211

2/5

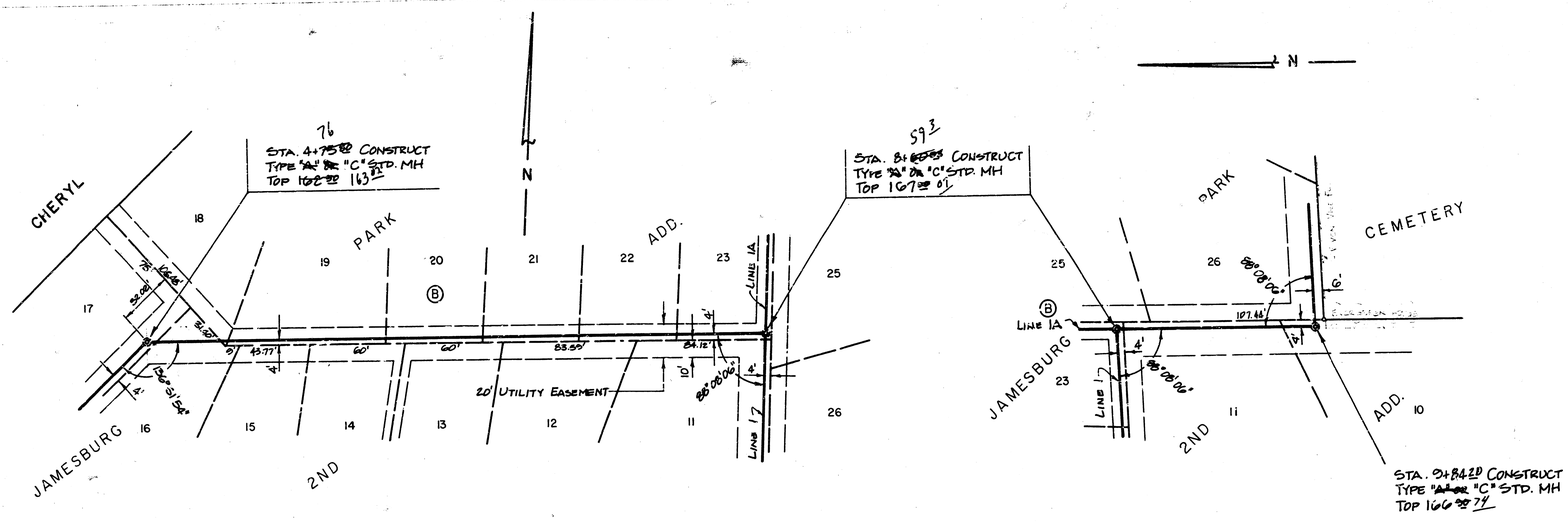

A/B 8/85 J.L.L.

LINE 1

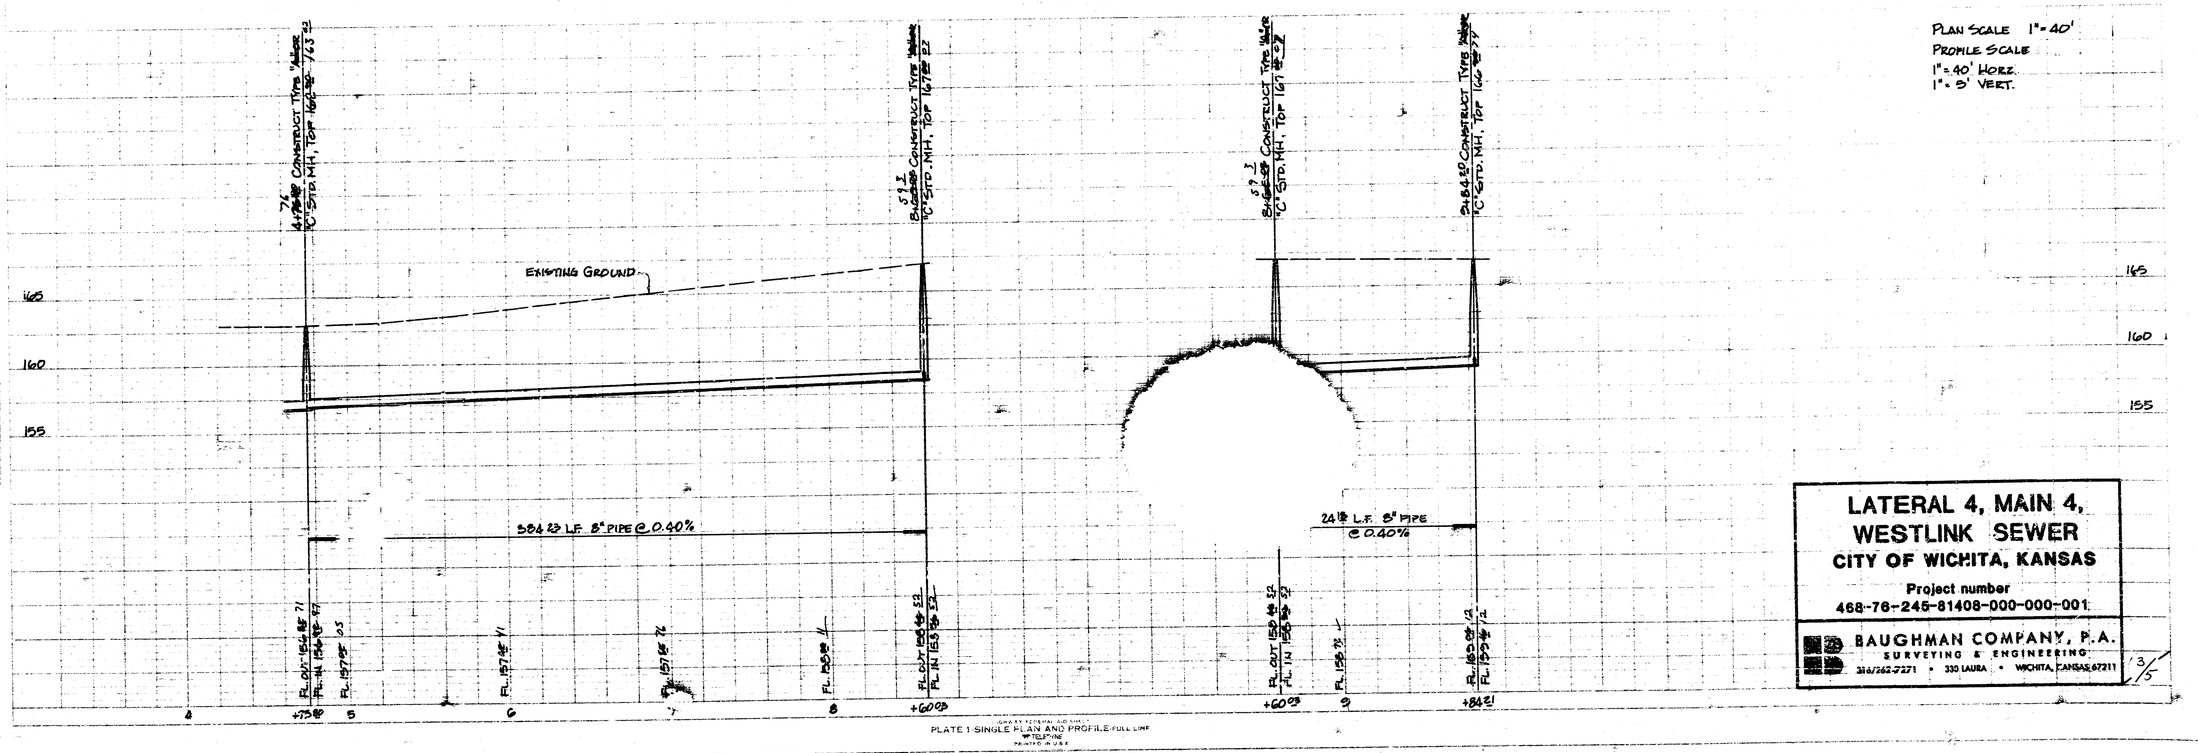

PLAN SCALE 1"=40'
PROFILE SCALE
1"=40' HORZ.
1"=5' VERT.

PLATE 1 SINGLE PLAN AND PROFILE-FULL LINE

LATERAL 4, MAIN 4, WESTLINK SEWER
CITY OF WICHITA, KANSAS

Project number
468-76-245-81408-000-000-001

BAUGHMAN COMPANY, P.A.
SURVEYING & ENGINEERING
316/262-7271 • 330 LAURA • WICHITA, KANSAS 67211

3/5

BENCH MARK: CITY OF WICHITA STD. DISC, 31' S. AND 36' E. OF 1/4 SEC. COR. @ 17TH & TYLER. ELEV. 1,249

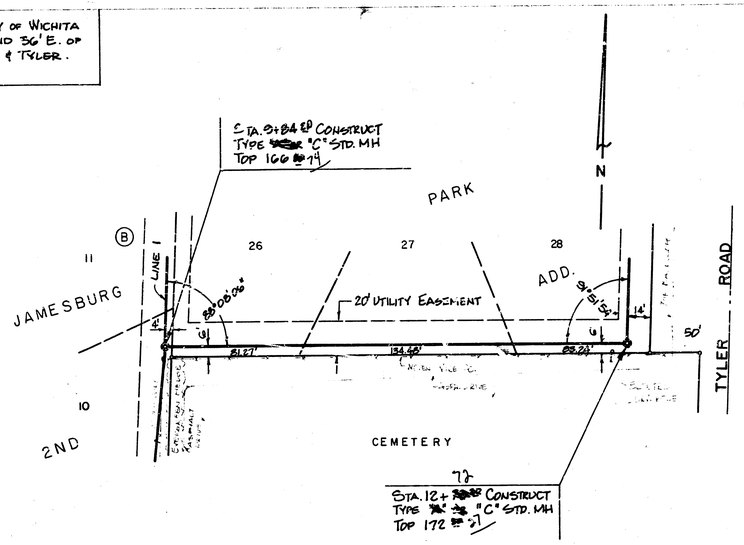

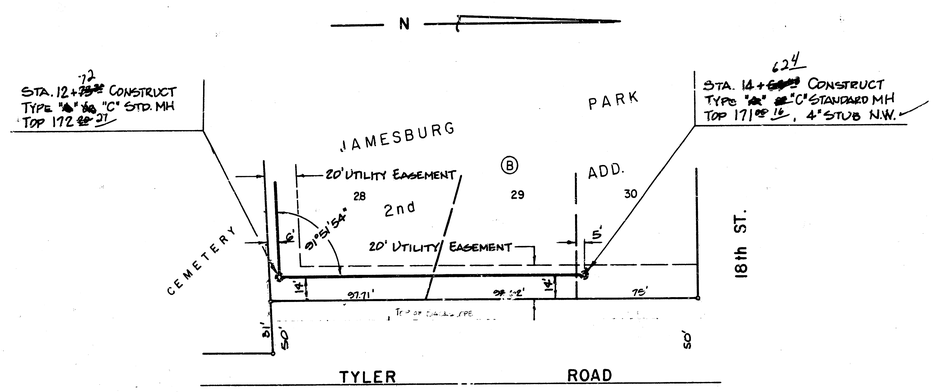

As Built J.L.L. 8/85

LINE 1

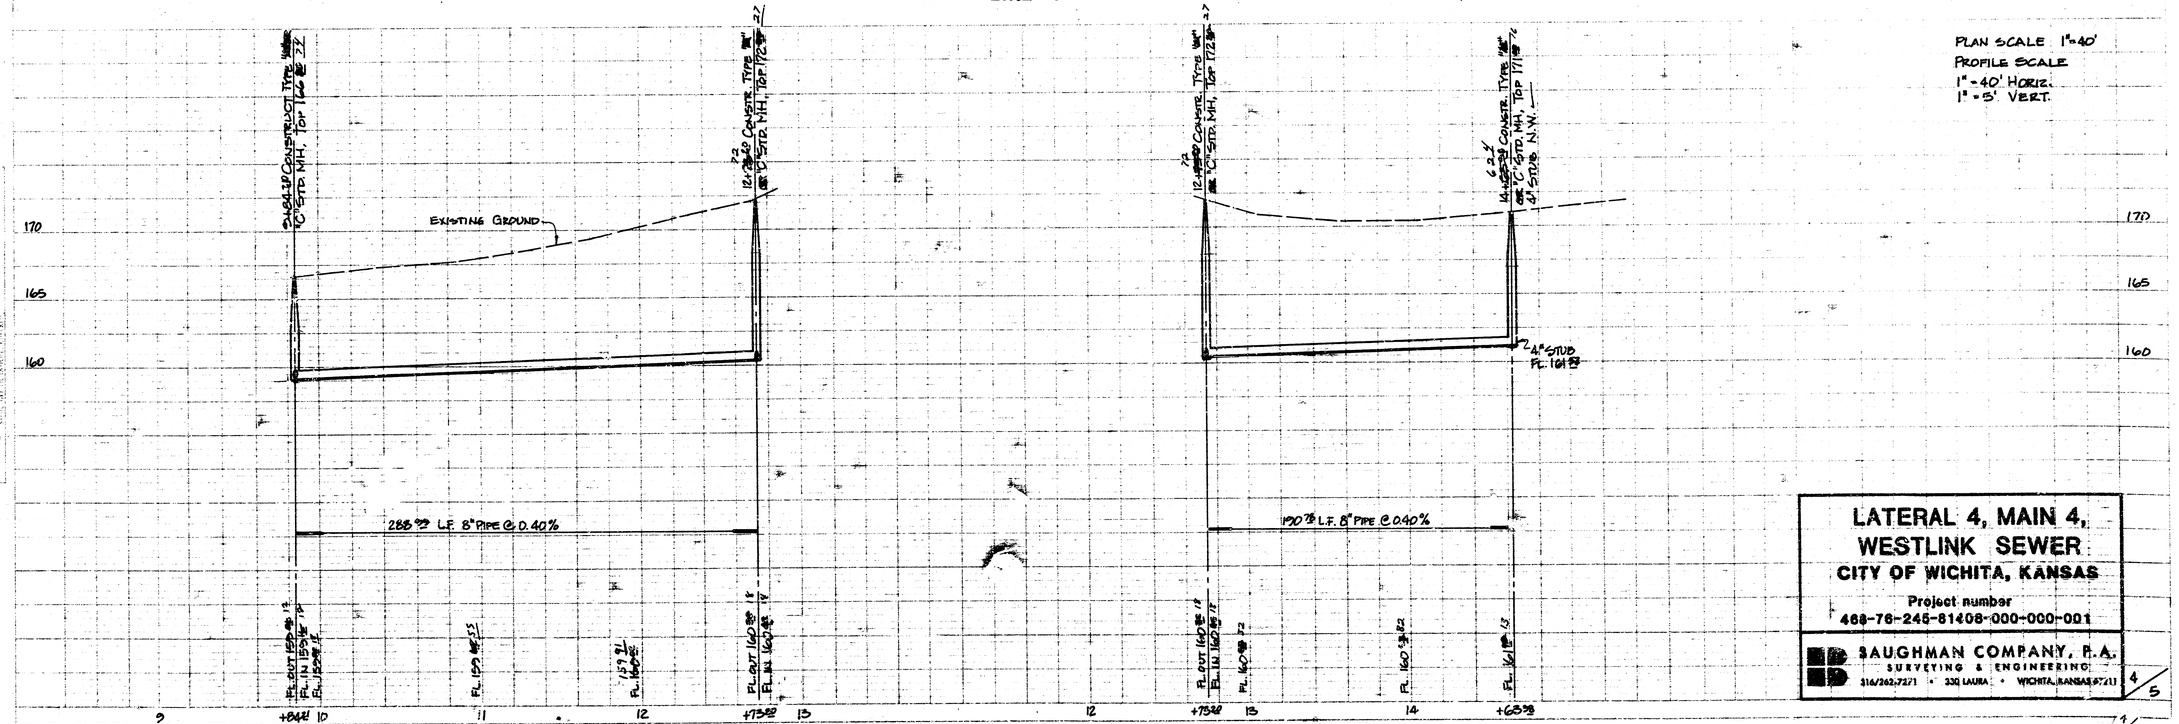

PROFILE
NO. BA-22

LATERAL 4, MAIN 4,
WESTLINK SEWER
CITY OF WICHITA, KANSAS
Project number
468-76-245-81408-000-000-001

SAUGHMAN COMPANY, P.A.
SURVEYING & ENGINEERING
316/262-7271 • 330 LAURA • WICHITA, KANSAS 67211

4/5

PLATE 1-SINGLE PLAN AND PROFILE-FULL LINE
TELELINE
PRINTED IN U.S.A.

11/5

BENCH MARK: TOP OF IRON @ S.W. CORNER LOT 5, BLOCK A, JAMESBURG PARK 2ND ADD. ELEV. 1678'

N

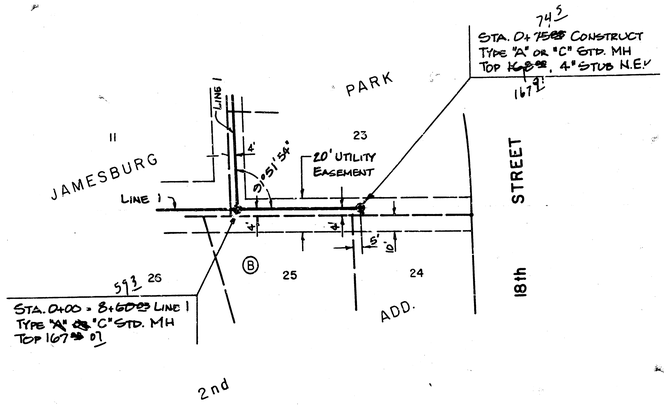

STA. 0+74.5 CONSTRUCT TYPE "A" OR "C" STD. MH TOP ~~1678~~ 1679', 4" STUB N.E.

STA. 0+00 = 8+60.3 LINE 1 TYPE ~~"A"~~ "C" STD. MH TOP 1678.91

N

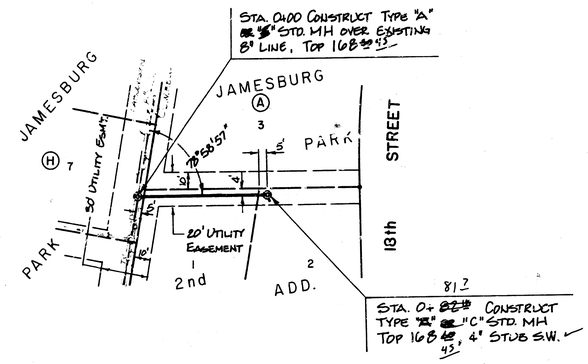

STA. 0+00 CONSTRUCT TYPE "A" ~~5'~~ 4' STD. MH OVER EXISTING 8" LINE, TOP 1683.43

STA. 0+~~82.18~~ 81.7 CONSTRUCT TYPE ~~"A"~~ "C" STD. MH TOP 1683.43, 4" STUB S.W.

As Built
J.L.L.
8/05

LINE 1A

STA. 0+00 = 8+60.3 (LINE 1) TYPE ~~"A"~~ "C" STD. MH, TOP 1678.91

STA. 0+74.5 CONSTRUCT TYPE ~~"A"~~ "C" STD. MH, TOP ~~1680.0~~ 1679, 4" ST. N.E.

4" STUB ~~EL. 1599.0~~

FL. OUT 1596.32
FL. IN 1596.57

FL. OUT 1596.57

0

+75.0

75.0 L.F. 8" PIPE @ 0.40%

LINE 2

0+00 CONSTRUCT TYPE "A" MH OVER EXIST. LINE, TOP 1683.43

STA. 0+81.7 CONSTRUCT TYPE "C" MH, TOP 1683.43, 4" STUB S.W.

EXISTING GROUND

4" STUB EL. 1599.0

FL. OUT 1595.44
FL. IN 1595.69

FL. 1595.96

0

+82.18

82.18 L.F. 8" PIPE @ 1.01%

PLAN SCALE 1"=40'
PROFILE SCALE
1"=40' HORZ.
1"=5' VERT.

PROFILL
NOTE FOUR SMALL SQUARES
No. BA 22

PLATE 1-SINGLE PLAN AND PROFILE FULL LINE
*MITSEDYE
PRINTED IN U.S.A.

LATERAL 4, MAIN 4, WESTLINK SEWER
CITY OF WICHITA, KANSAS

Project number
468-76-245-81408-000-000-001

BAUGHMAN COMPANY, P.A.
SURVEYING & ENGINEERING
316/262-7271 • 330 LAURA • WICHITA, KANSAS 67211

S 5

Sheet 10 of 13