



SECTIONAL PLAN  
Scale: 1/4" = 1'-0"

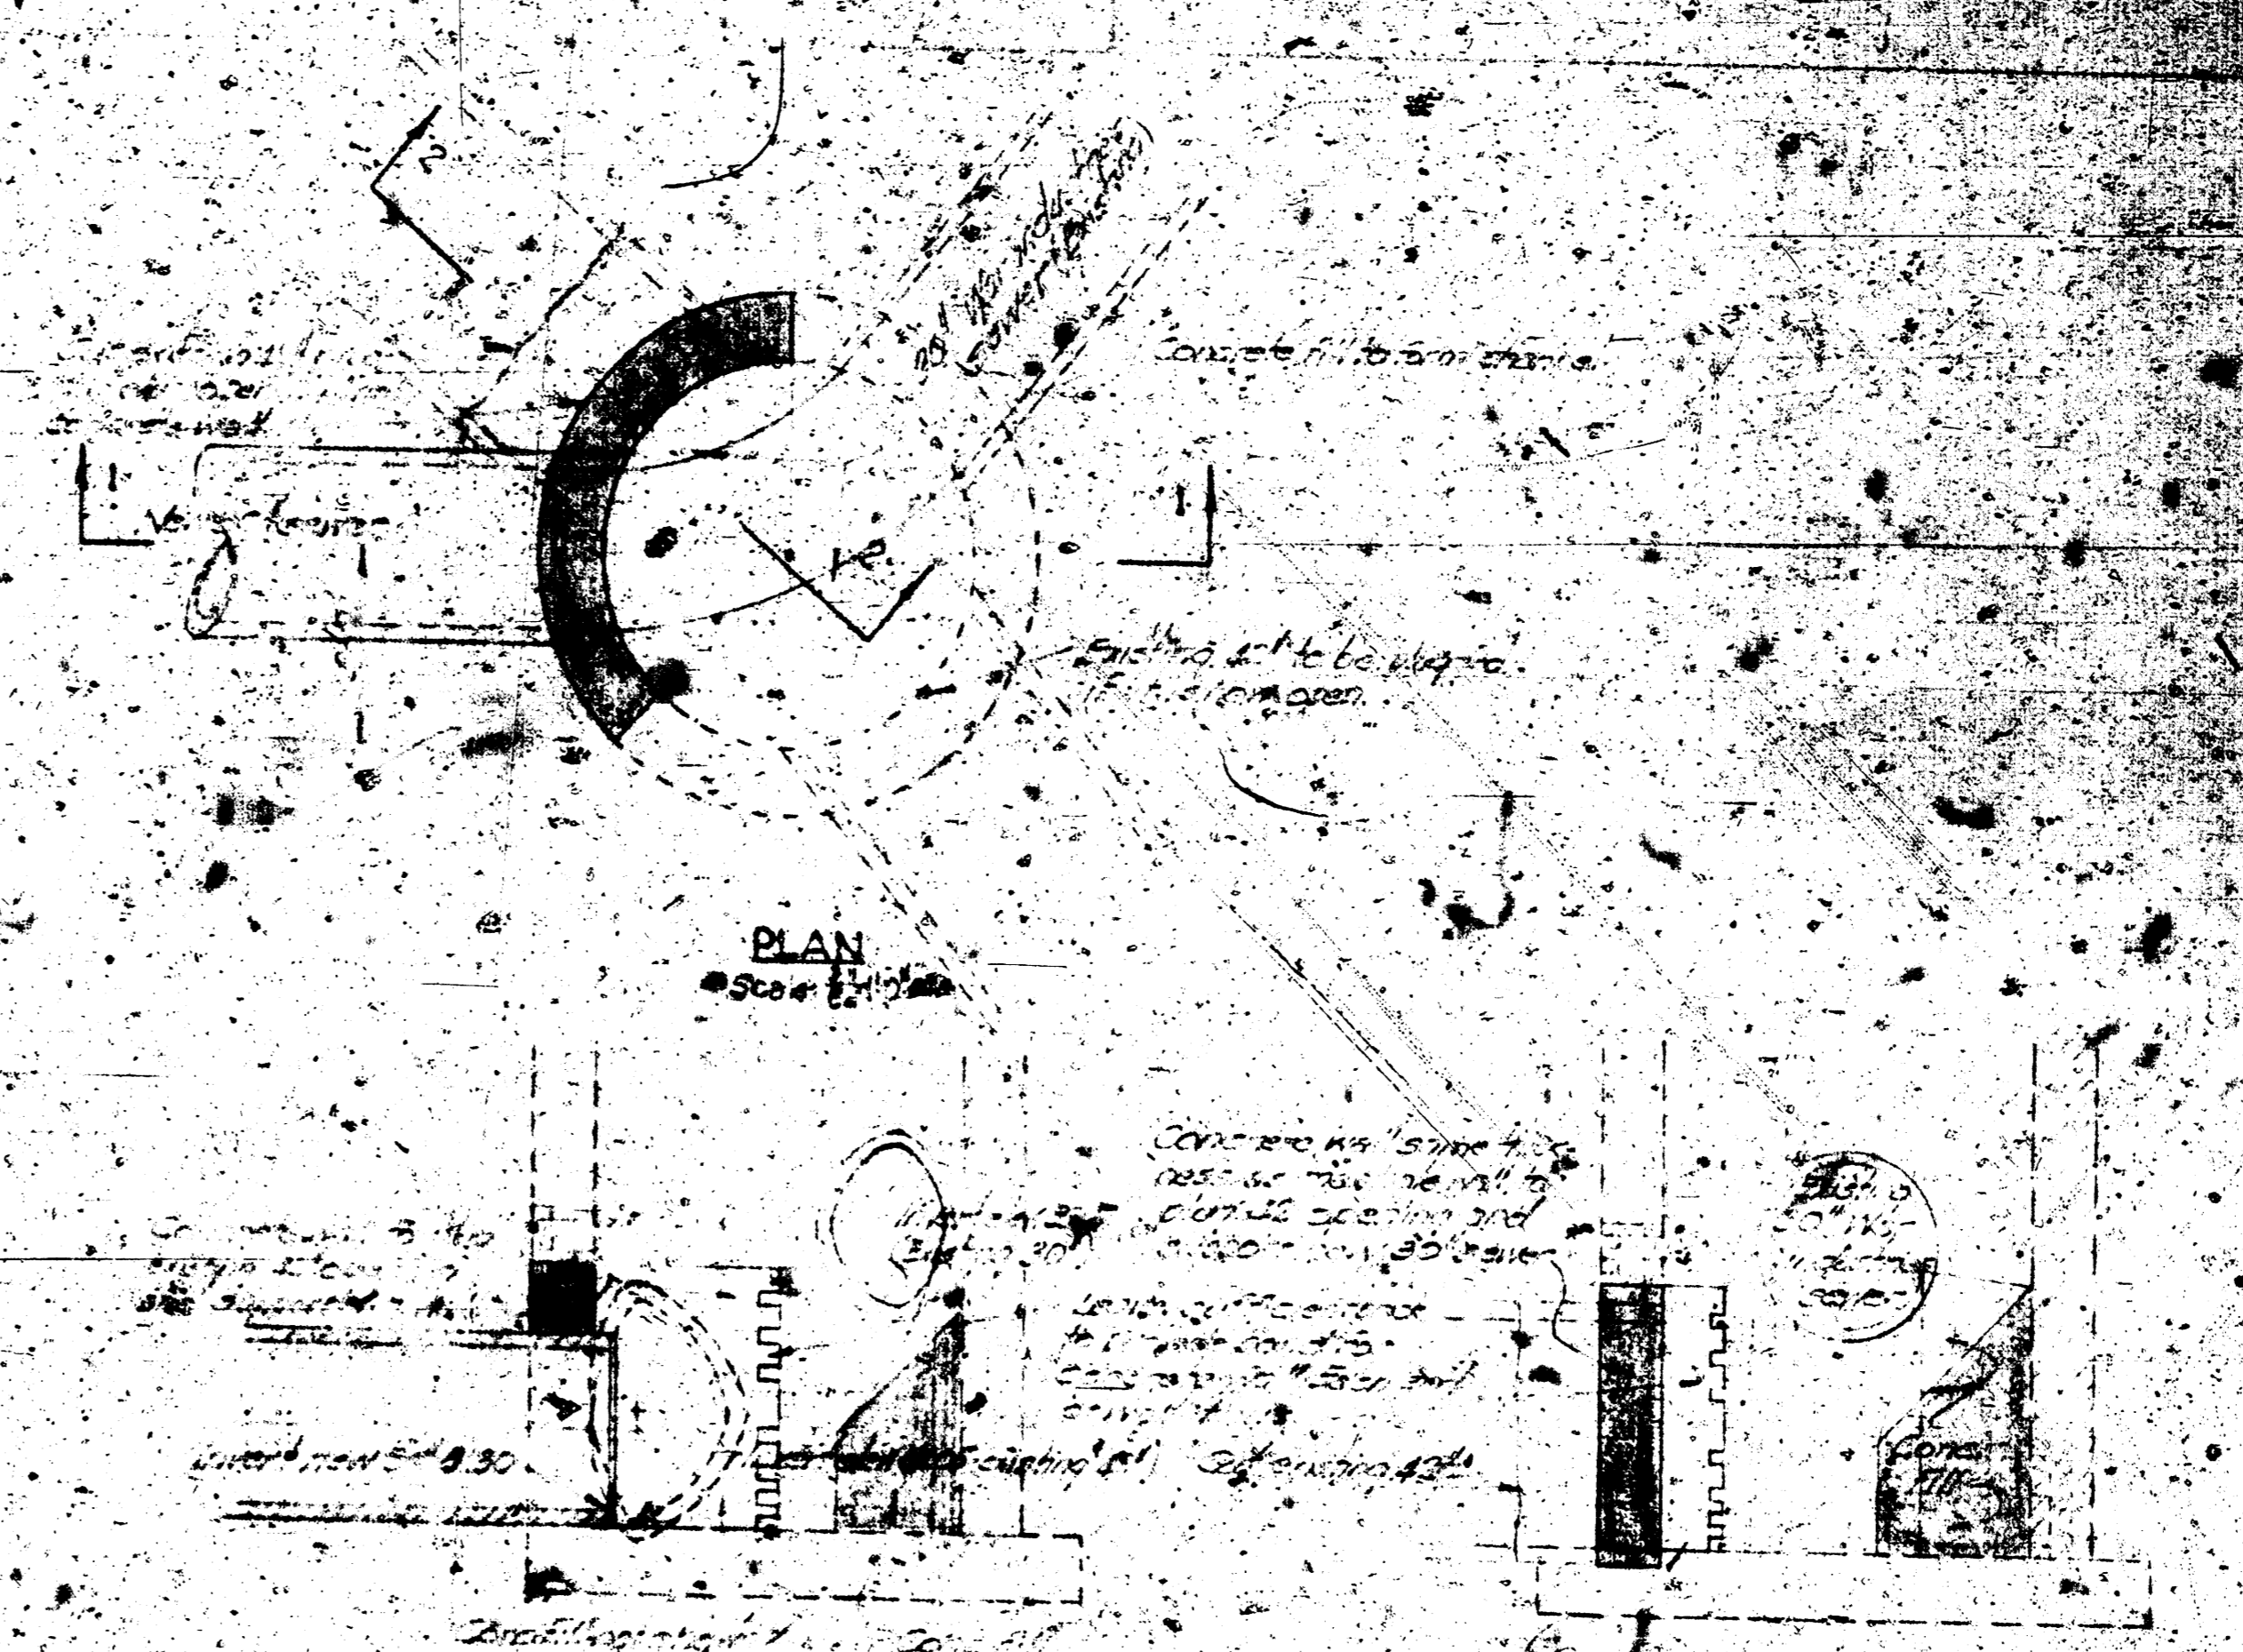

PLAN  
Scale: 1/4" = 1'-0"

 

SECTION A-A  
Scale: 1/4" = 1'-0"



SECTION B-B  
Scale: 1/4" = 1'-0"


DISTRIBUTION STRUCTURE DETAILS  
STA. 12 + 55

SECTION 1-1  
Scale: 1/4" = 1'-0"

SECTION 2-2  
Scale: 1/4" = 1'-0"

DETAILS OF 30" SEWER AT EXISTING MANHOLE - STA. 12 + 74


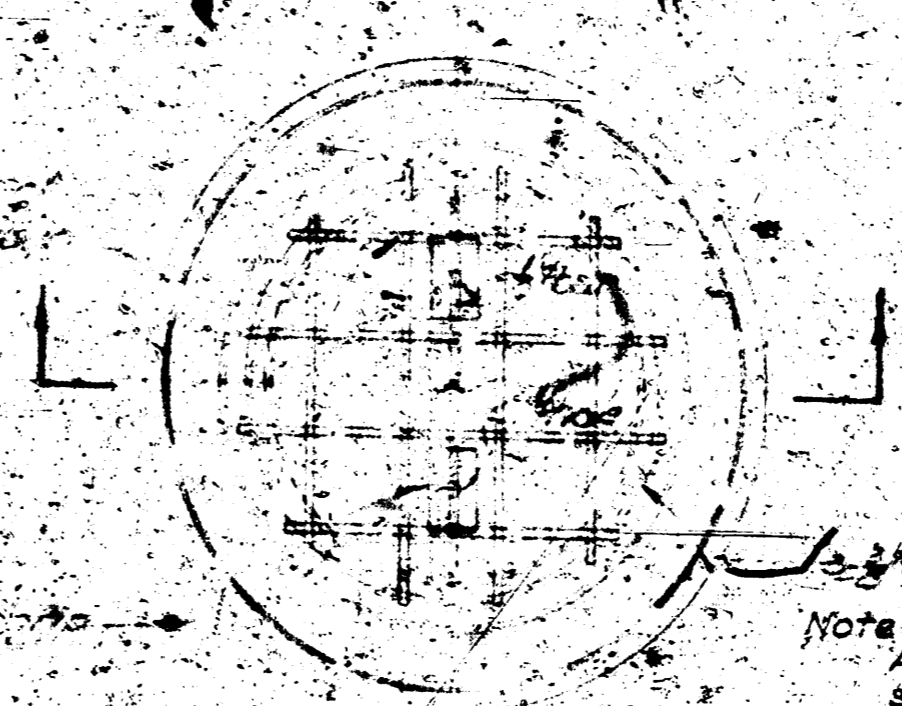

PLAN

Note: Factory built rings & covers, A.C.S.I. Std. or equal, as per specifications may be used in lieu of design indicated.

SECTION  
CONCRETE MANHOLE RING & COVER  
Scale: 1/4" = 1'-0"

10-14-43	Added Manhole & Stationing	L.S.F.
Revised Date	By	
WICHITA KANSAS		
WAR INDUSTRIES SEWER EXTENSION		
DISTRIBUTION STRUCTURE AND MANHOLE DETAILS		
BLAIR & VEATCH CONSULTING ENGINEERS, KANSAS CITY, MO. AUGUST 1943		
DESIGNED BY	TRACED BY	SHEET 2 OF 3
APPROVED	CHECKED	
	DATE	

