

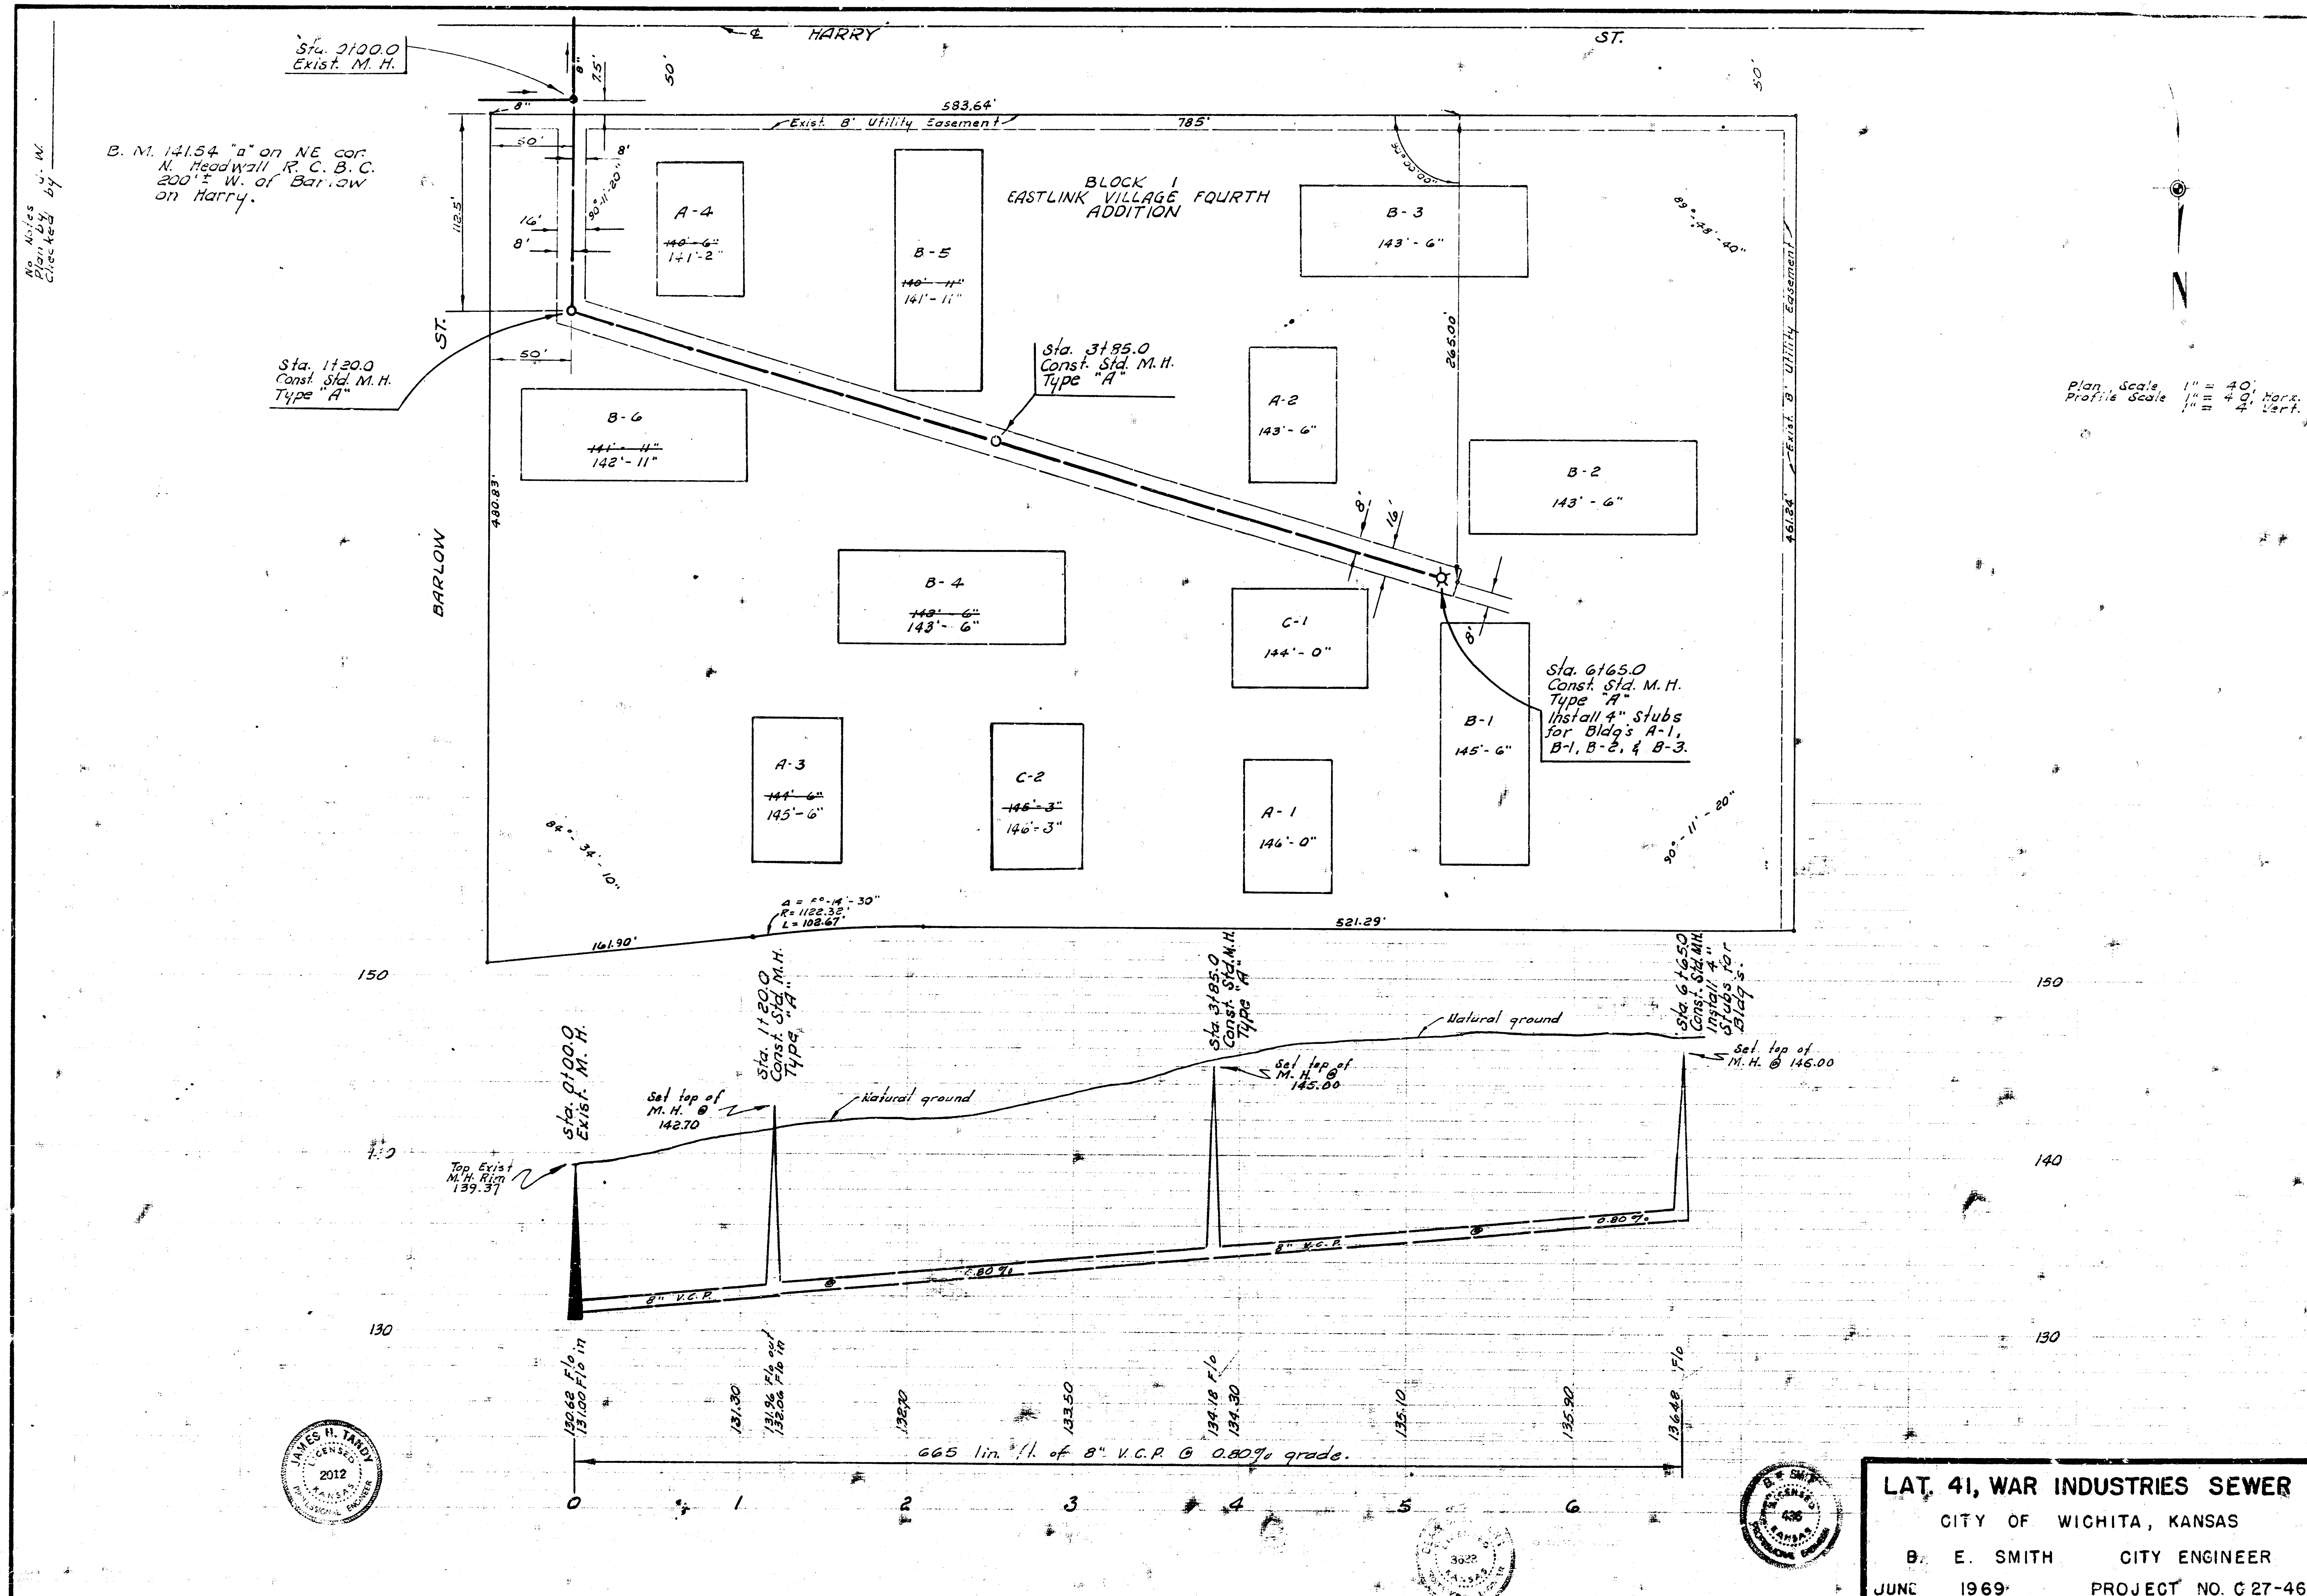


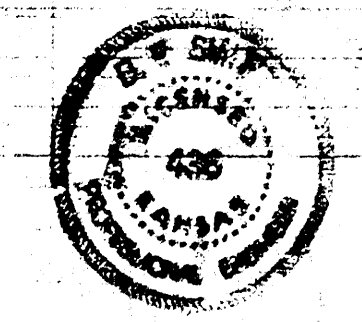

Plan Scale 1" = 40' hor.
Profile Scale 1" = 4' vert.

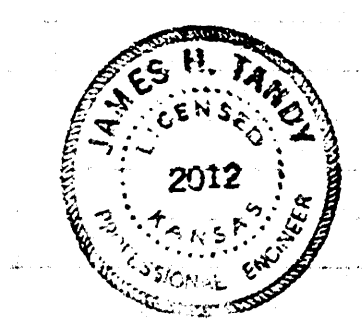

LAT 41, WAR INDUSTRIES SEWER
CITY OF WICHITA, KANSAS
B. E. SMITH CITY ENGINEER
JUNE 1969 PROJECT NO. C 27-46