

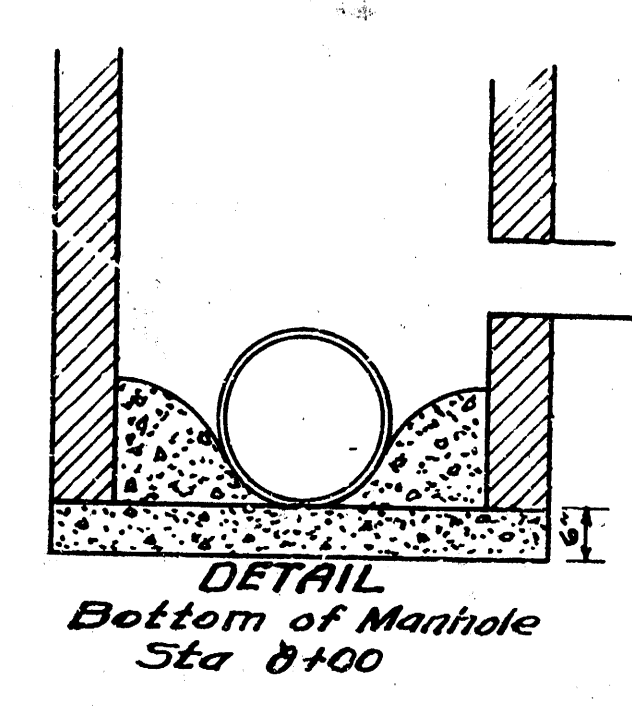


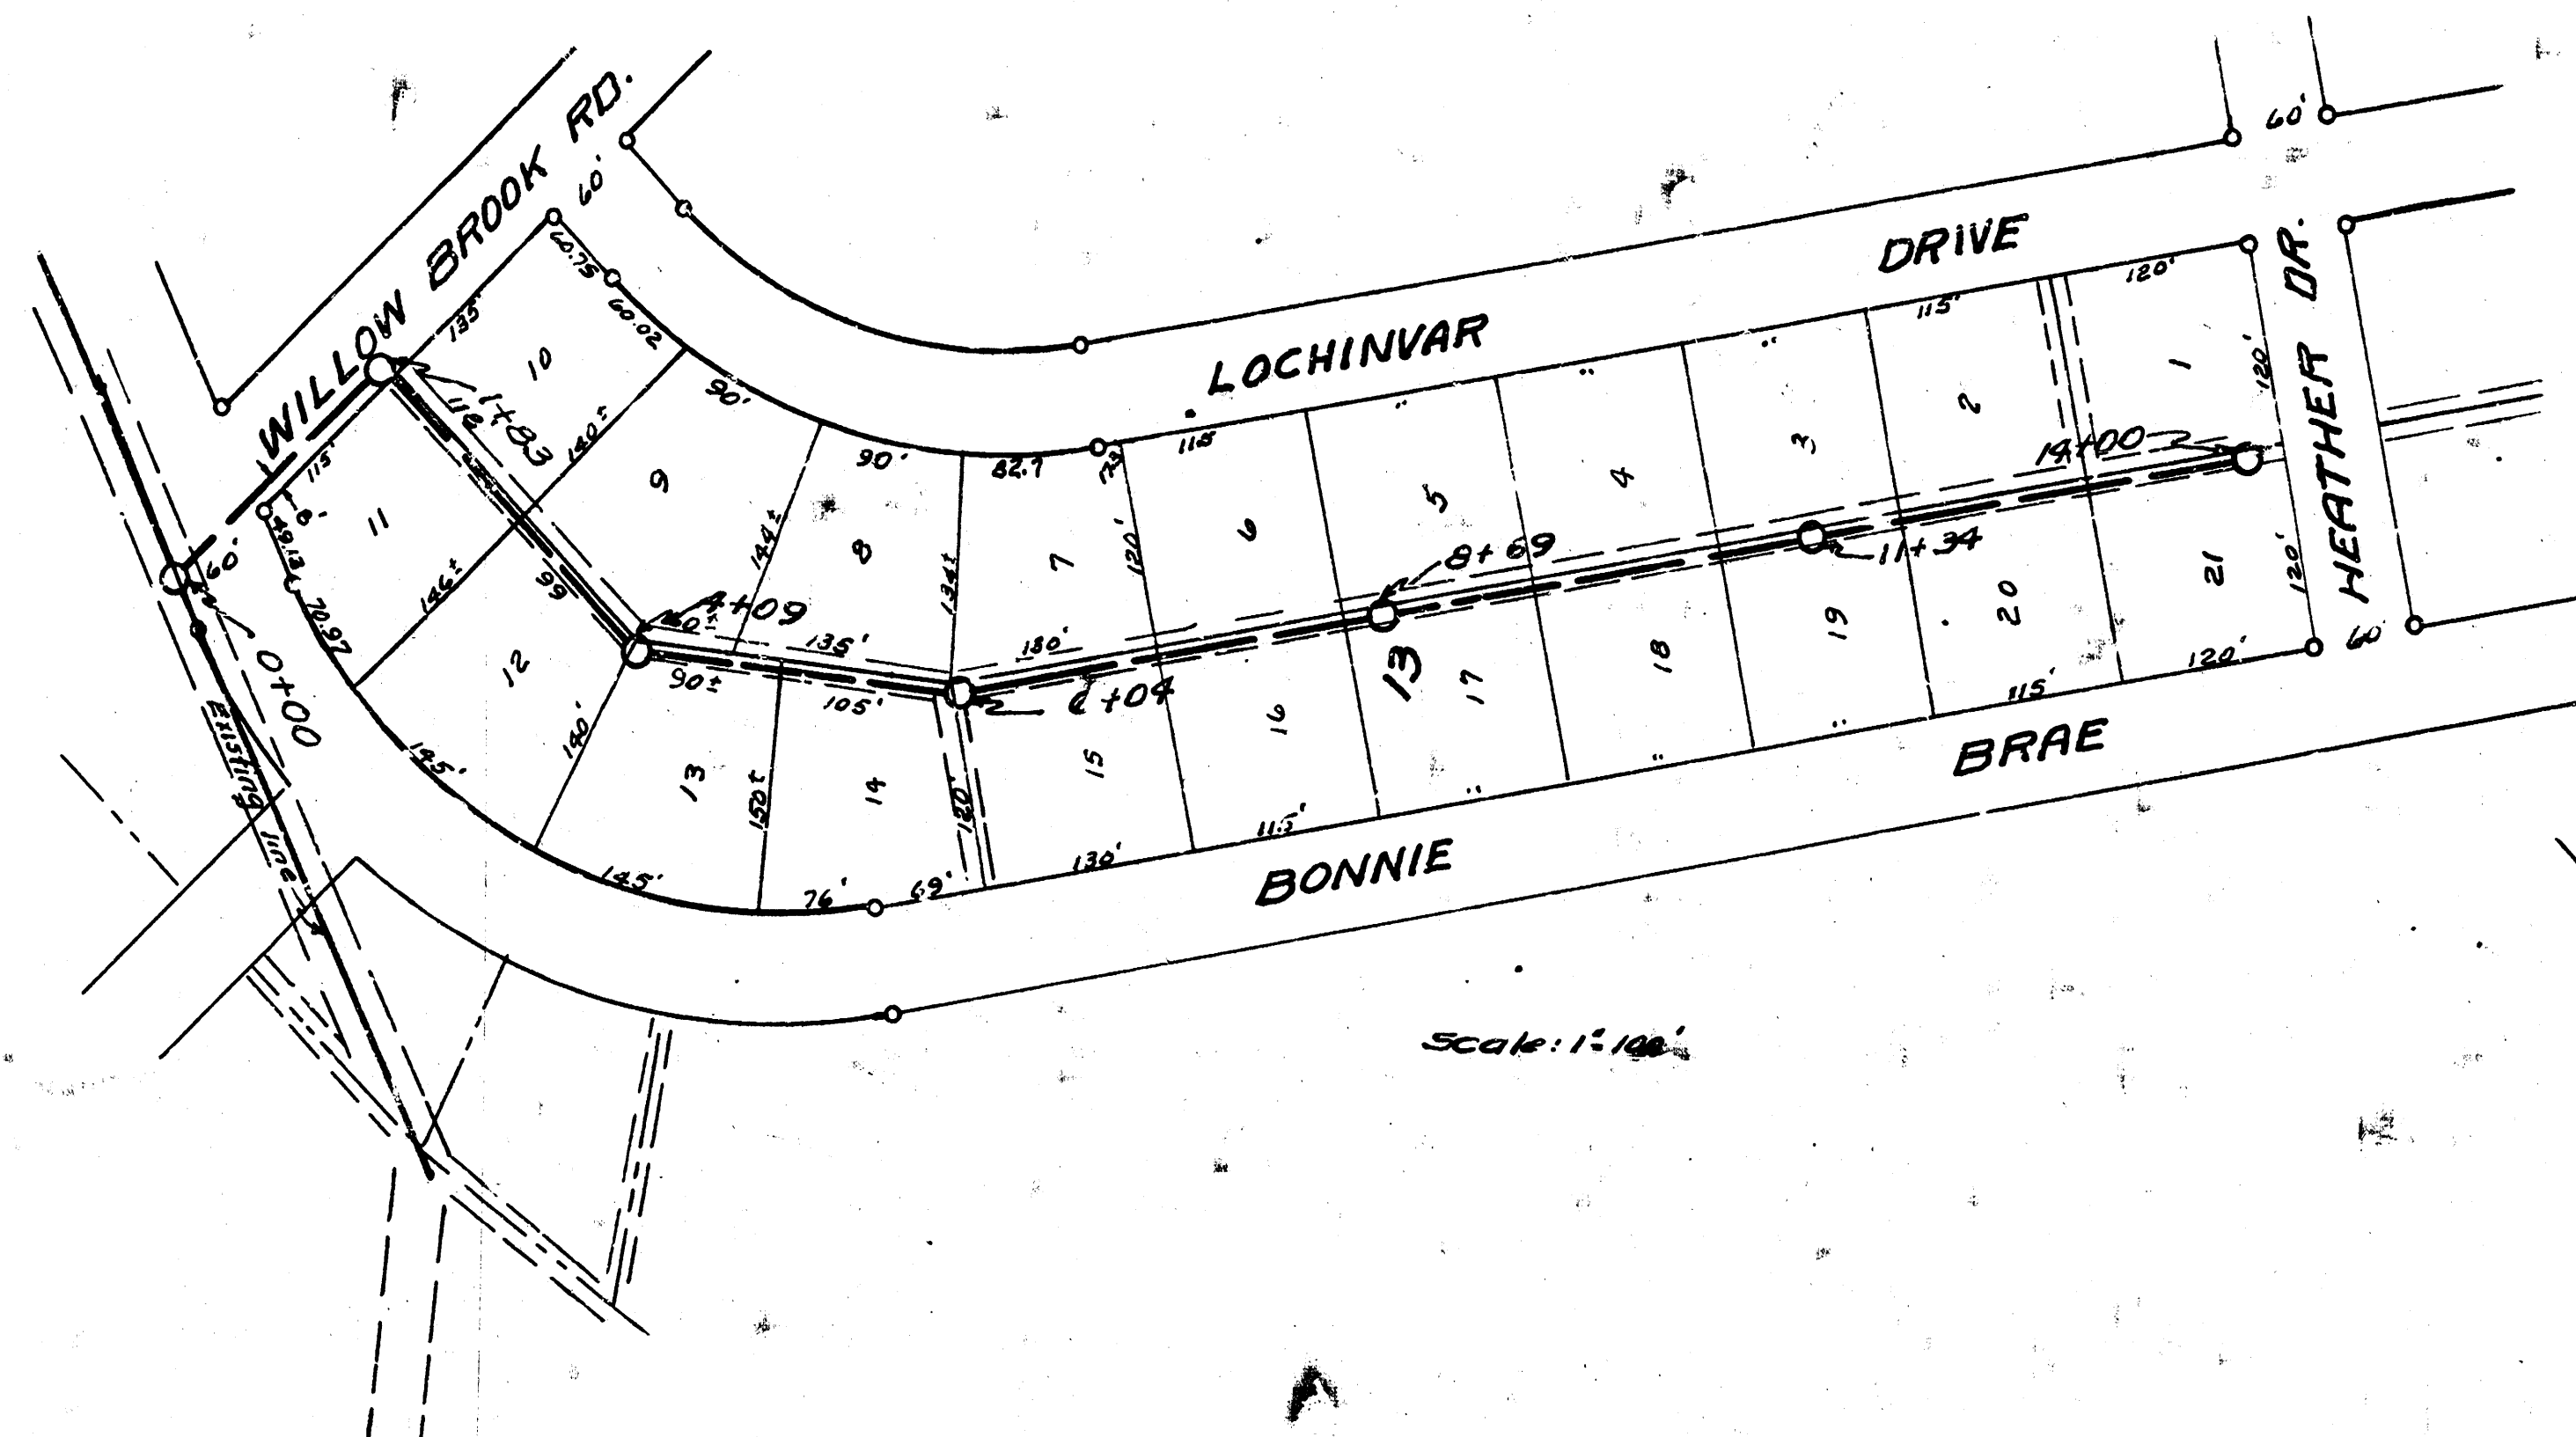

Date 11-22-53
Drawn by McLean
Checked by [Signature]
Circled No. 10

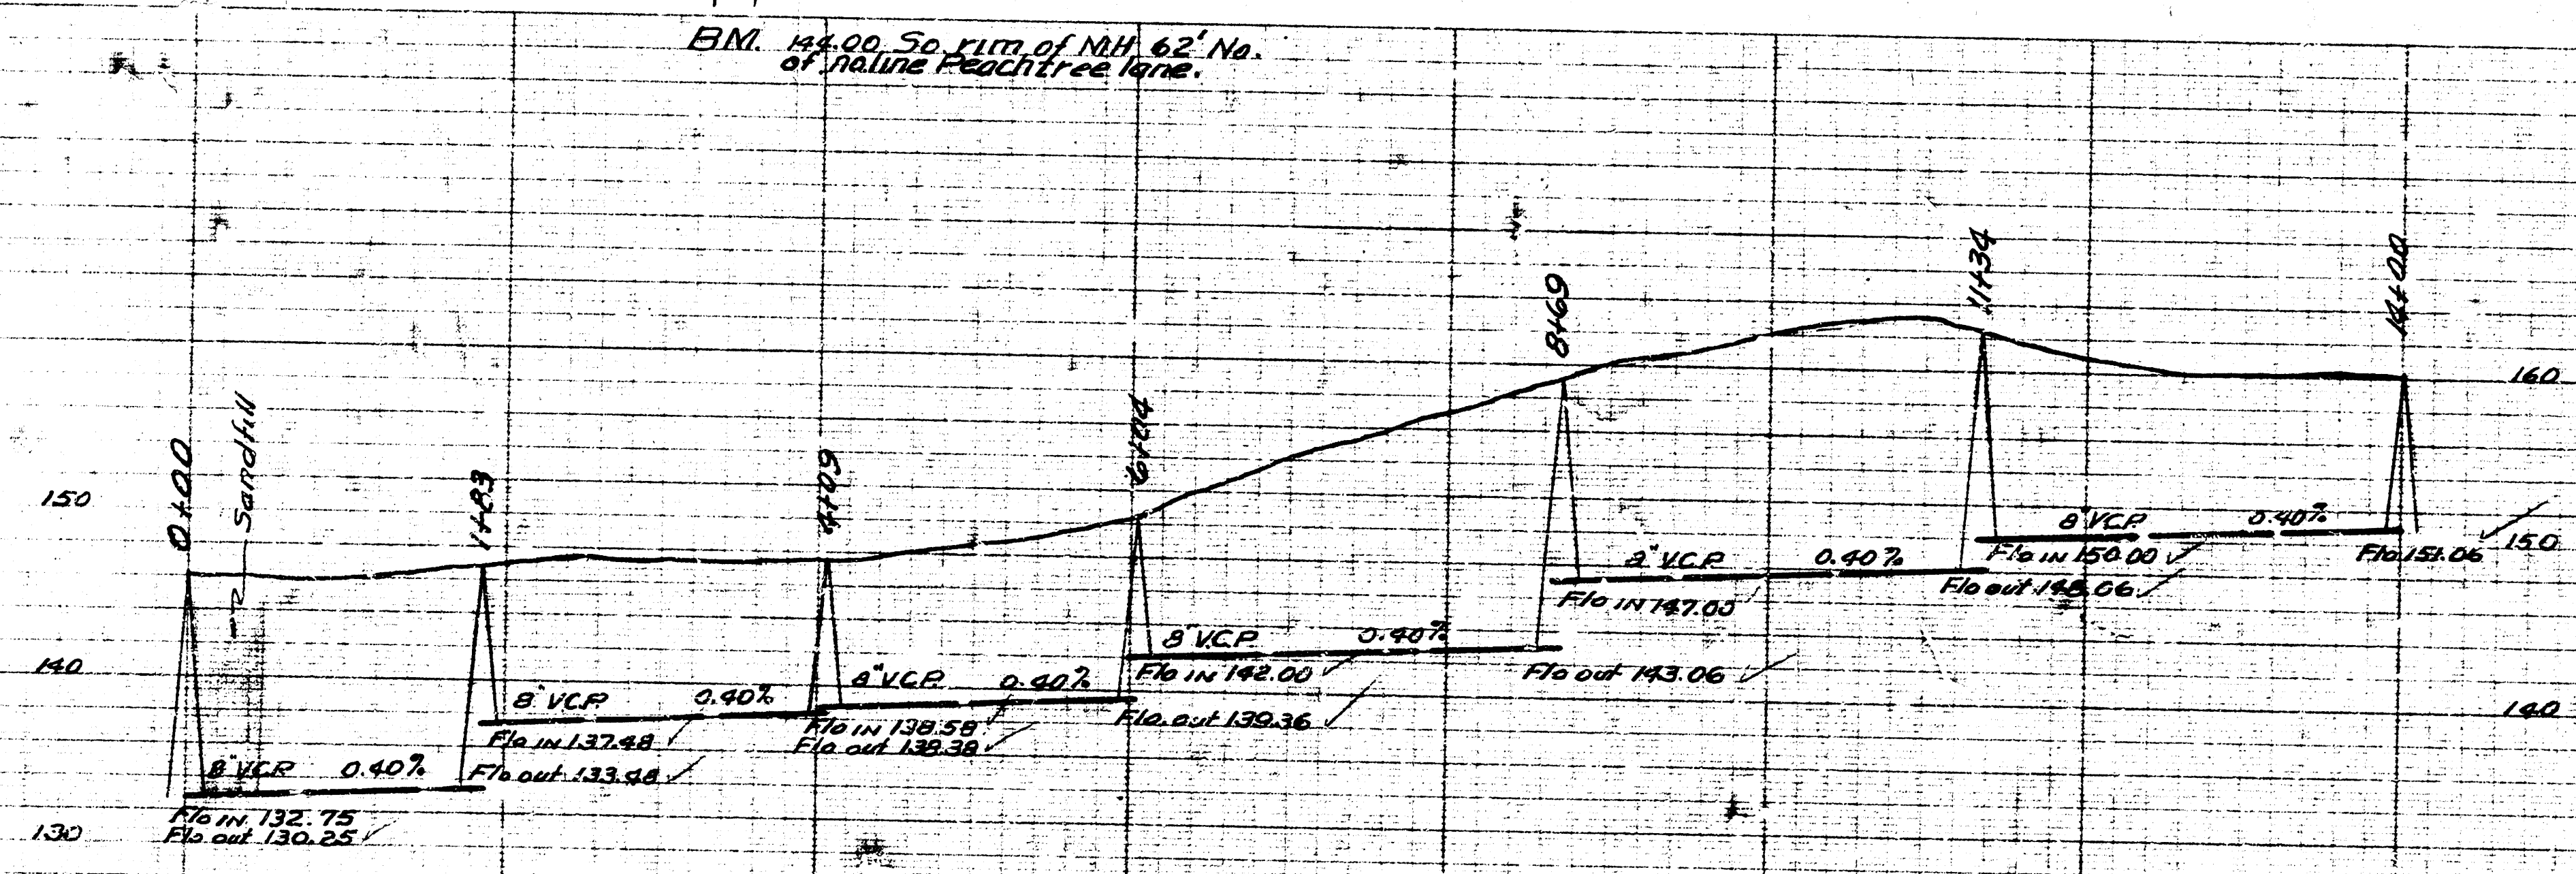

Note: Line shall be laid on cradle concrete where cover exceeds 12'

LAT 4 WIS.
CITY OF WICHITA KANSAS
BESMITH CITY ENGINEER
Proj No. C 23-58

