

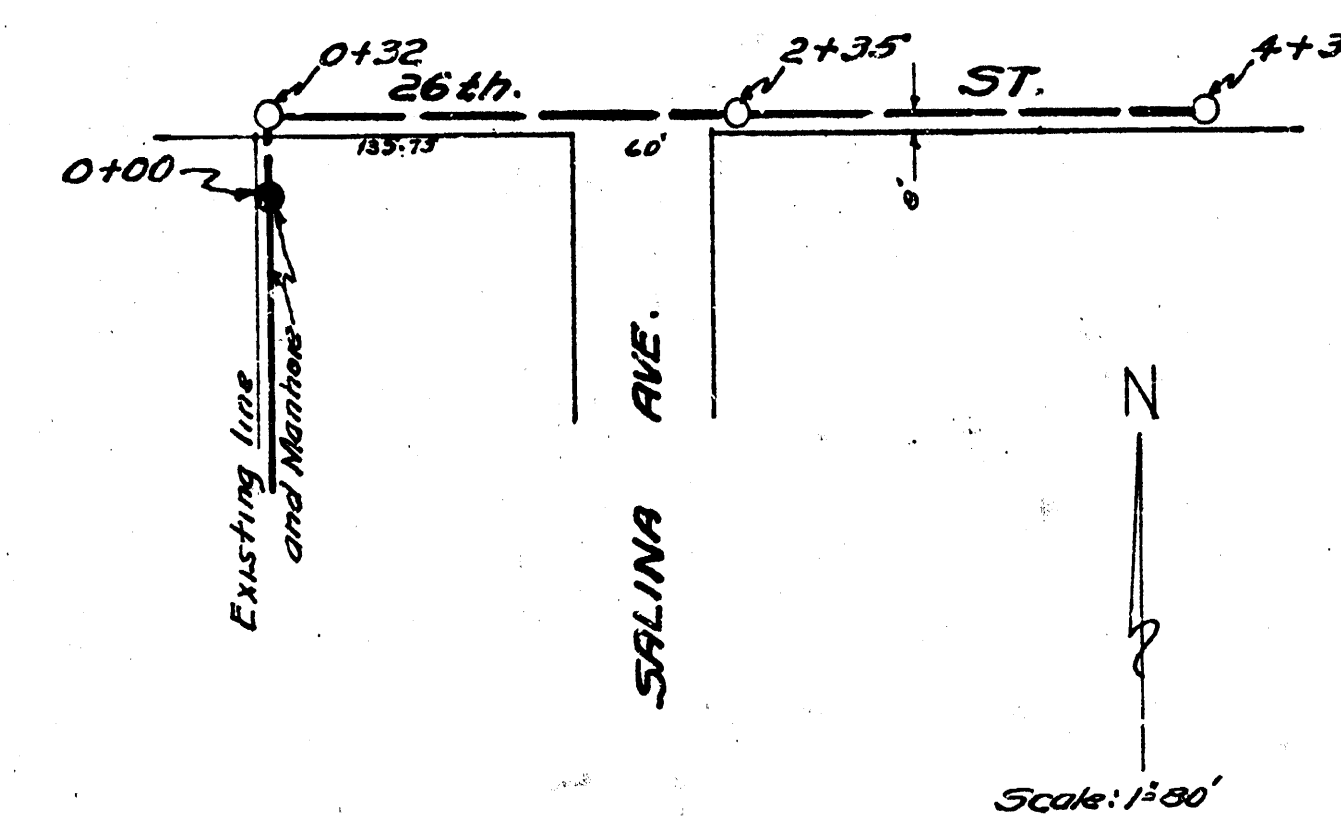


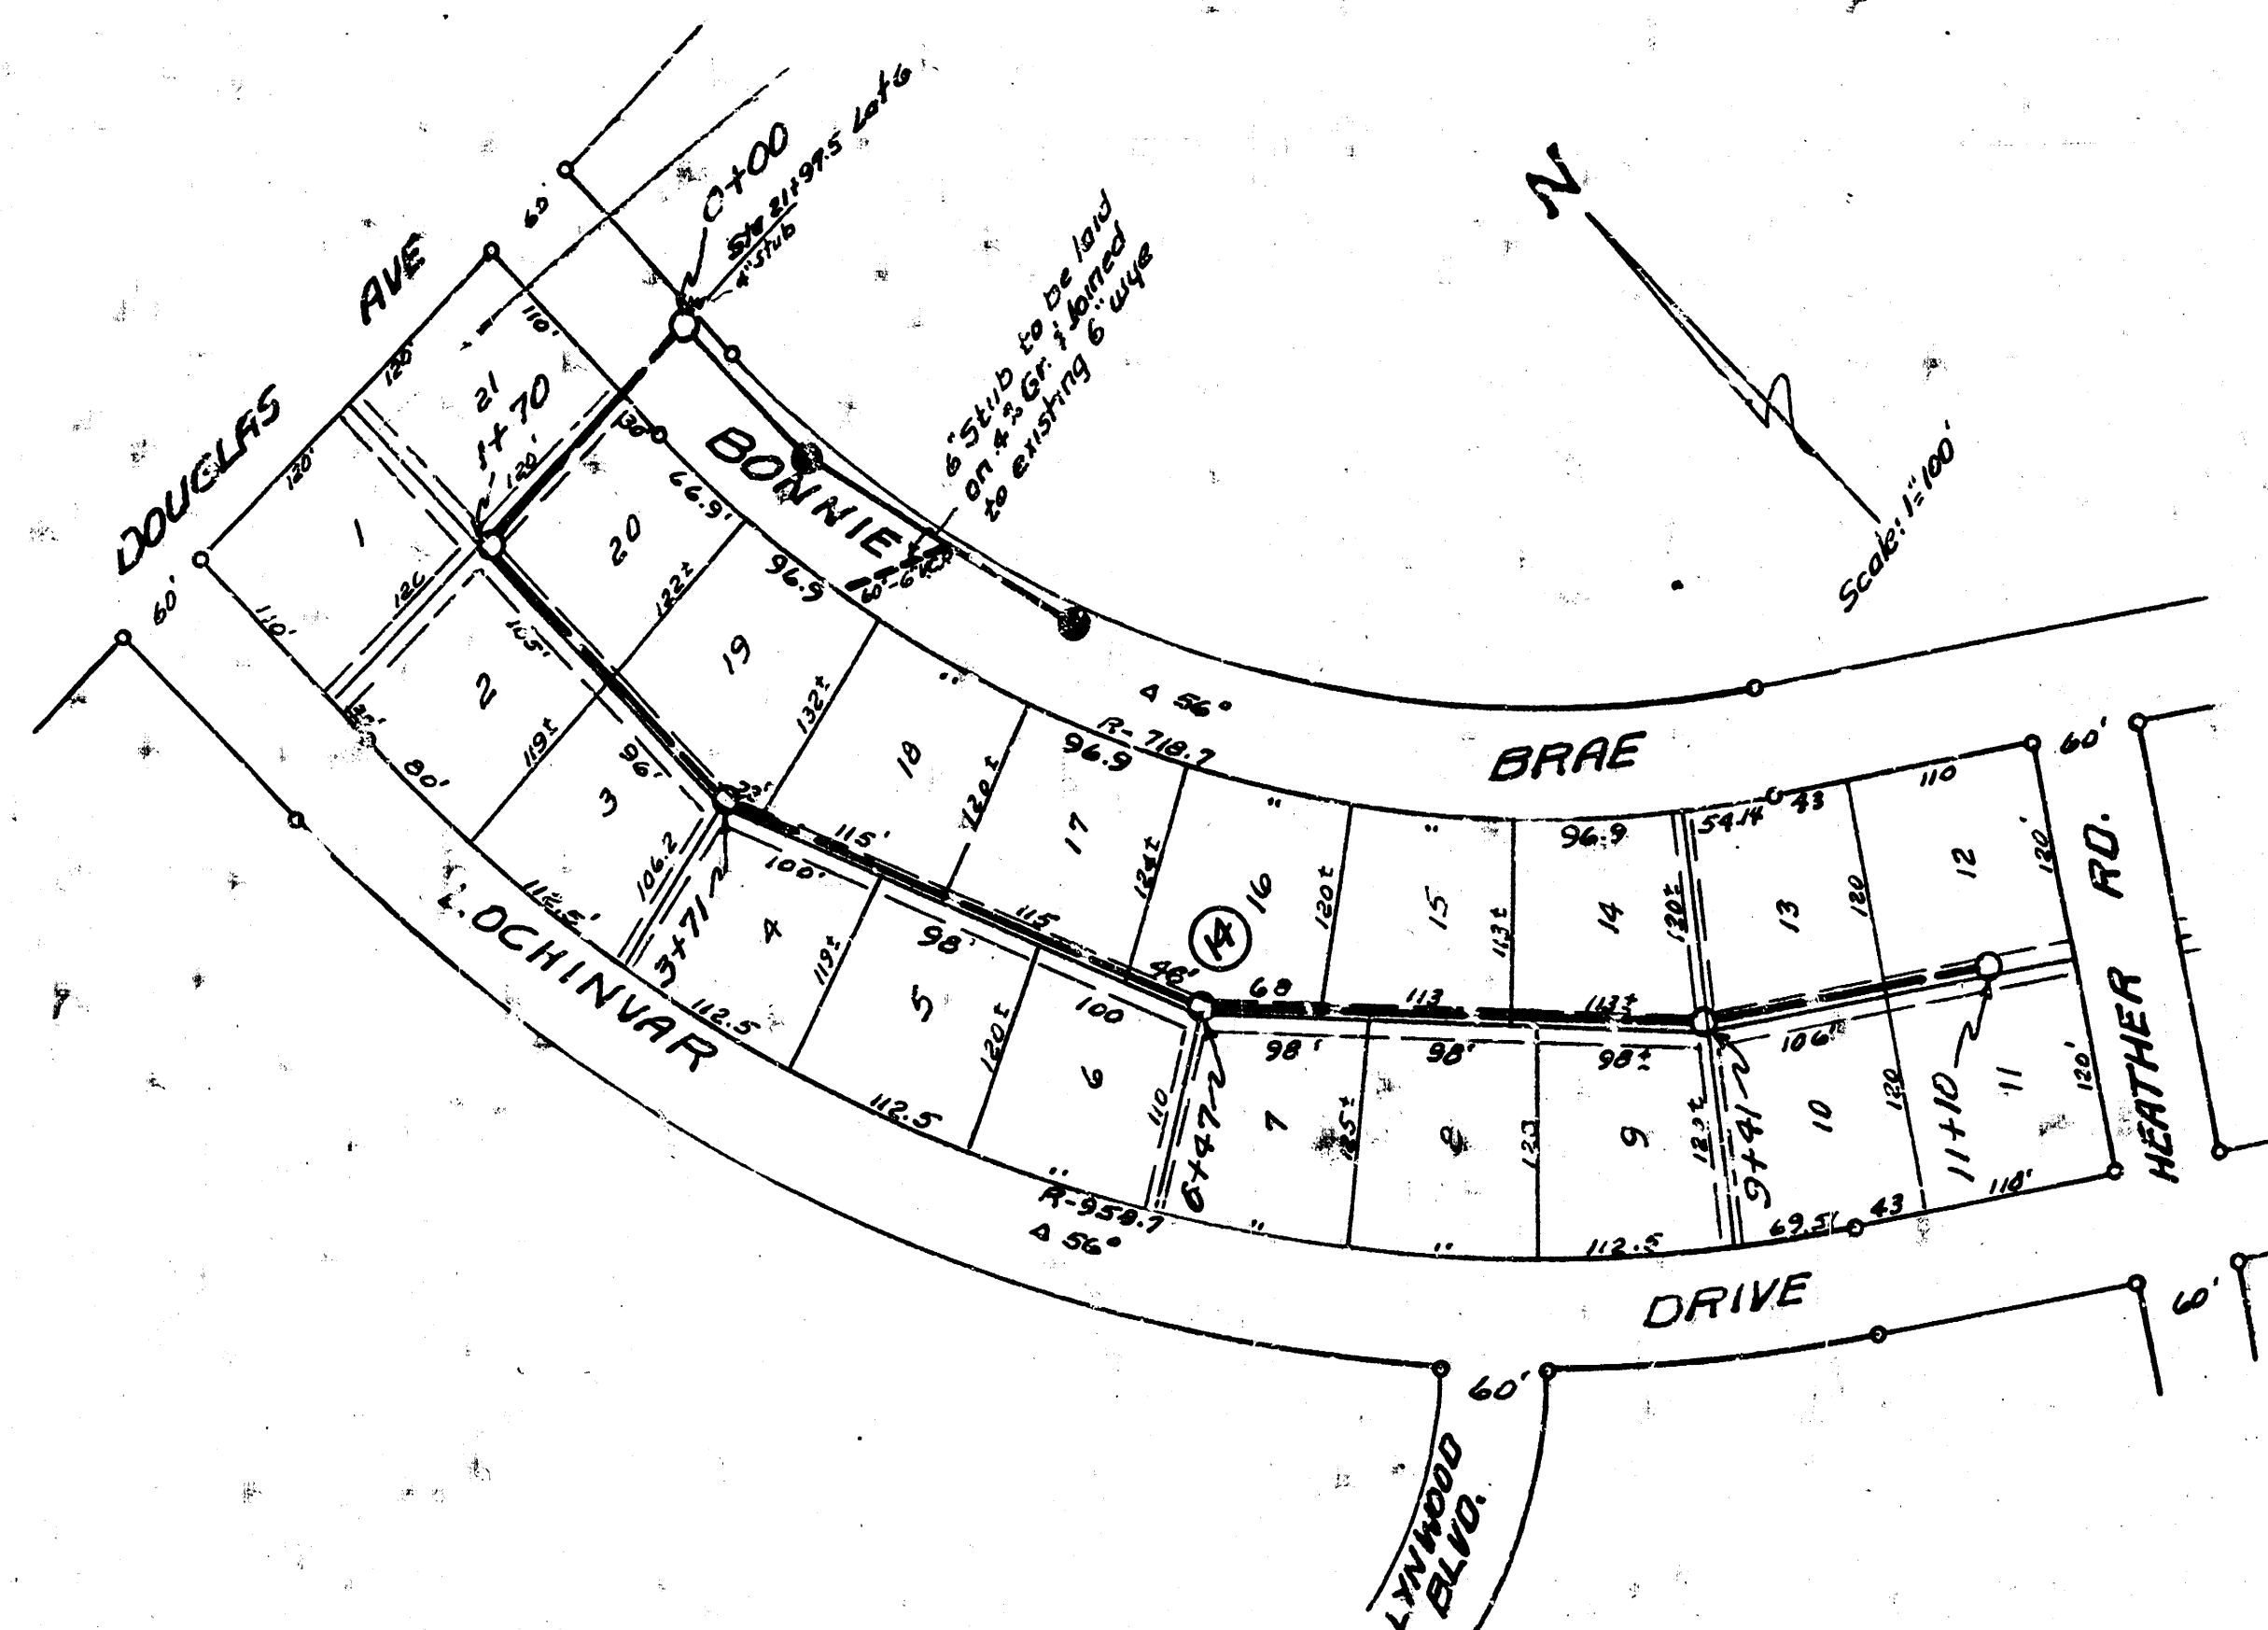


NOTE TO CONTRACTOR  
This project will be constructed under the supervision of the CITY ENGINEER and conforming to the SPECIFICATIONS of the CITY OF WICHITA. The CONTRACTOR will reimburse the City of Wichita for all cost of engineering, plans, and inspection.

Date 11-24-53  
Drawn by McLean  
Checked by T. J. Jones  
Based on

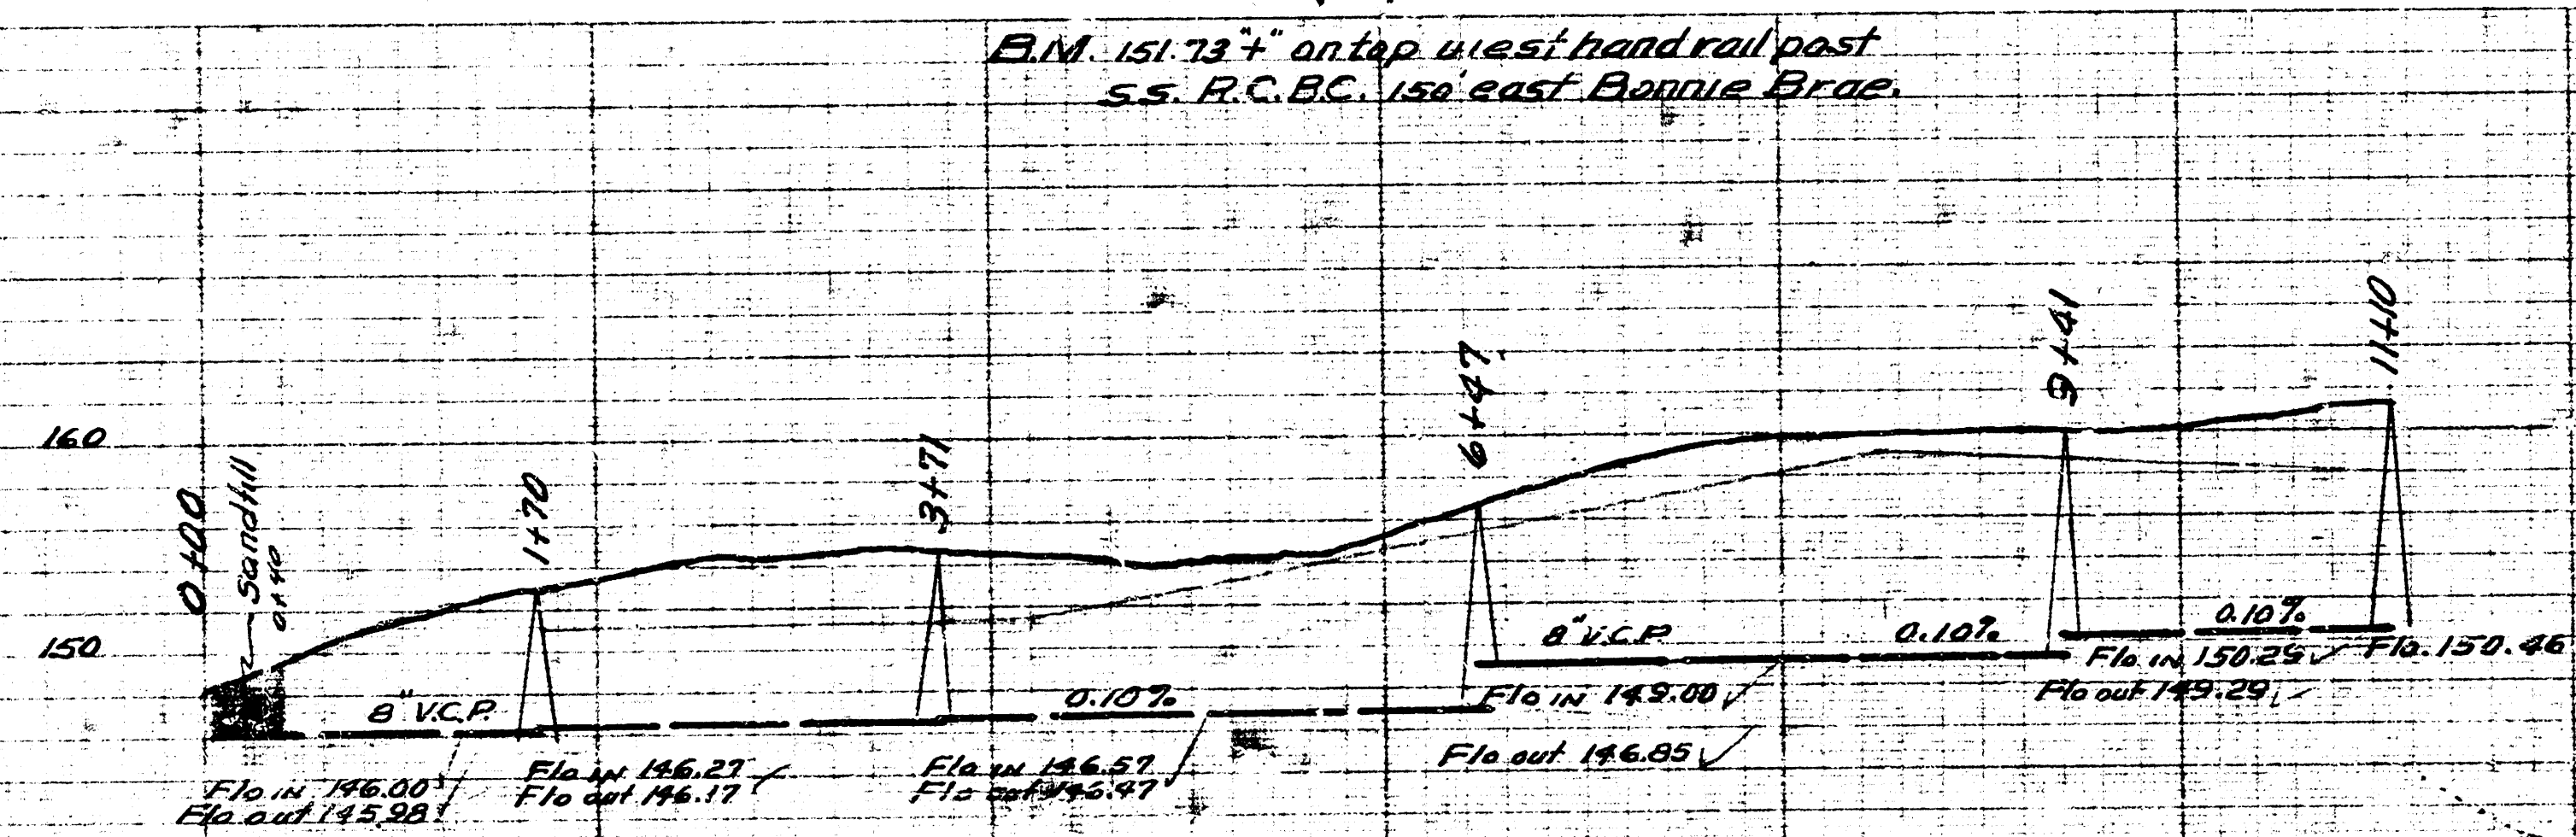

Engineer Note: Check elev. at the house on Lot 19 if it can be serviced with a 6" line at the rear of the lot. Disregard the 6" stub in Bonnie Brae.

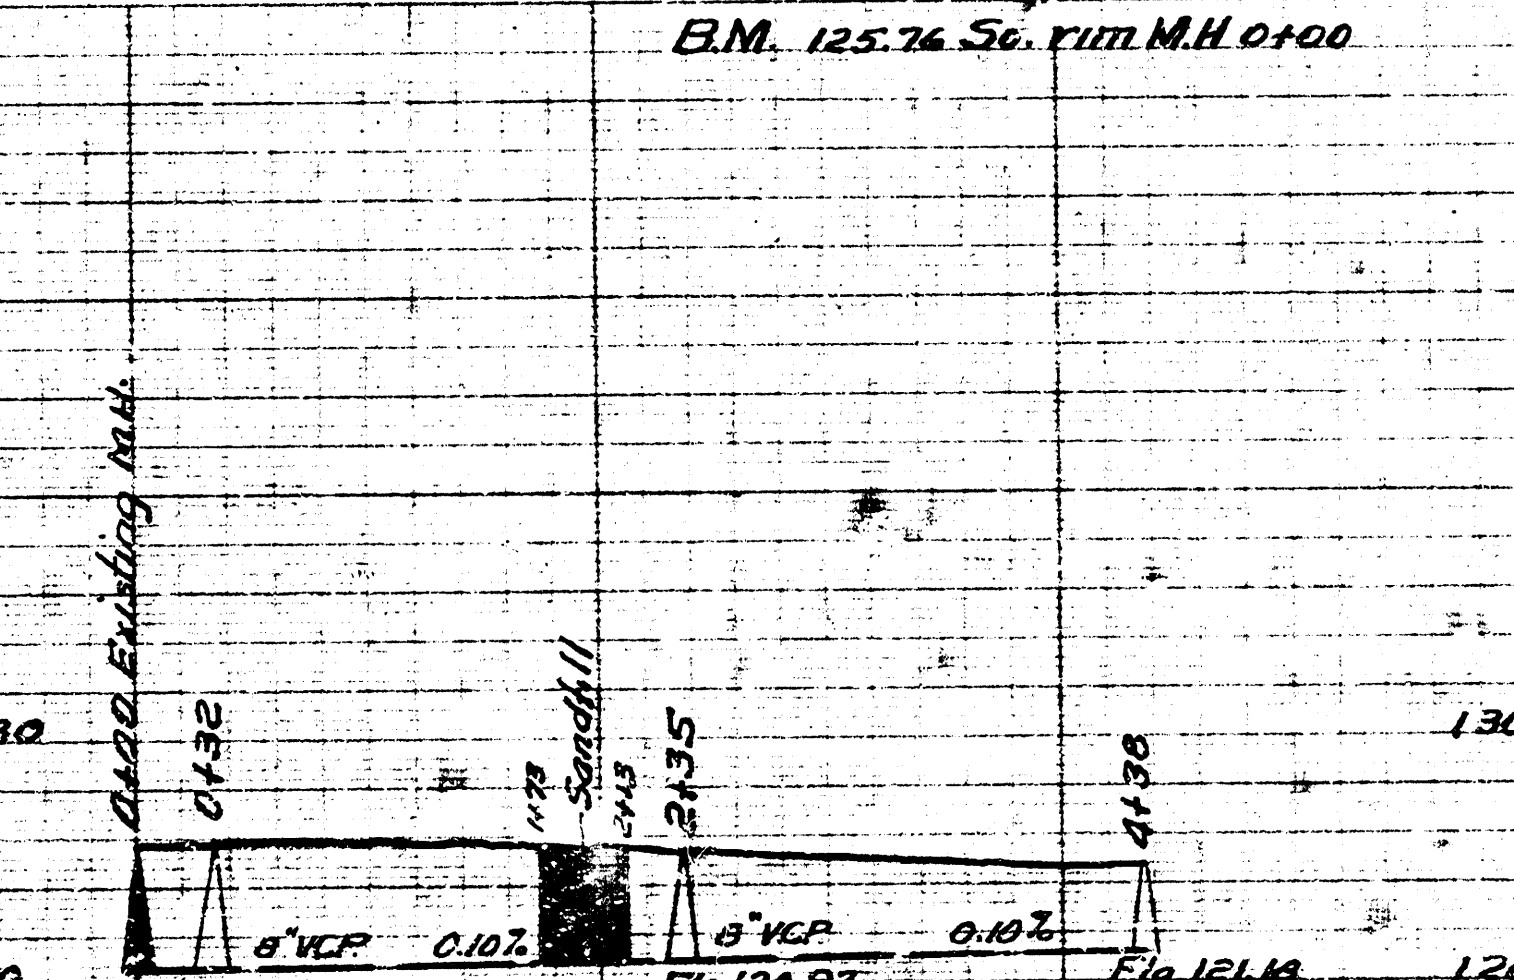

LAT. 5 WLS  
CITY OF WICHITA KANSAS  
BE SMITH CITY ENGINEER  
Proj No. C-23-59

HENRY ROE CLOUD SCHOOL  
CITY OF WICHITA KANSAS  
PRIVATE SEWER  
BE SMITH CITY ENGINEER