


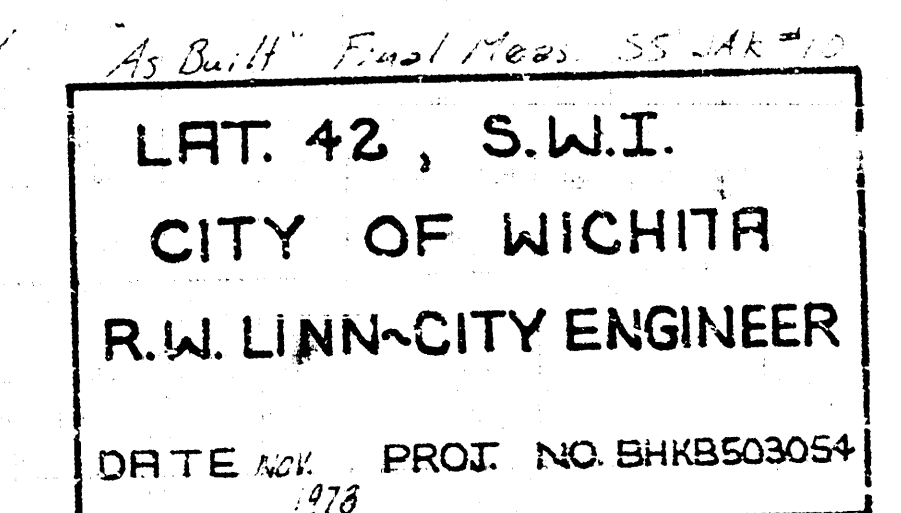


Plan Scale ~ 1"=40'
Profile Scale ~ Horiz. 1"=40'
 Vert. 1"=5'

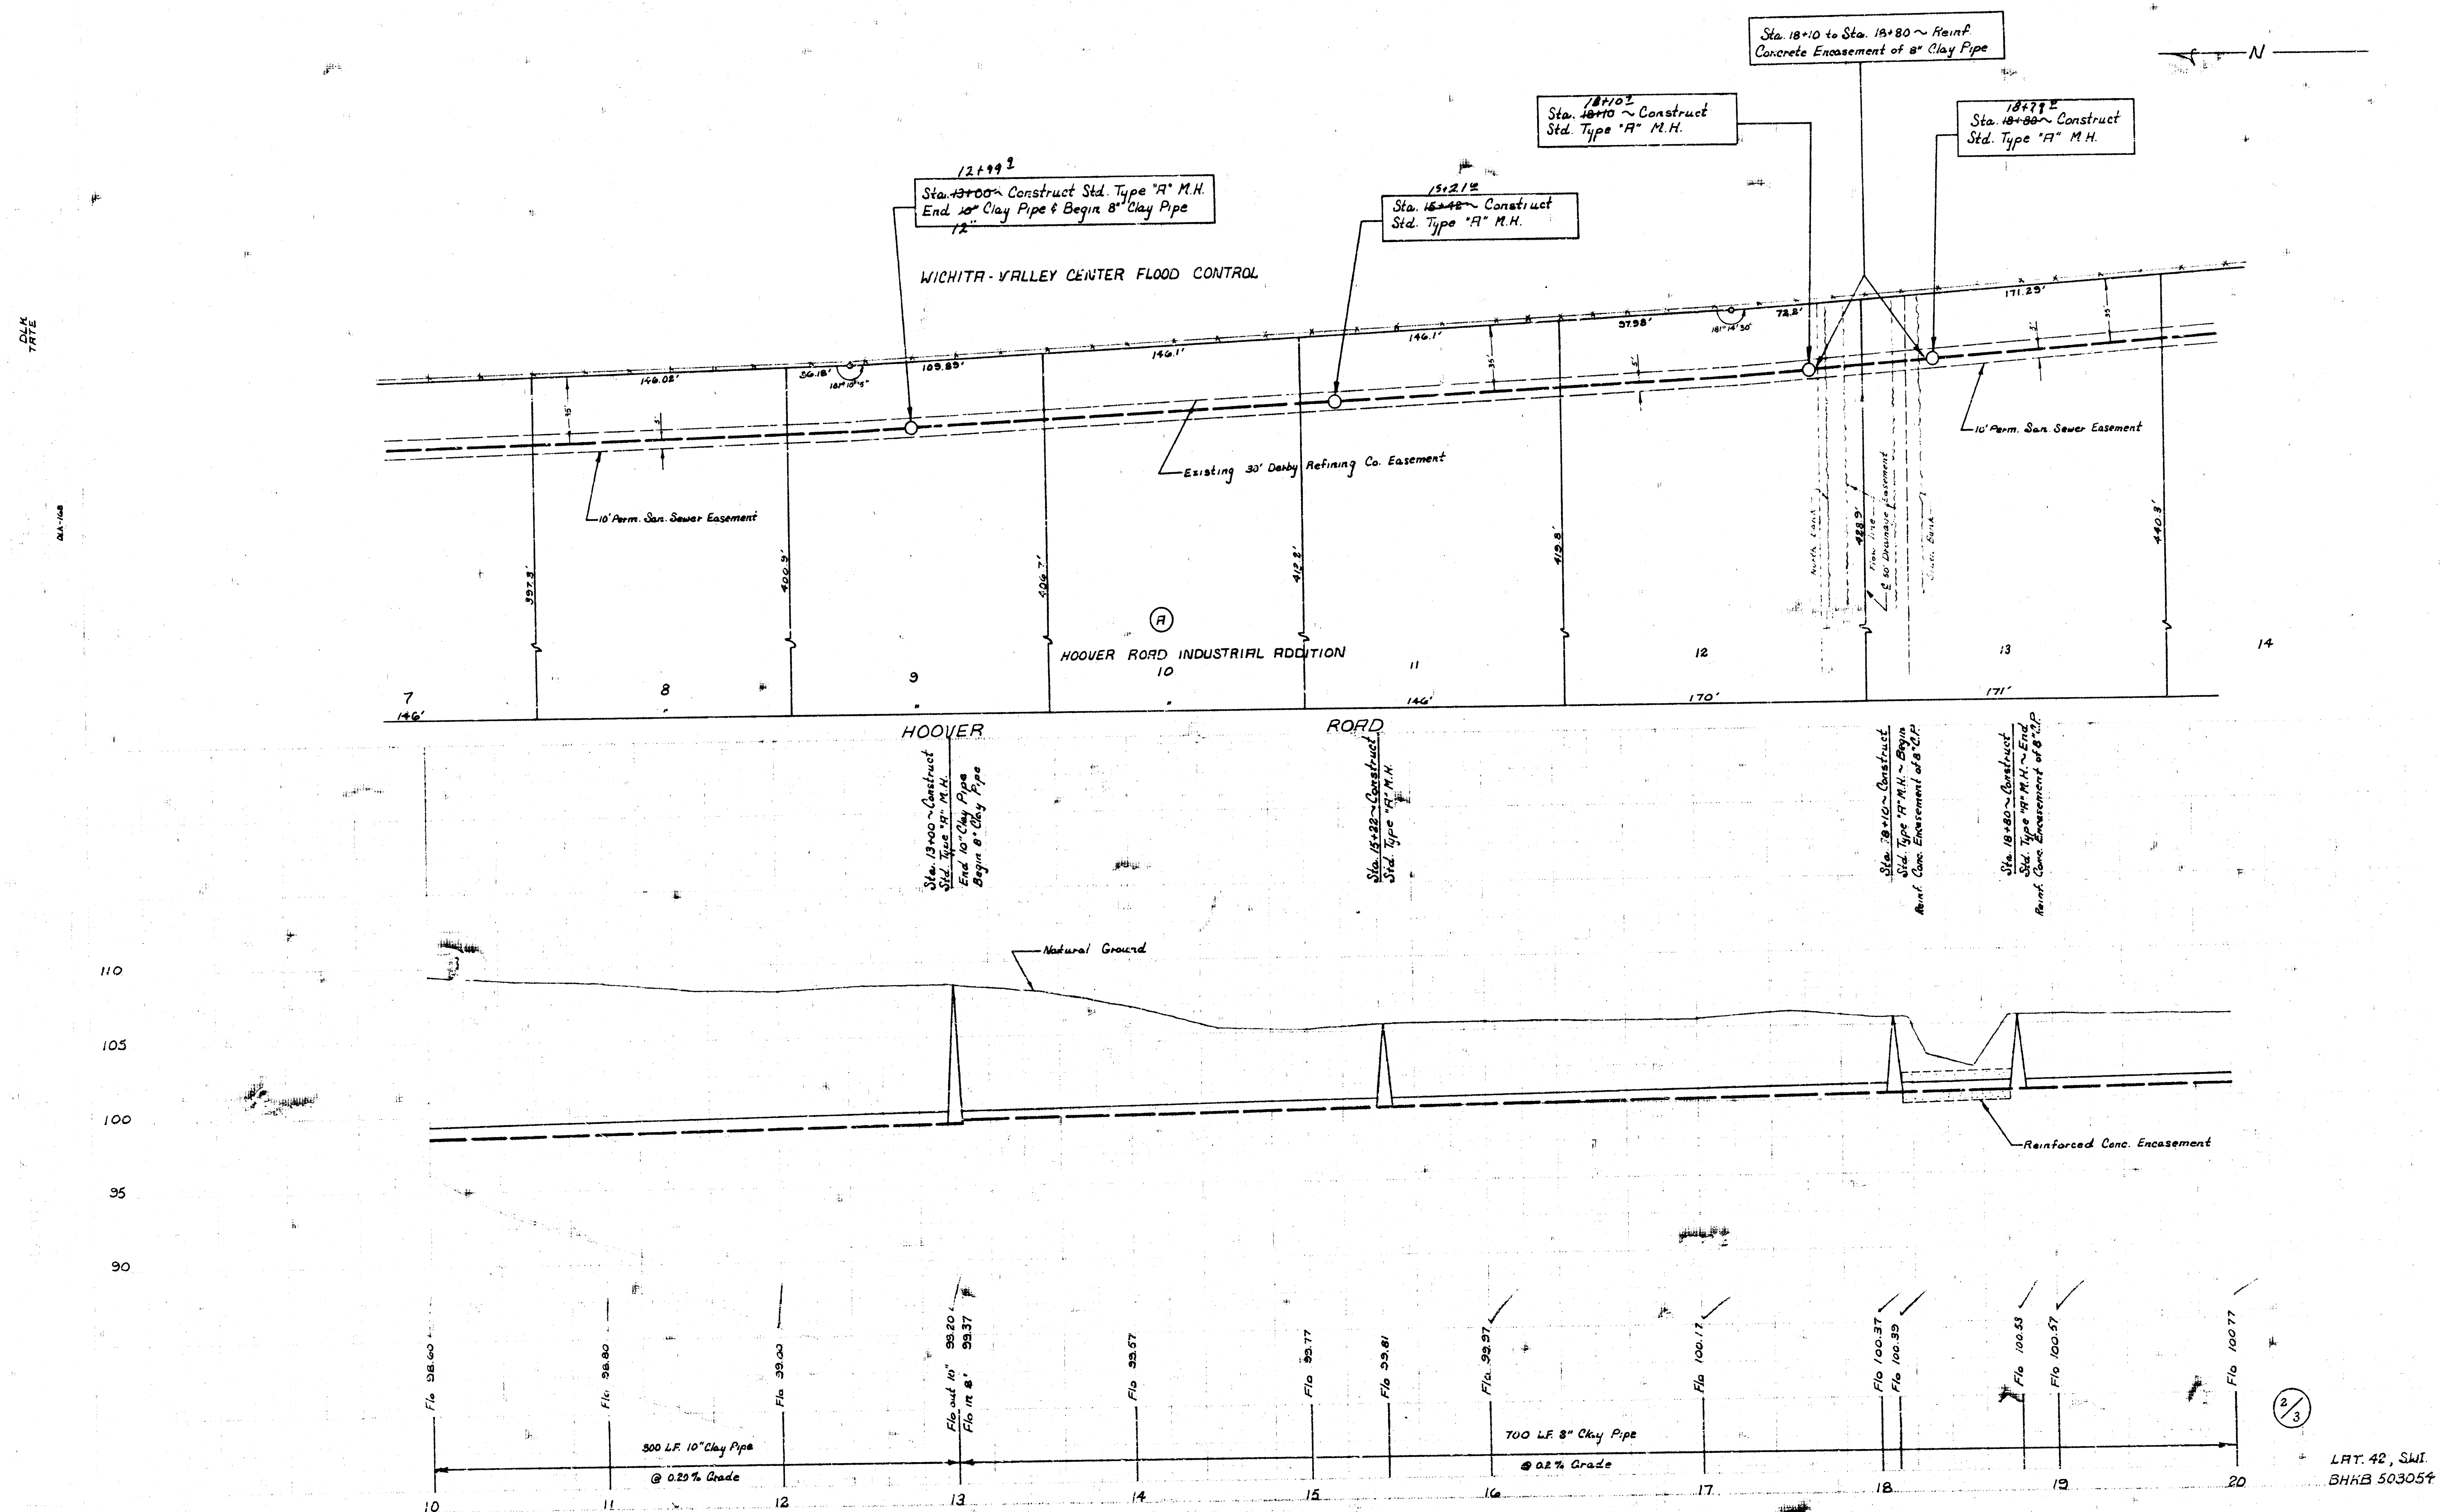

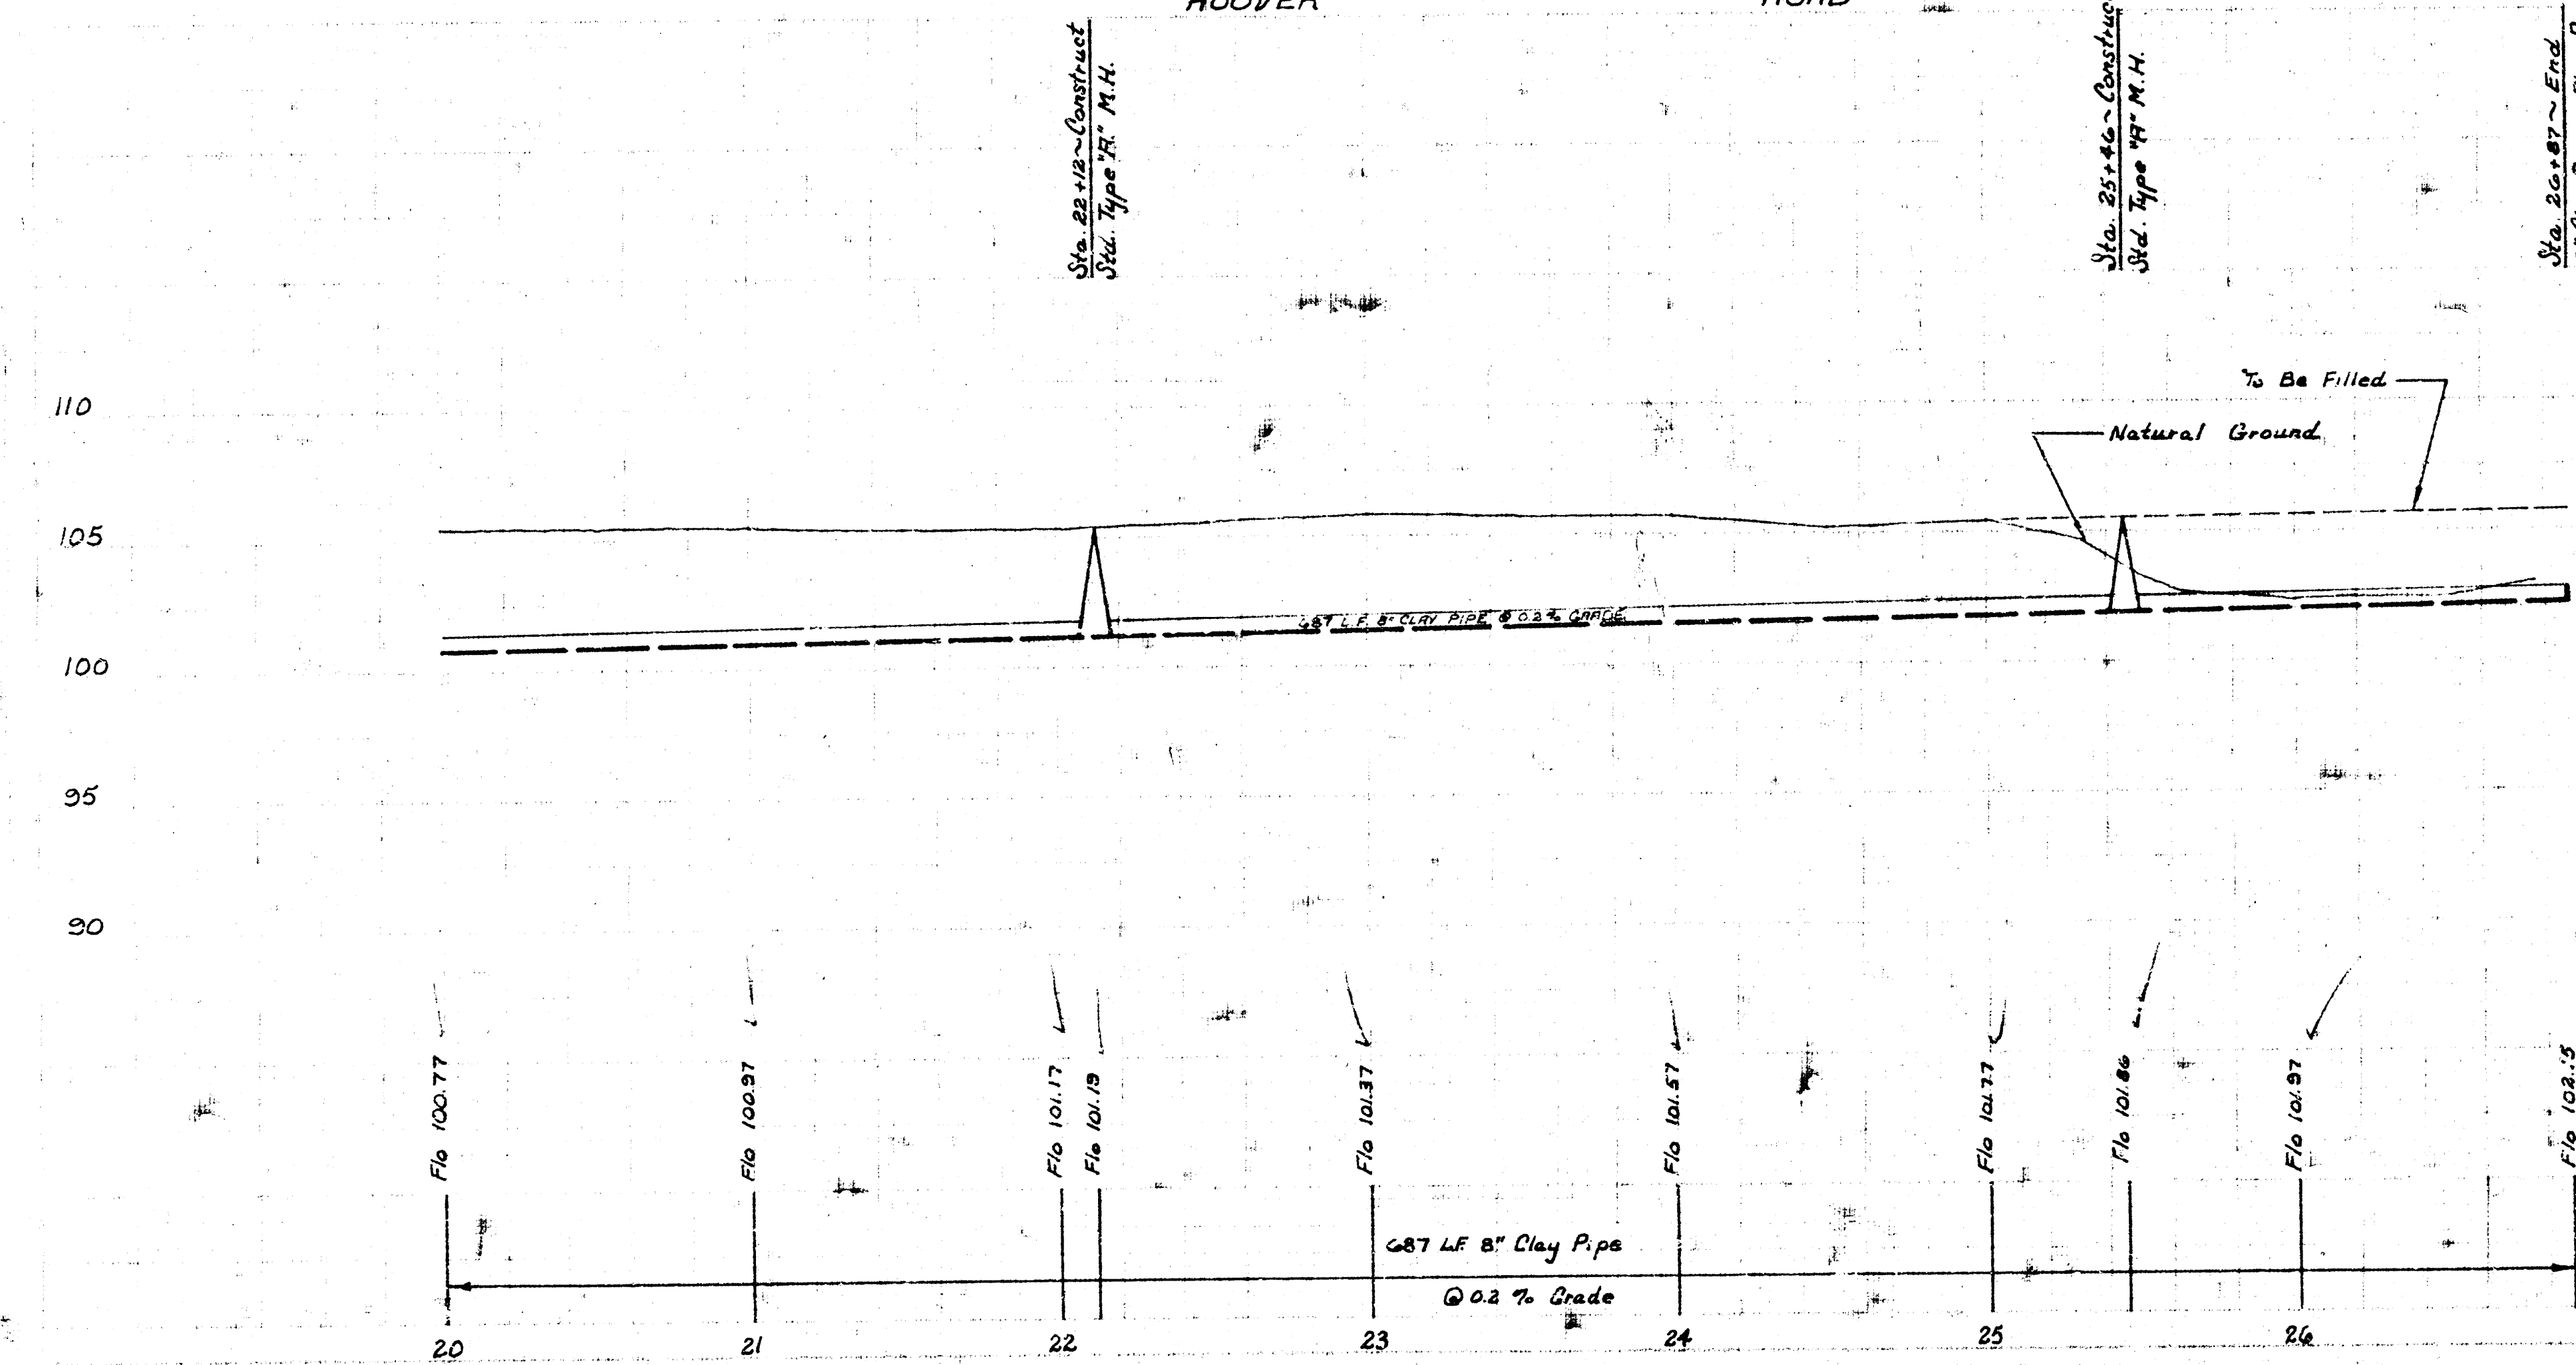

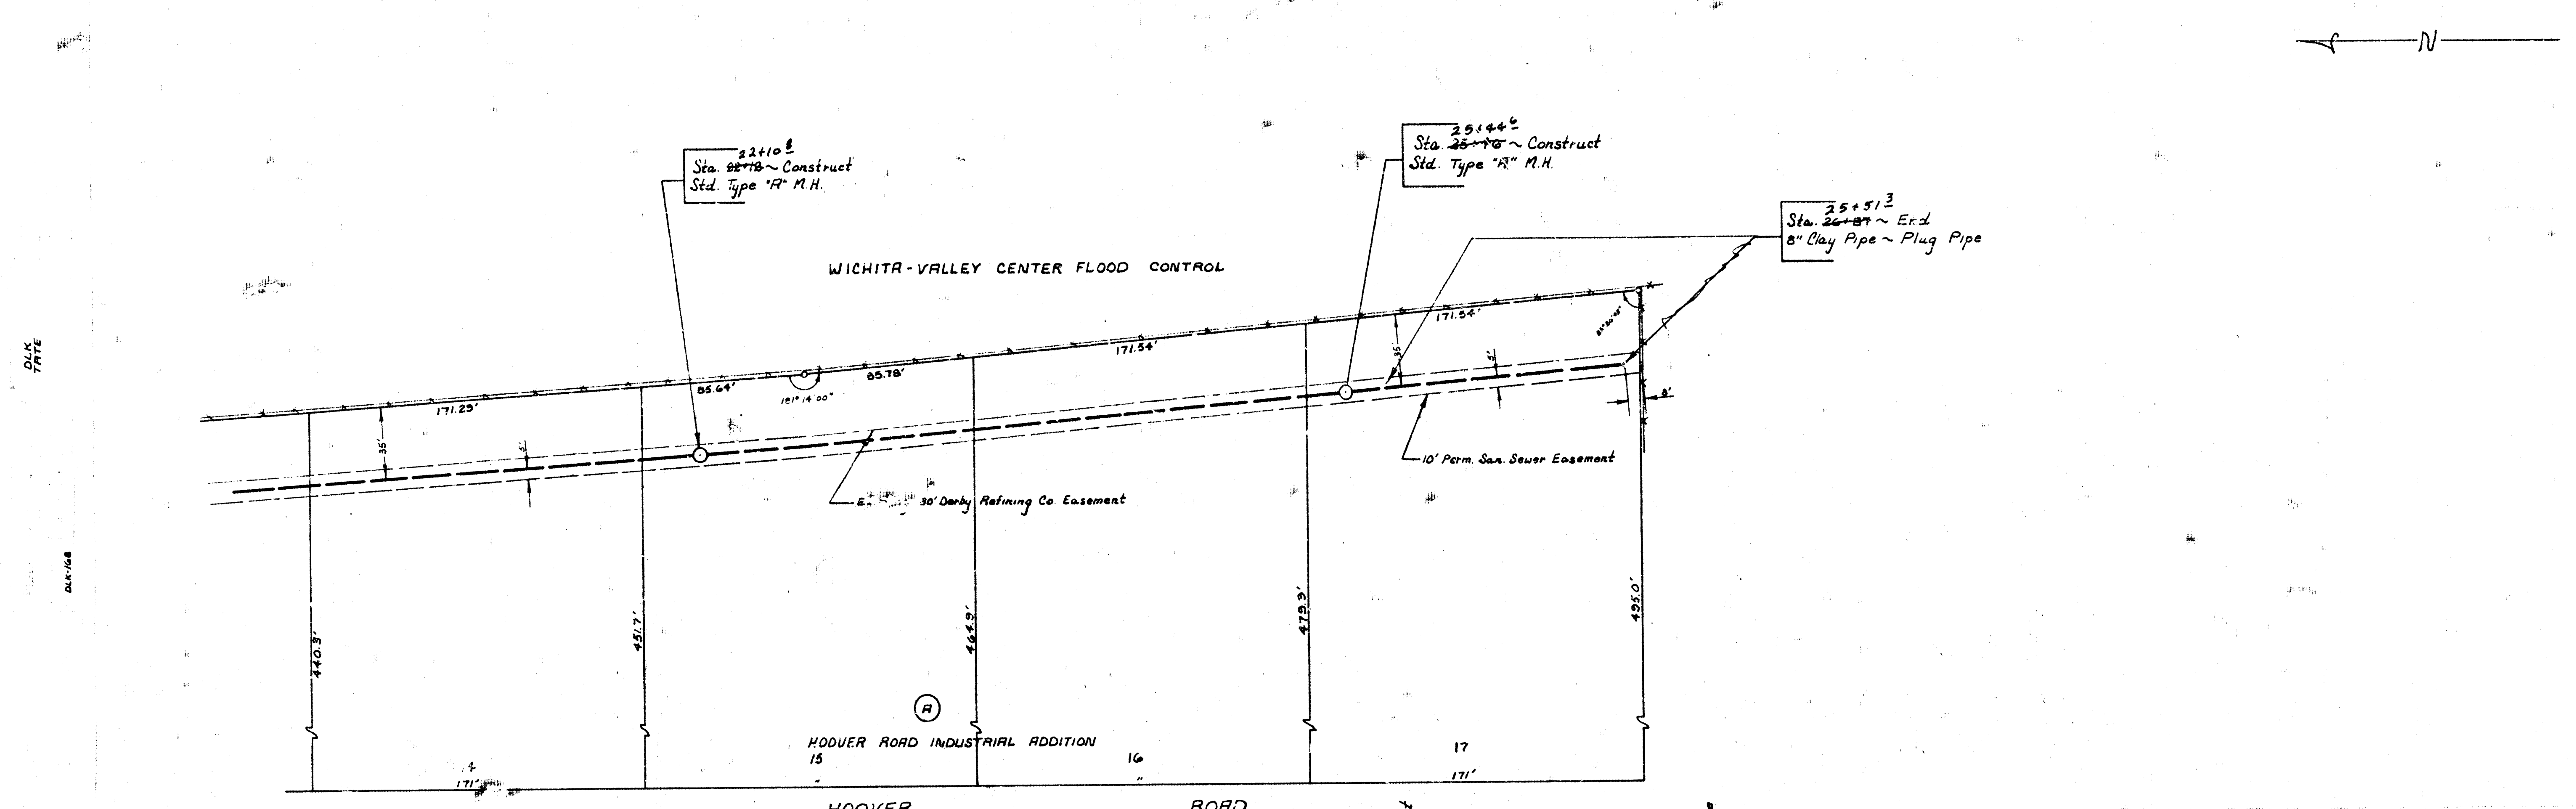

