
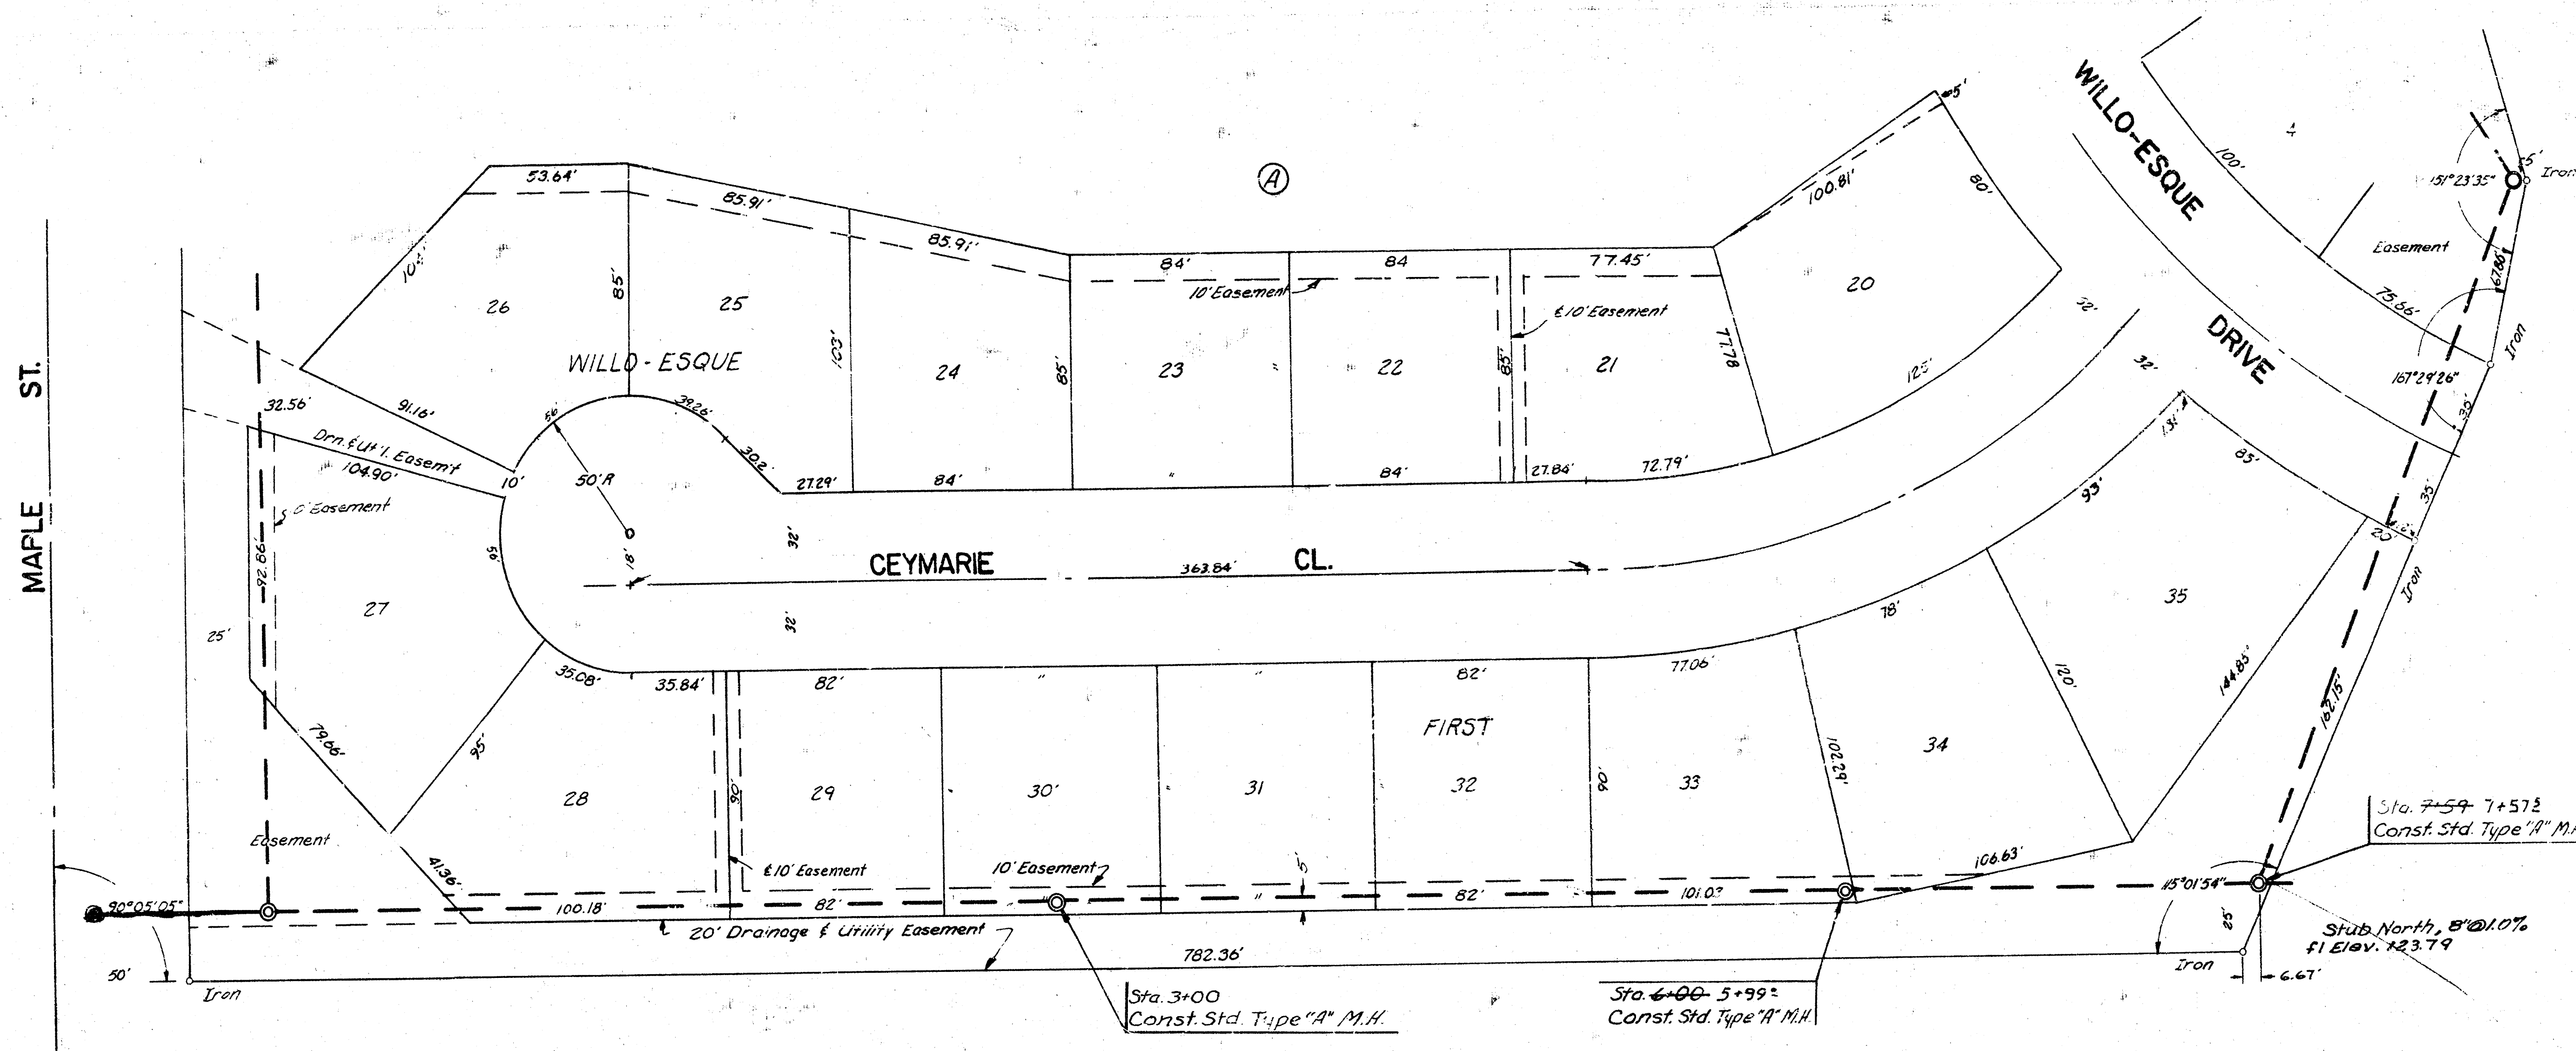



Plan Scale: 1" = 40'
 Profile Scale: 1" = 40'
 1/4" = 1' - 5"

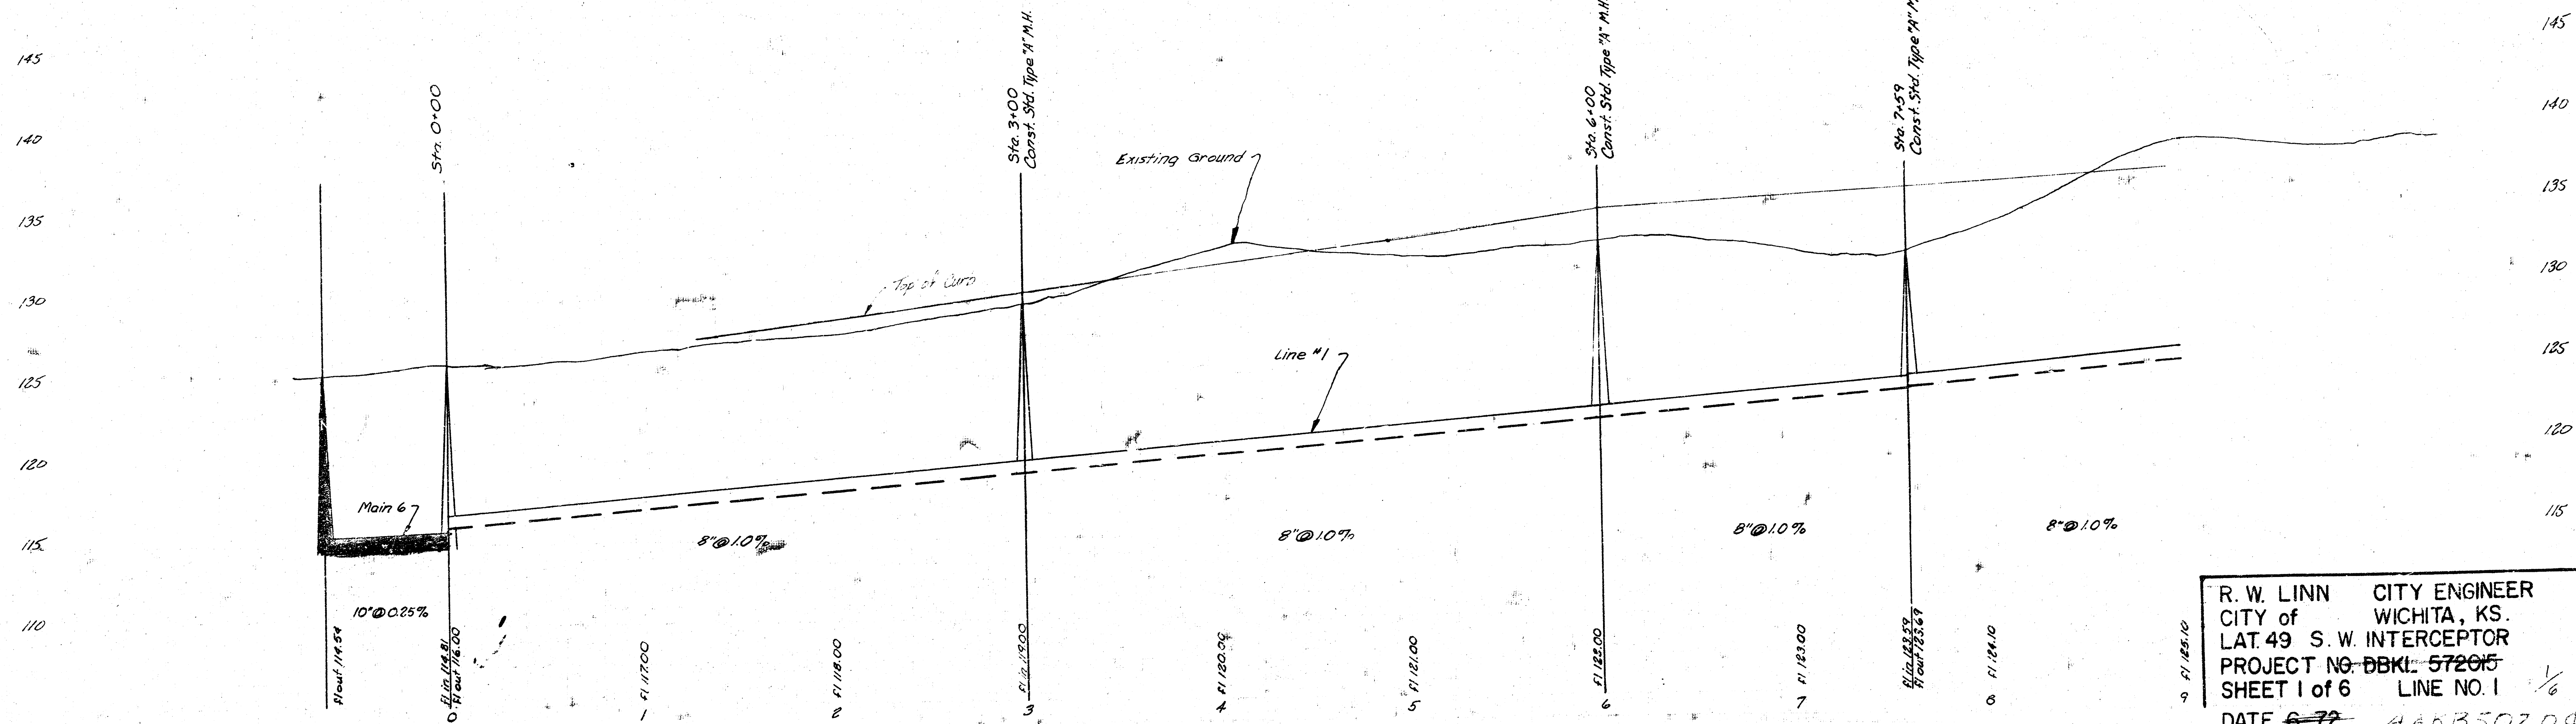


R. W. LINN CITY ENGINEER
 CITY of WICHITA, KS.
 LAT. 49 S. W. INTERCEPTOR
 PROJECT NO. DBKL 57205
 SHEET 1 of 6 LINE NO. 1
 DATE 9-72 AAKB502048

9-72

FILMED FROM THE BEST


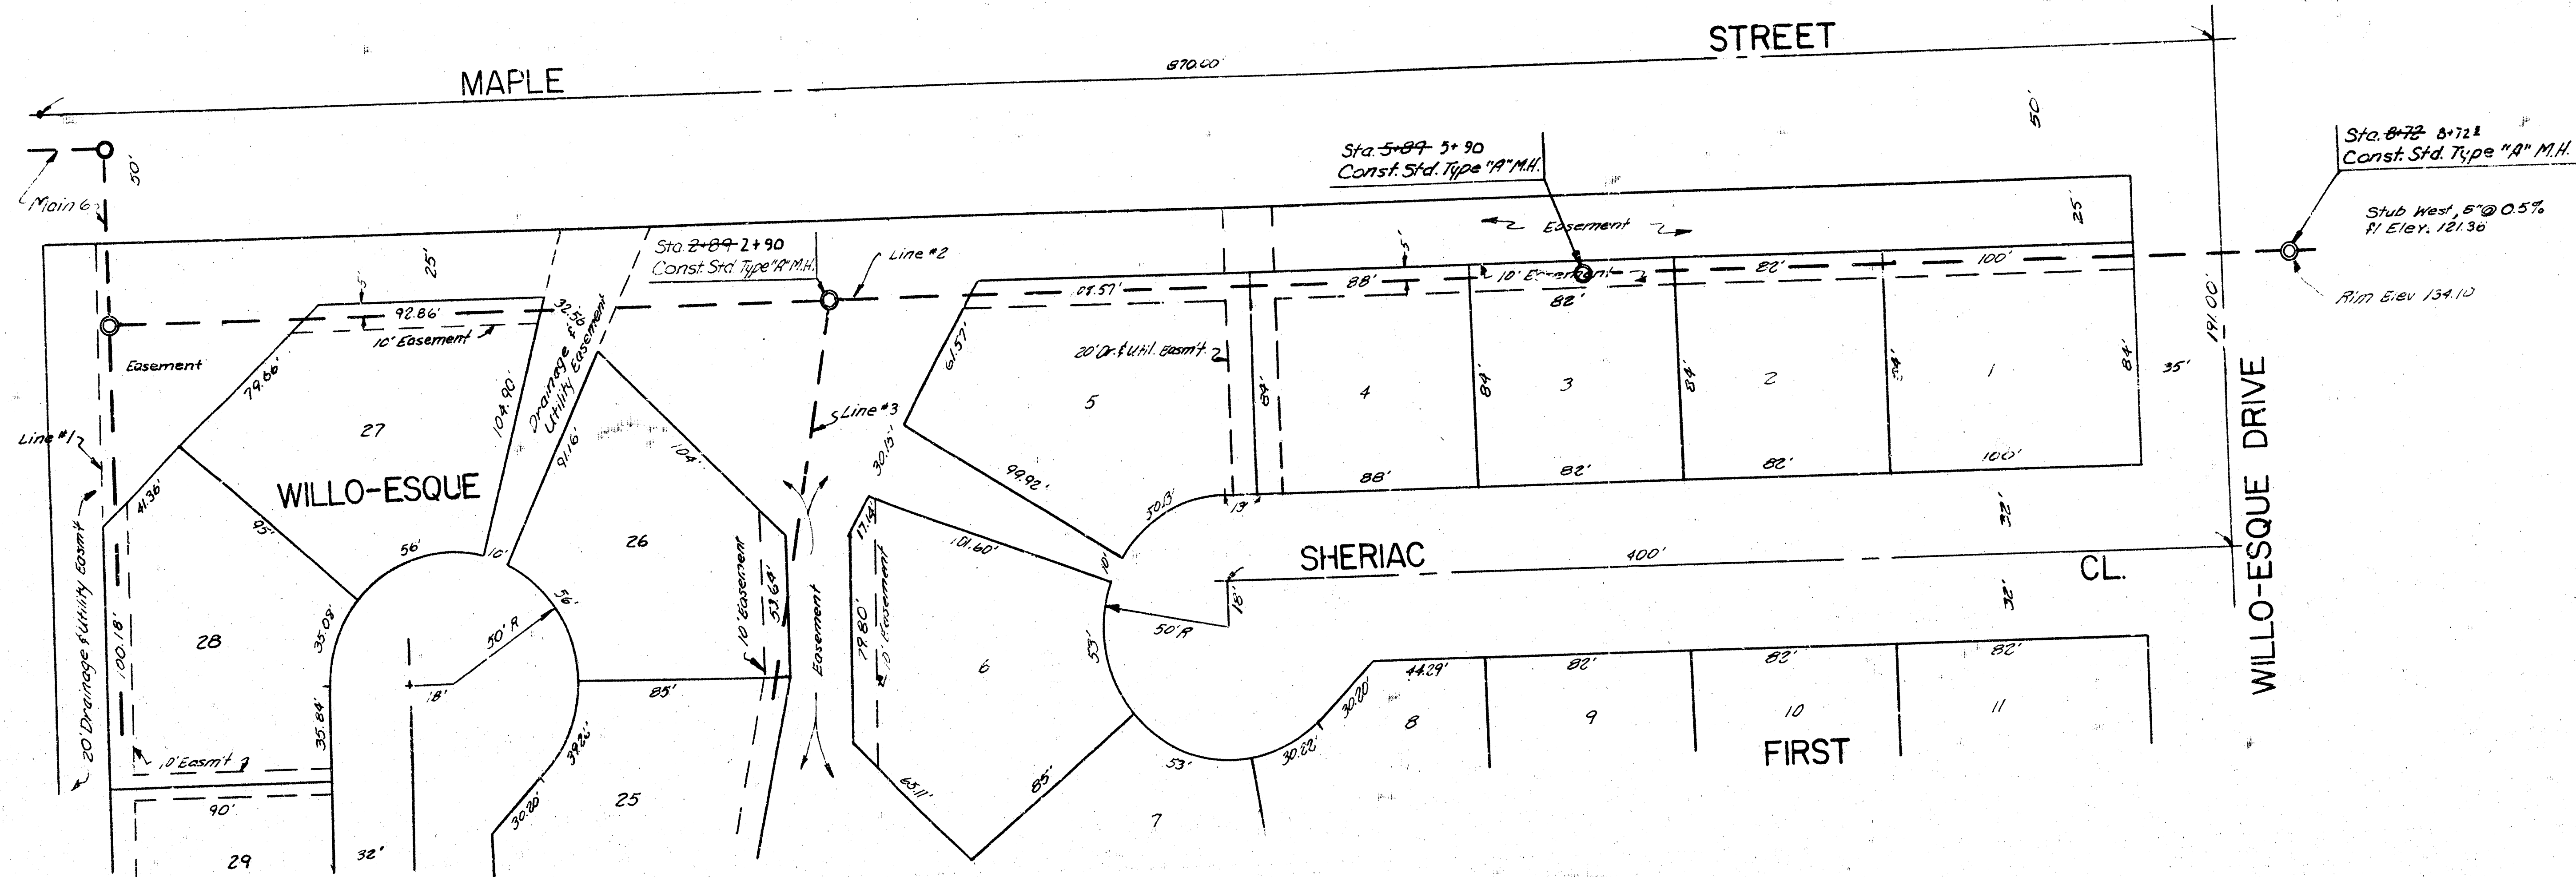


Plan Scale 1" = 40'
 Profile Scale Hor 1" = 40'
 Ver 1" = 5'

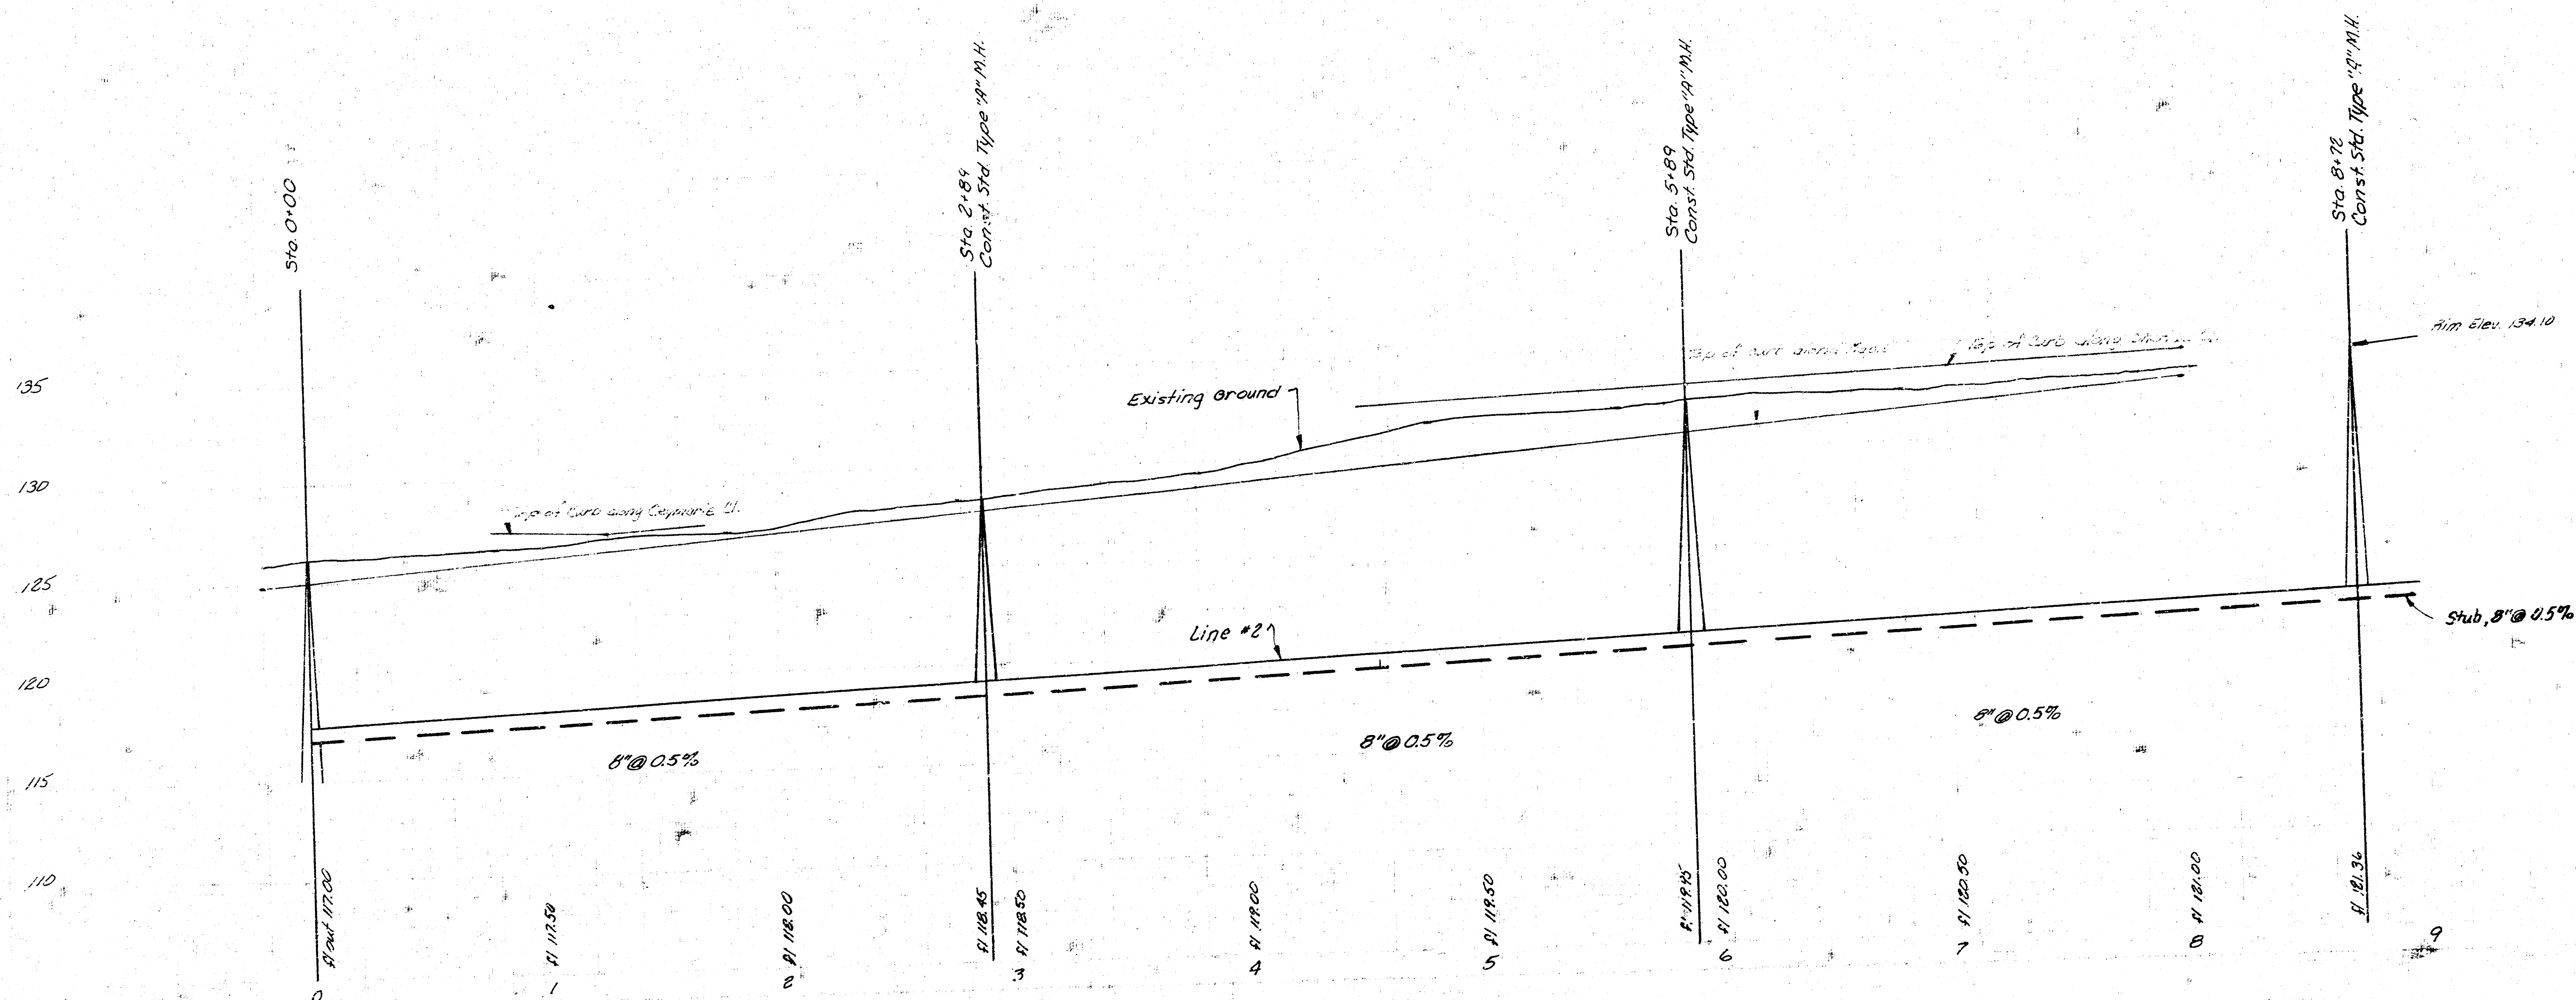



LAT. 49 S.W. INTERCEPTOR
 PROJ. NO. DKL 57205
 SHEET 3 of 6 LINE NO. 2

B.M. 125.81 R.R. spike N. side power pole S side Maple, 10.0 E. of E.L. Ceymarie

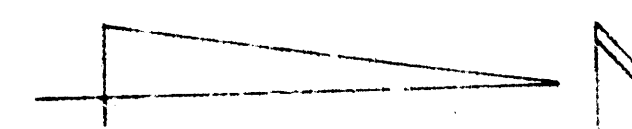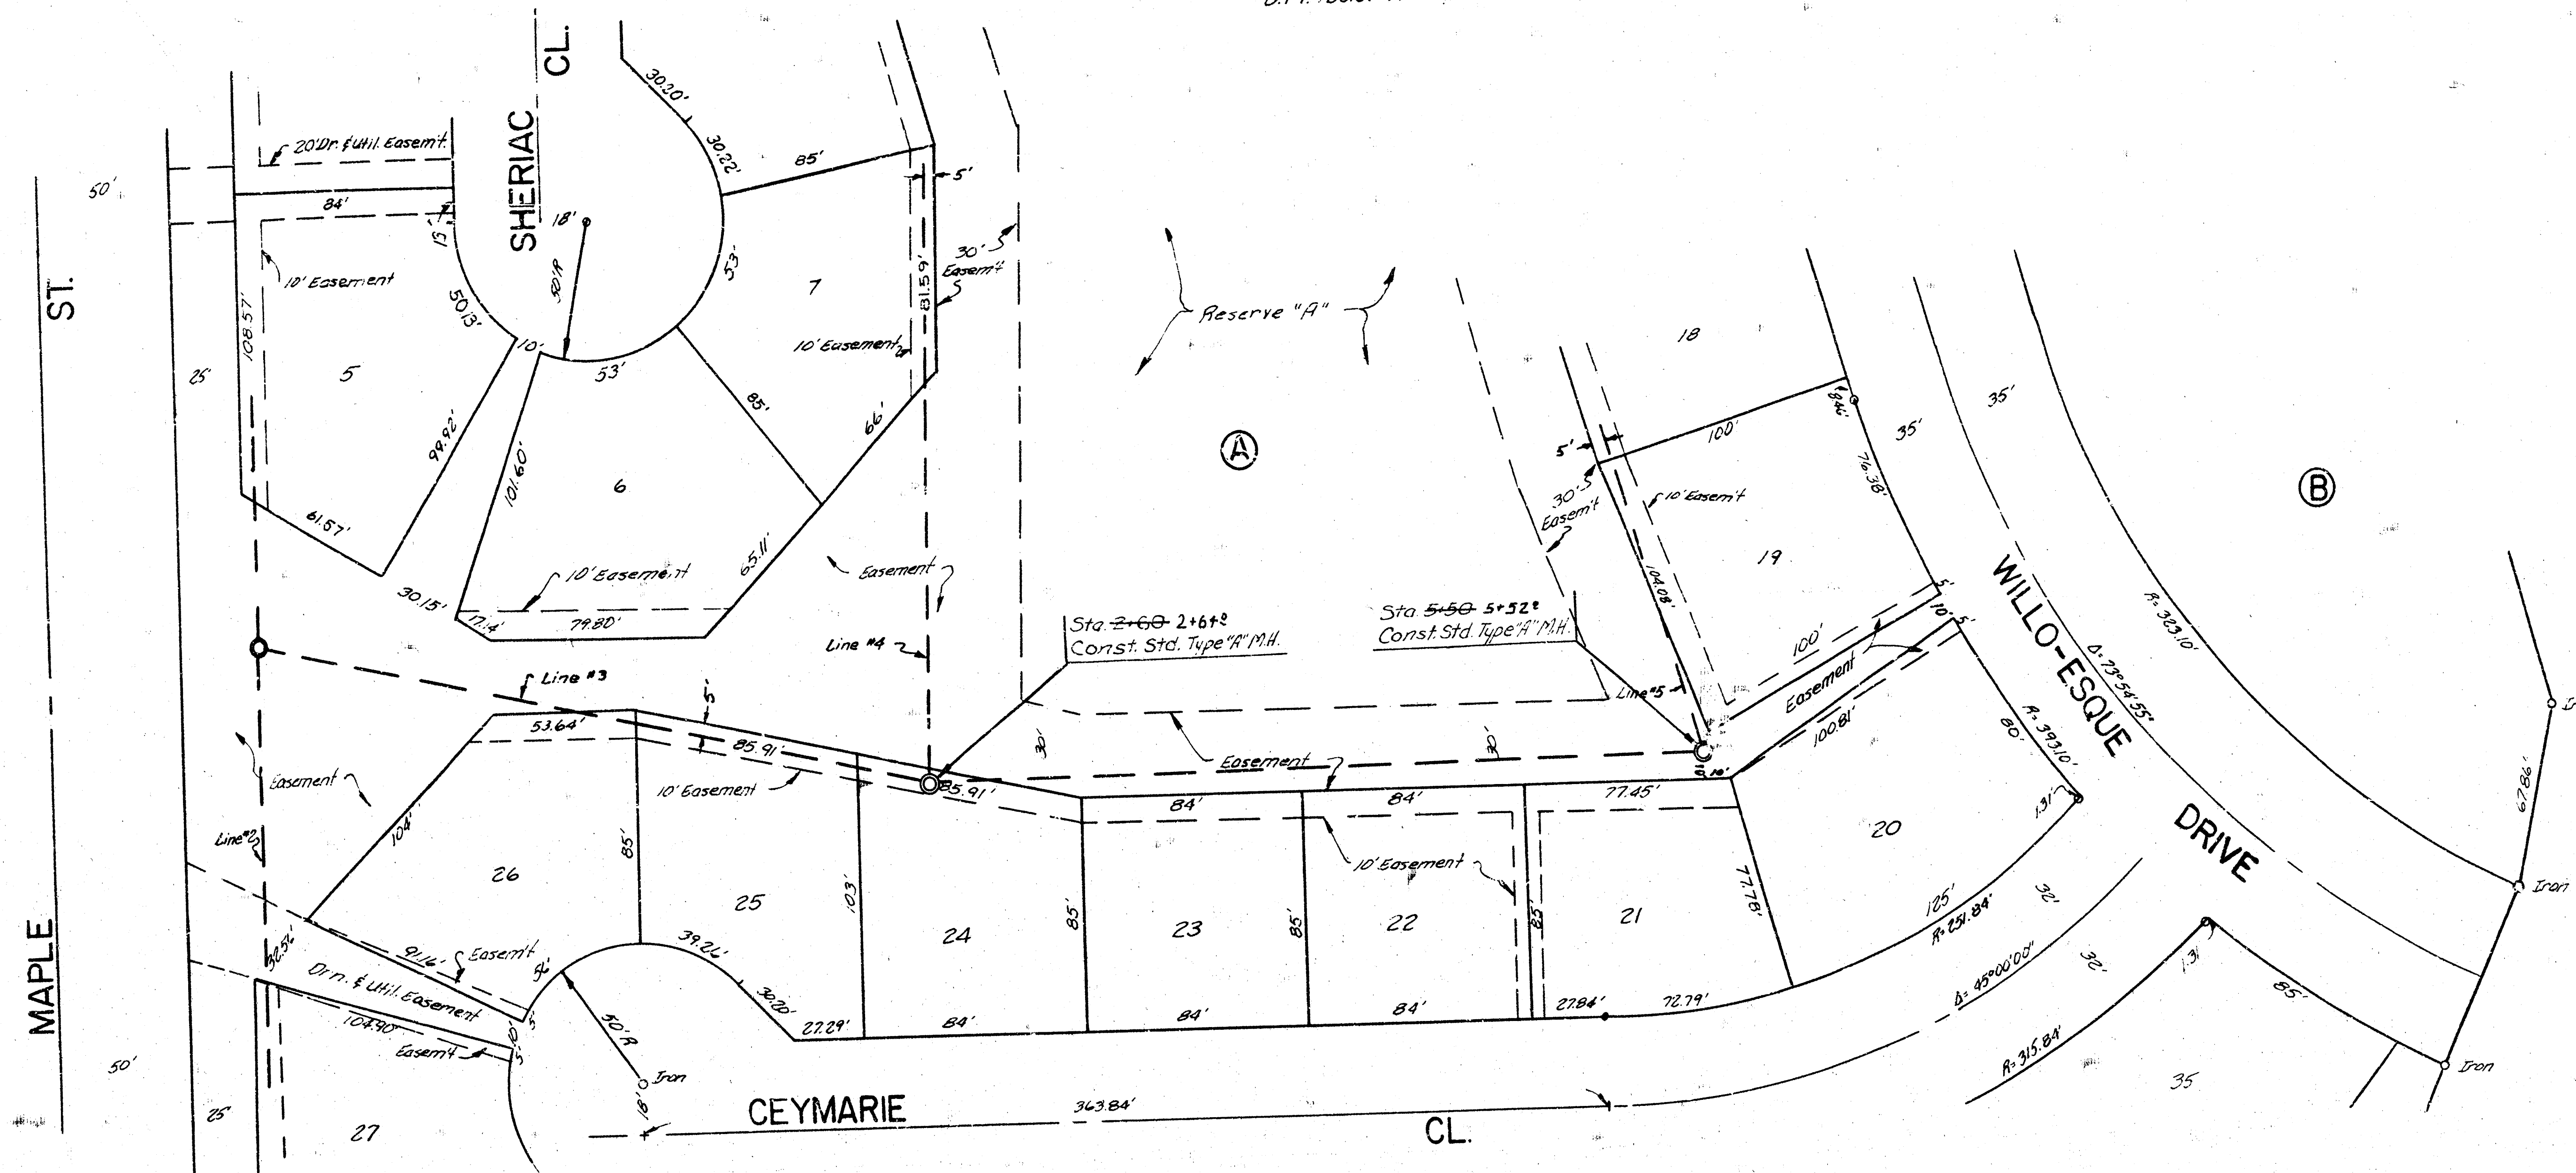


Plan Scale 1"=40'
Profile Scale hor 1"=40'
" ver 1"=5'

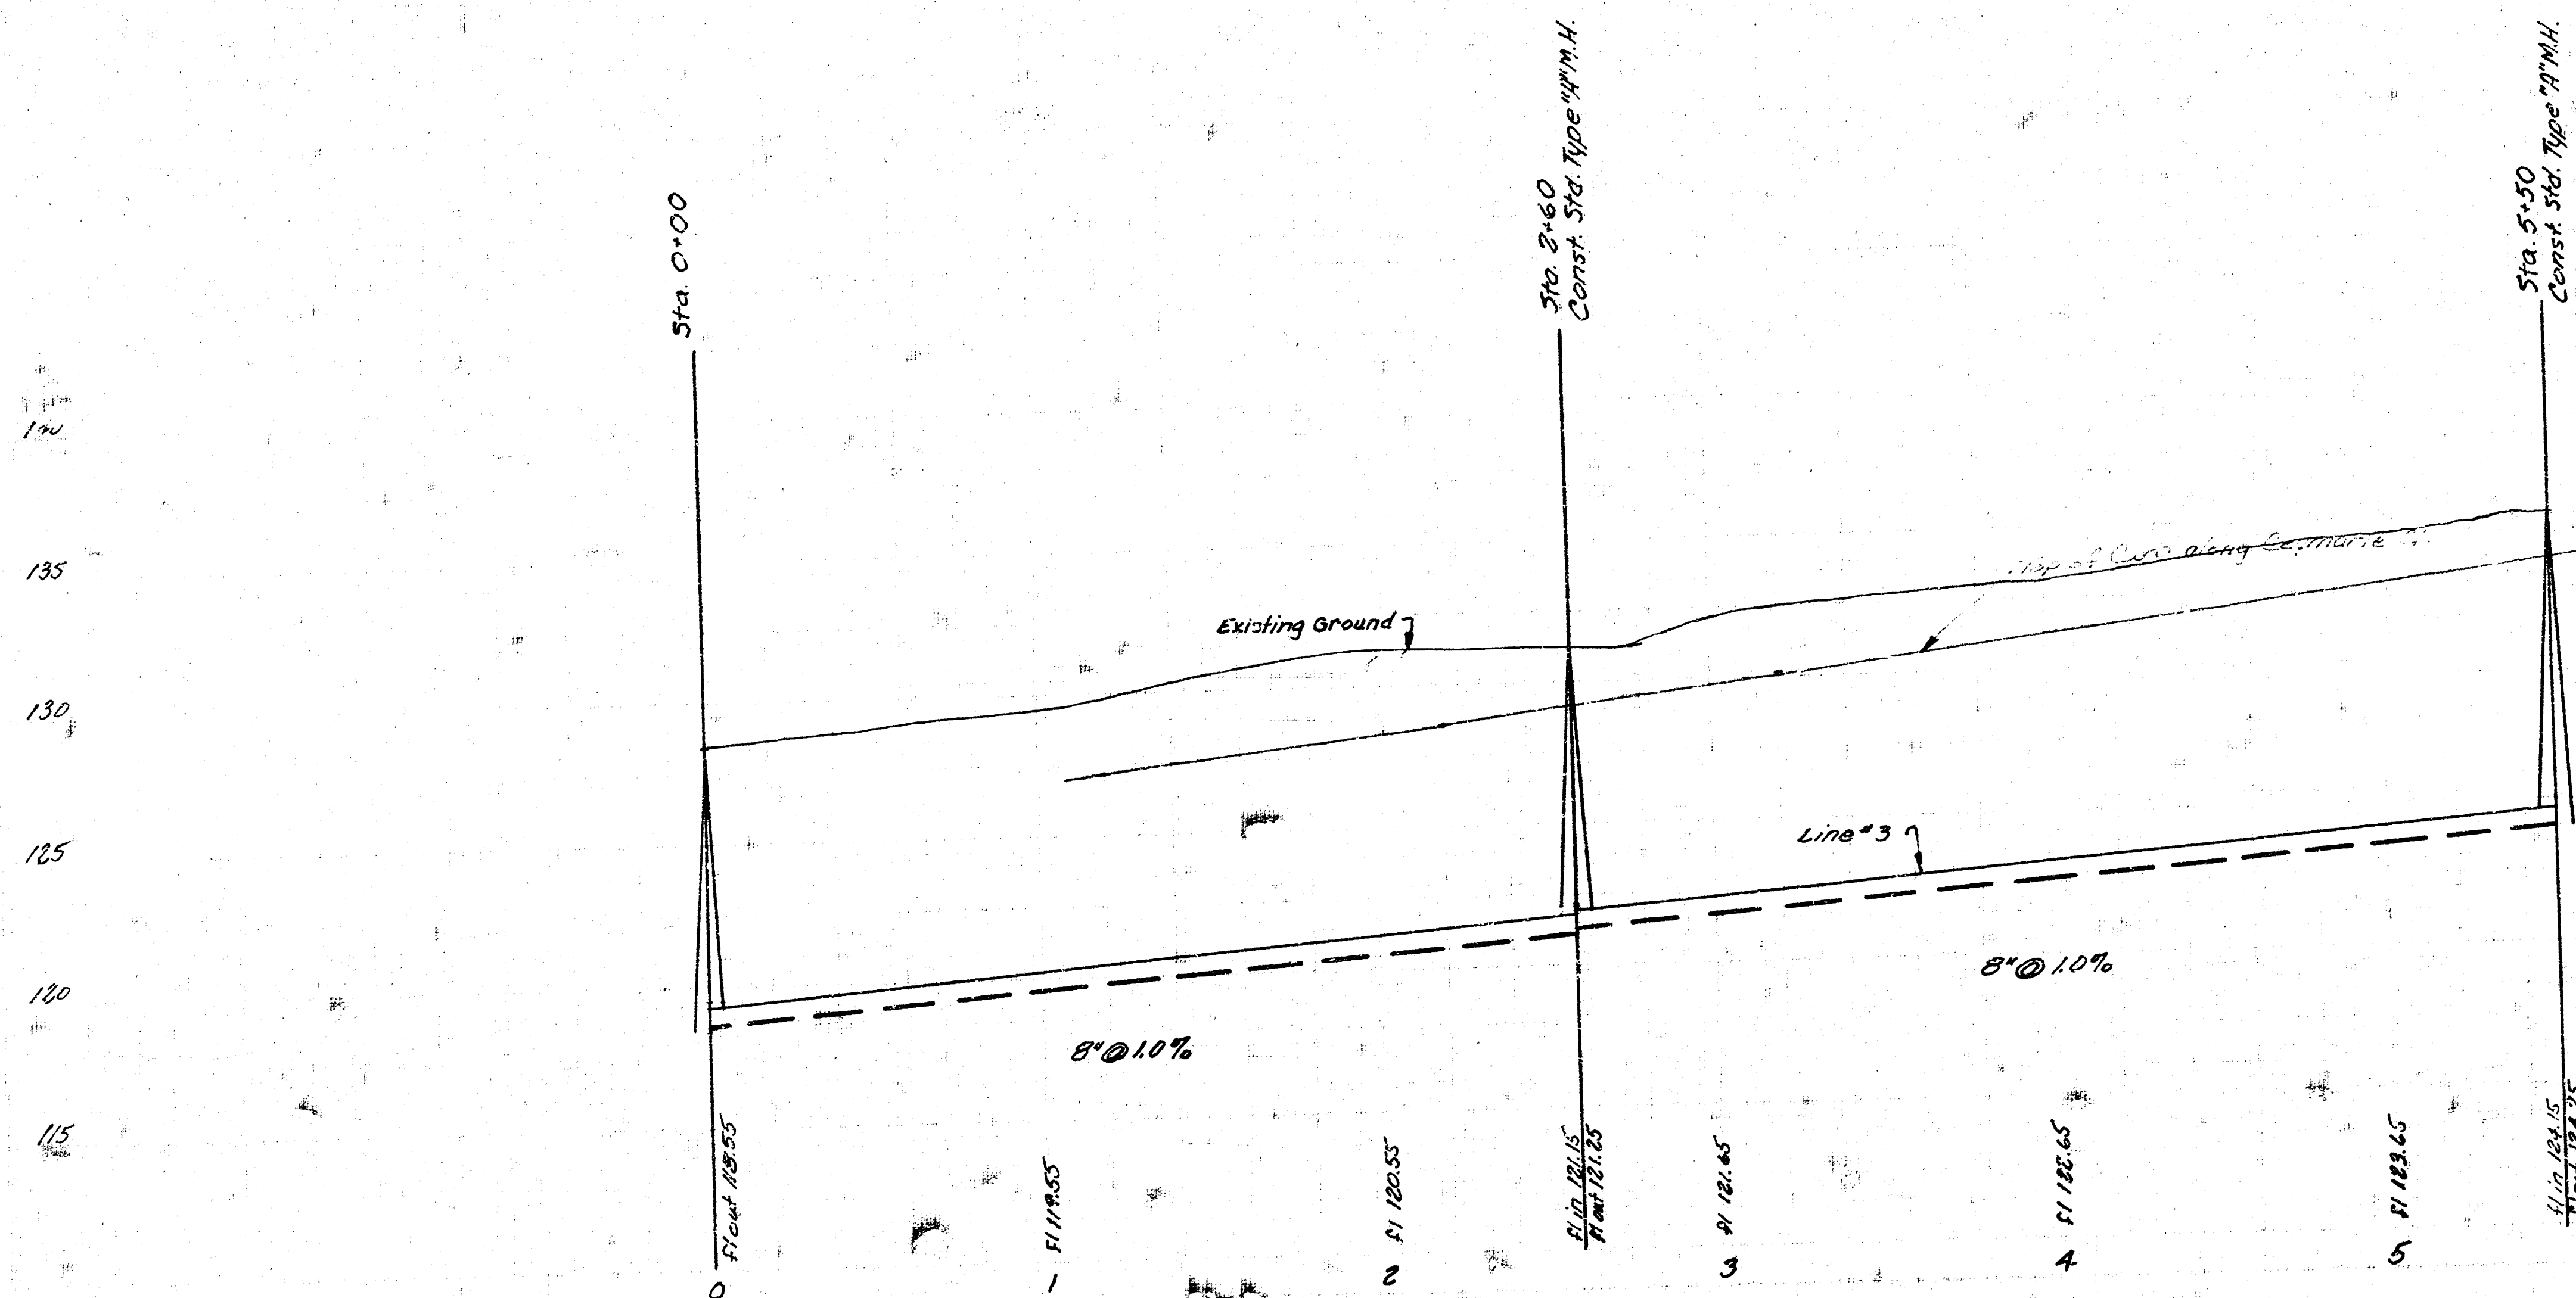


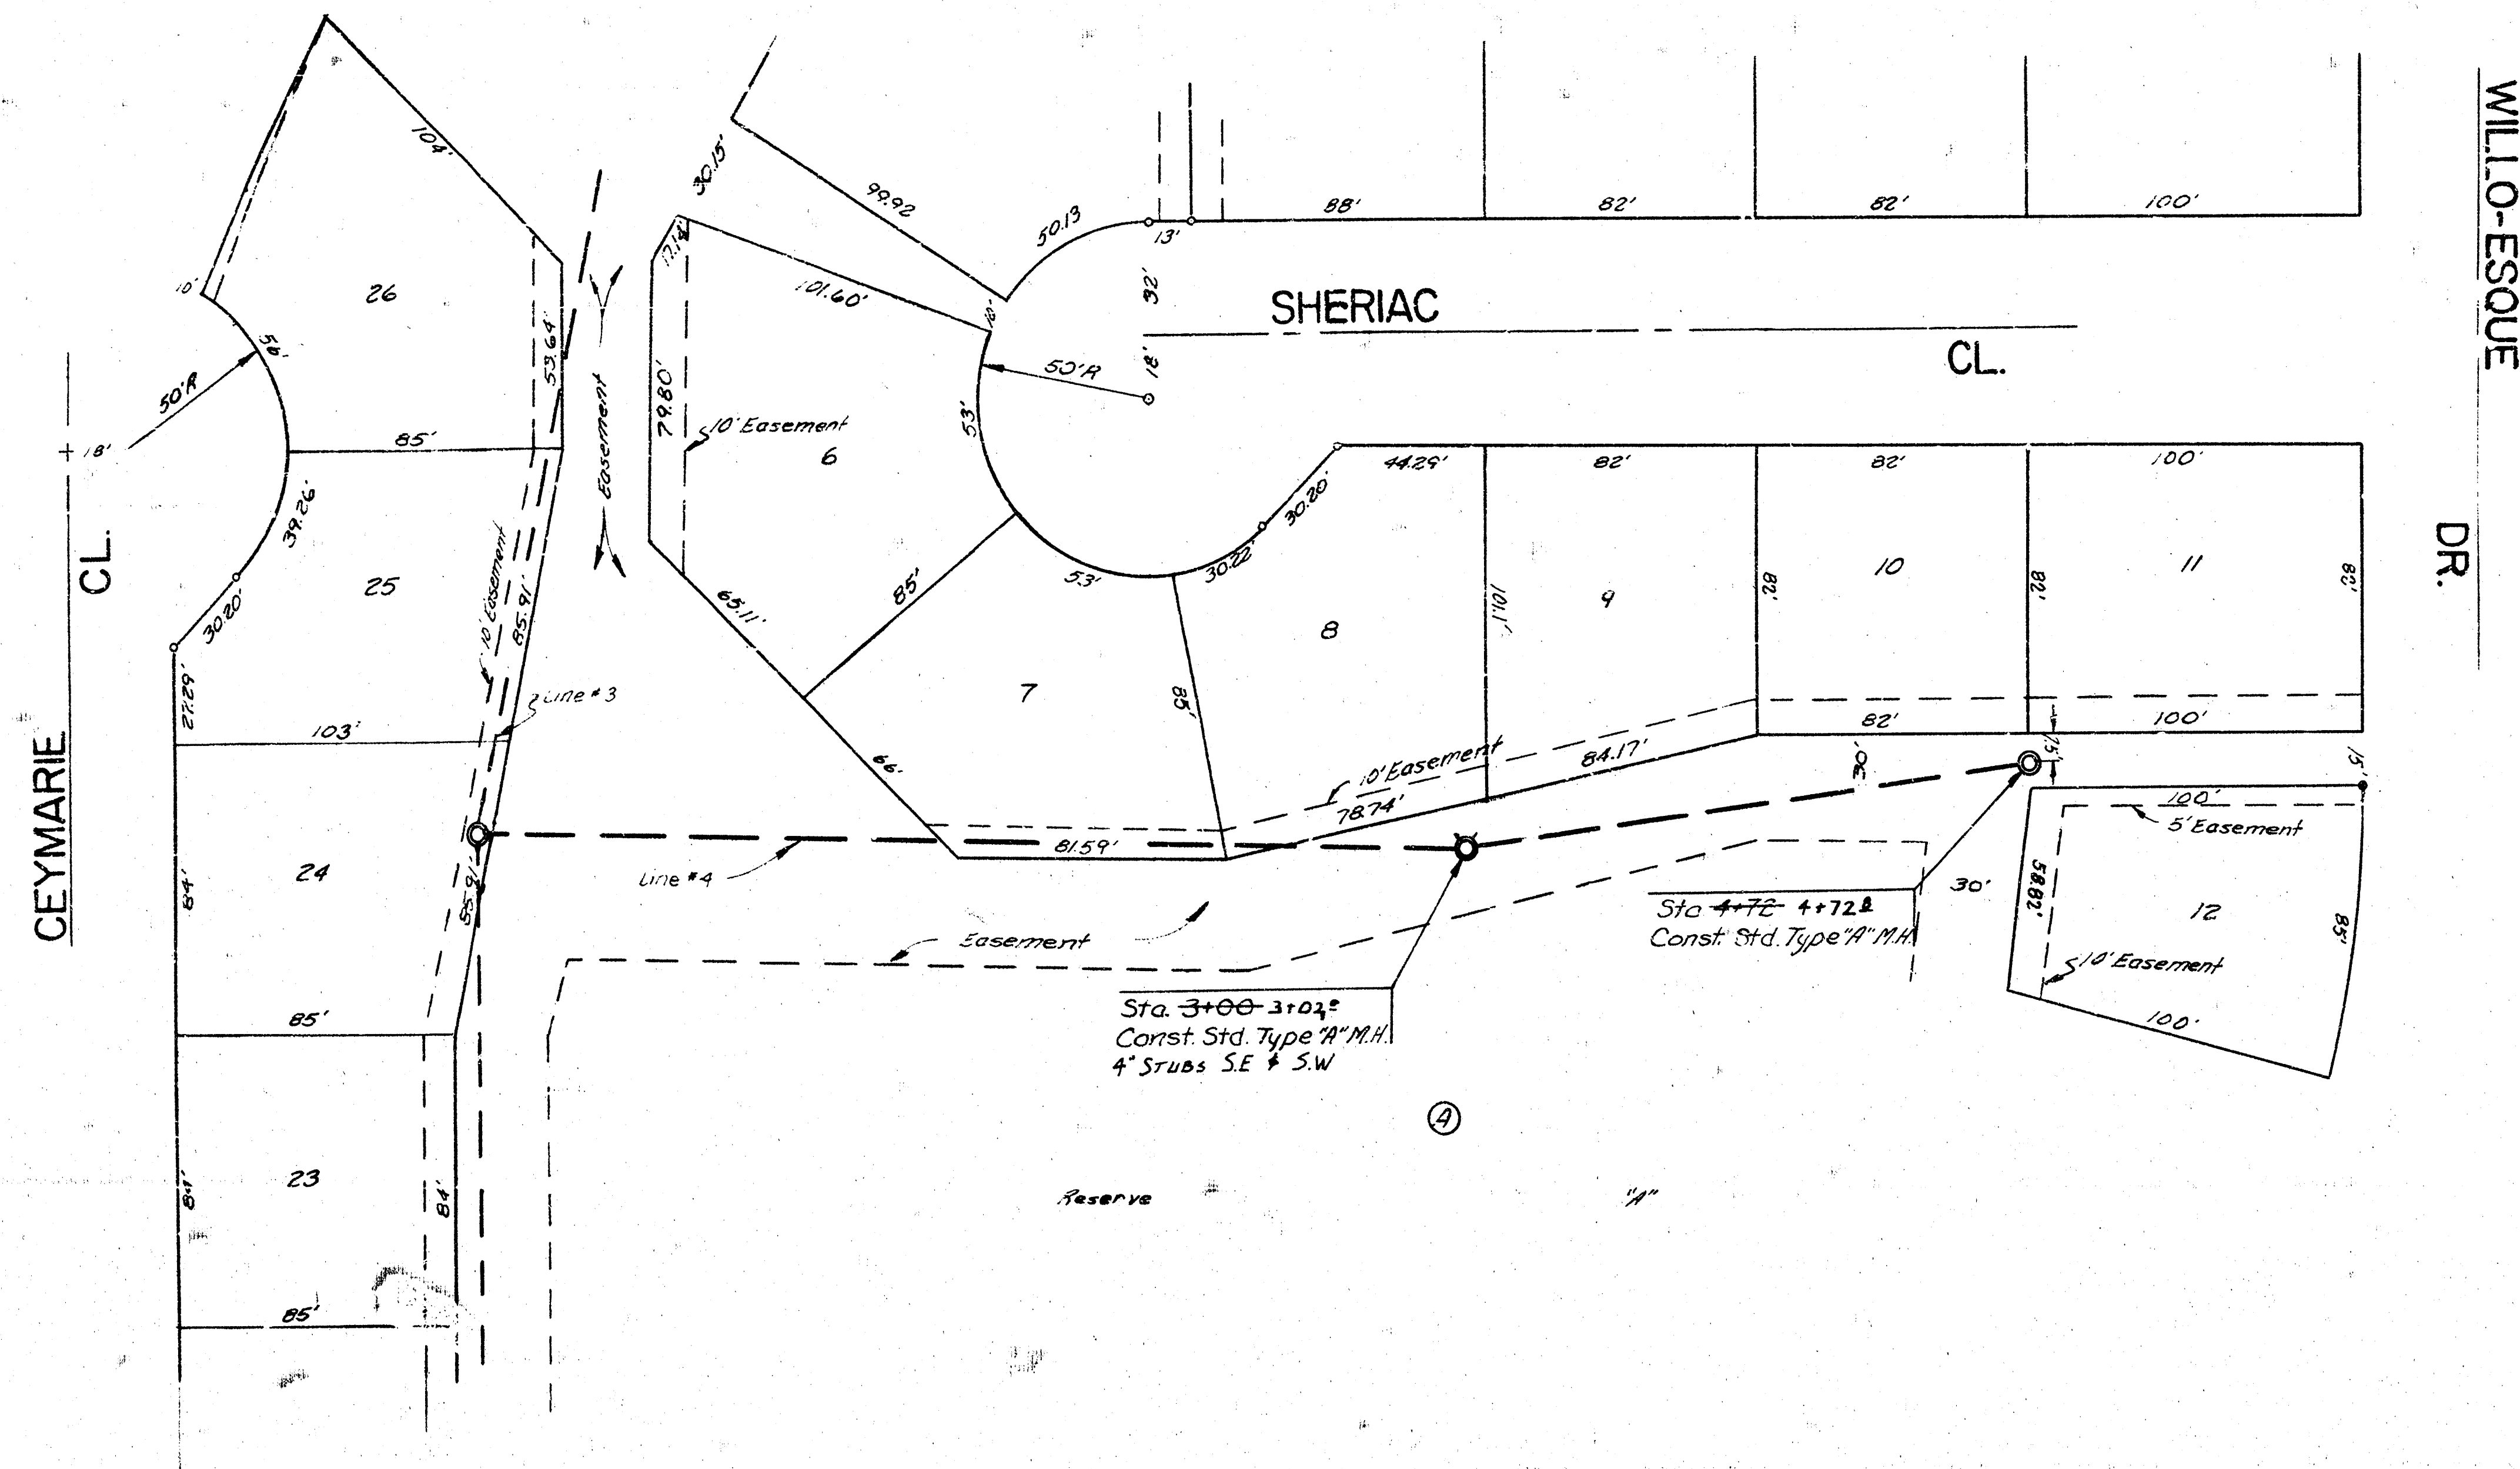

Plan Scale 1" = 40'
 Profile Scale Hor. 1" = 40'
 Profile Scale Ver. 1" = 5'

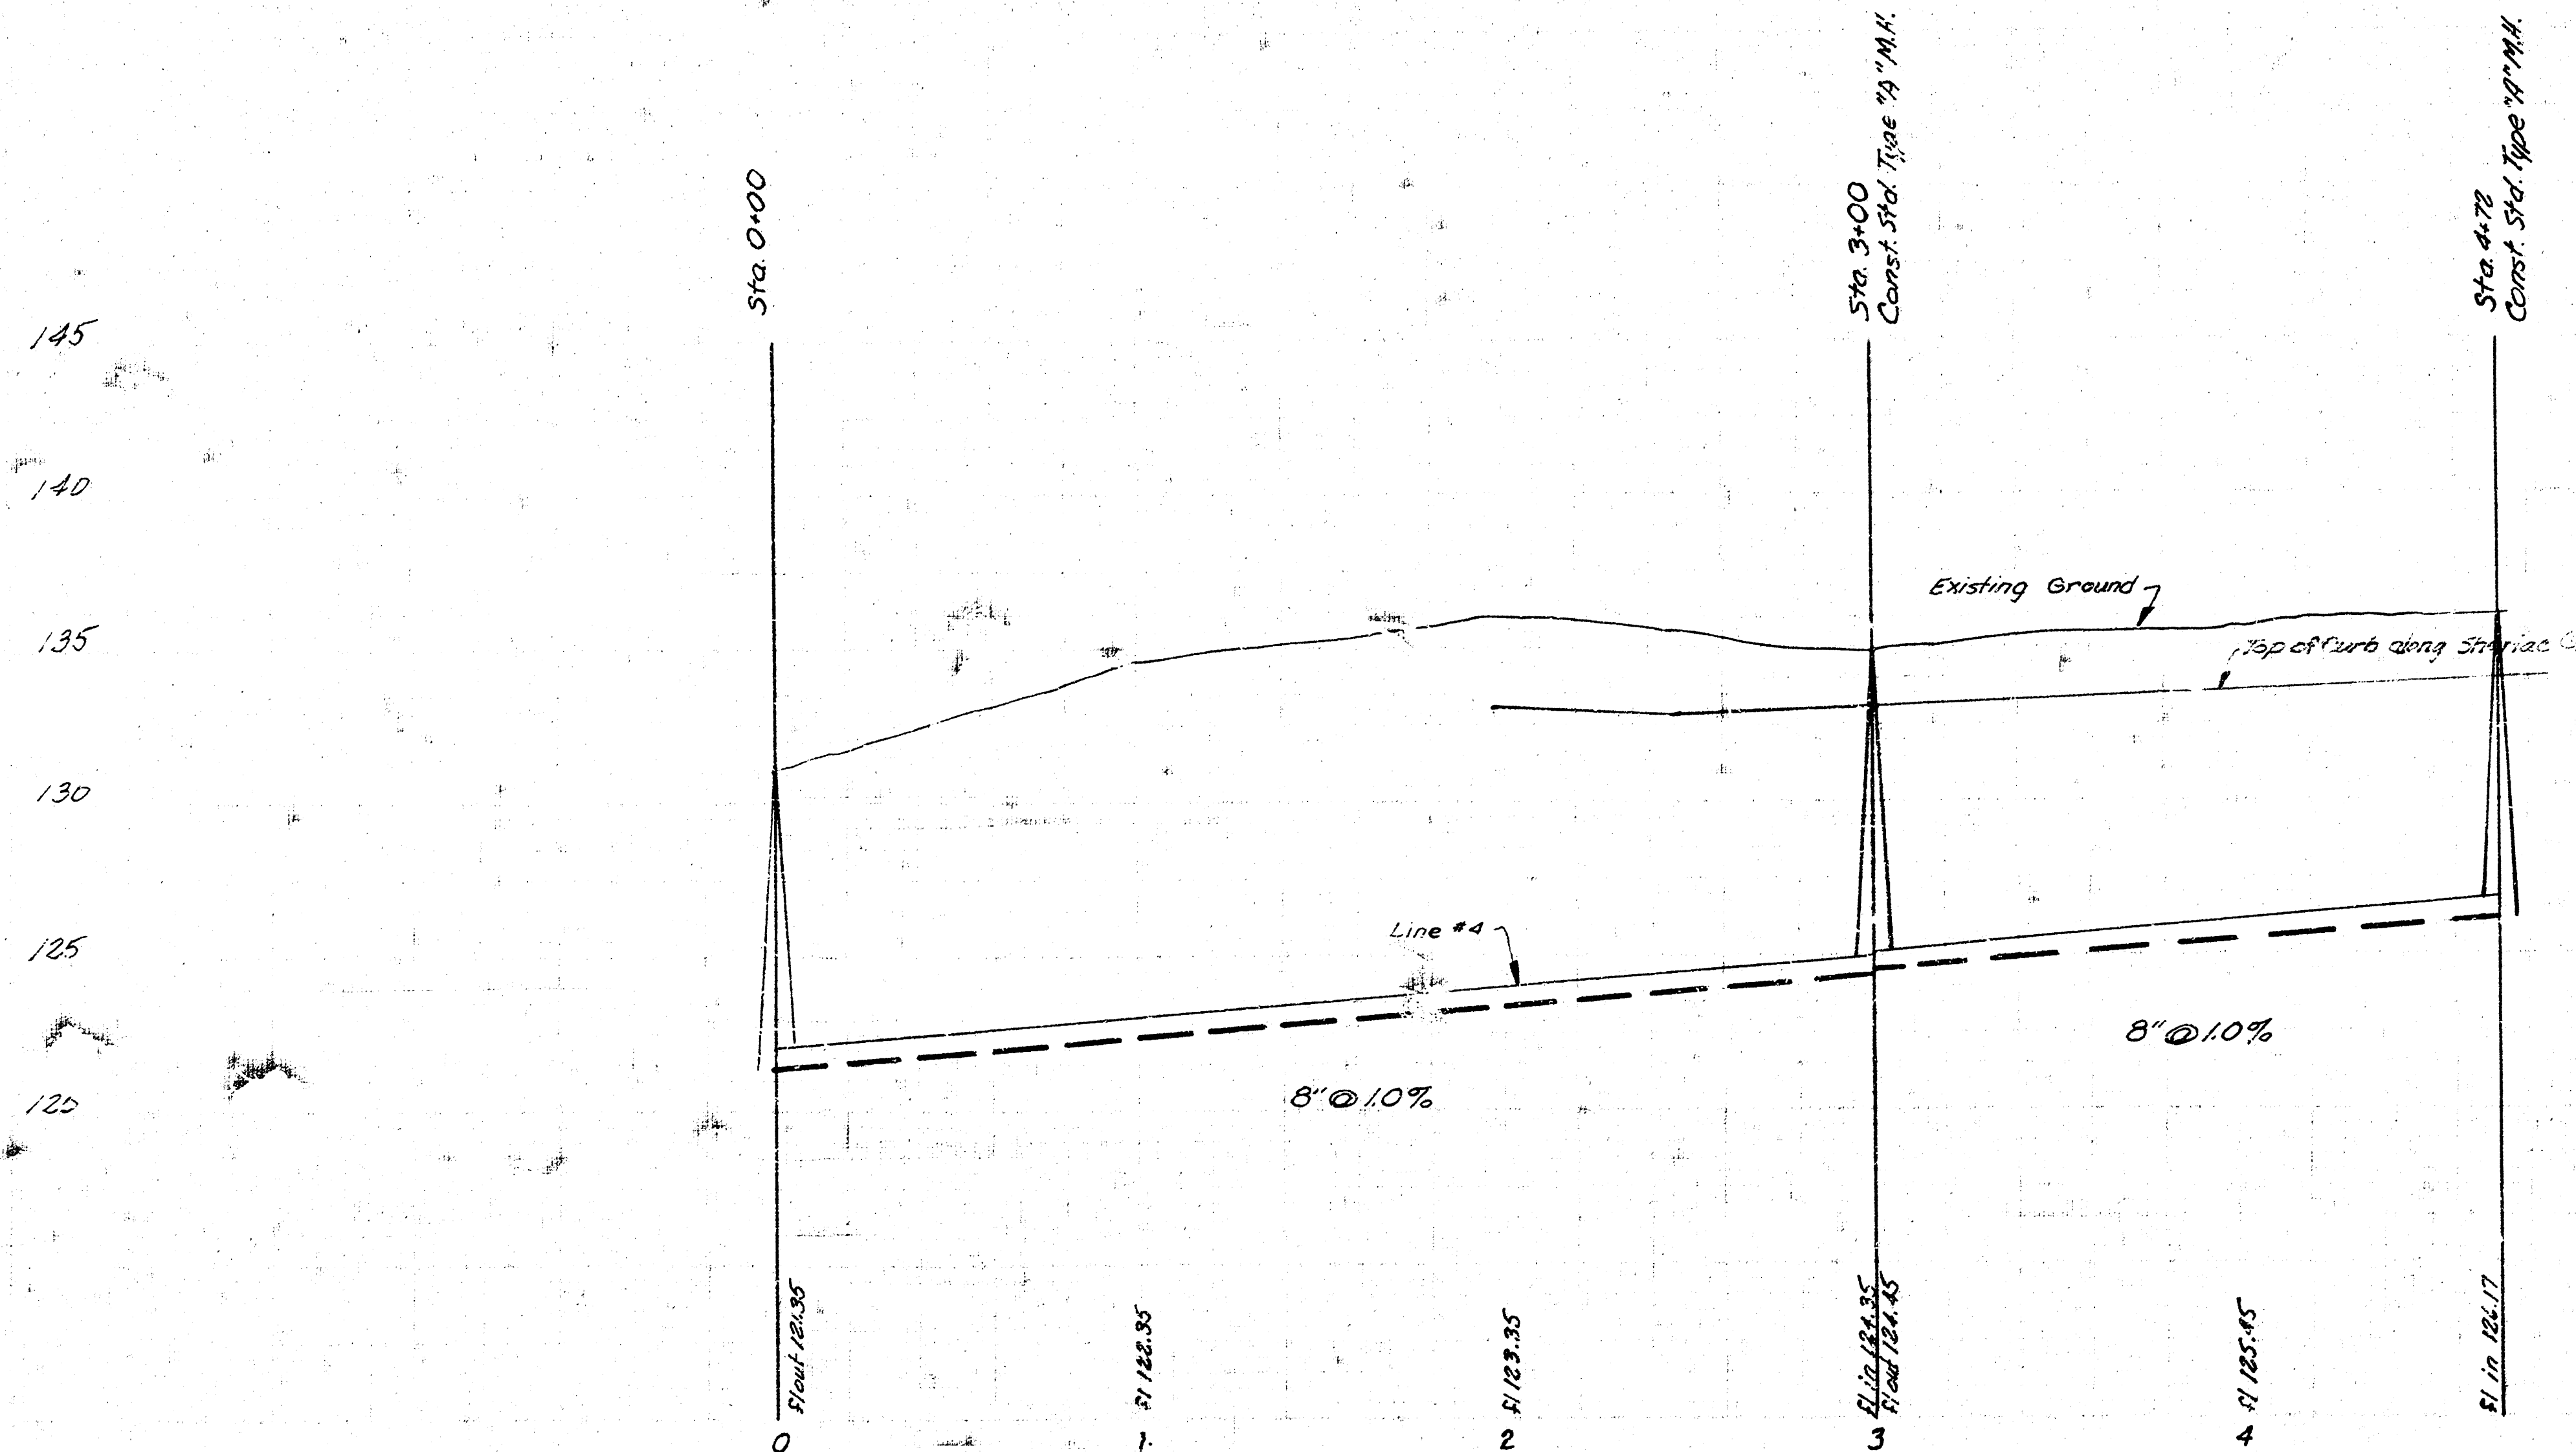

LA 45
LADGEY

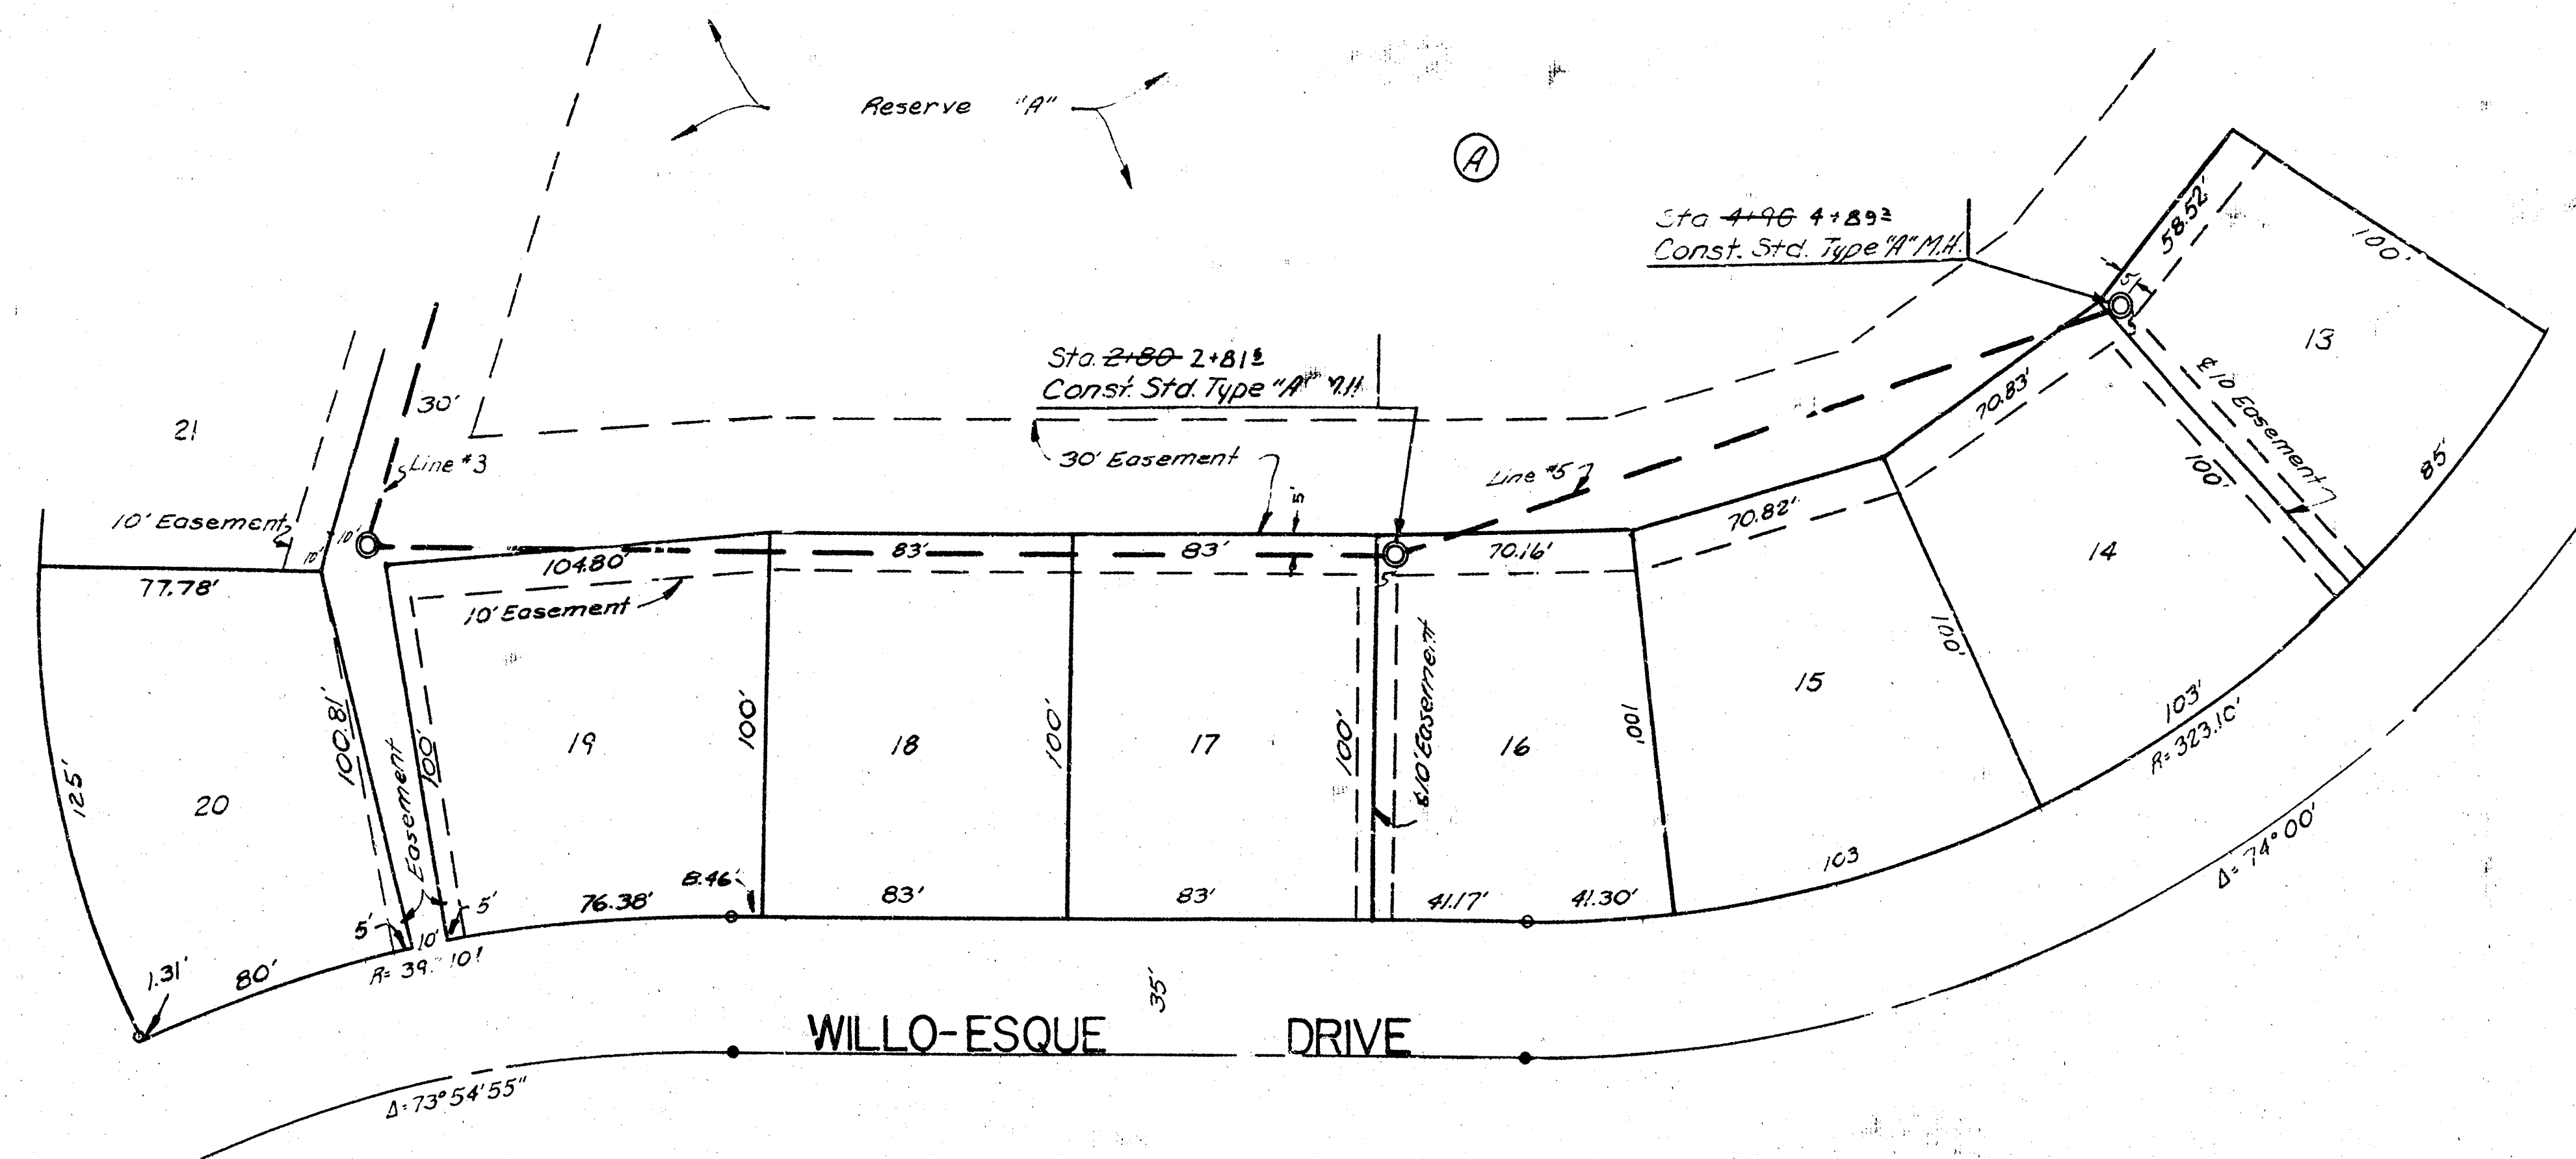

Plan Scale 1"=40'
Profile Scale Hor 1"=40'
Profile Scale Ver 1"=5'

