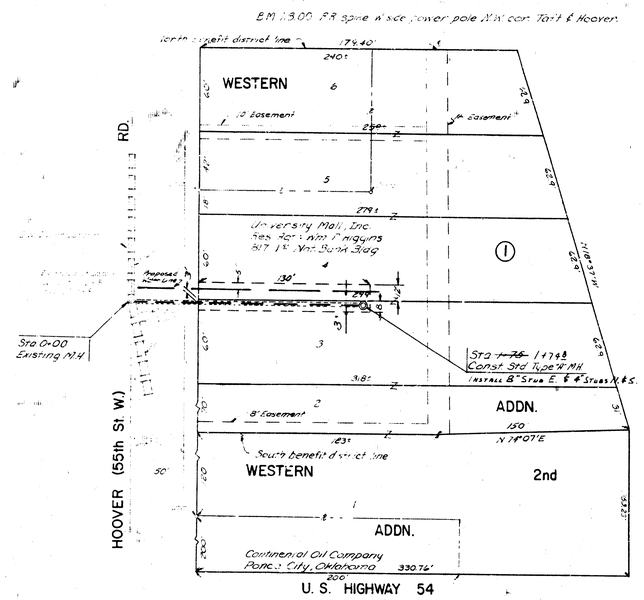

Note: Contractor shall contact Ben Adkins of Derby Pipe Line Co. prior to crossing under Derby pipeline on Hoover Rd.

Note: Field Engineer shall check stub's flow elevation prior to construction of sanitary sewer.

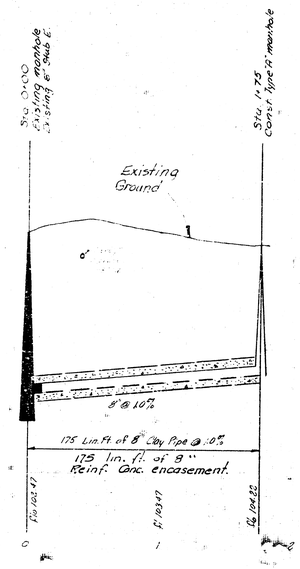

Plan Scale 1" = 40'
Profile Scale Hor. 1" = 40'
Profile Scale Ver. 1" = 5'

"As Built" Final Measurements 7-28

LAT. 50 S.W. INTERCEPTOR
R. W. LINN CITY ENGINEER
CITY OF WICHITA, KS.
PROJ. NO. DBKL 572033
DATE 7-72

14 4 5 5