


NOTE:
Clearing of Right-of-Way shall include removal of all trees, fence, hedge and etc. - within the easement. All equipment, labor and tools necessary to complete the items shall be included in price bid of "Lump Sum Clear R/W."

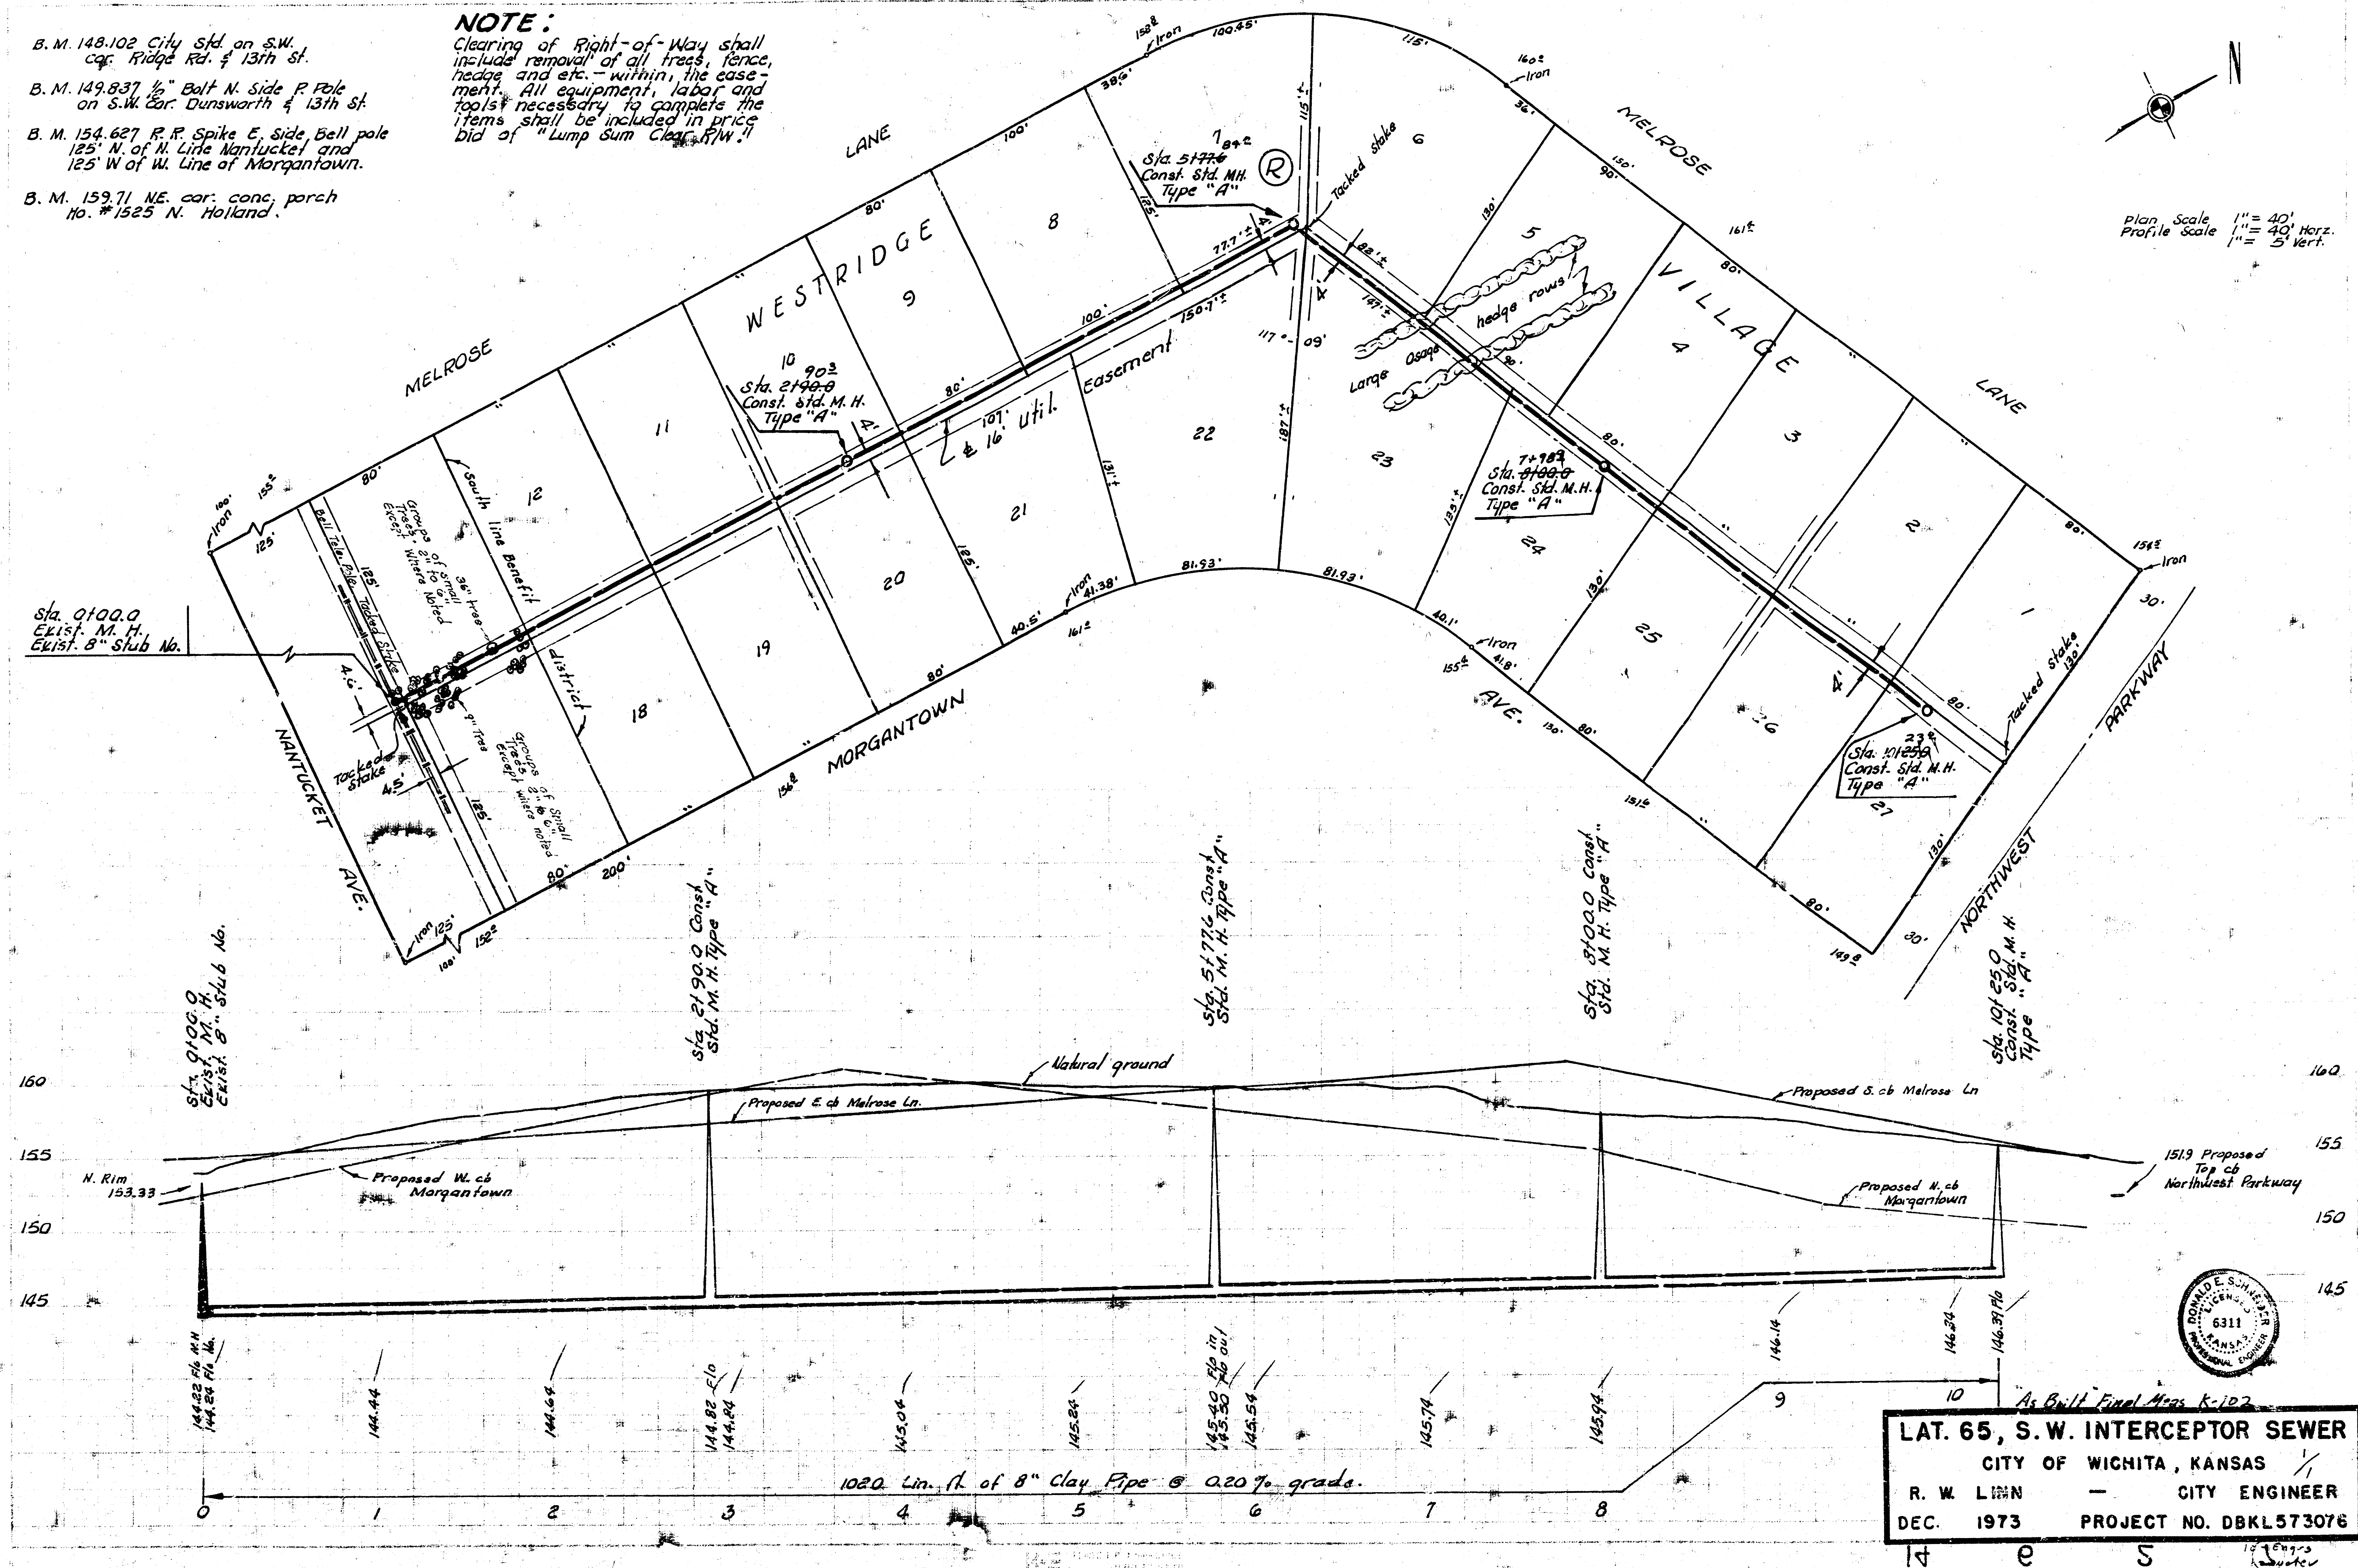

FILMED FROM THE BEST