
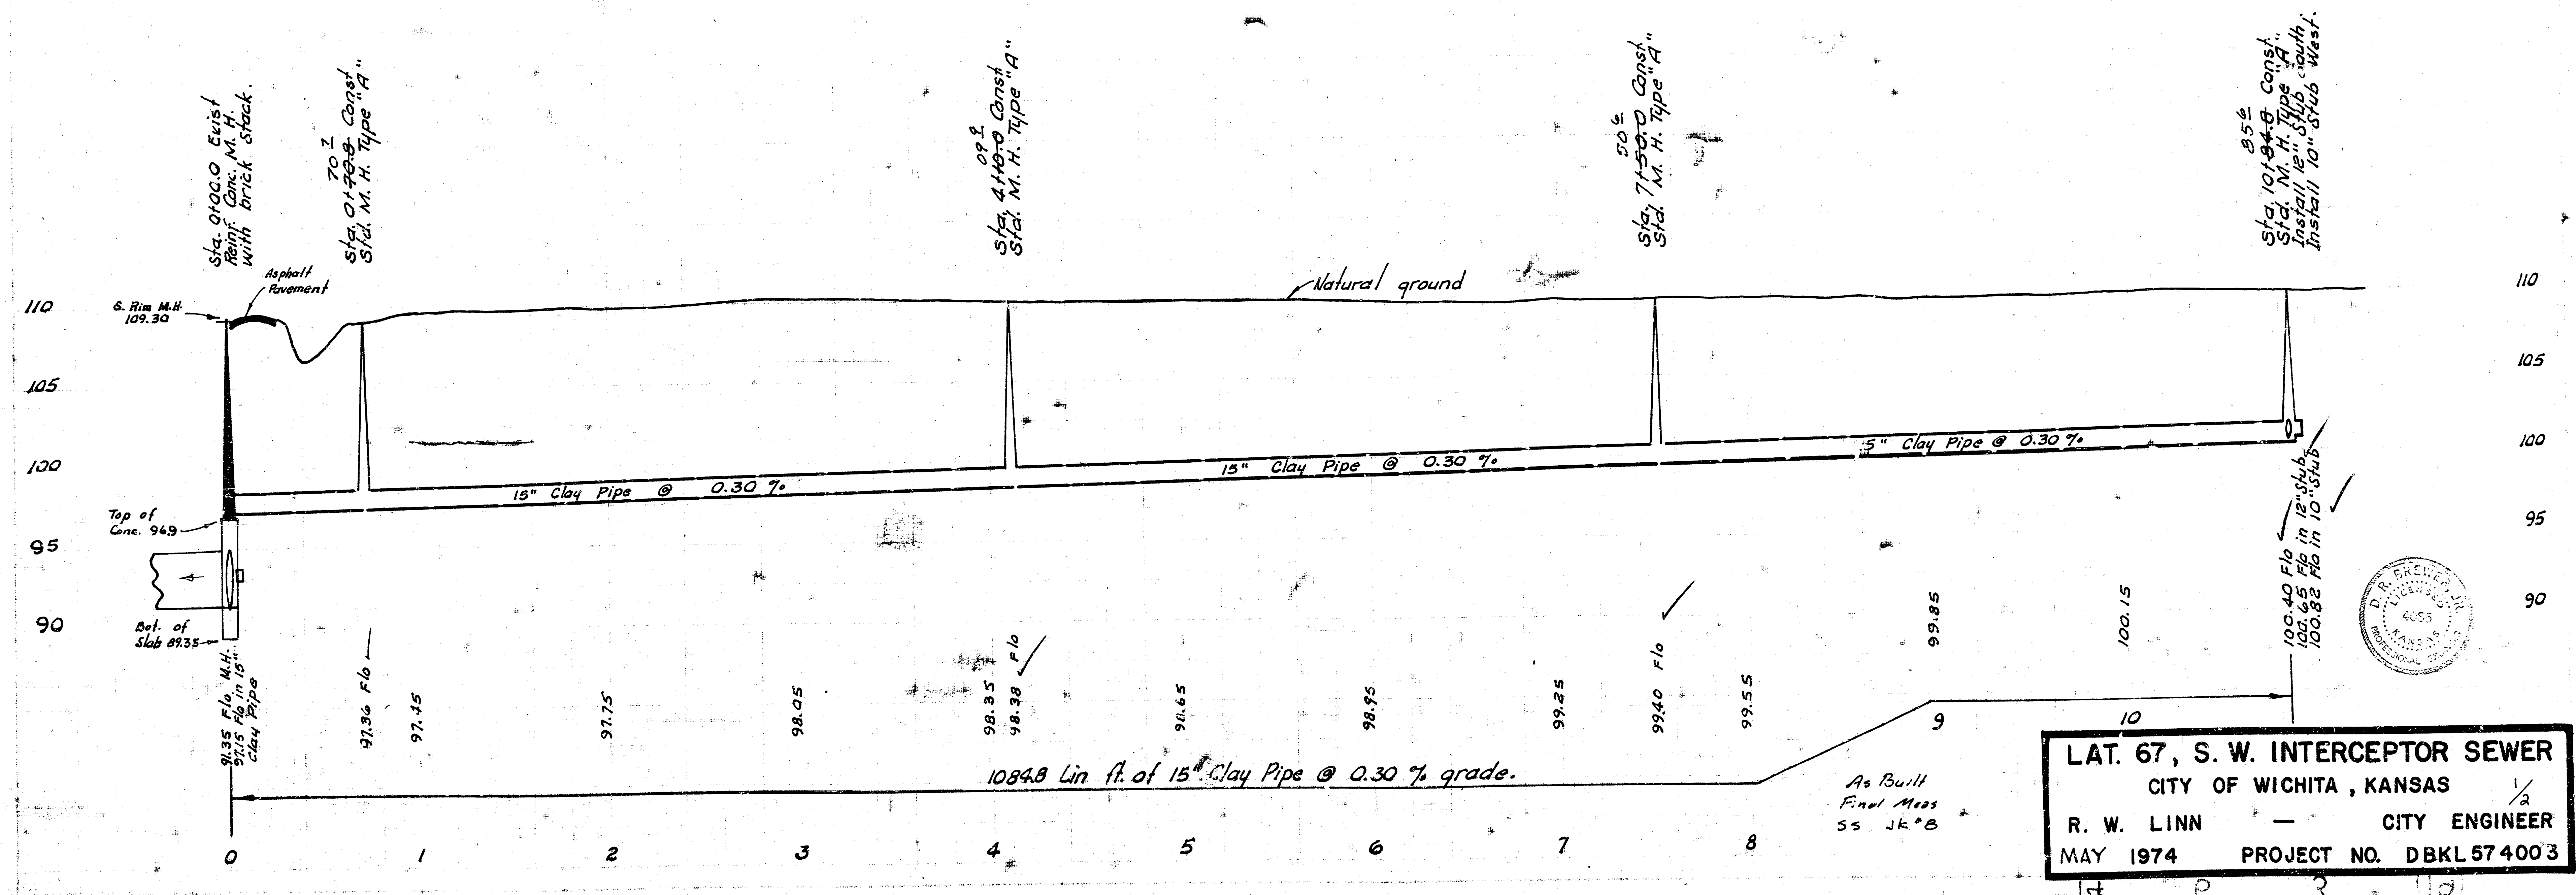


14-3-1-10
10 M. H. M.
10-10-74
Pg 2


69
A. R. W.
U. R. W.

B. M. 108.43 City Std. Hoover & 31st. St. So.
44' E. & 32' N. & both.
B. M. 113.83 "P" cut SE. cor. conc. Flyme N. Side
31st. Sta. 13150 by Cassa Water tower.

Plan Scale 1" = 40'
Profile Scale 1" = 40' Horz.
1" = 5' Vert.

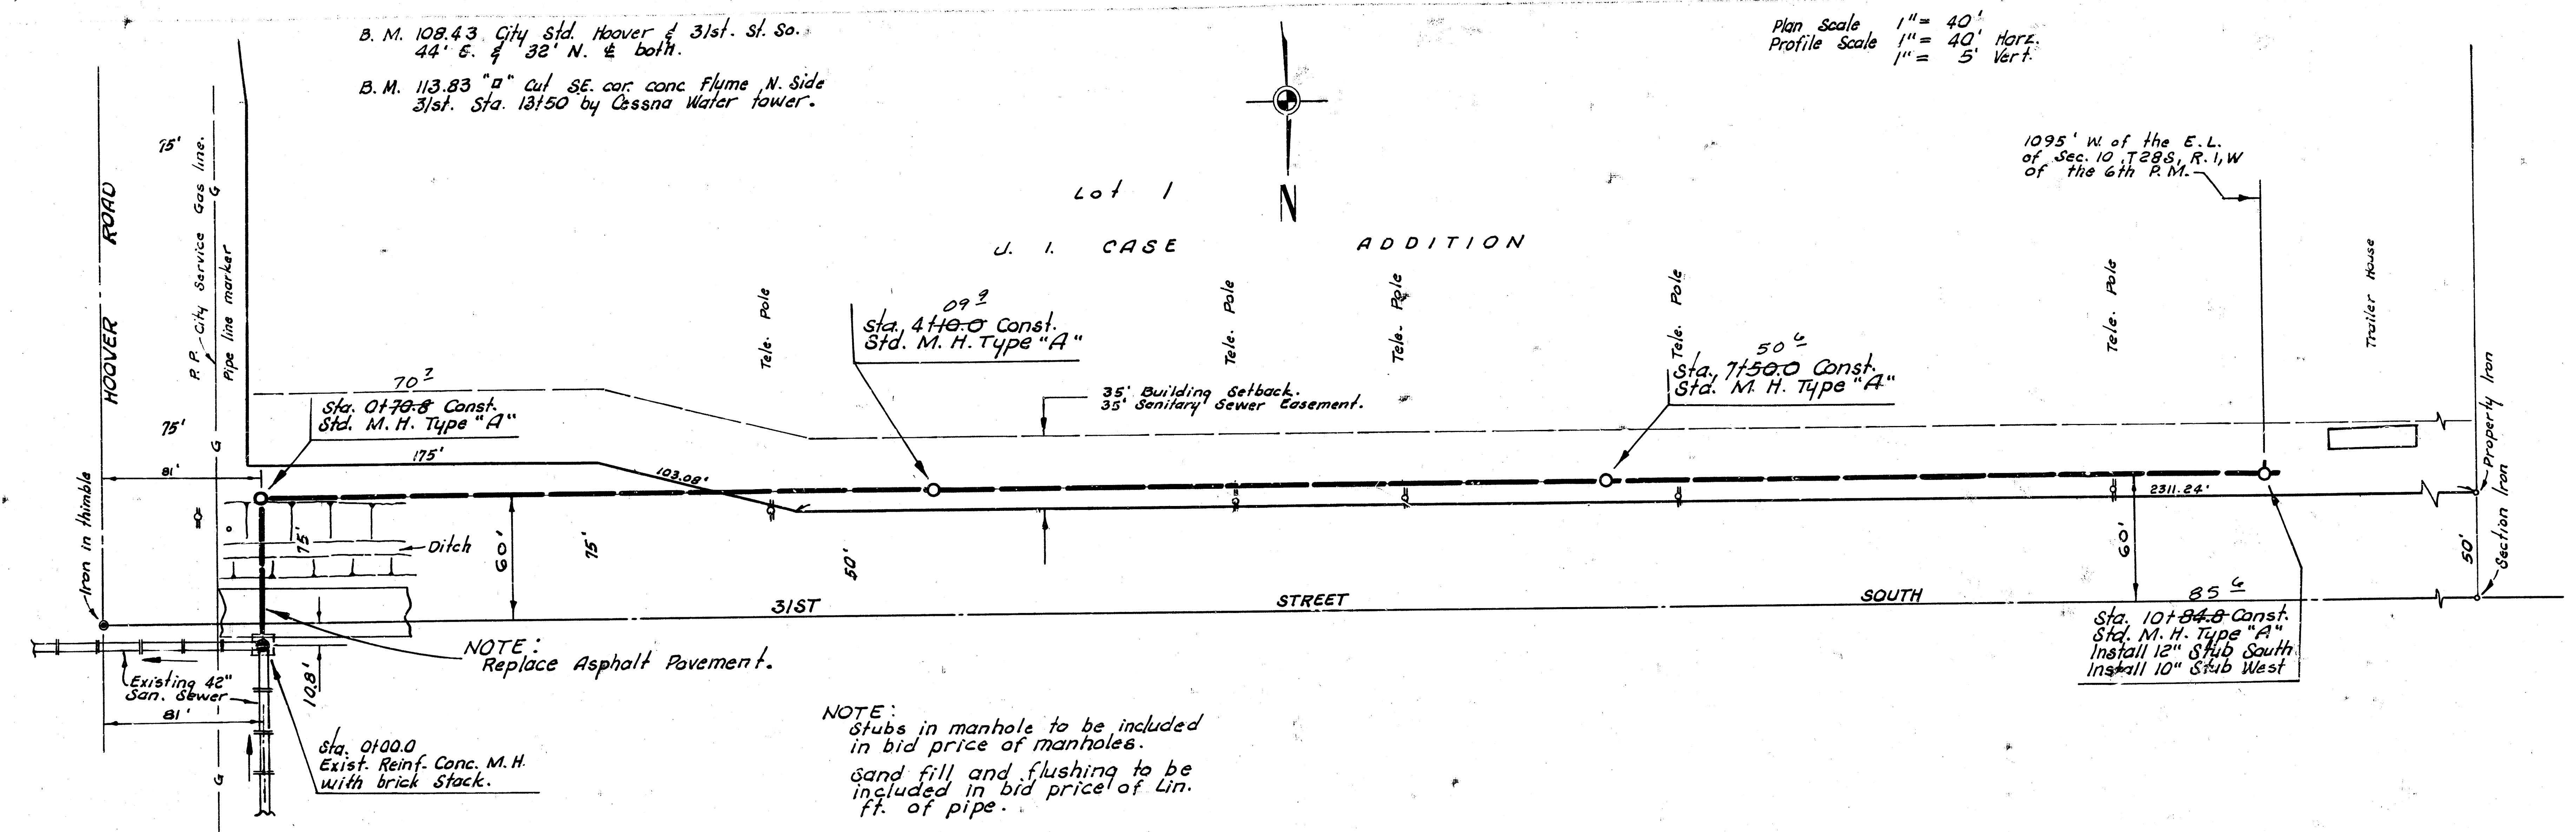

LAT. 67, S. W. INTERCEPTOR SEWER
CITY OF WICHITA, KANSAS
R. W. LINN — CITY ENGINEER
MAY 1974 PROJECT NO. DBKL 574003

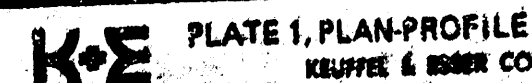

LAT. 67, S. W. INTERCEPTOR SEWER
CITY OF WICHITA, KANSAS $\frac{3}{2}$
R. W. LINN — CITY ENGINEER
MAY 1974 PROJECT NO. DBKL 57 4003