


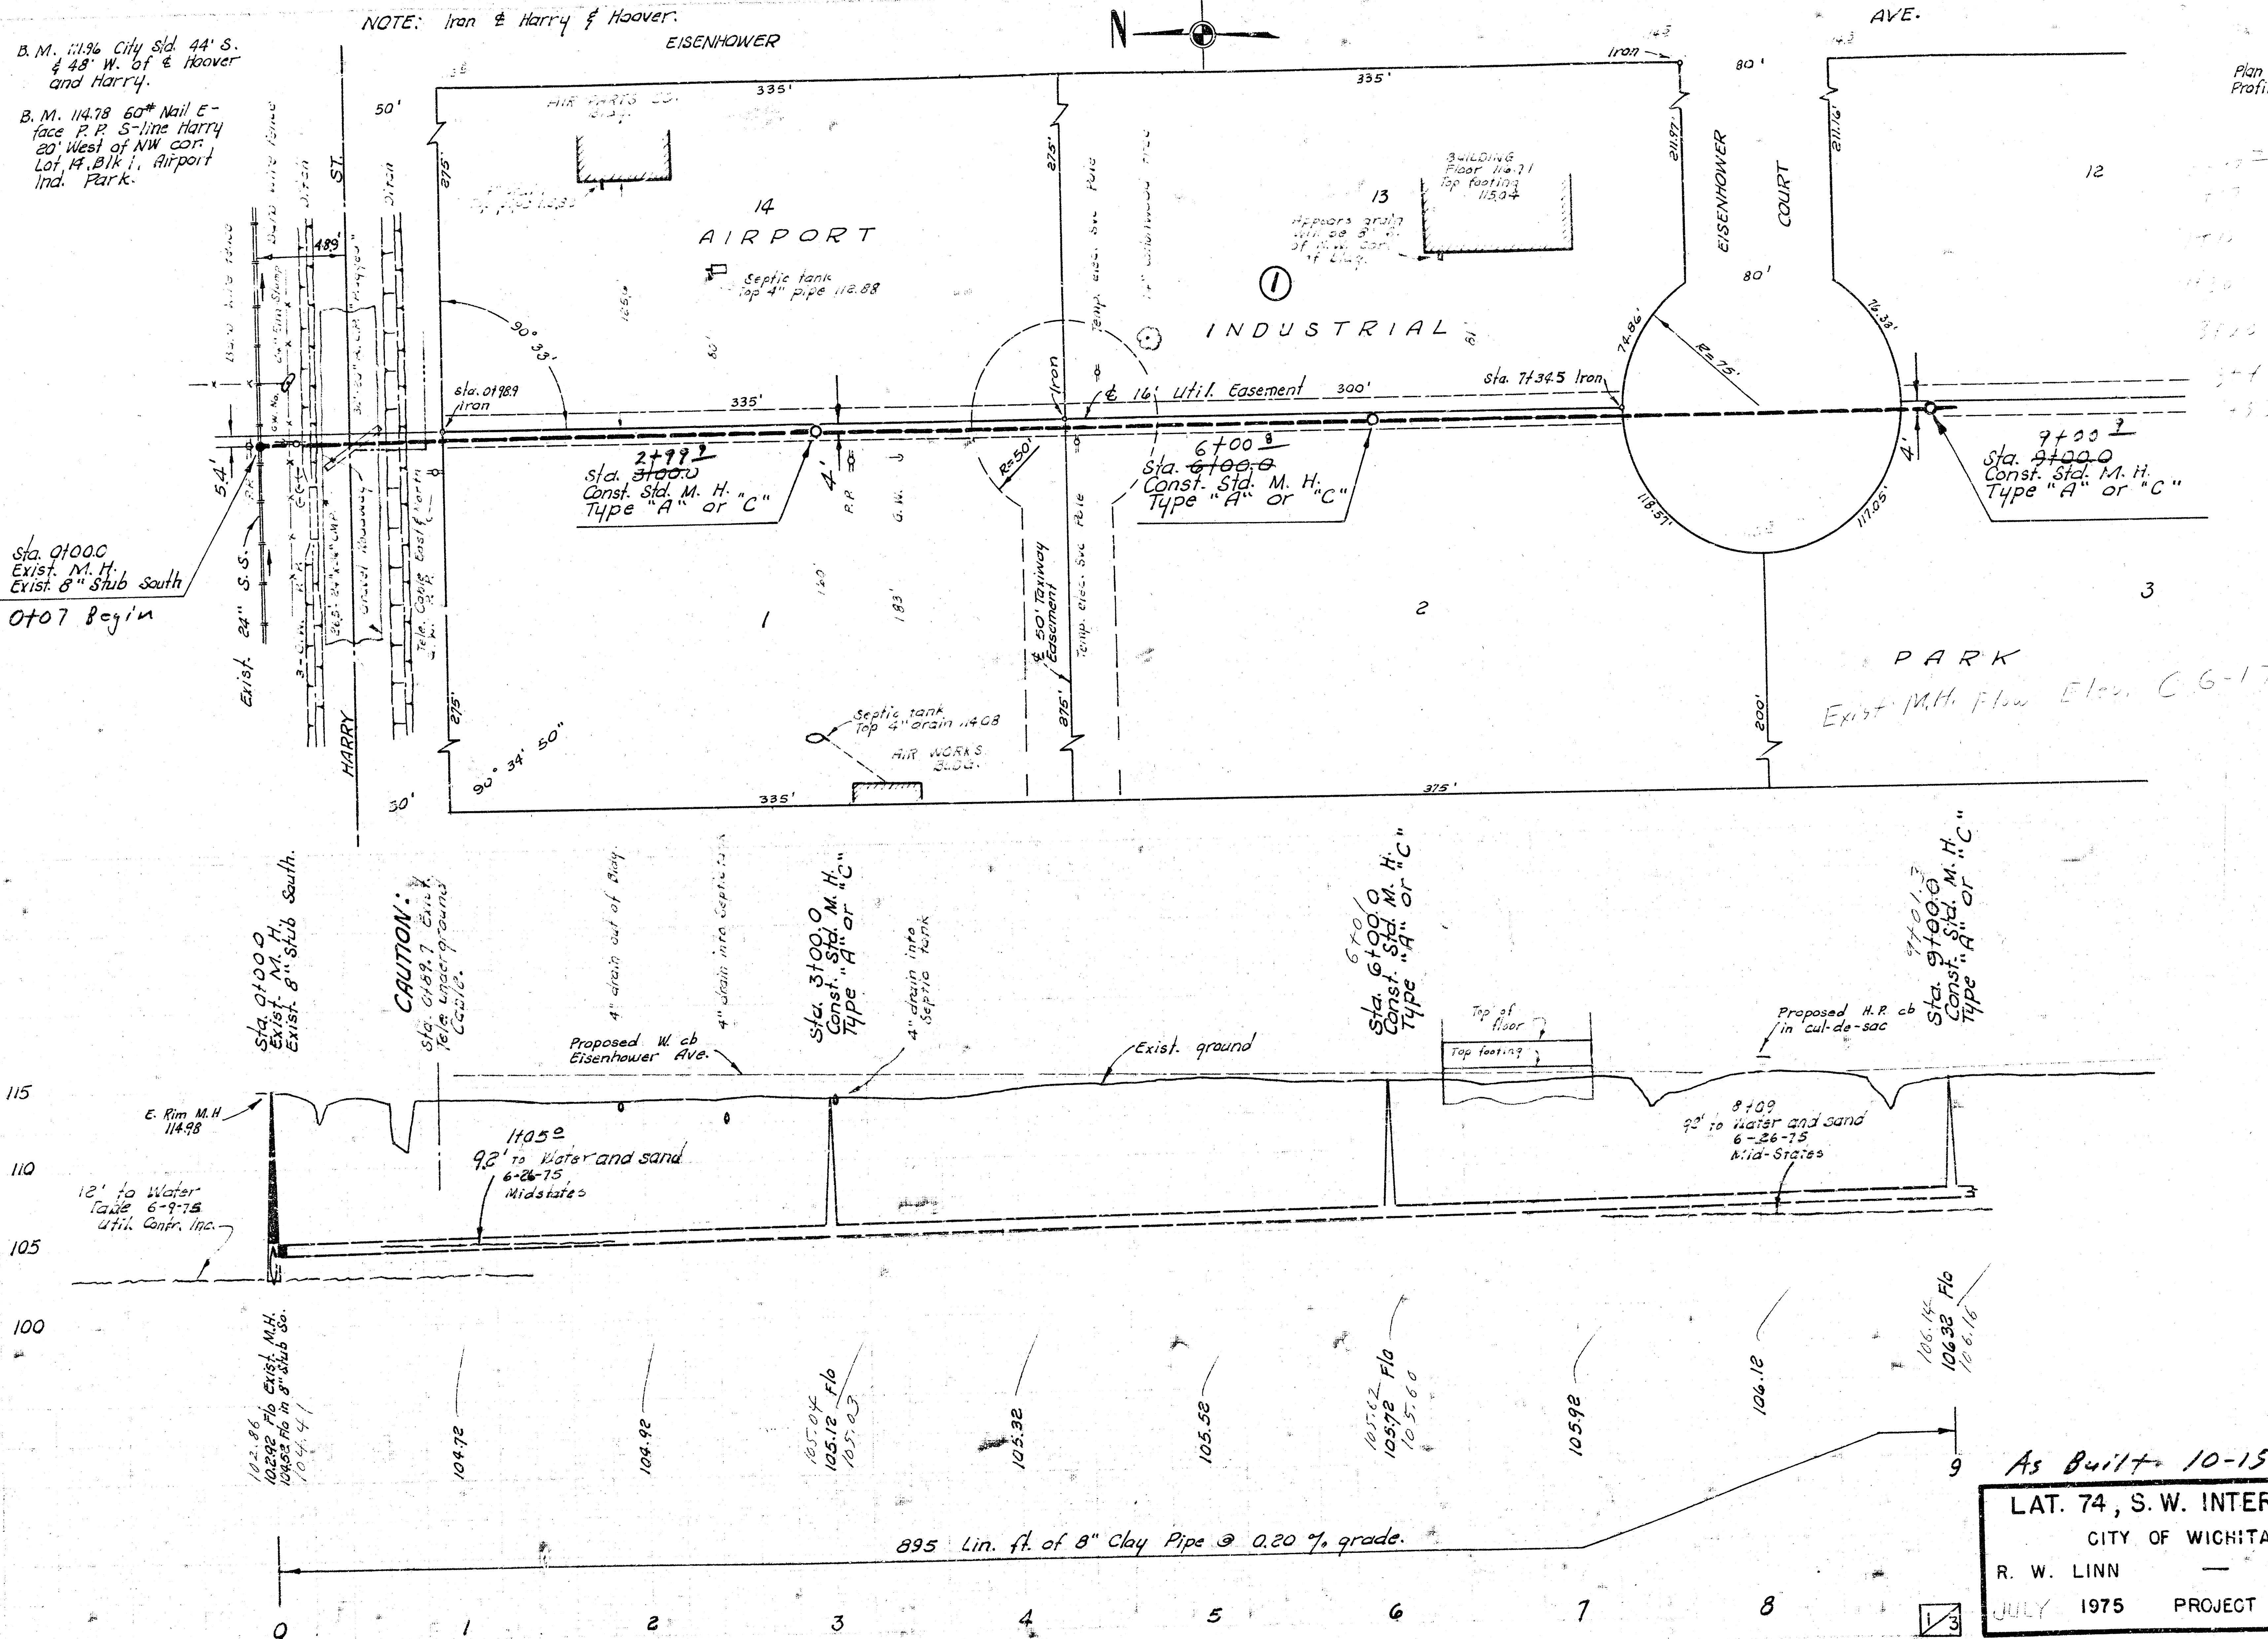
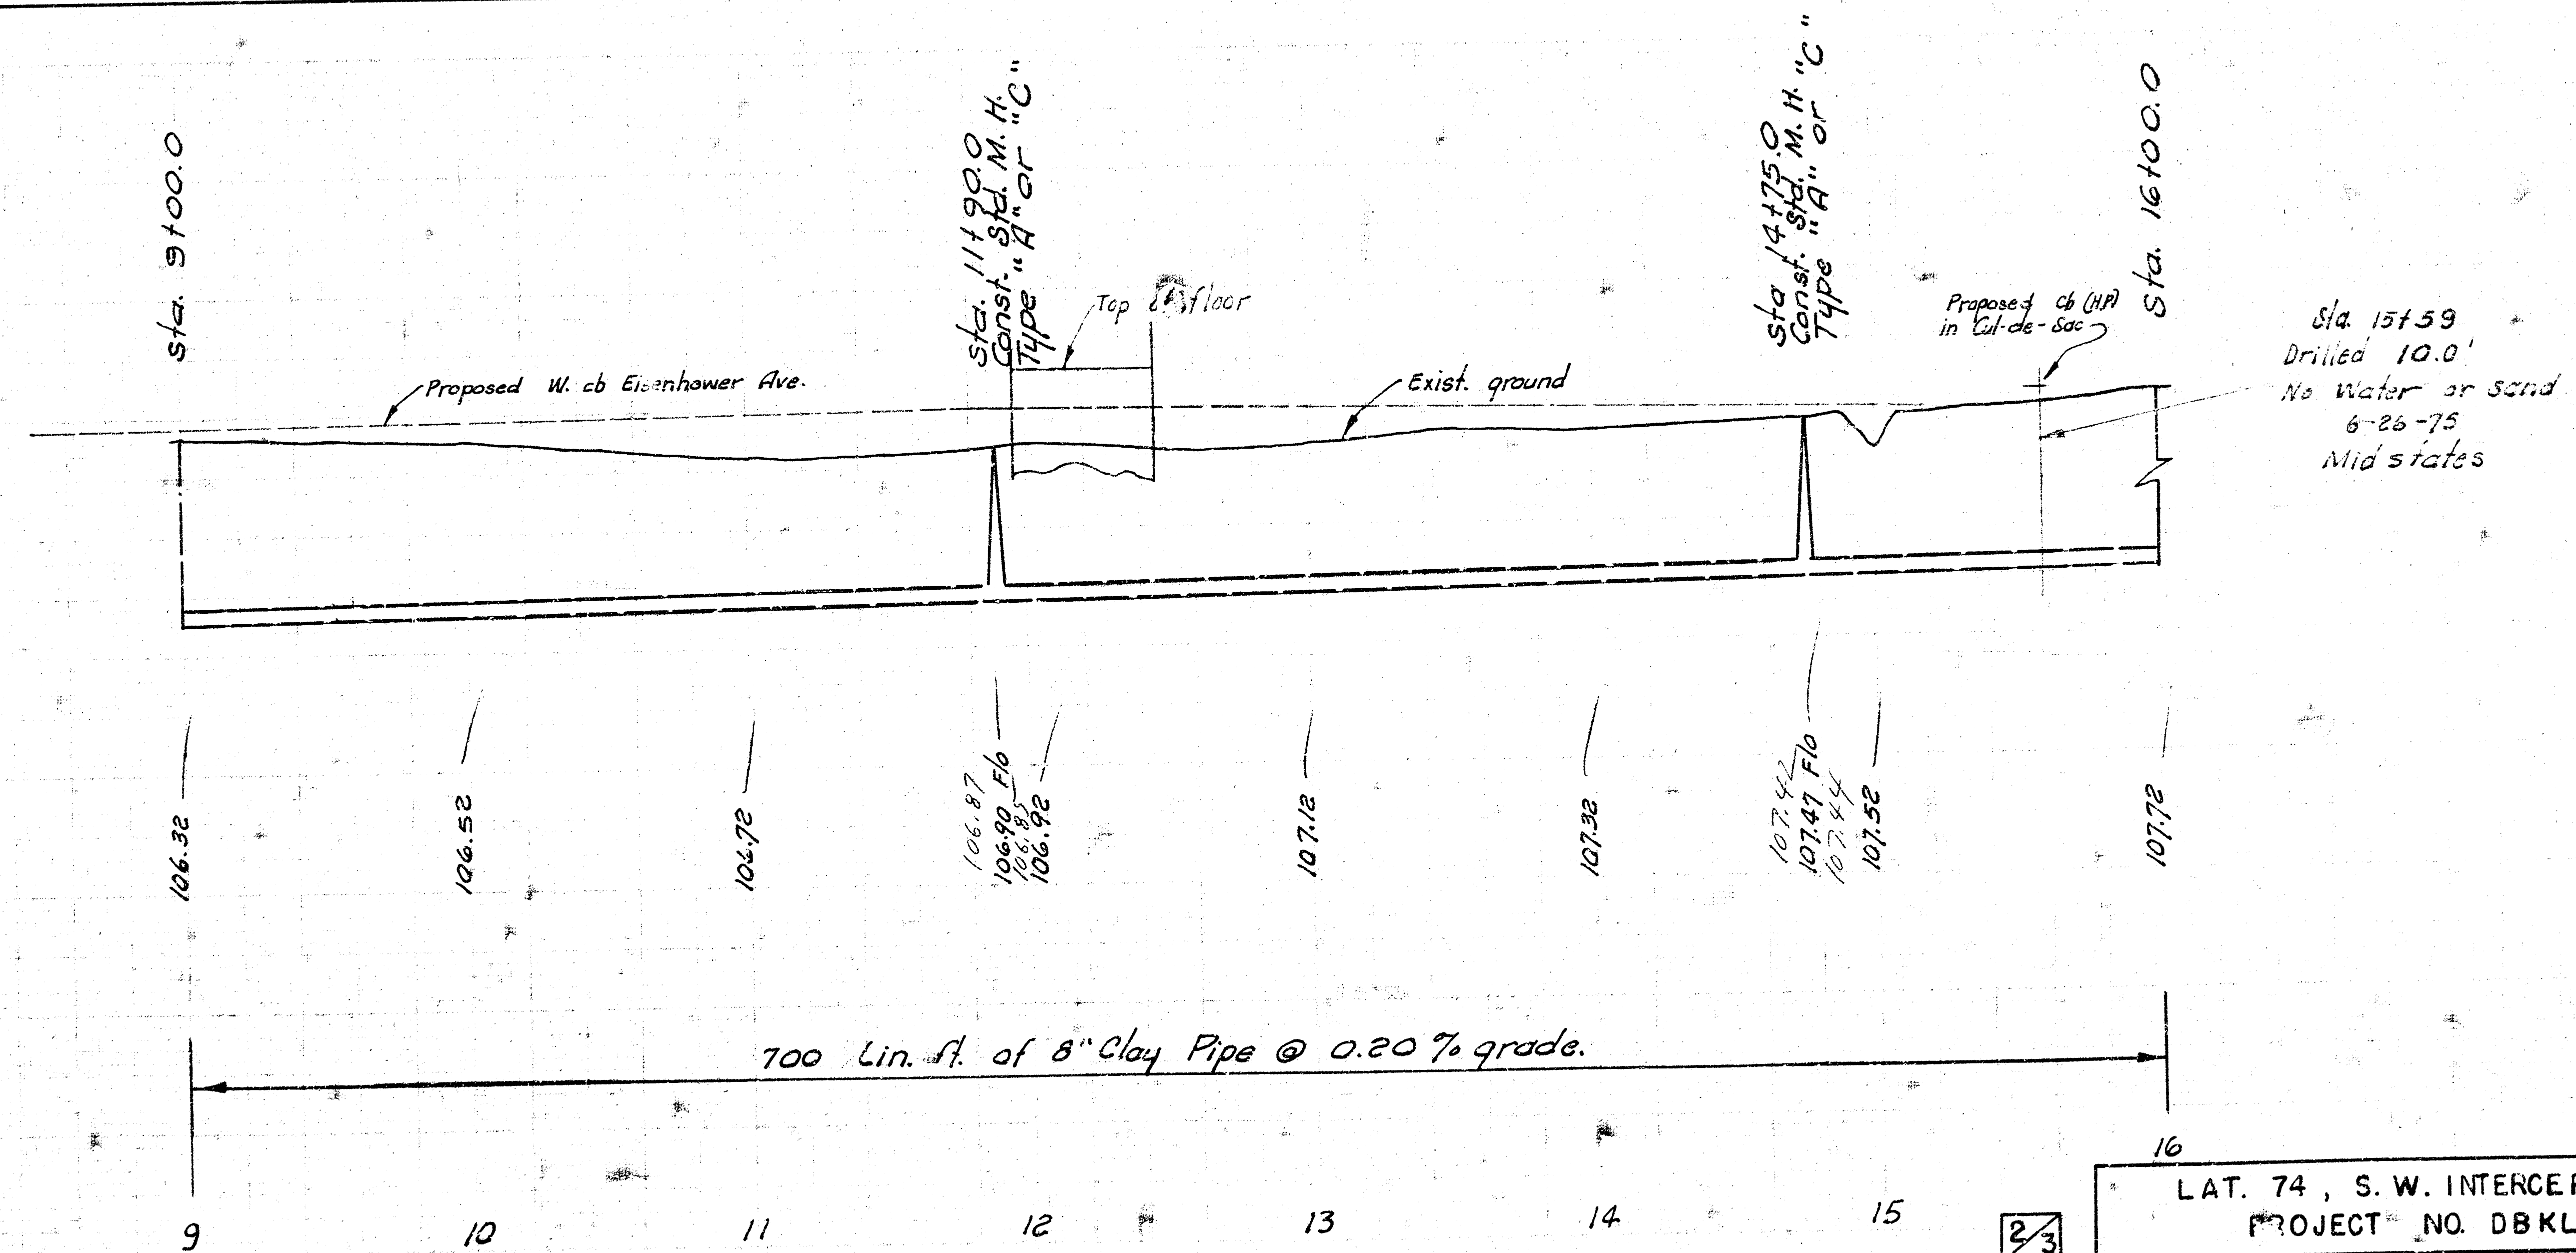


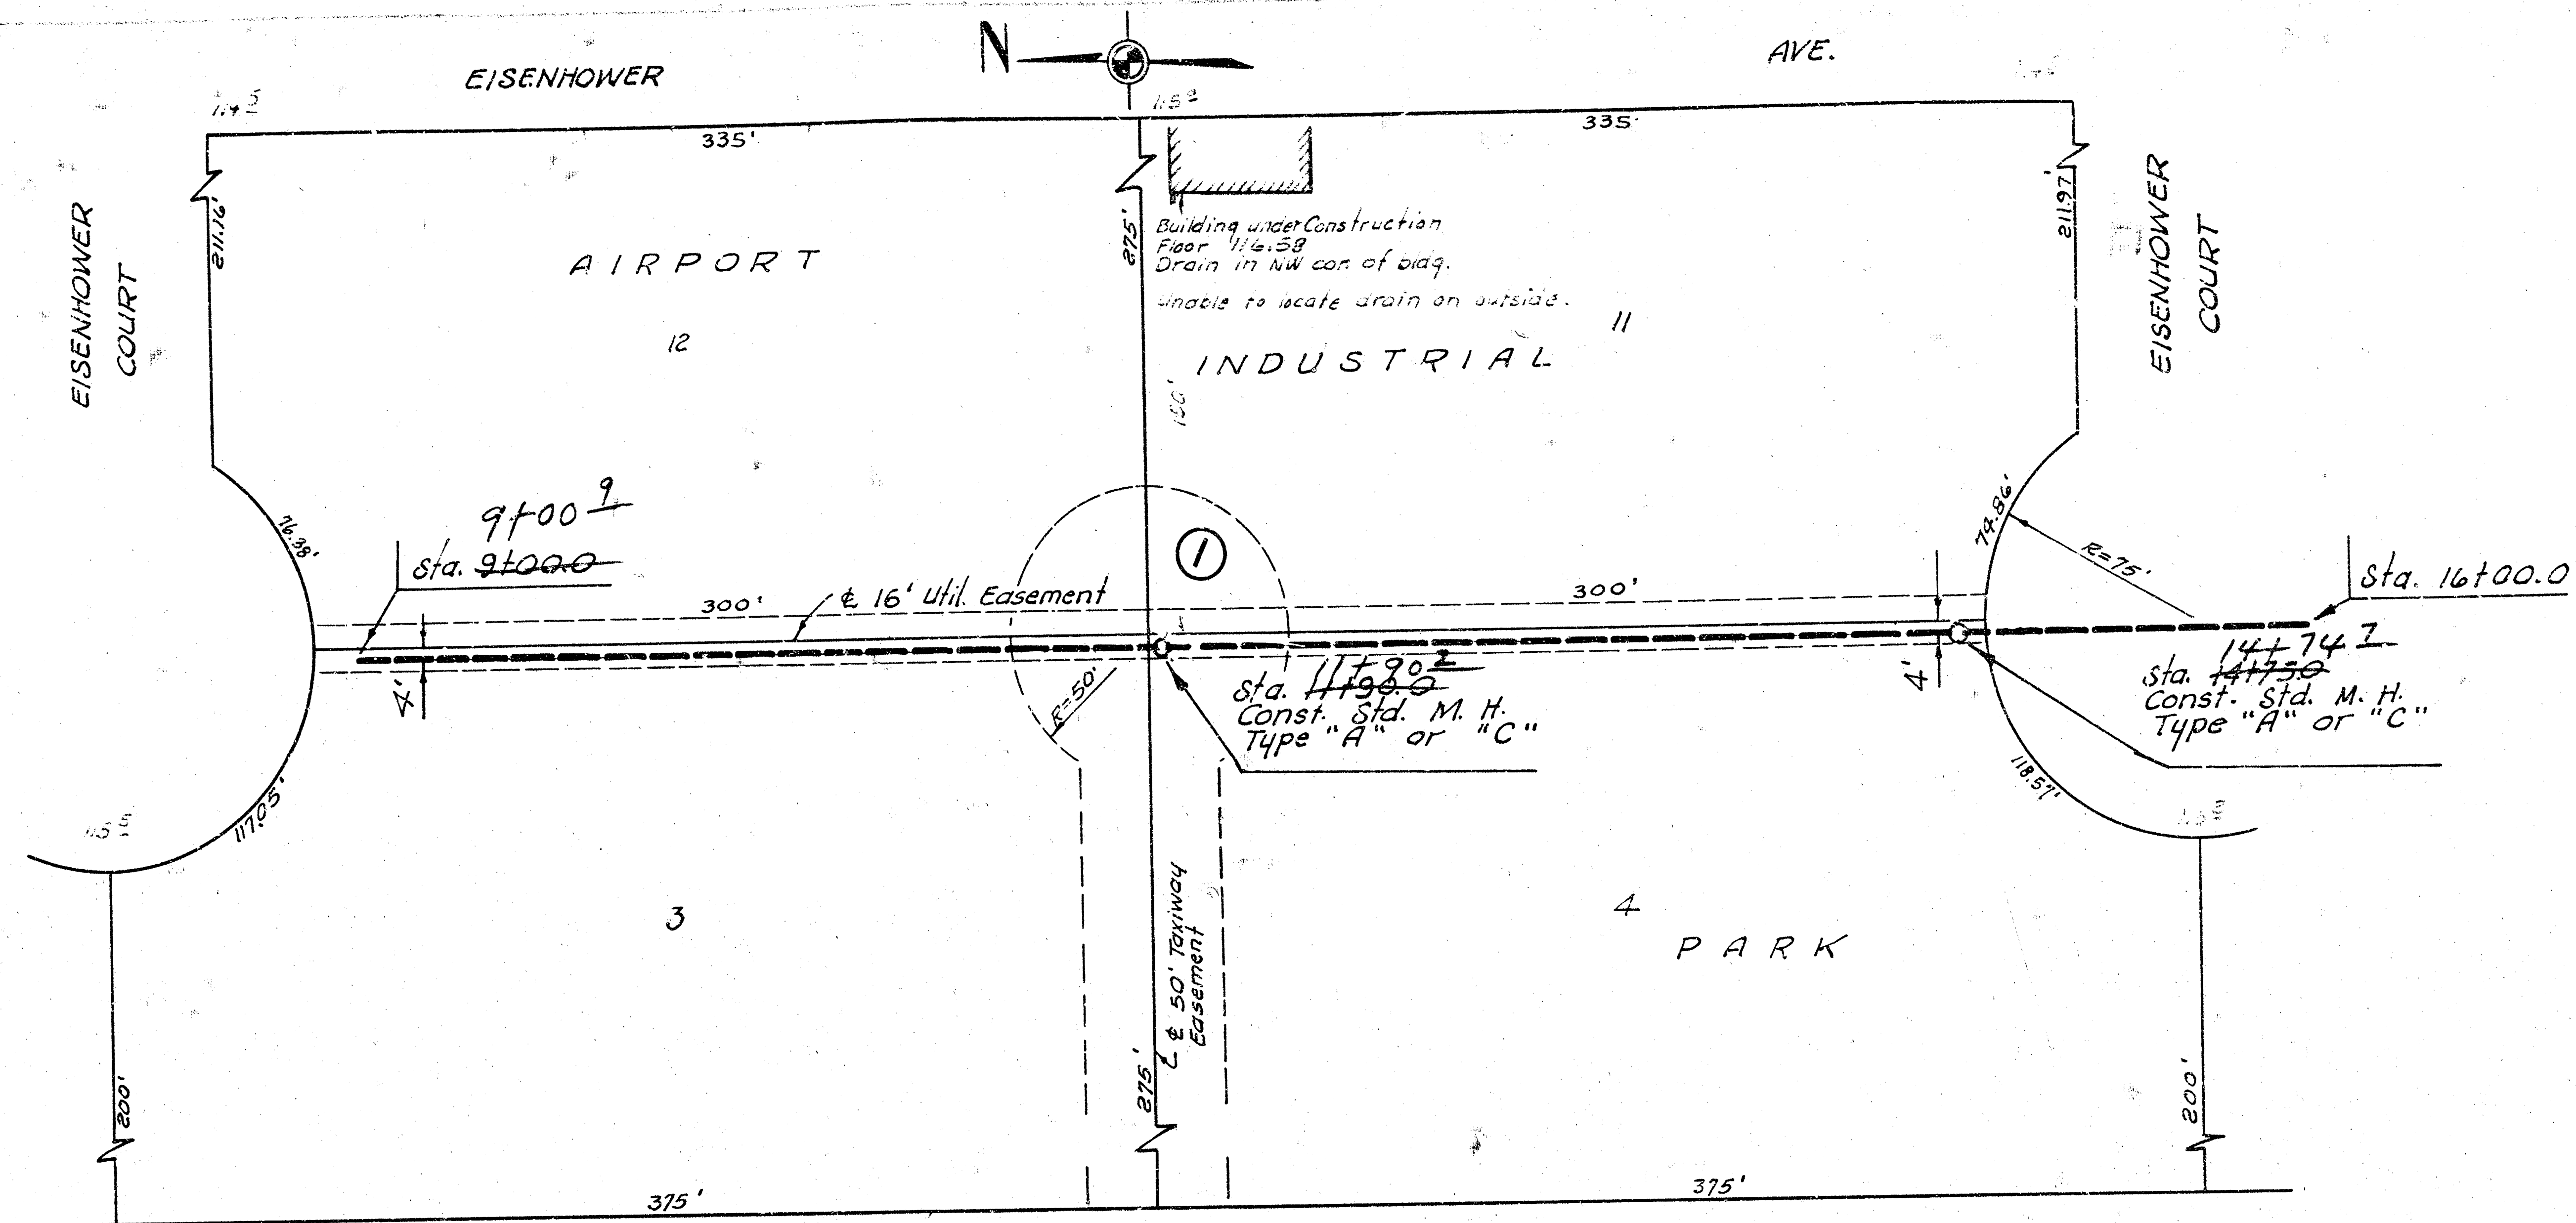

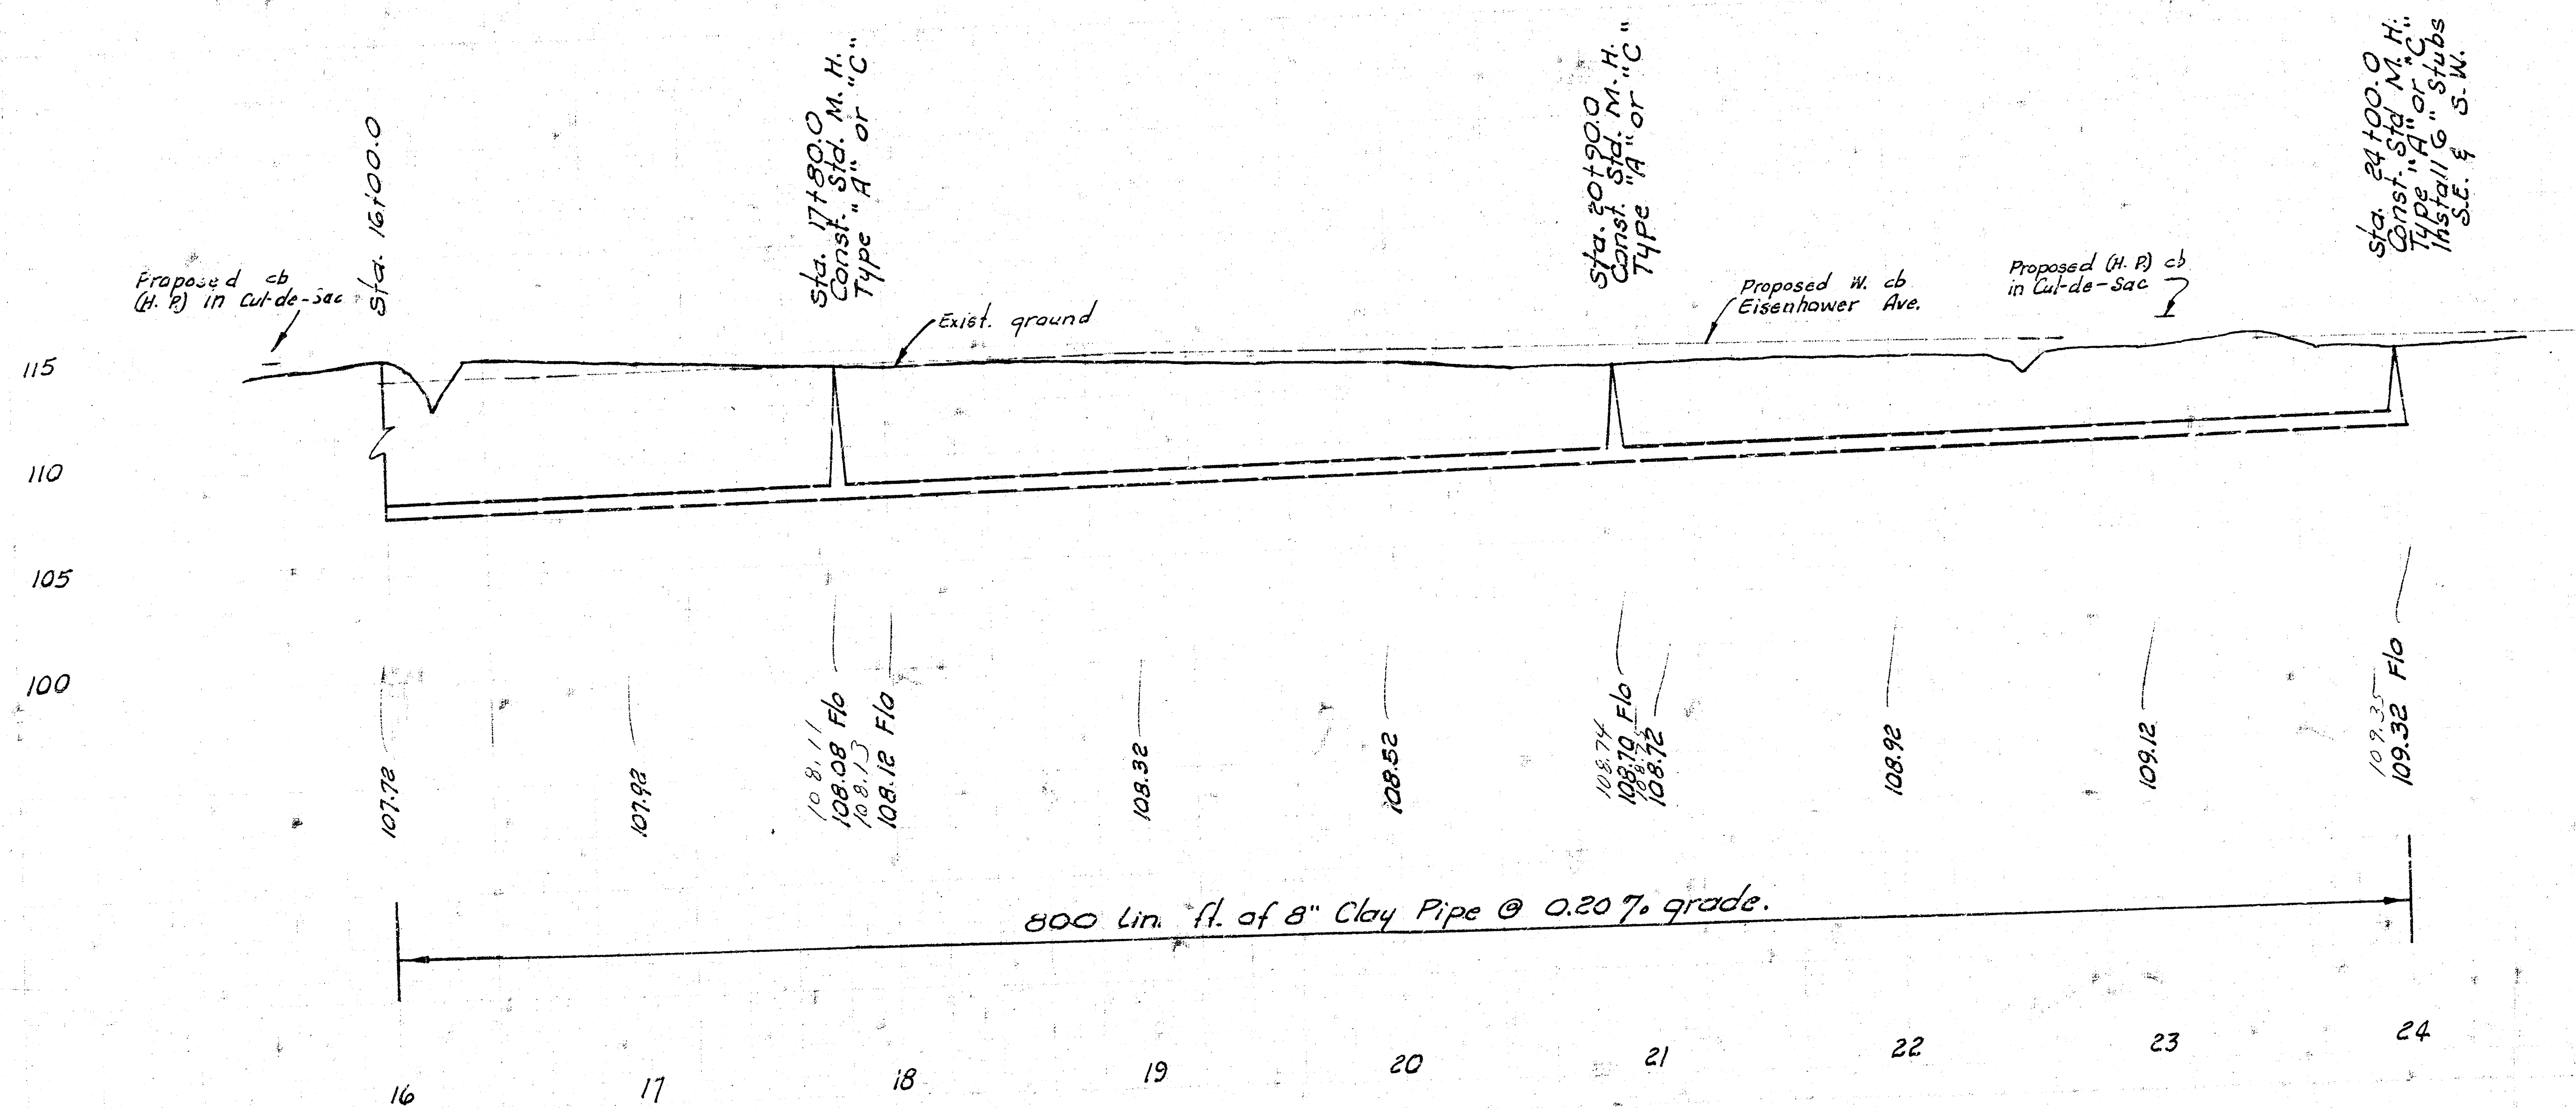

LAT. 74, S.W. INTERCEPTOR SEWER
PROJECT NO. DBKL575036

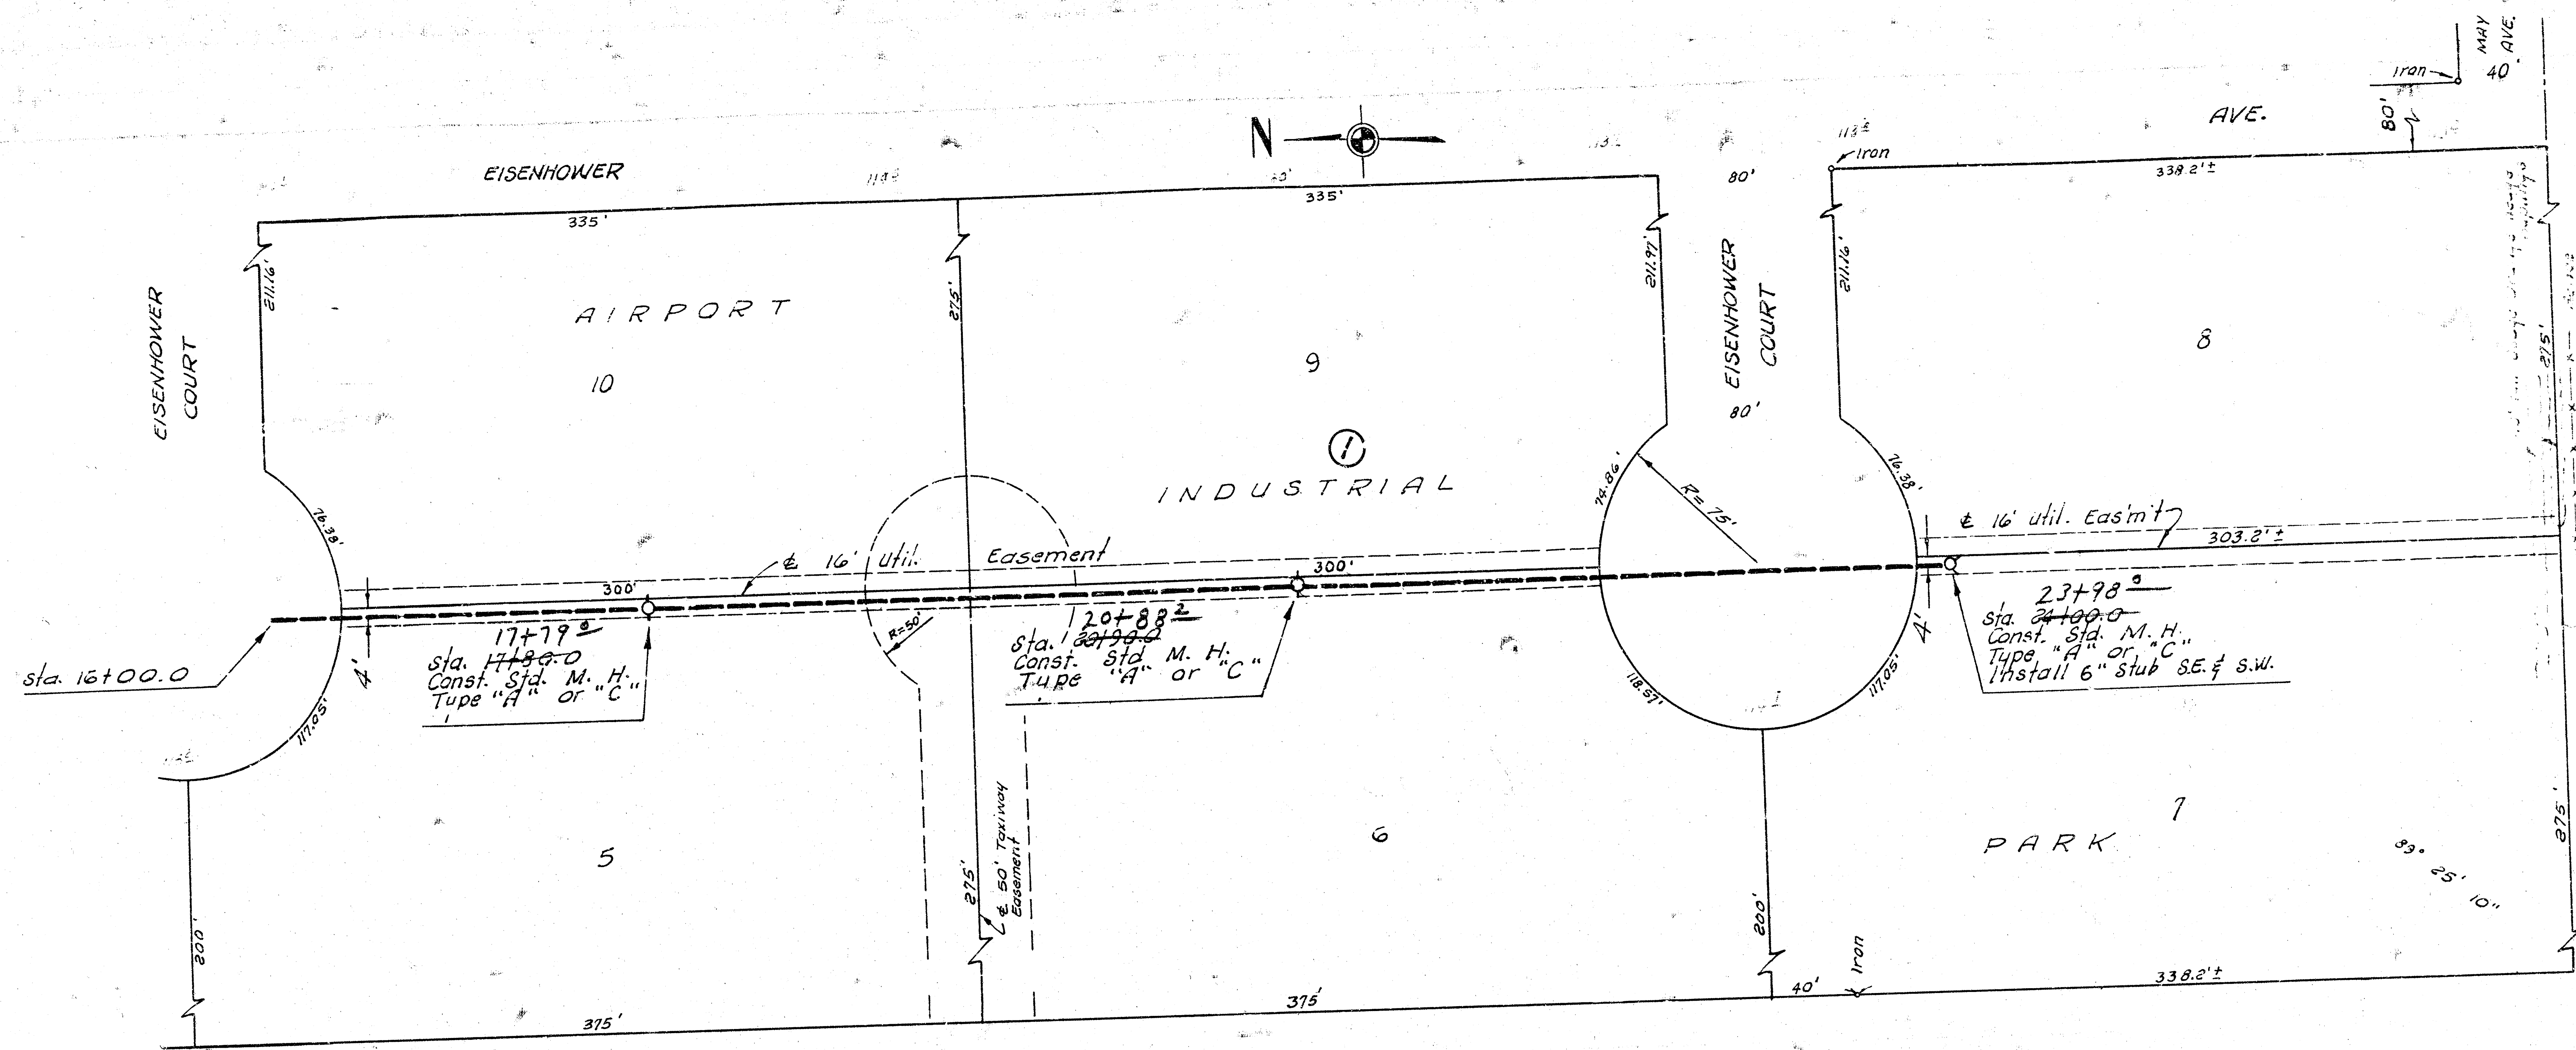

LAT. 74, S.W. INTERCEPTOR SEWER
PROJECT NO. DBKL575036