



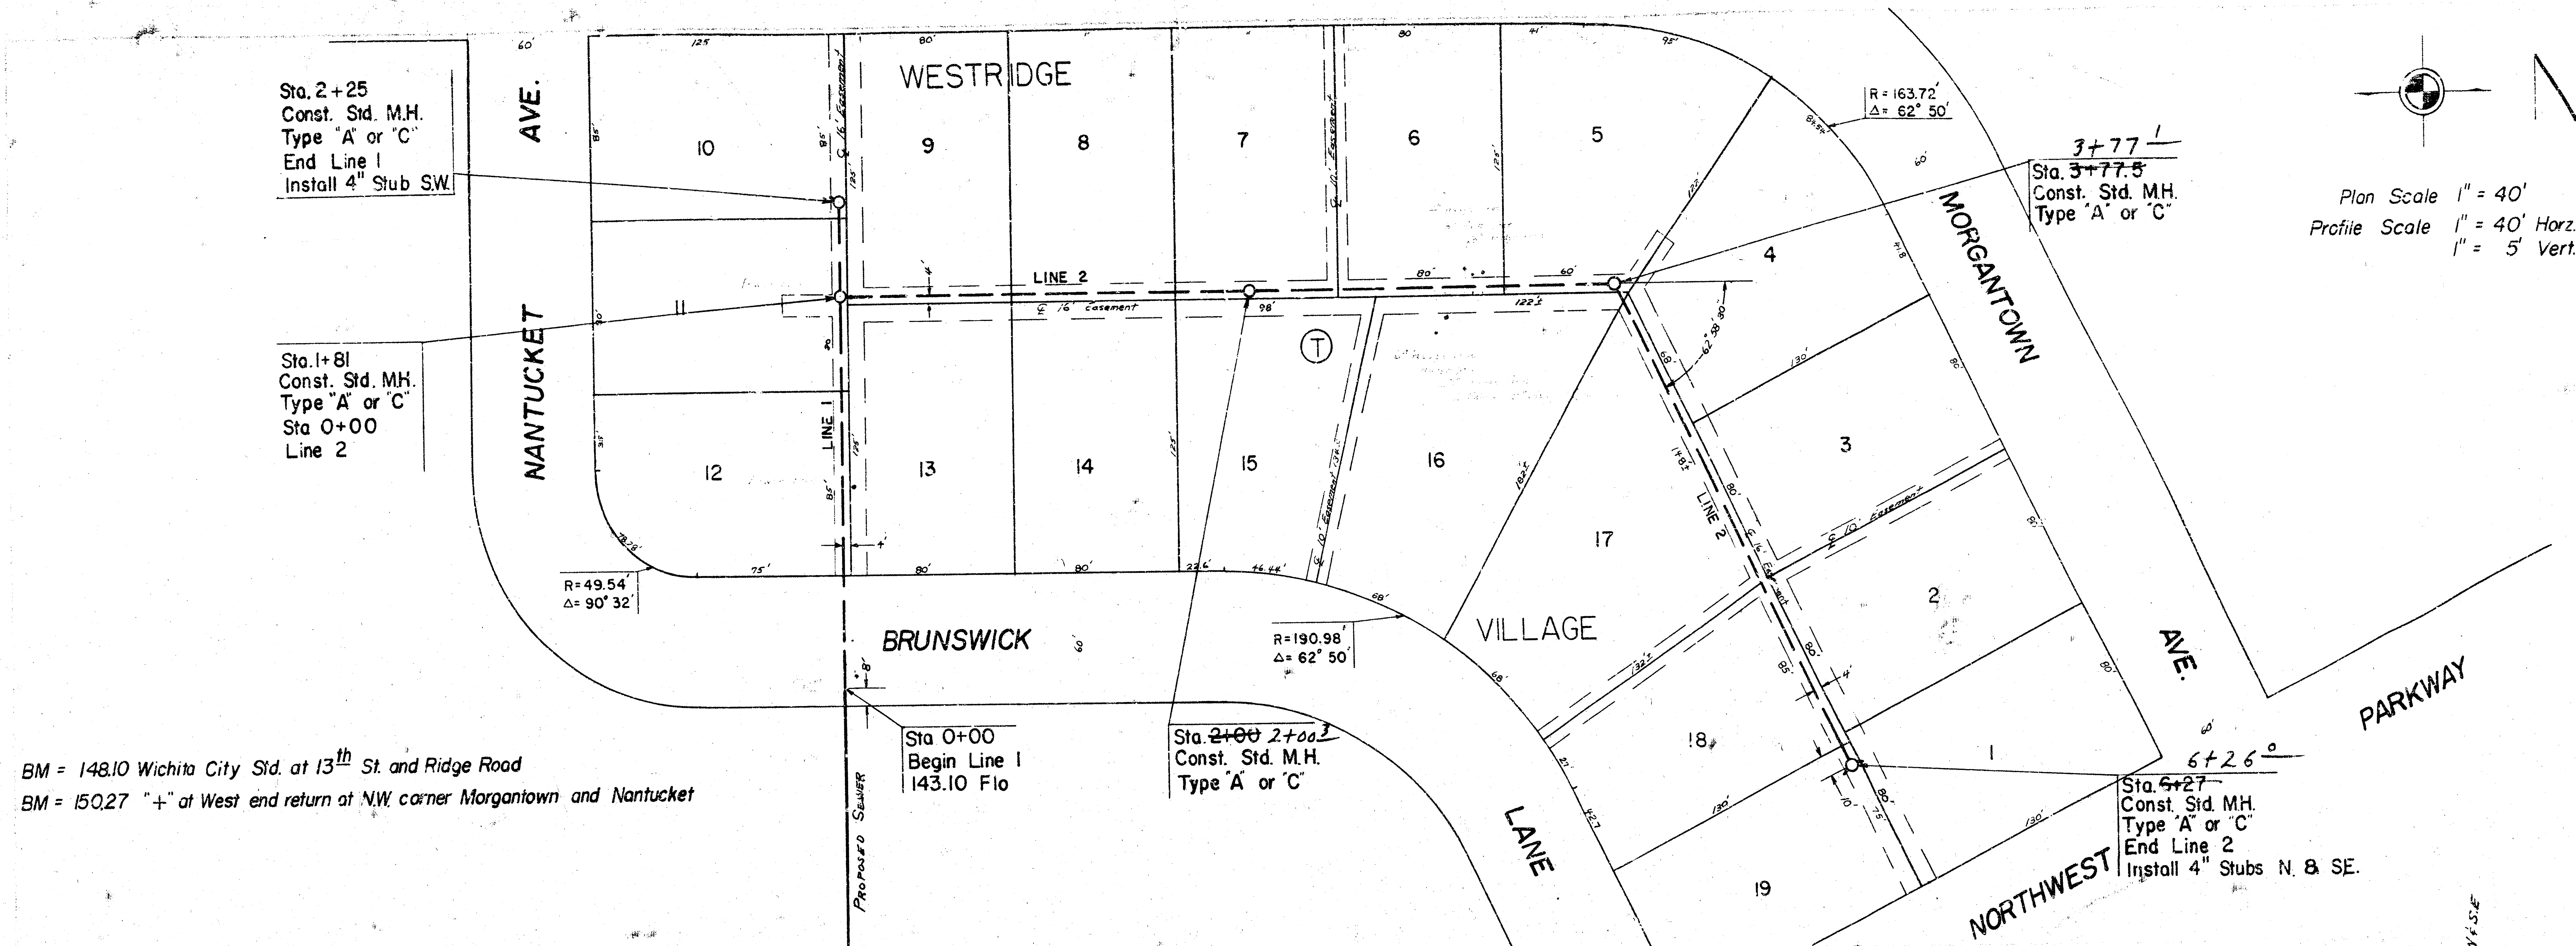

Plan Scale 1" = 40'
 Profile Scale 1" = 40' Horz.
 1" = 5' Vert.

BM = 148.10 Wichita City Sid. at 13th St. and Ridge Road
 BM = 150.27 "+" at West end return at NW corner Morgantown and Nantucket

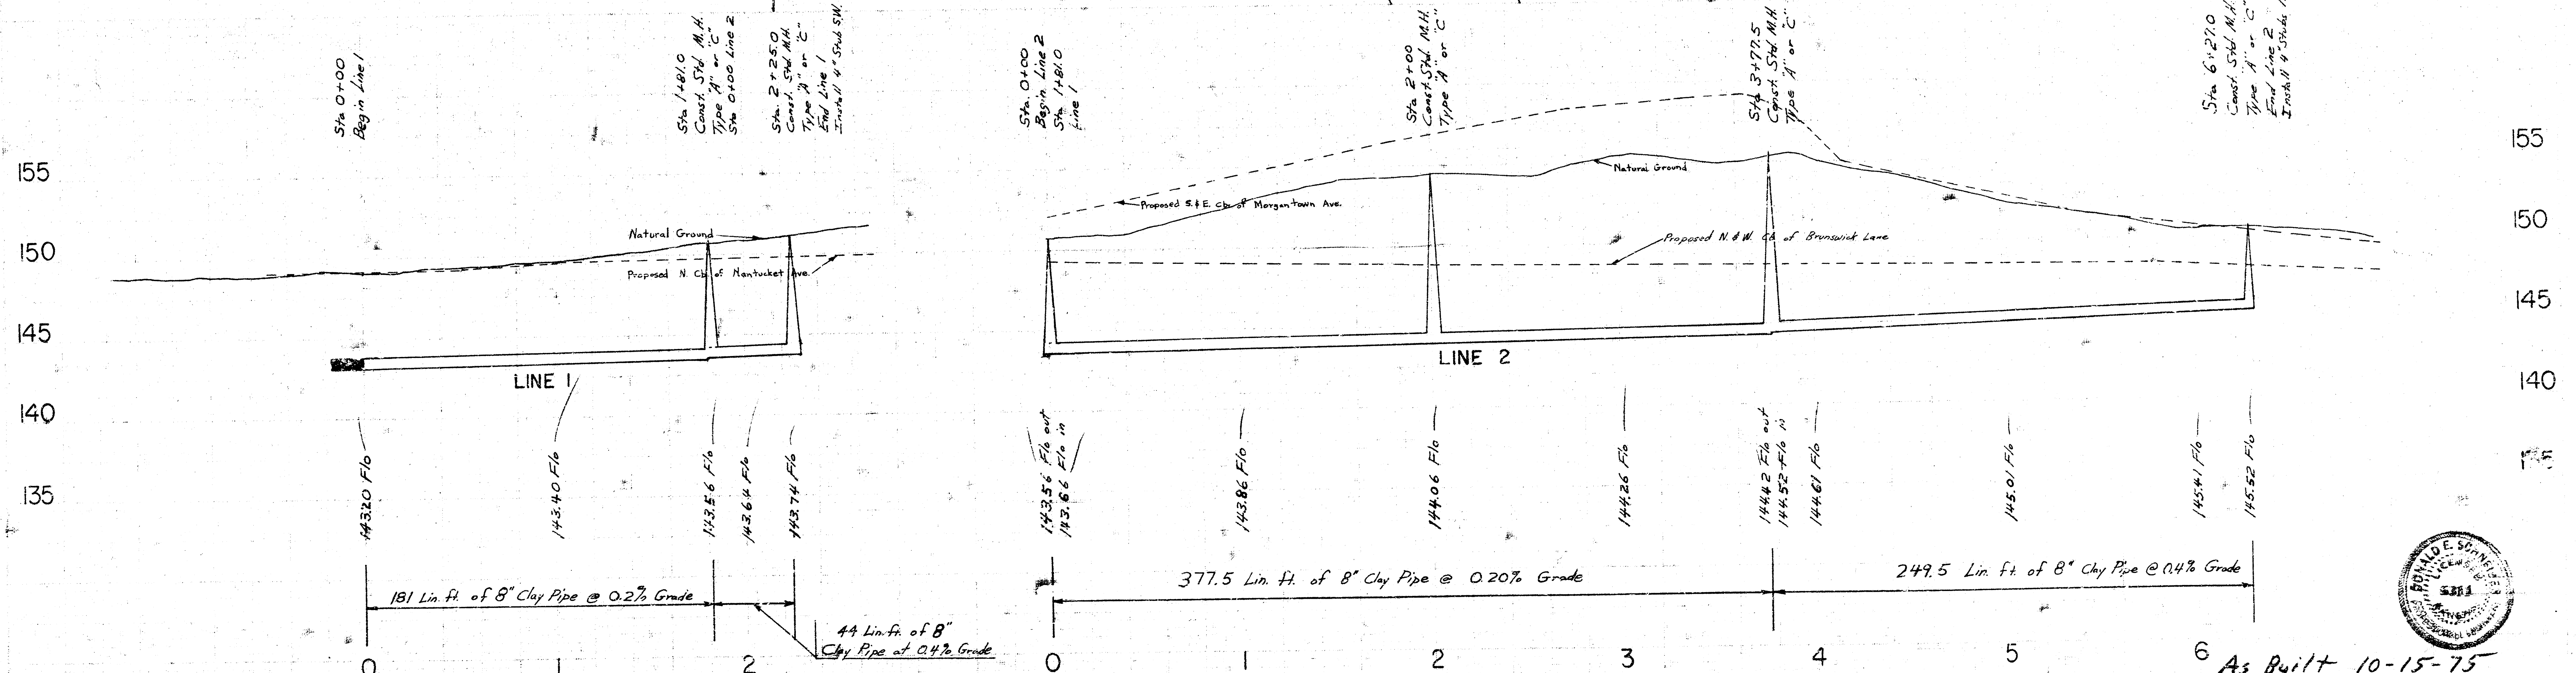

LAT. 75 SWI SEWER
 CITY OF WICHITA, KANSAS
 R. W. LINN CITY ENGINEER
 Project No. DBKL575041

