BM 119.57 R.R. Spike S.E. Side Power Pole on N.S. Pawnee 17' West of W.L. Yellowstone Dr.

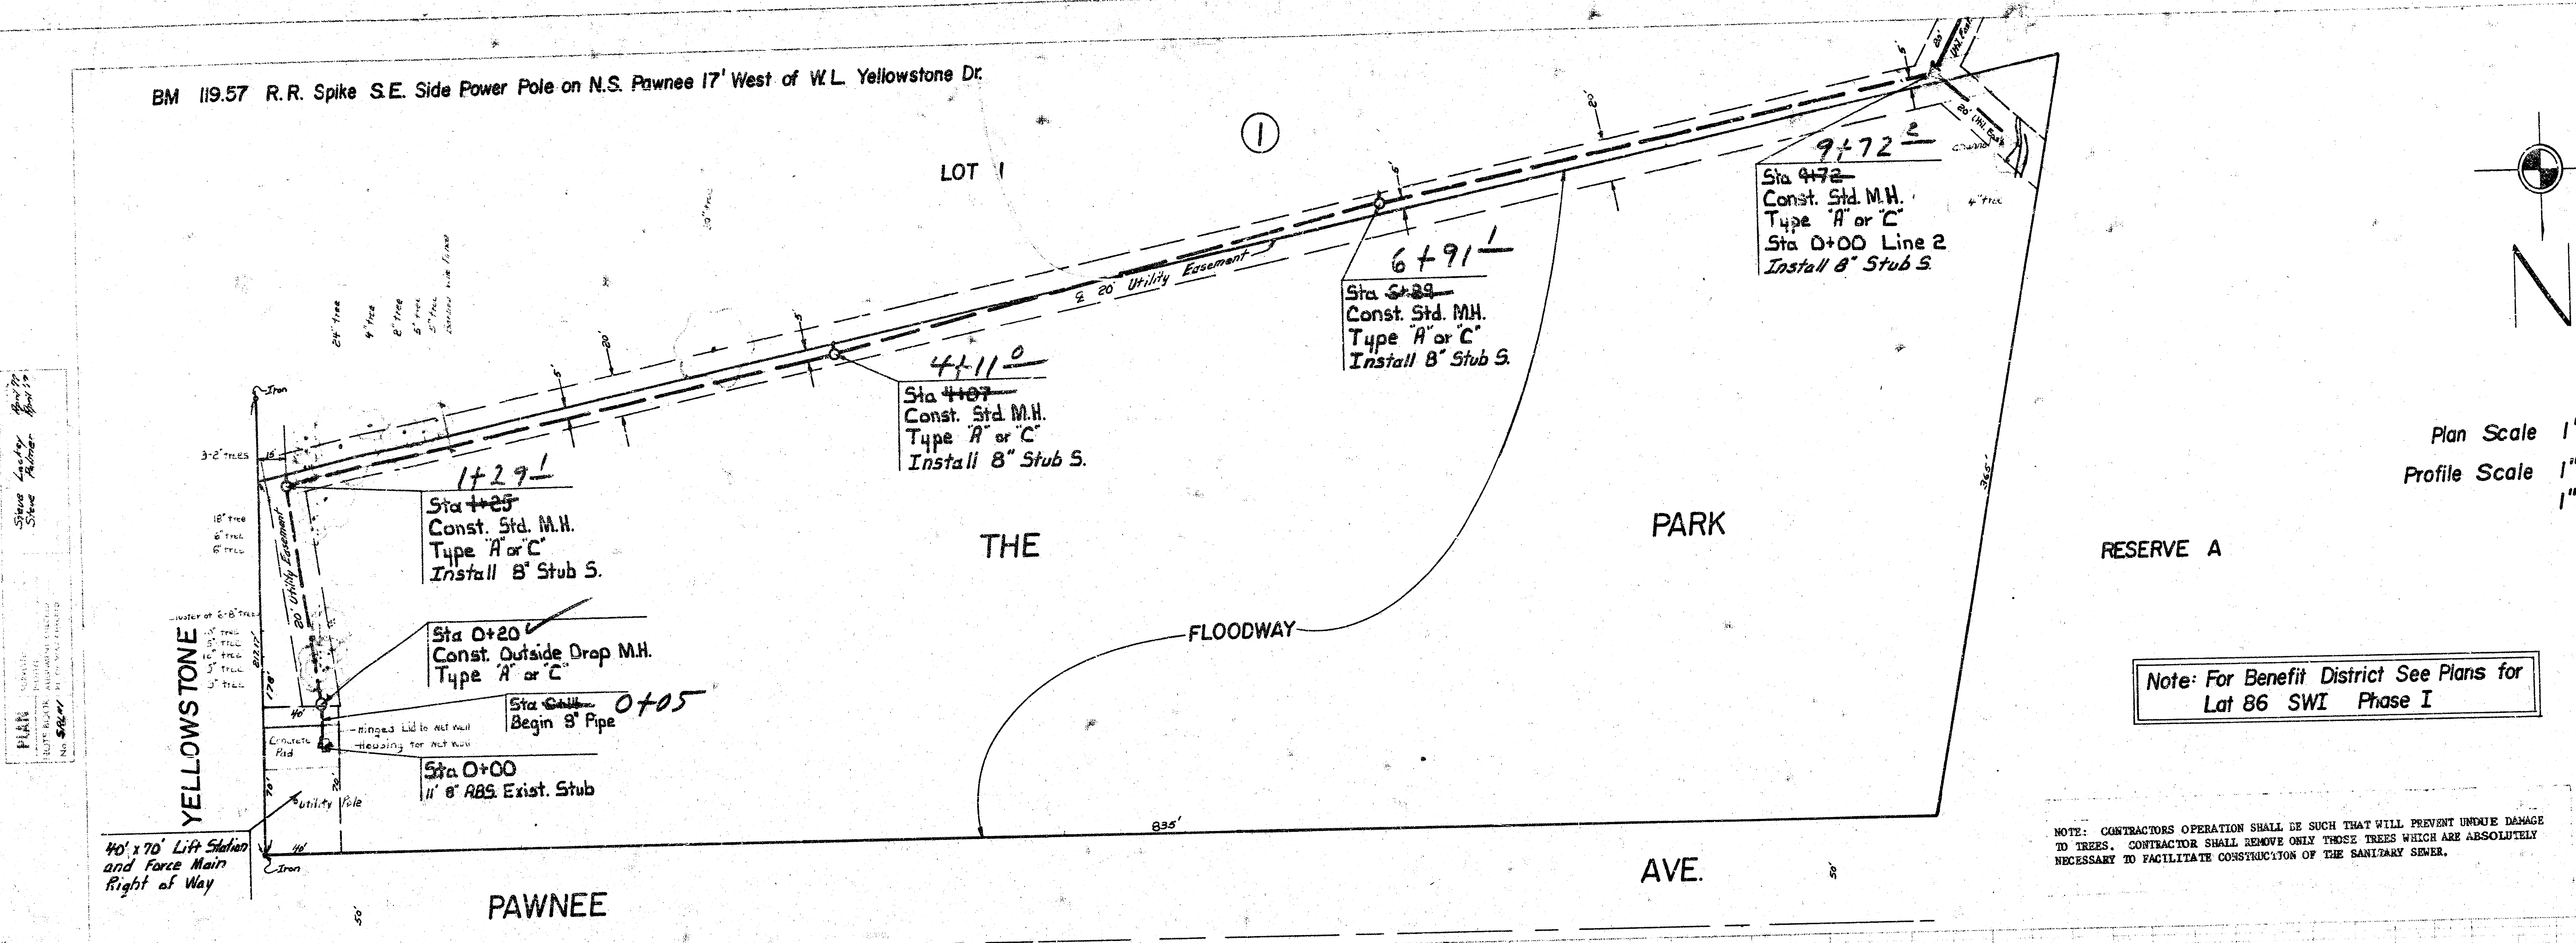

Plan Scale 1" = 40'
Profile Scale 1" = 40' Horz.
1" = 5' Vert.

Note: For Benefit District See Plans for Lat 86 SWI Phase I

NOTE: CONTRACTORS OPERATION SHALL BE SUCH THAT WILL PREVENT UNDUE DAMAGE TO TREES. CONTRACTOR SHALL REMOVE ONLY THOSE TREES WHICH ARE ABSOLUTELY NECESSARY TO FACILITATE CONSTRUCTION OF THE SANITARY SEWER.

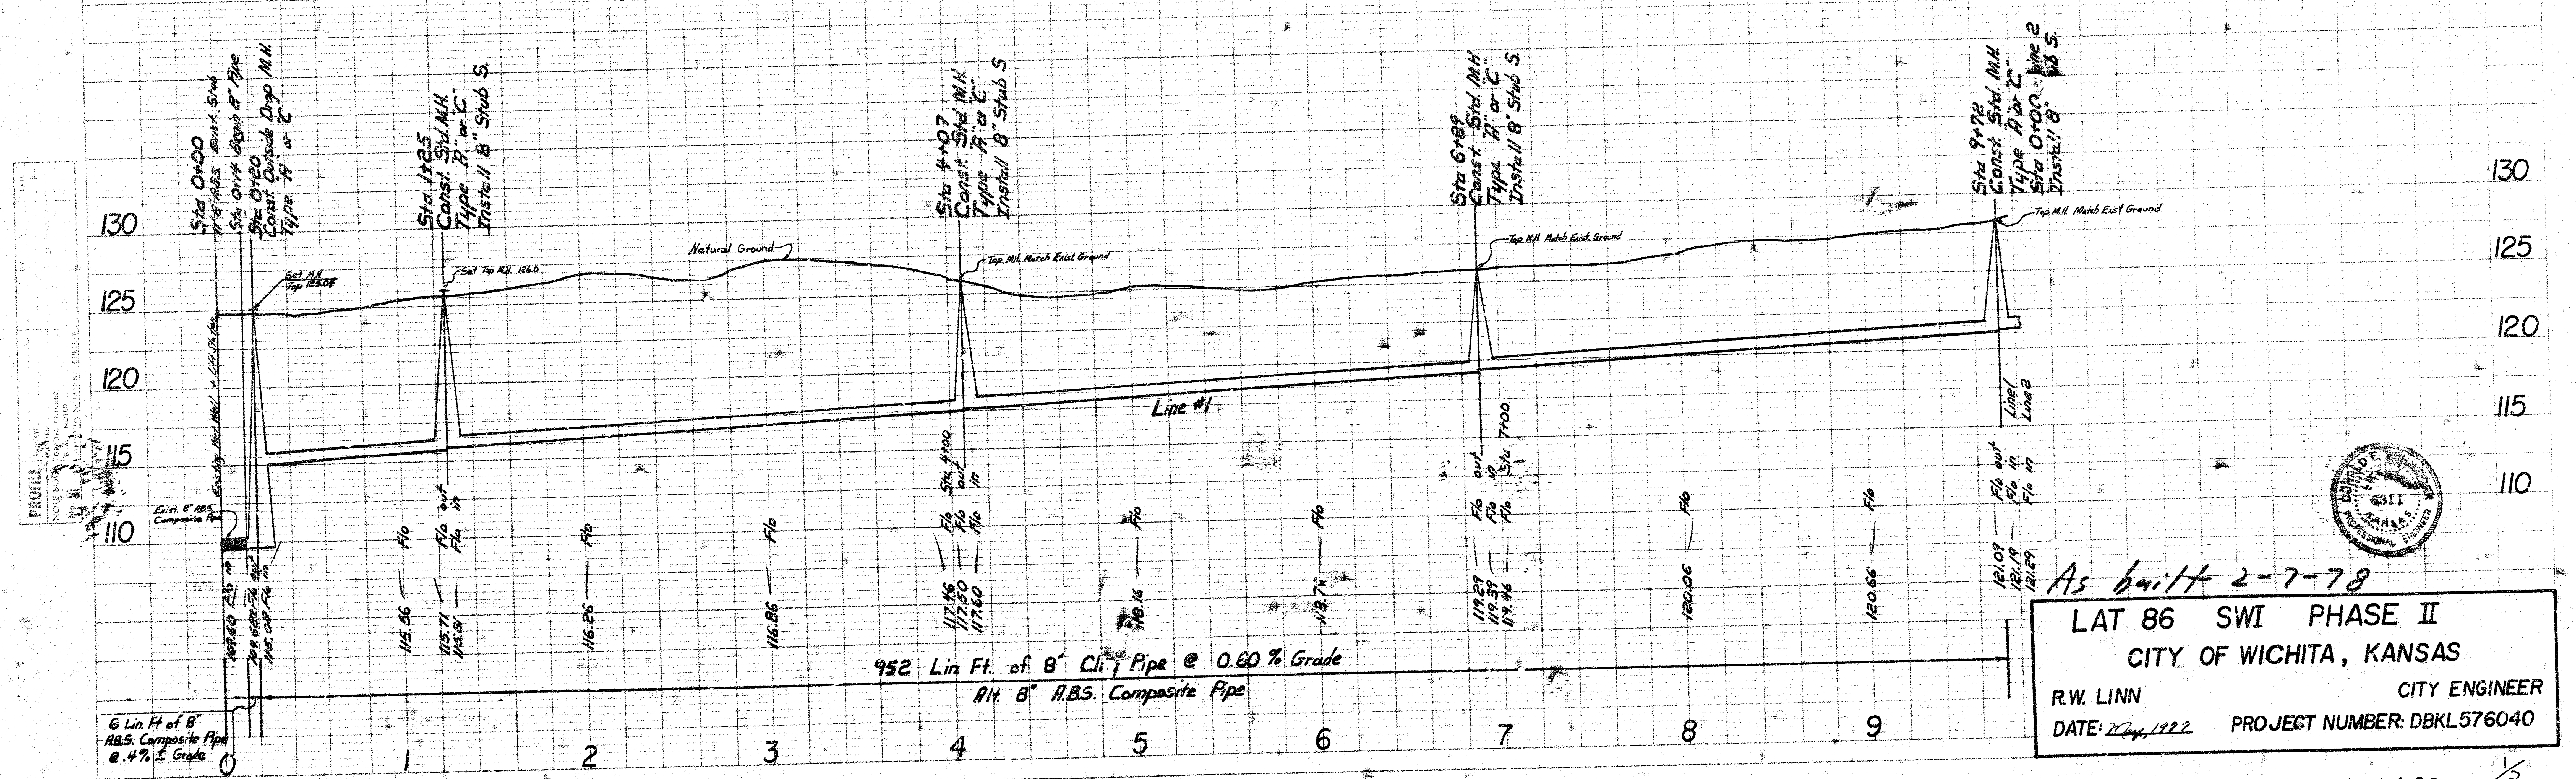
130
125
120
115
110
Sta 0+00 11' 8" ABS. Exist. Stub
Sta 0+14 Begin 8" Pipe
Sta 0+20 Const. Outside Drop M.H. Type "A" or "C"
Sta 1+25 Const. Std. M.H. Type "A" or "C" Install 8" Stub S.
Sta 4+07 Const. Std. M.H. Type "A" or "C" Install 8" Stub S
Sta 6+89 Const. Std. M.H. Type "A" or "C" Install 8" Stub S.
Sta 9+72 Const. Std. M.H. Type "A" or "C" Sta 0+00 Line 2 Install 8" Stub S.
Set M.H. Top 125.04
Set Top M.H. 126.0
Top M.H. Match Exist Ground
Natural Ground
Line #1
Line 1
Line 2
Exist. 8" ABS. Composite Pipe
Existing Wet Well
Sta 4+00
Sta 7+00
Flo
Flo out
Flo in
115.36
115.71
115.81
116.26
116.86
117.46
117.50
117.60
118.16
118.7
119.29
119.39
119.46
120.06
120.66
121.09
121.19
121.29
952 Lin Ft. of 8" Cl. Pipe @ 0.60 % Grade
Alt. 8" A.B.S. Composite Pipe
6 Lin. Ft of 8" A.B.S. Composite Pipe @ .4% ± Grade
0
1
2
3
4
5
6
7
8
9

As built 2-7-78

LAT 86 SWI PHASE II
CITY OF WICHITA, KANSAS
R.W. LINN CITY ENGINEER
DATE: May, 1977 PROJECT NUMBER: DBKL576040

6311

Sheet 1 of 2

1/2

PLATE 1-SINGLE PLAN AND PROFILE-FULL LINE

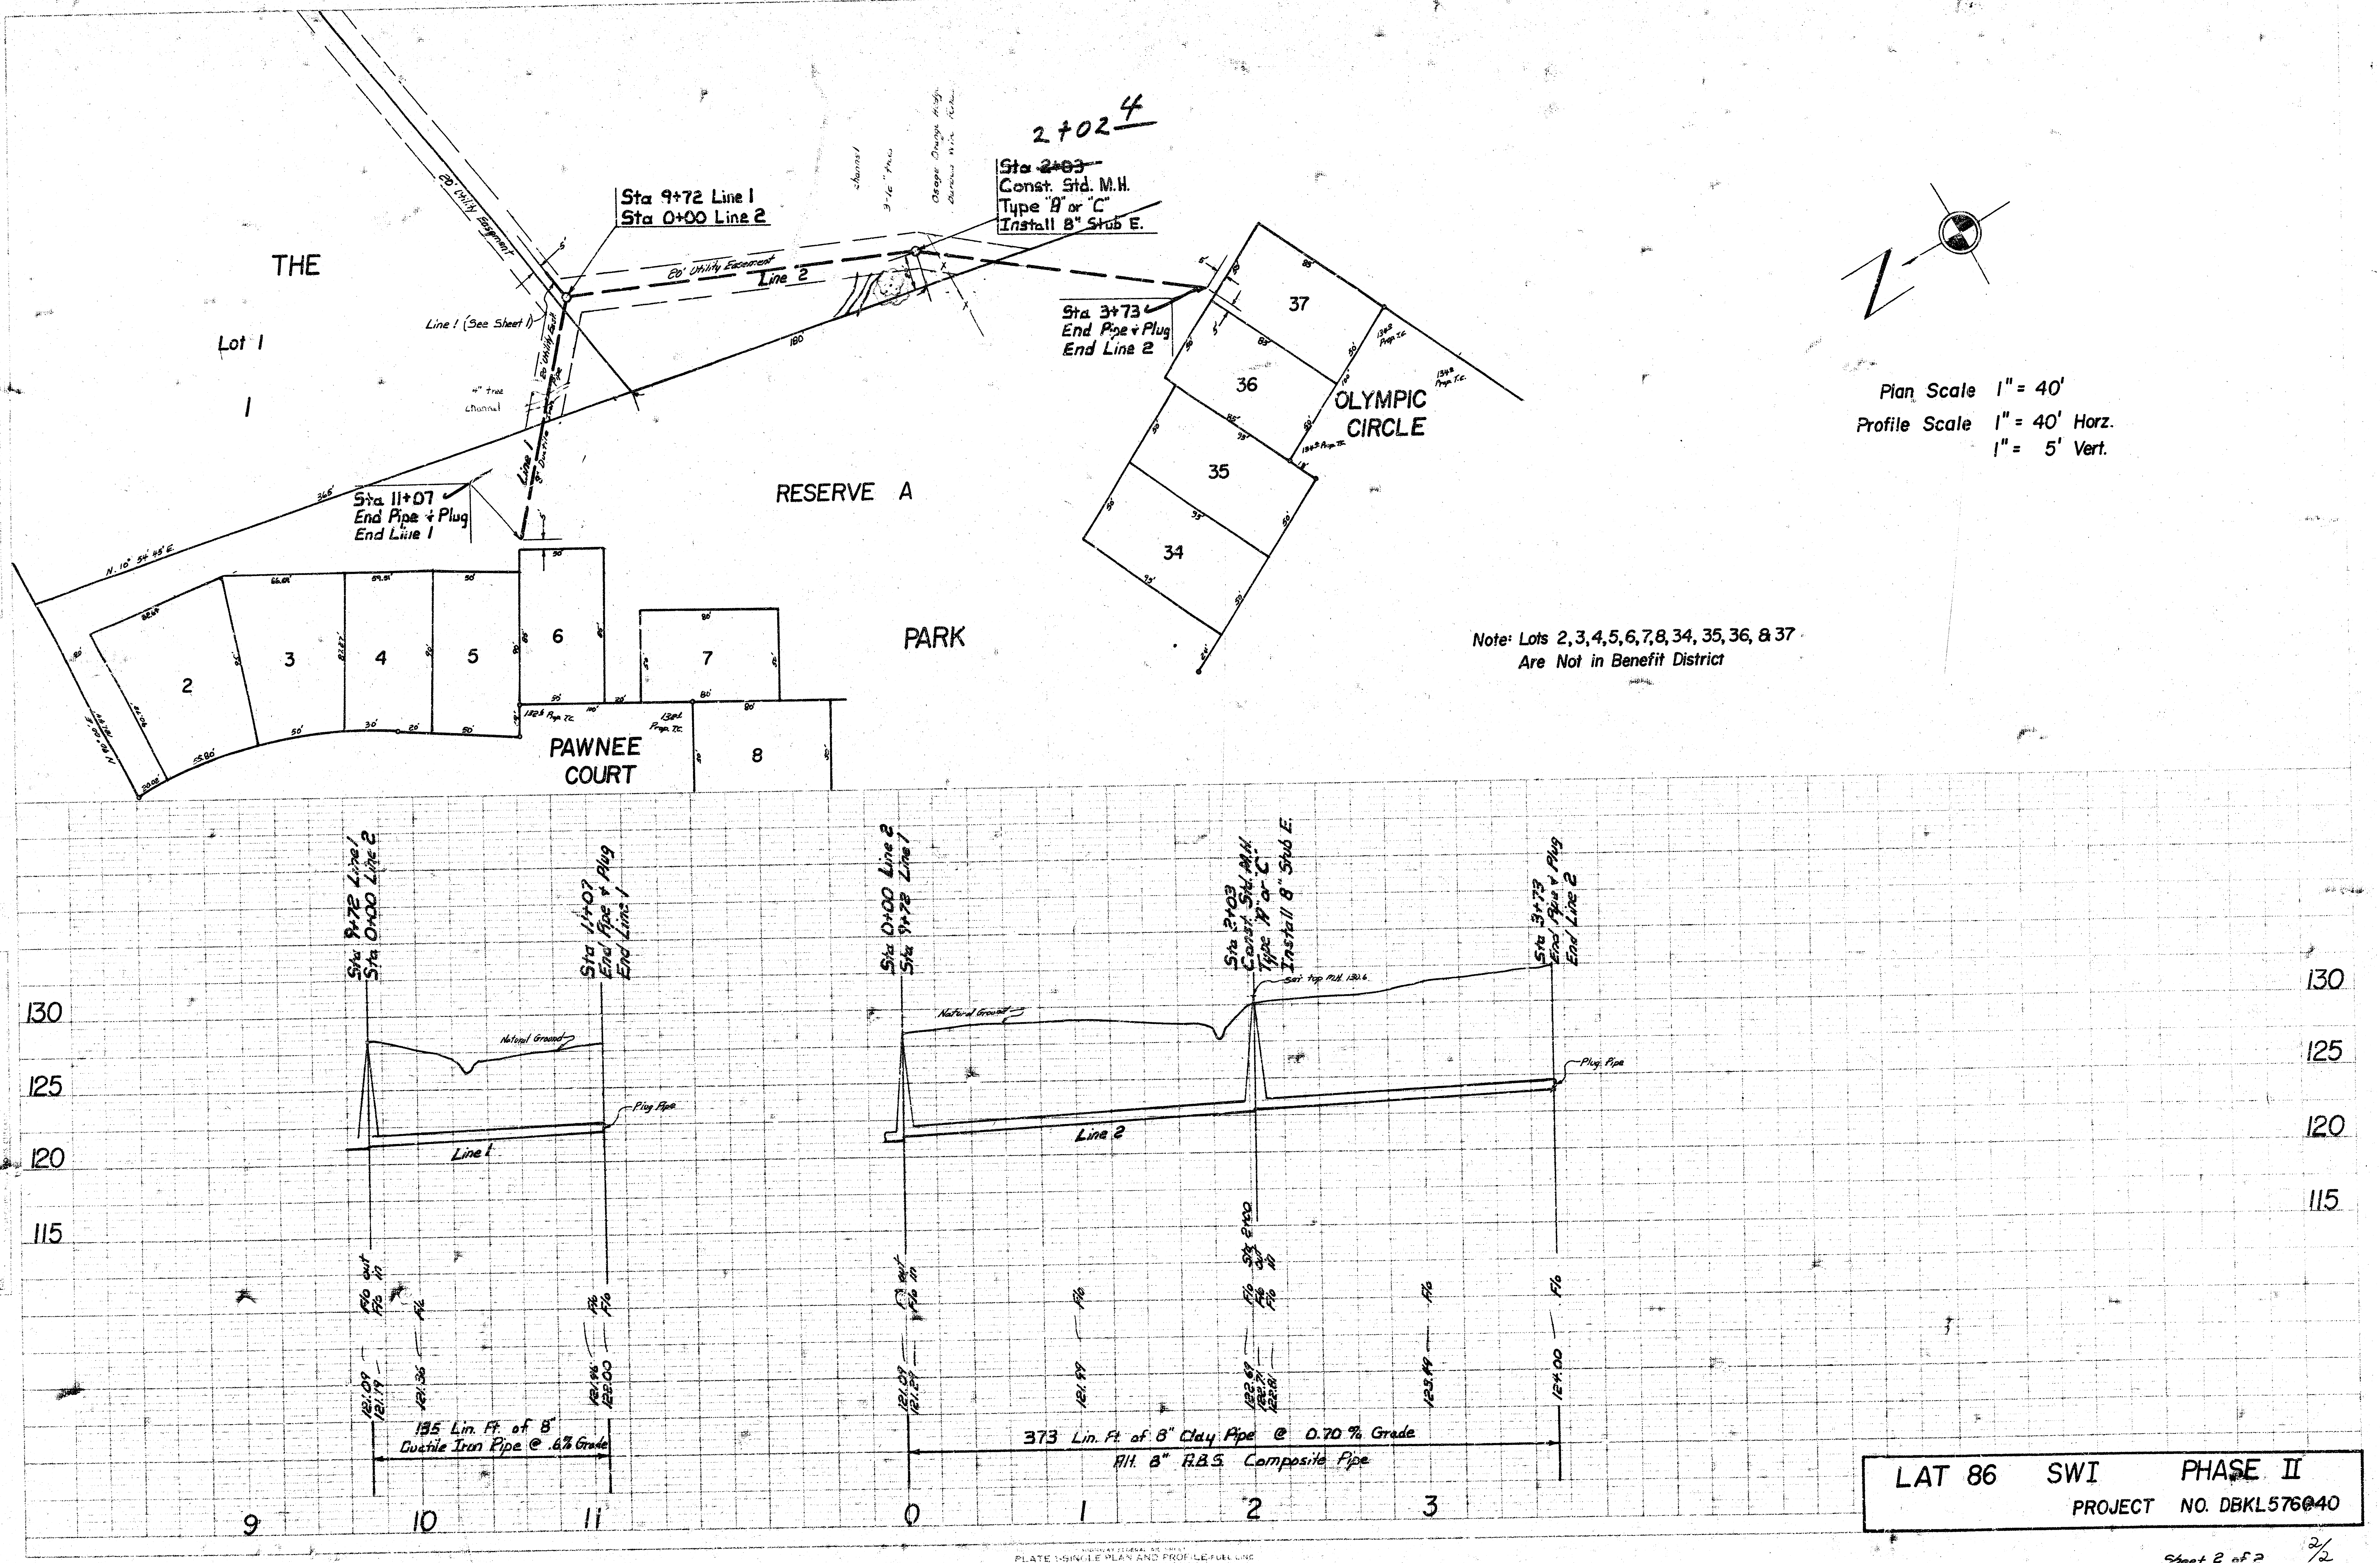

Plan Scale 1" = 40'

Profile Scale 1" = 40' Horz.
1" = 5' Vert.

Note: Lots 2, 3, 4, 5, 6, 7, 8, 34, 35, 36, & 37
Are Not in Benefit District

LAT 86 SWI PHASE II
PROJECT NO. DBKL576@40

PLATE 1-SINGLE PLAN AND PROFILE-FULL LINE

Sheet 2 of 2

2/2

14 10 4 12