


LATERAL 89, SW INTERCEPTOR SEWER

PROJECT NO.

468 · 76 · 245 · 80260 · 000 · 000 · 001



CITY OF WICHITA, KANSAS

DEAN SELLERS, ACTING CITY ENGINEER

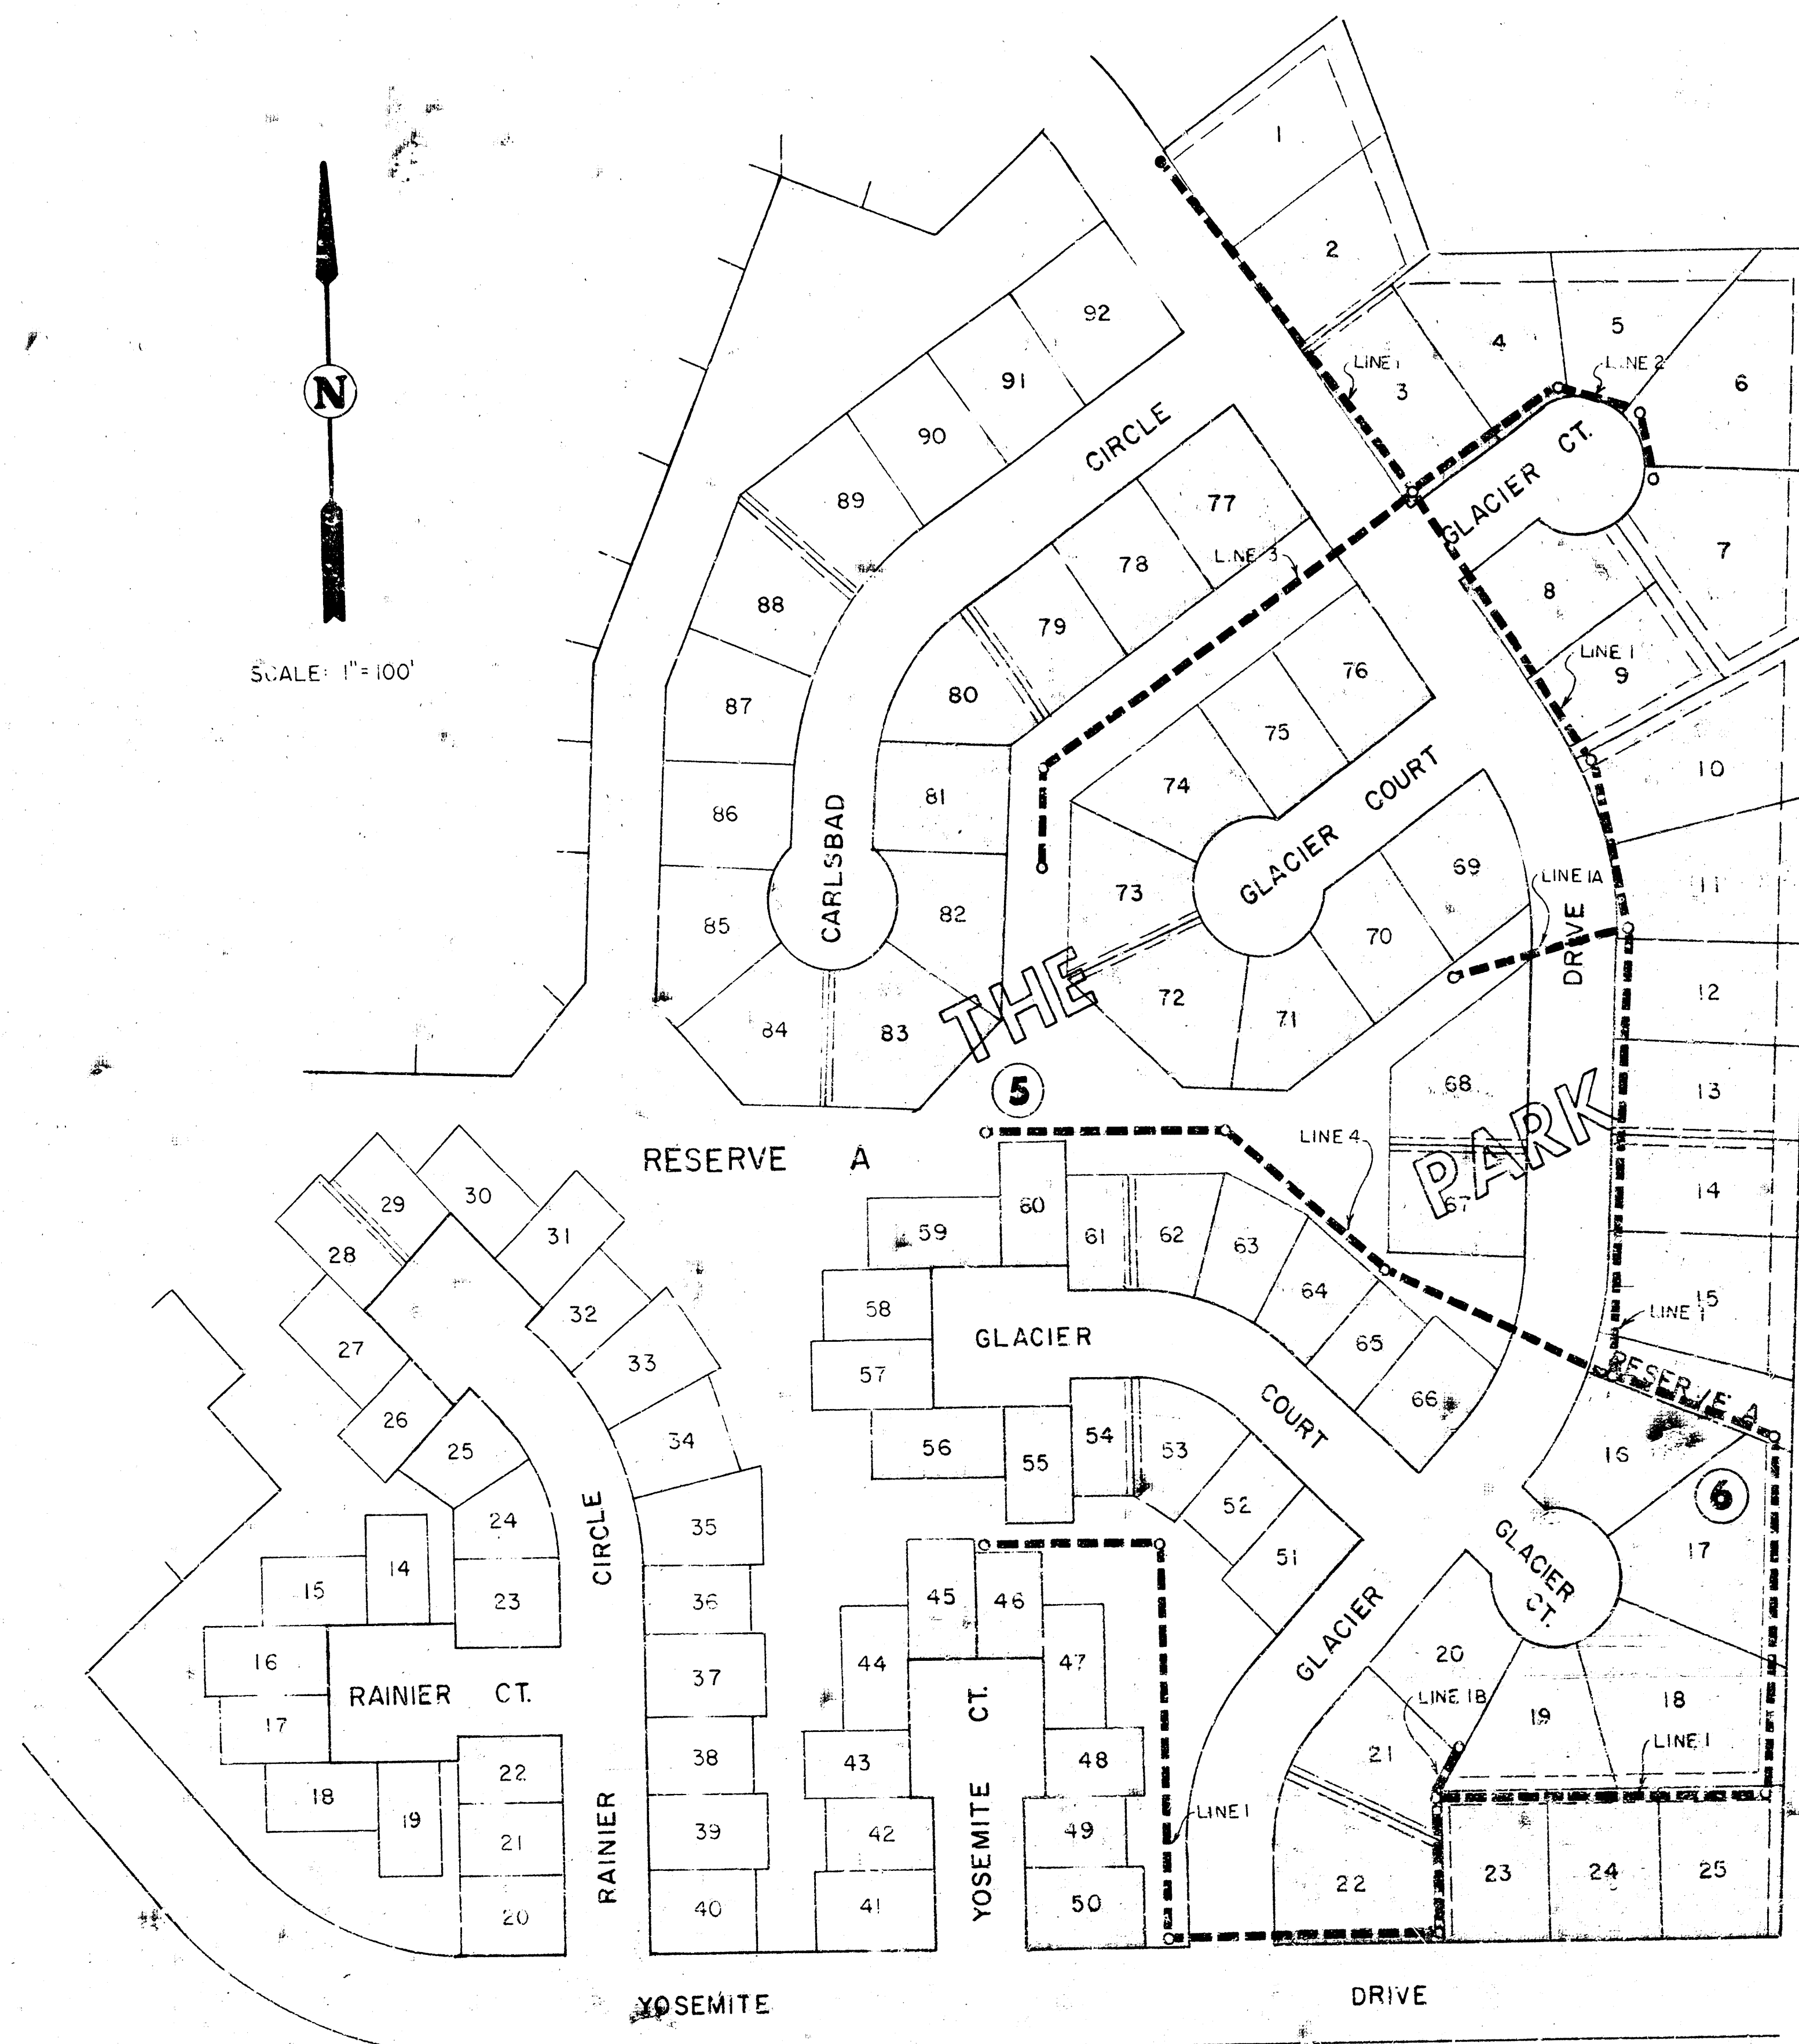[illegible]

INDEX TO DRAWINGS

SHT. NO	DESCRIPTION
1	TITLE SHEET
2	LINE 1, 1A, 1B
3	LINE 2, 3, 4

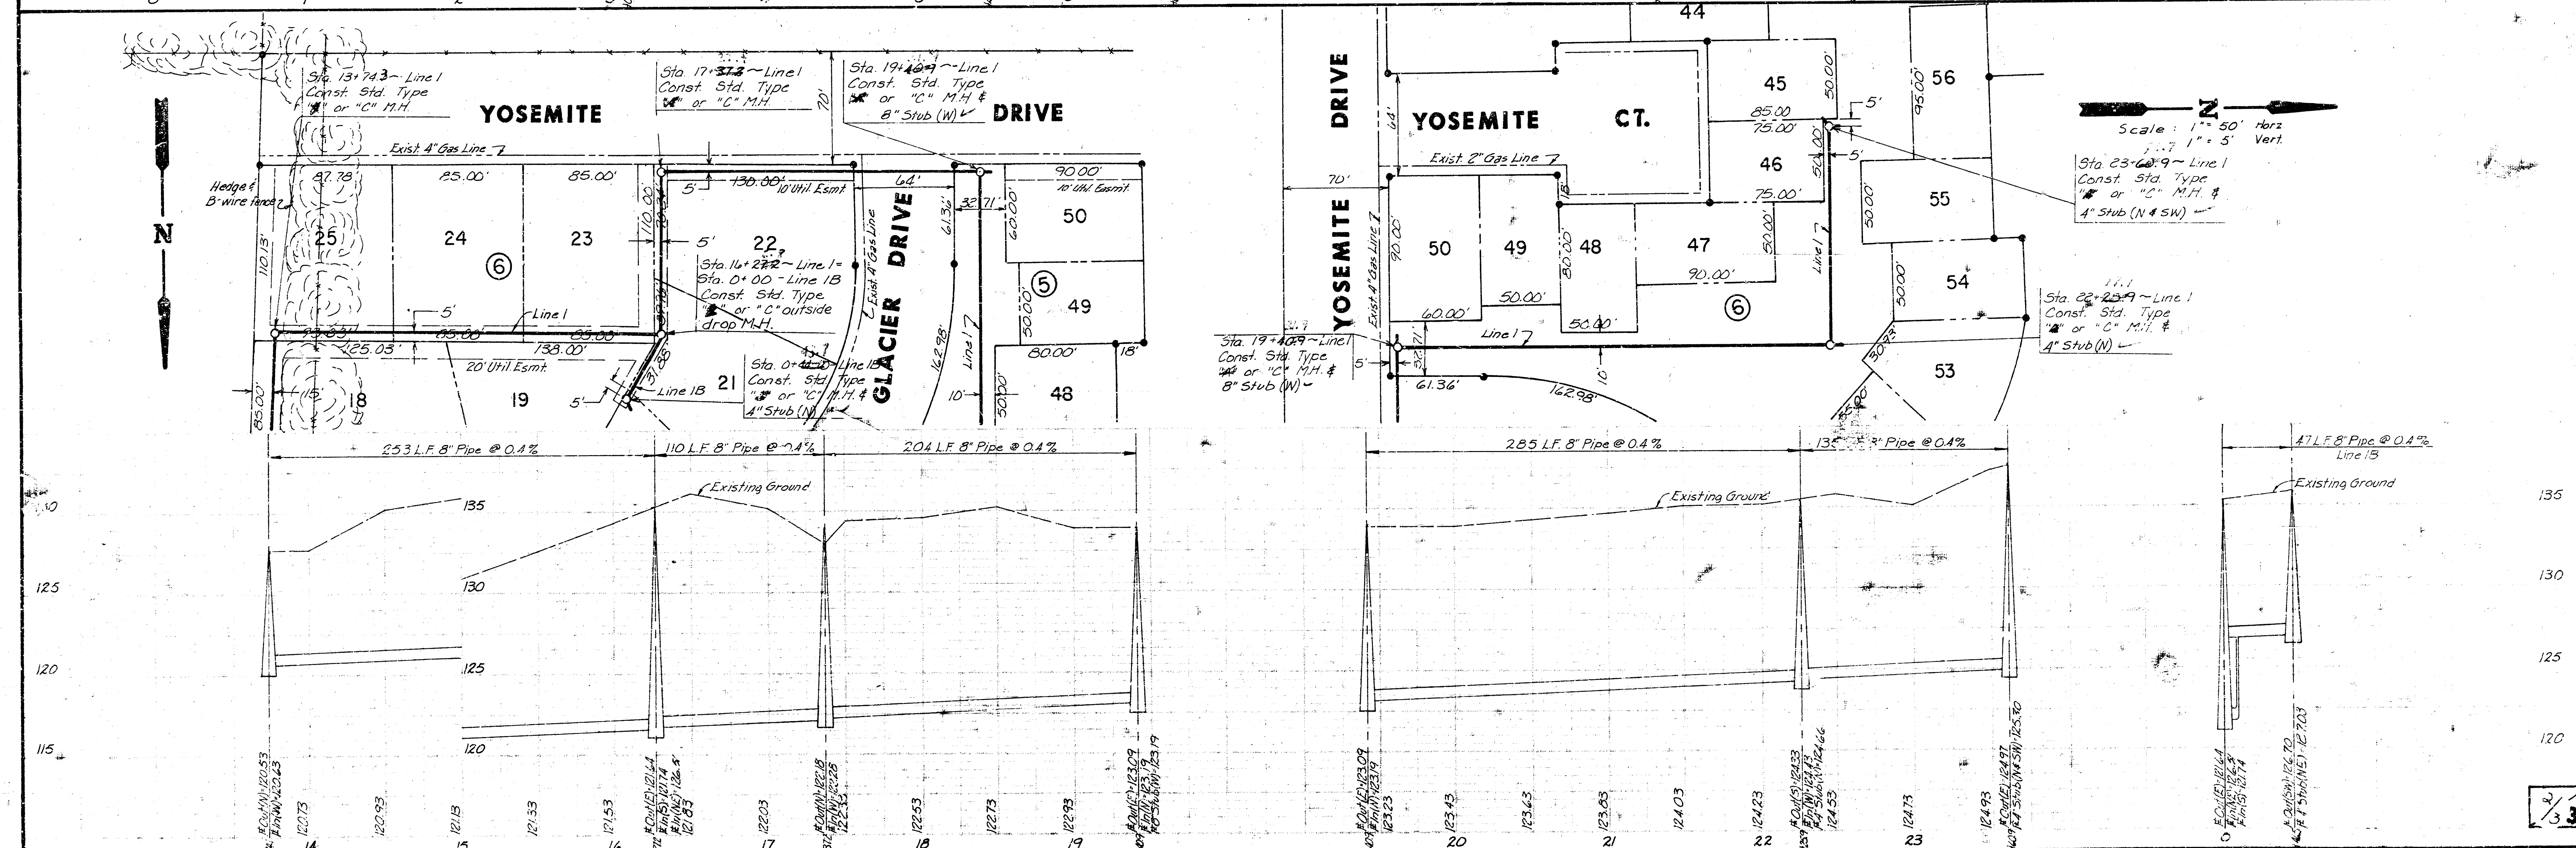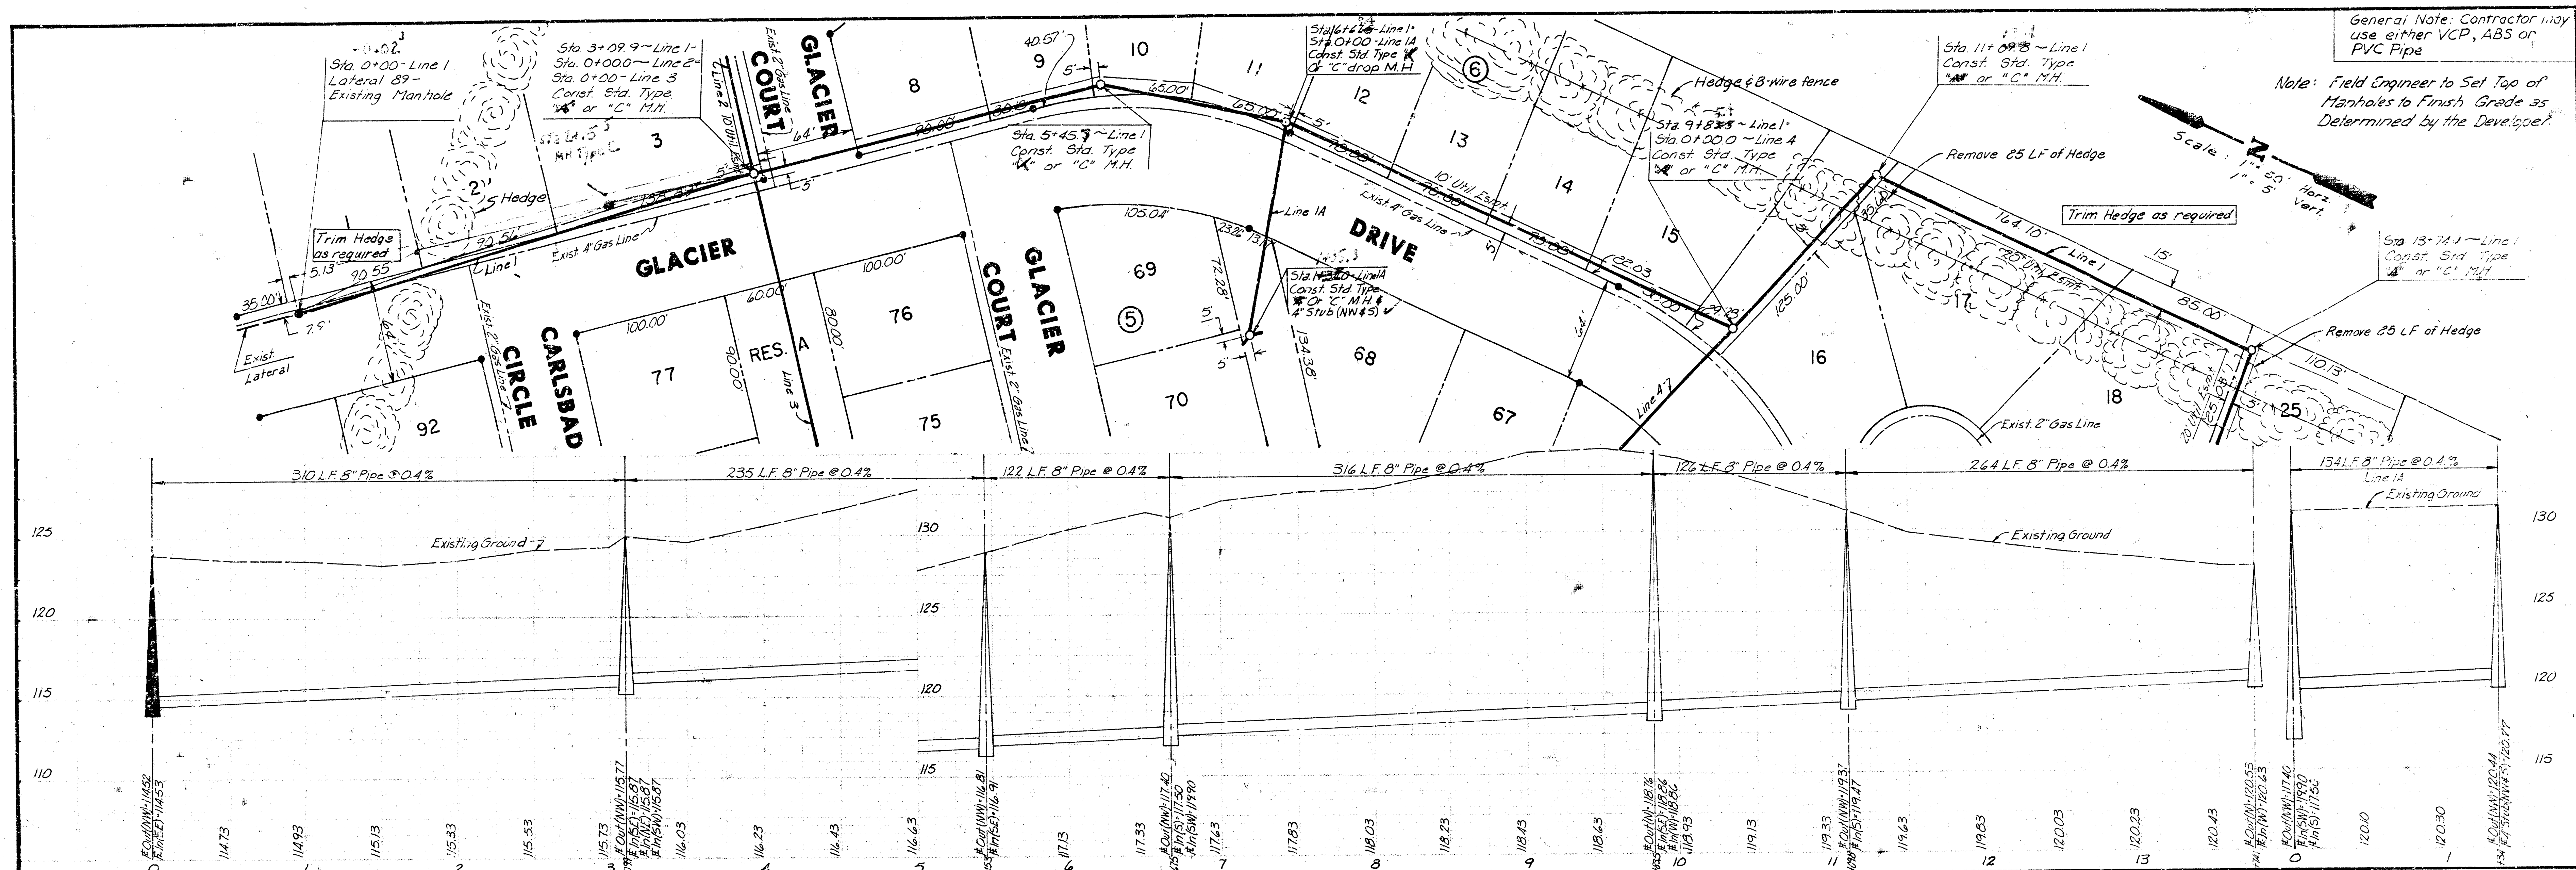

General Note: Contractor May use either VCP, ABS or PVC Pipe

