


Plan Scale: 1" = 40'
 Profile Scale: 1" = 40' Vert.
 1" = 5' Hor.

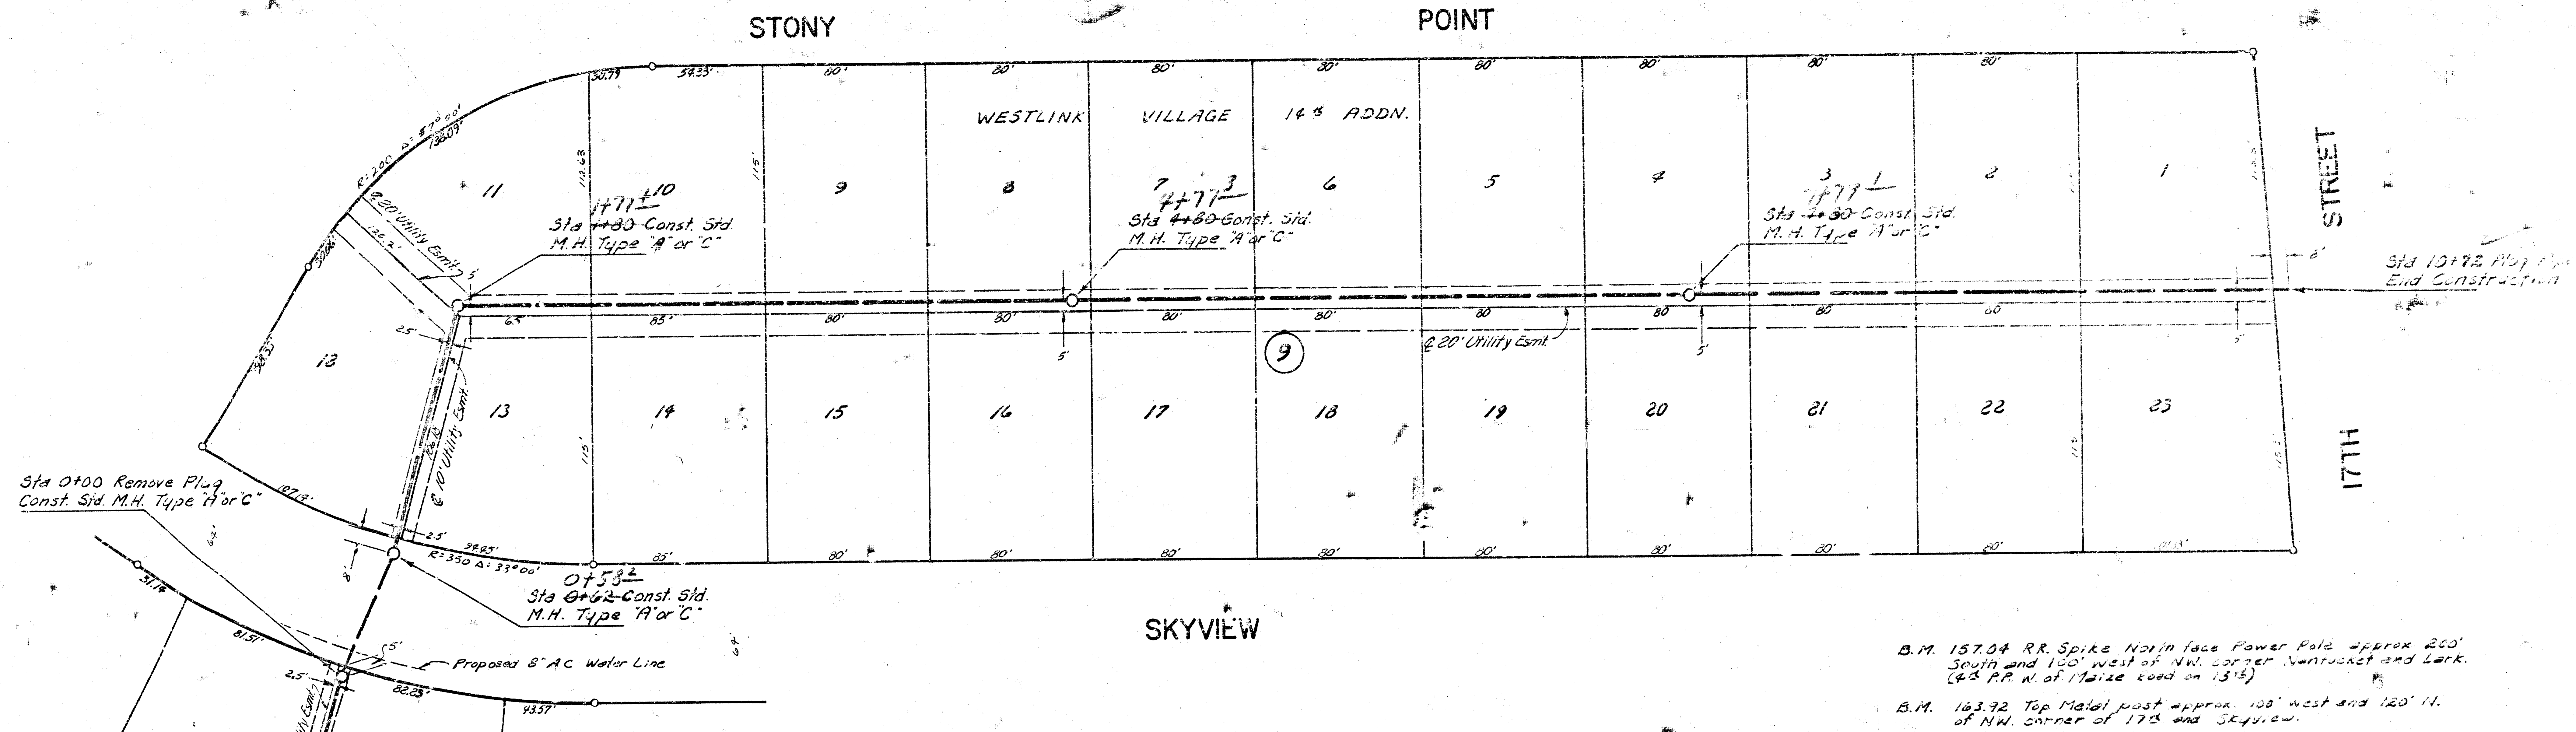

SKYVIEW

B.M. 157.04 RR Spike North face Power Pole approx 200' South and 100' west of NW corner Nantucket and Lark. (4th P.P. N. of Maple Road on 13th)

B.M. 163.92 Top Metal post approx 100' west and 120' N. of NW corner of 17th and Skyview.

