Lat. 141, Southwest Interceptor

468-76-245-80748-000-000-001

CITY of WICHITA, KANSAS
DEPT. of PUBLIC WORKS-ENGINEERING DIV.
DEAN S. SELLERS-ACTING CITY ENGINEER

DATE _____

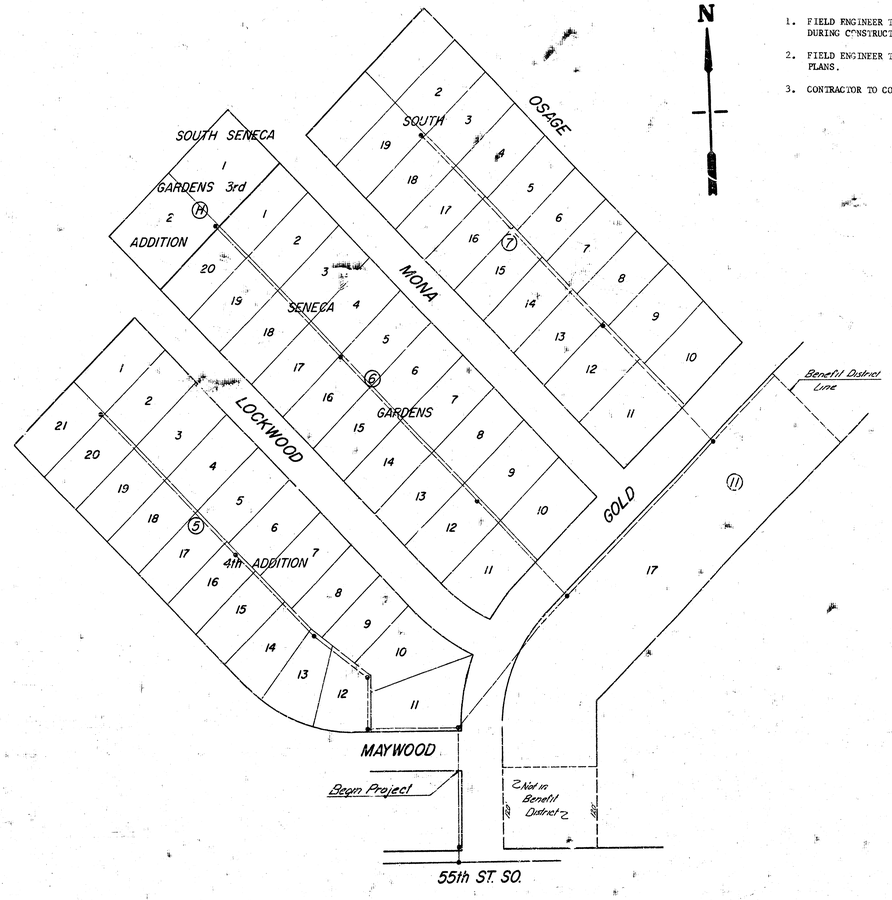

GENERAL NOTES

1. FIELD ENGINEER TO TAKE TIES TO ANY IRONS THAT MAY BE DISTURBED DURING CONSTRUCTION AND REPLACE ANY IRONS DESTROYED DURING CONSTRUCTION.
2. FIELD ENGINEER TO SET TOP OF MANHOLES TO FINISH GRADE AS DETERMINED BY THE DIVELOPER UNLESS OTHERWISE NOTED ON PLANS.
3. CONTRACTOR TO CONTACT UTILITY COMPANIES FOR LOCATION OF ANY UNDERGROUND LINES BEFORE BEGINNING CONSTRUCTION.

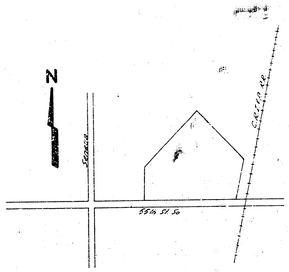

Location Map

CIVIL ENGINEER LICENSED 8208 KANSAS

1/15 1/5

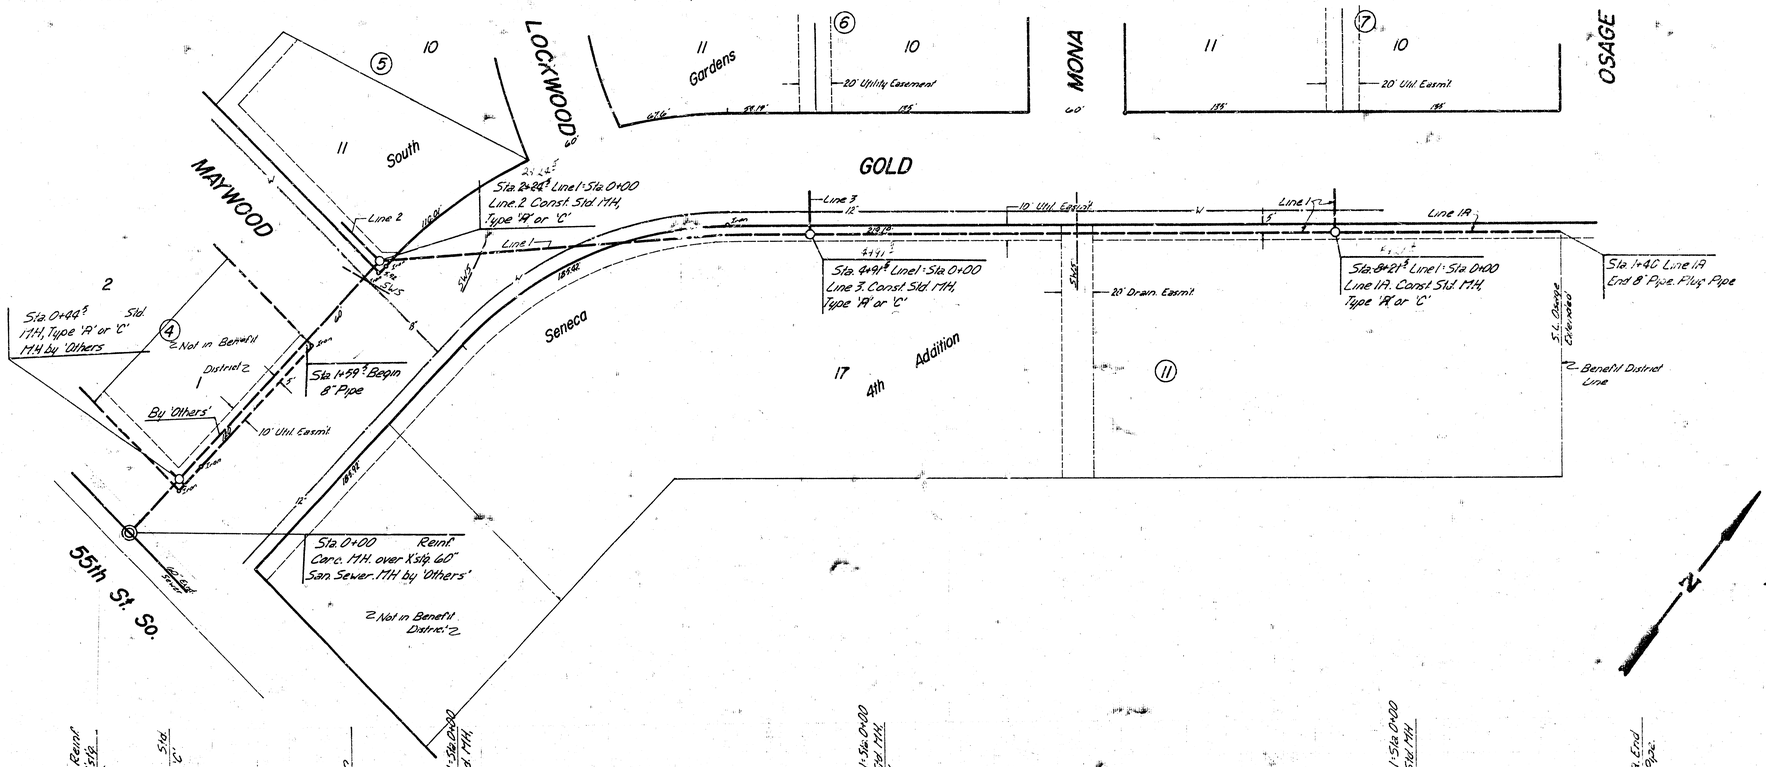

B.M. 82.05 R.R. Spk. N.E. Face Tele. Pole N.S. 55th St. So. 33' ± W. of W.L. Gold
B.M. 84.03 N.W. Cor. Conc. Porch 754 Mona
B.M. 81.08 R.R. Spk. S. face P. Pole N.W. Cor. Lockwood & Southbound

Scale
Plan 1"=40'
Profile Hort. 1"=40'
Vert. 1"=5'

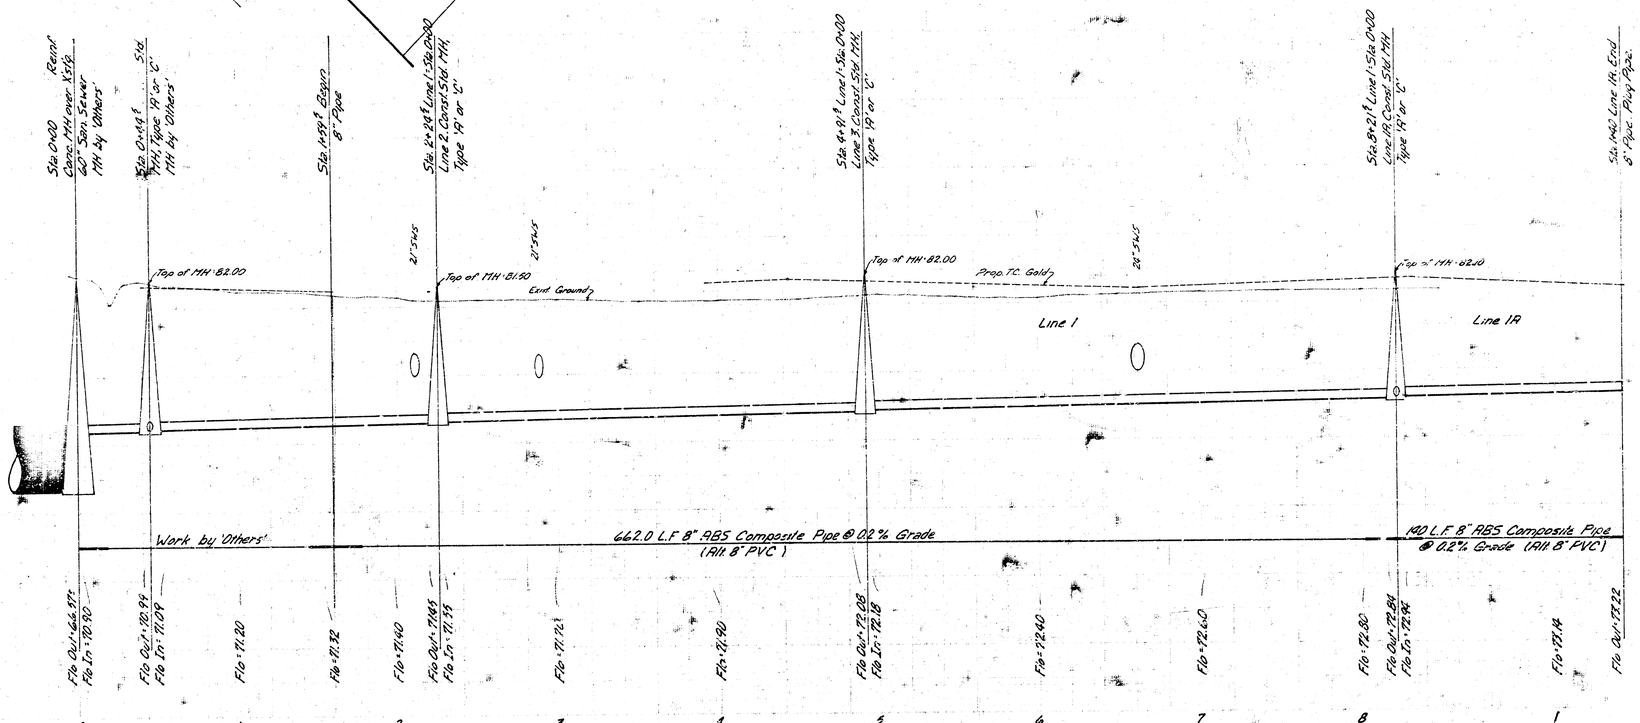

Line 1
Lat 141.5' W.I.
2/5

MONA

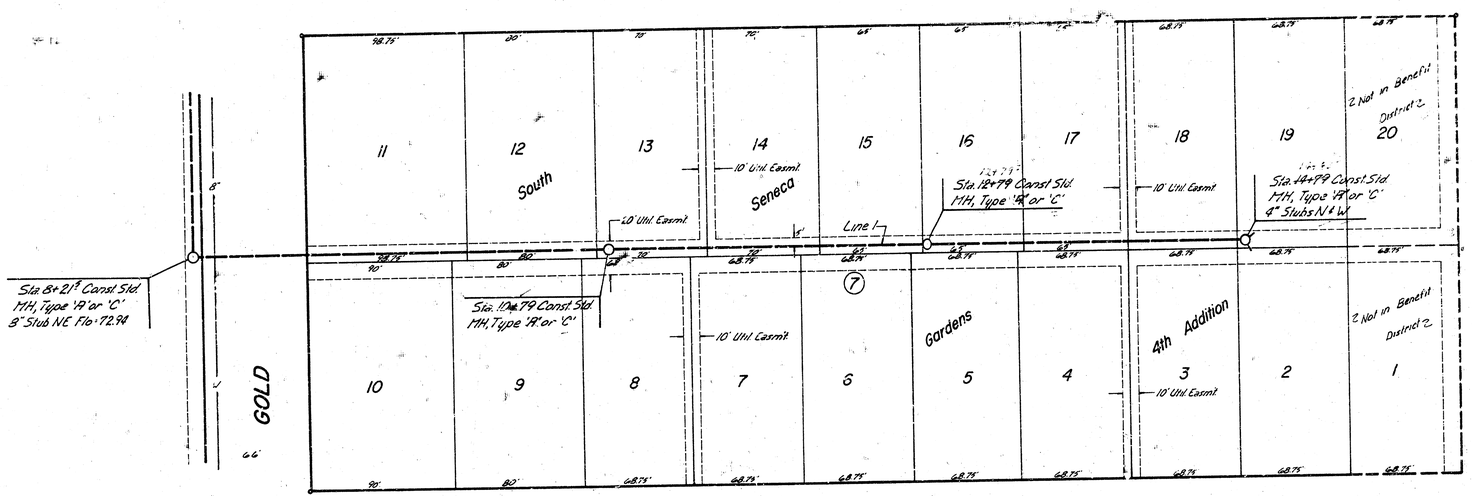

OSAGE

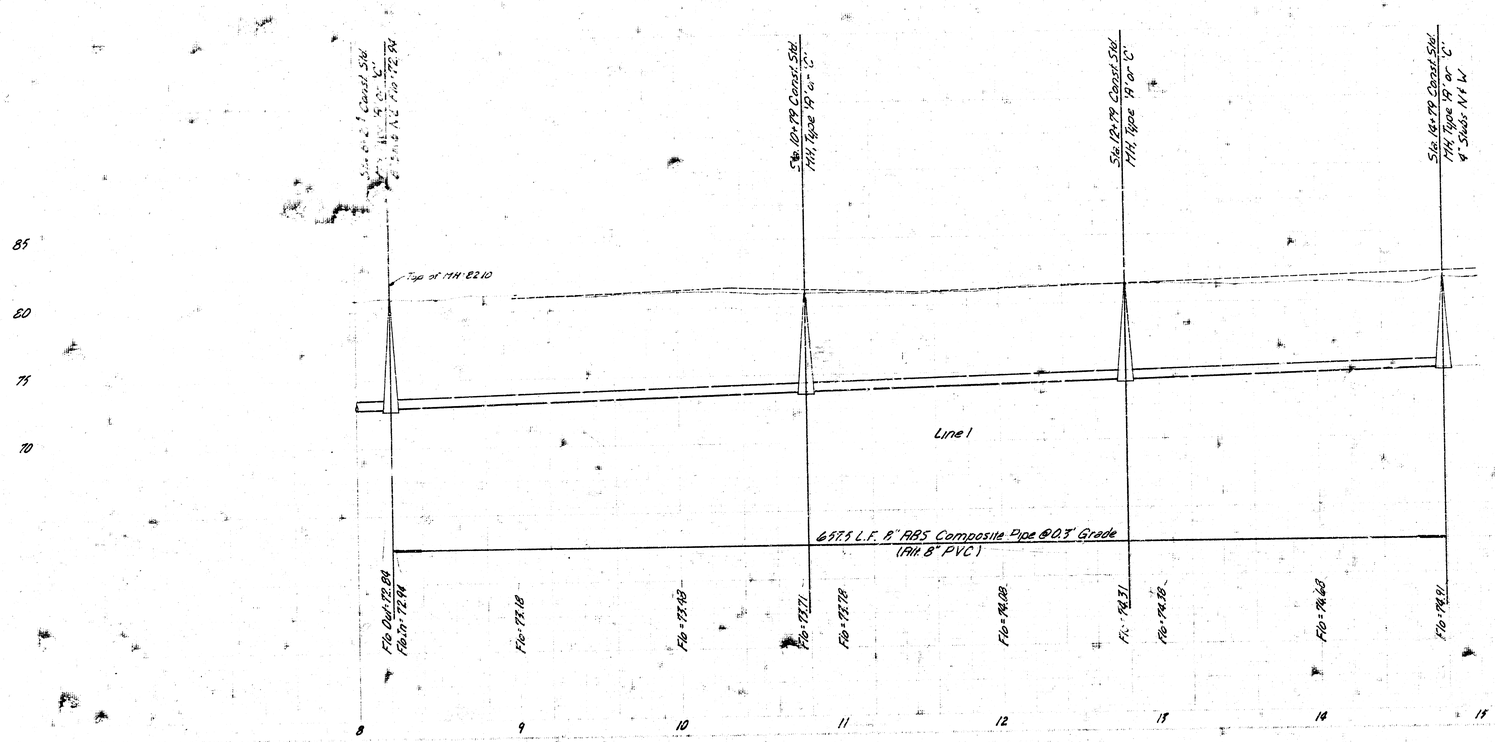

Scale
Plan 1"=40'
Profile Hor. 1"=40'
Vert. 1"=5'

Line 1
Lat. 14, S.W.I. 3/5

MAYWOOD

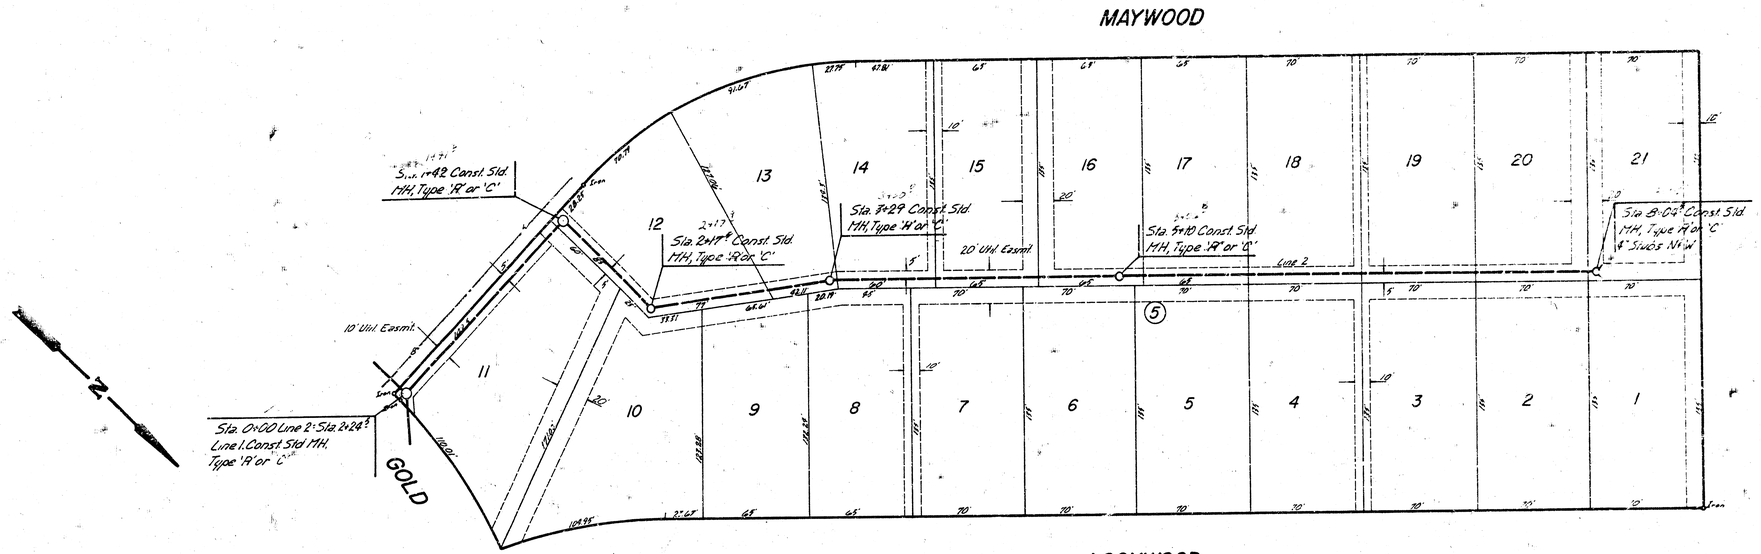

LOCKWOOD

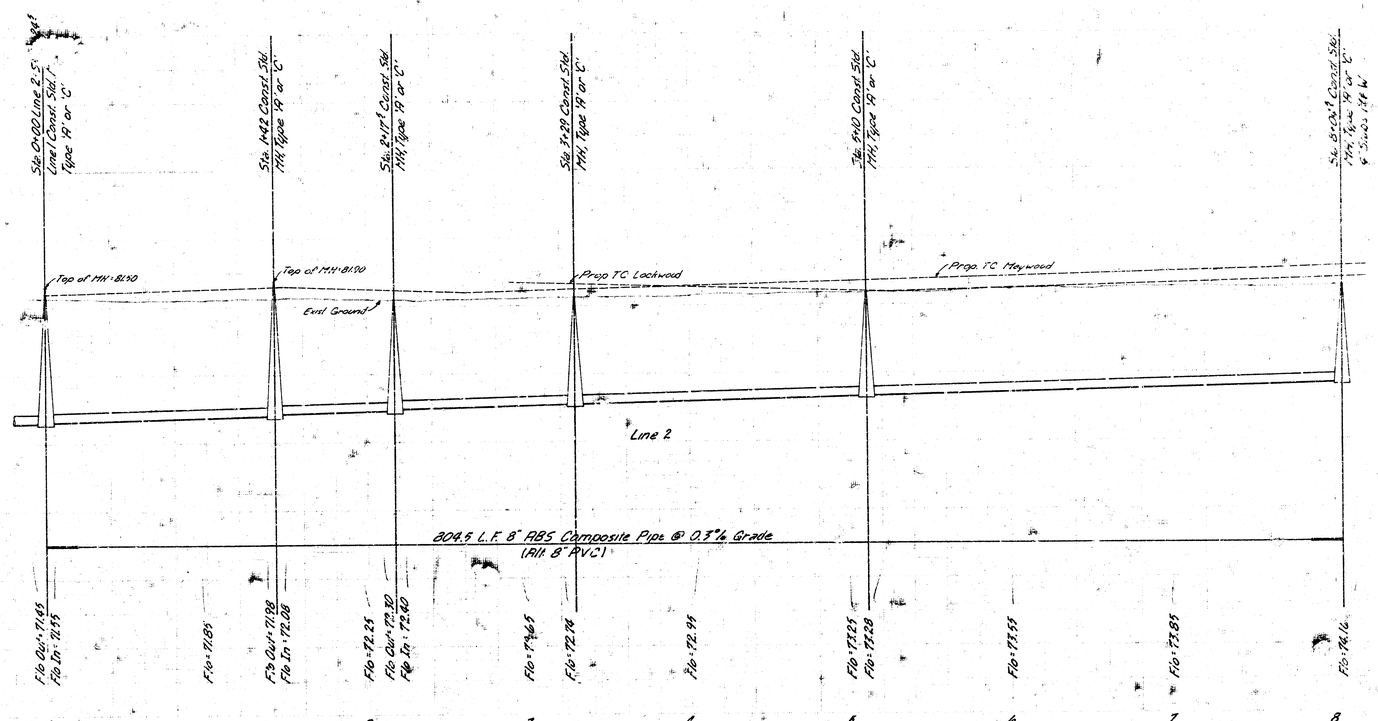

Scale
Plan 1" = 40'
Profile Hort 1" = 40'
Vert 1" = 5'

Line 2
Cal. 161, S.W.I. 4/5

LOCKWOOD

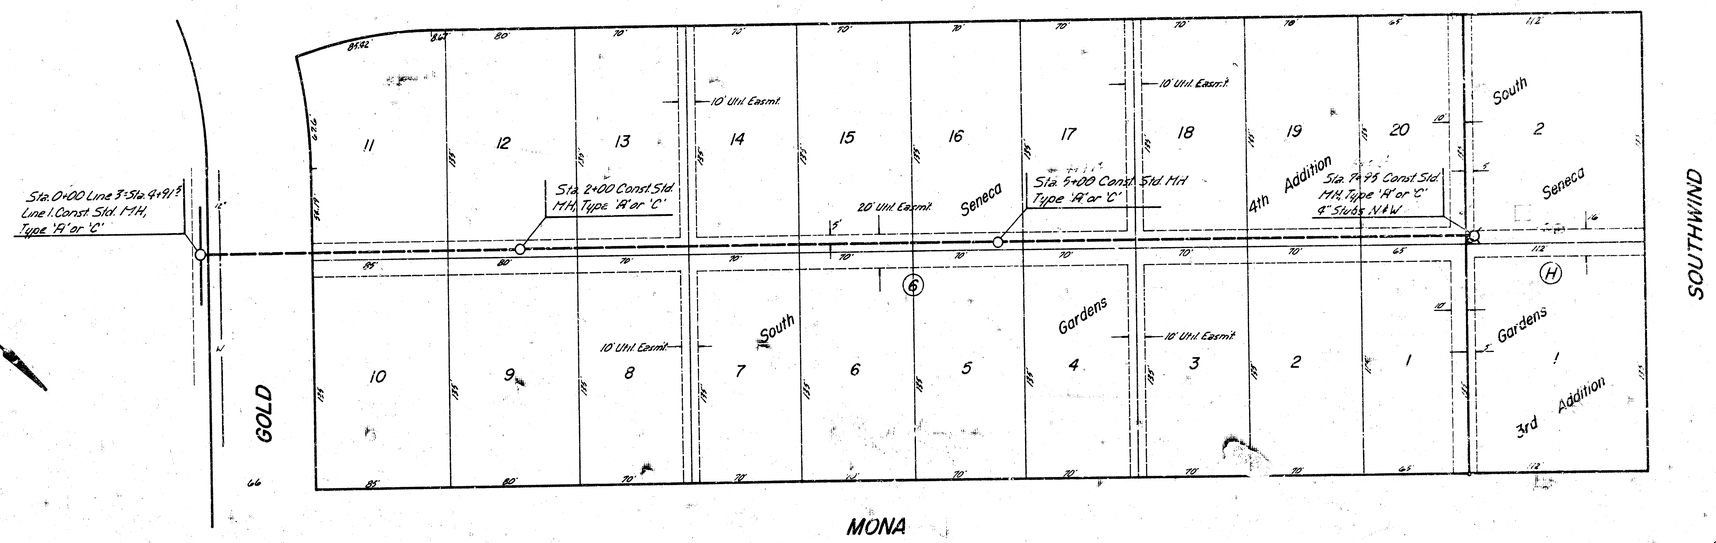

MONA

Scale
Plan 1"=40'
Profile Horiz 1"=40'
Vert 1"=5'

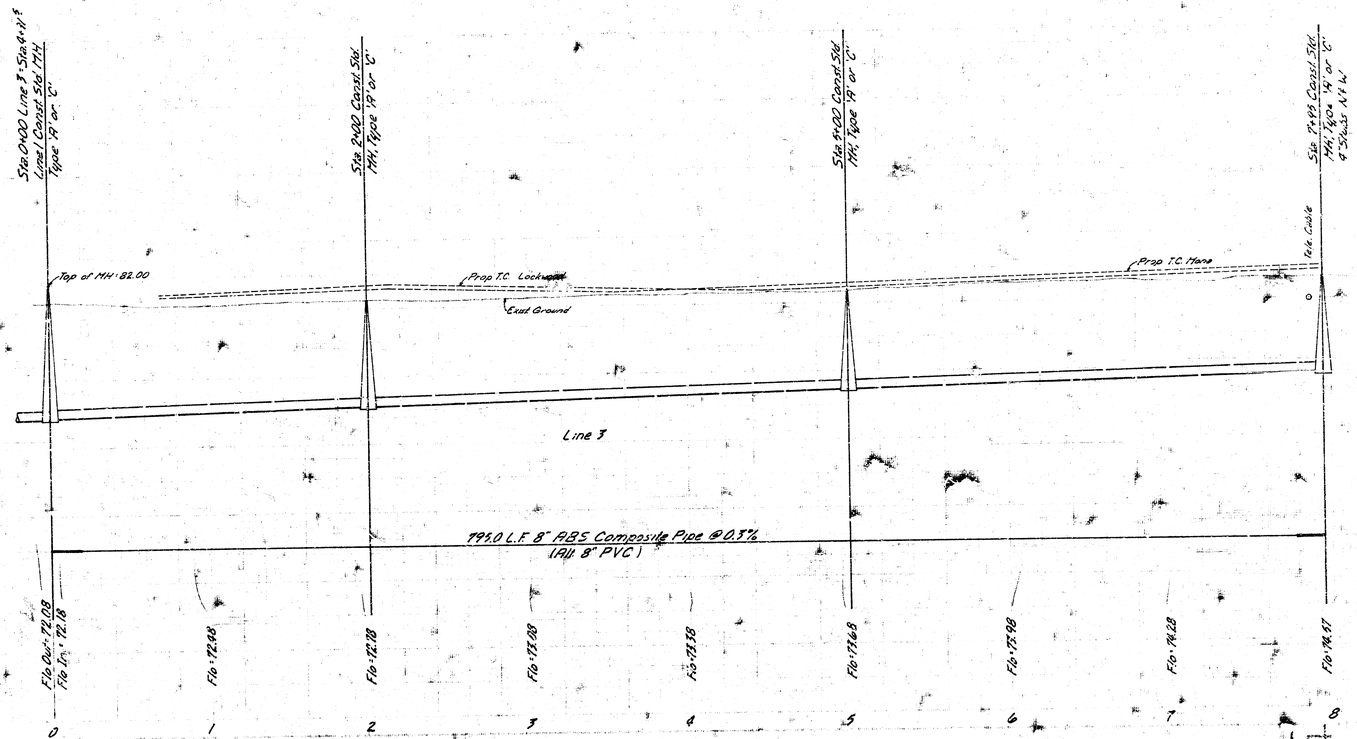

Line 3
Cat. 141, S.W.I. 5/5