


CONSTRUCTION PLANS FOR
LATERAL 197
OF THE
SOUTHWEST INTERCEPTOR SEWER
THE CITY OF WICHITA,
SEDGWICK COUNTY, KANSAS
MICHAEL E. LINDEBAK, P.E. CITY ENGINEER

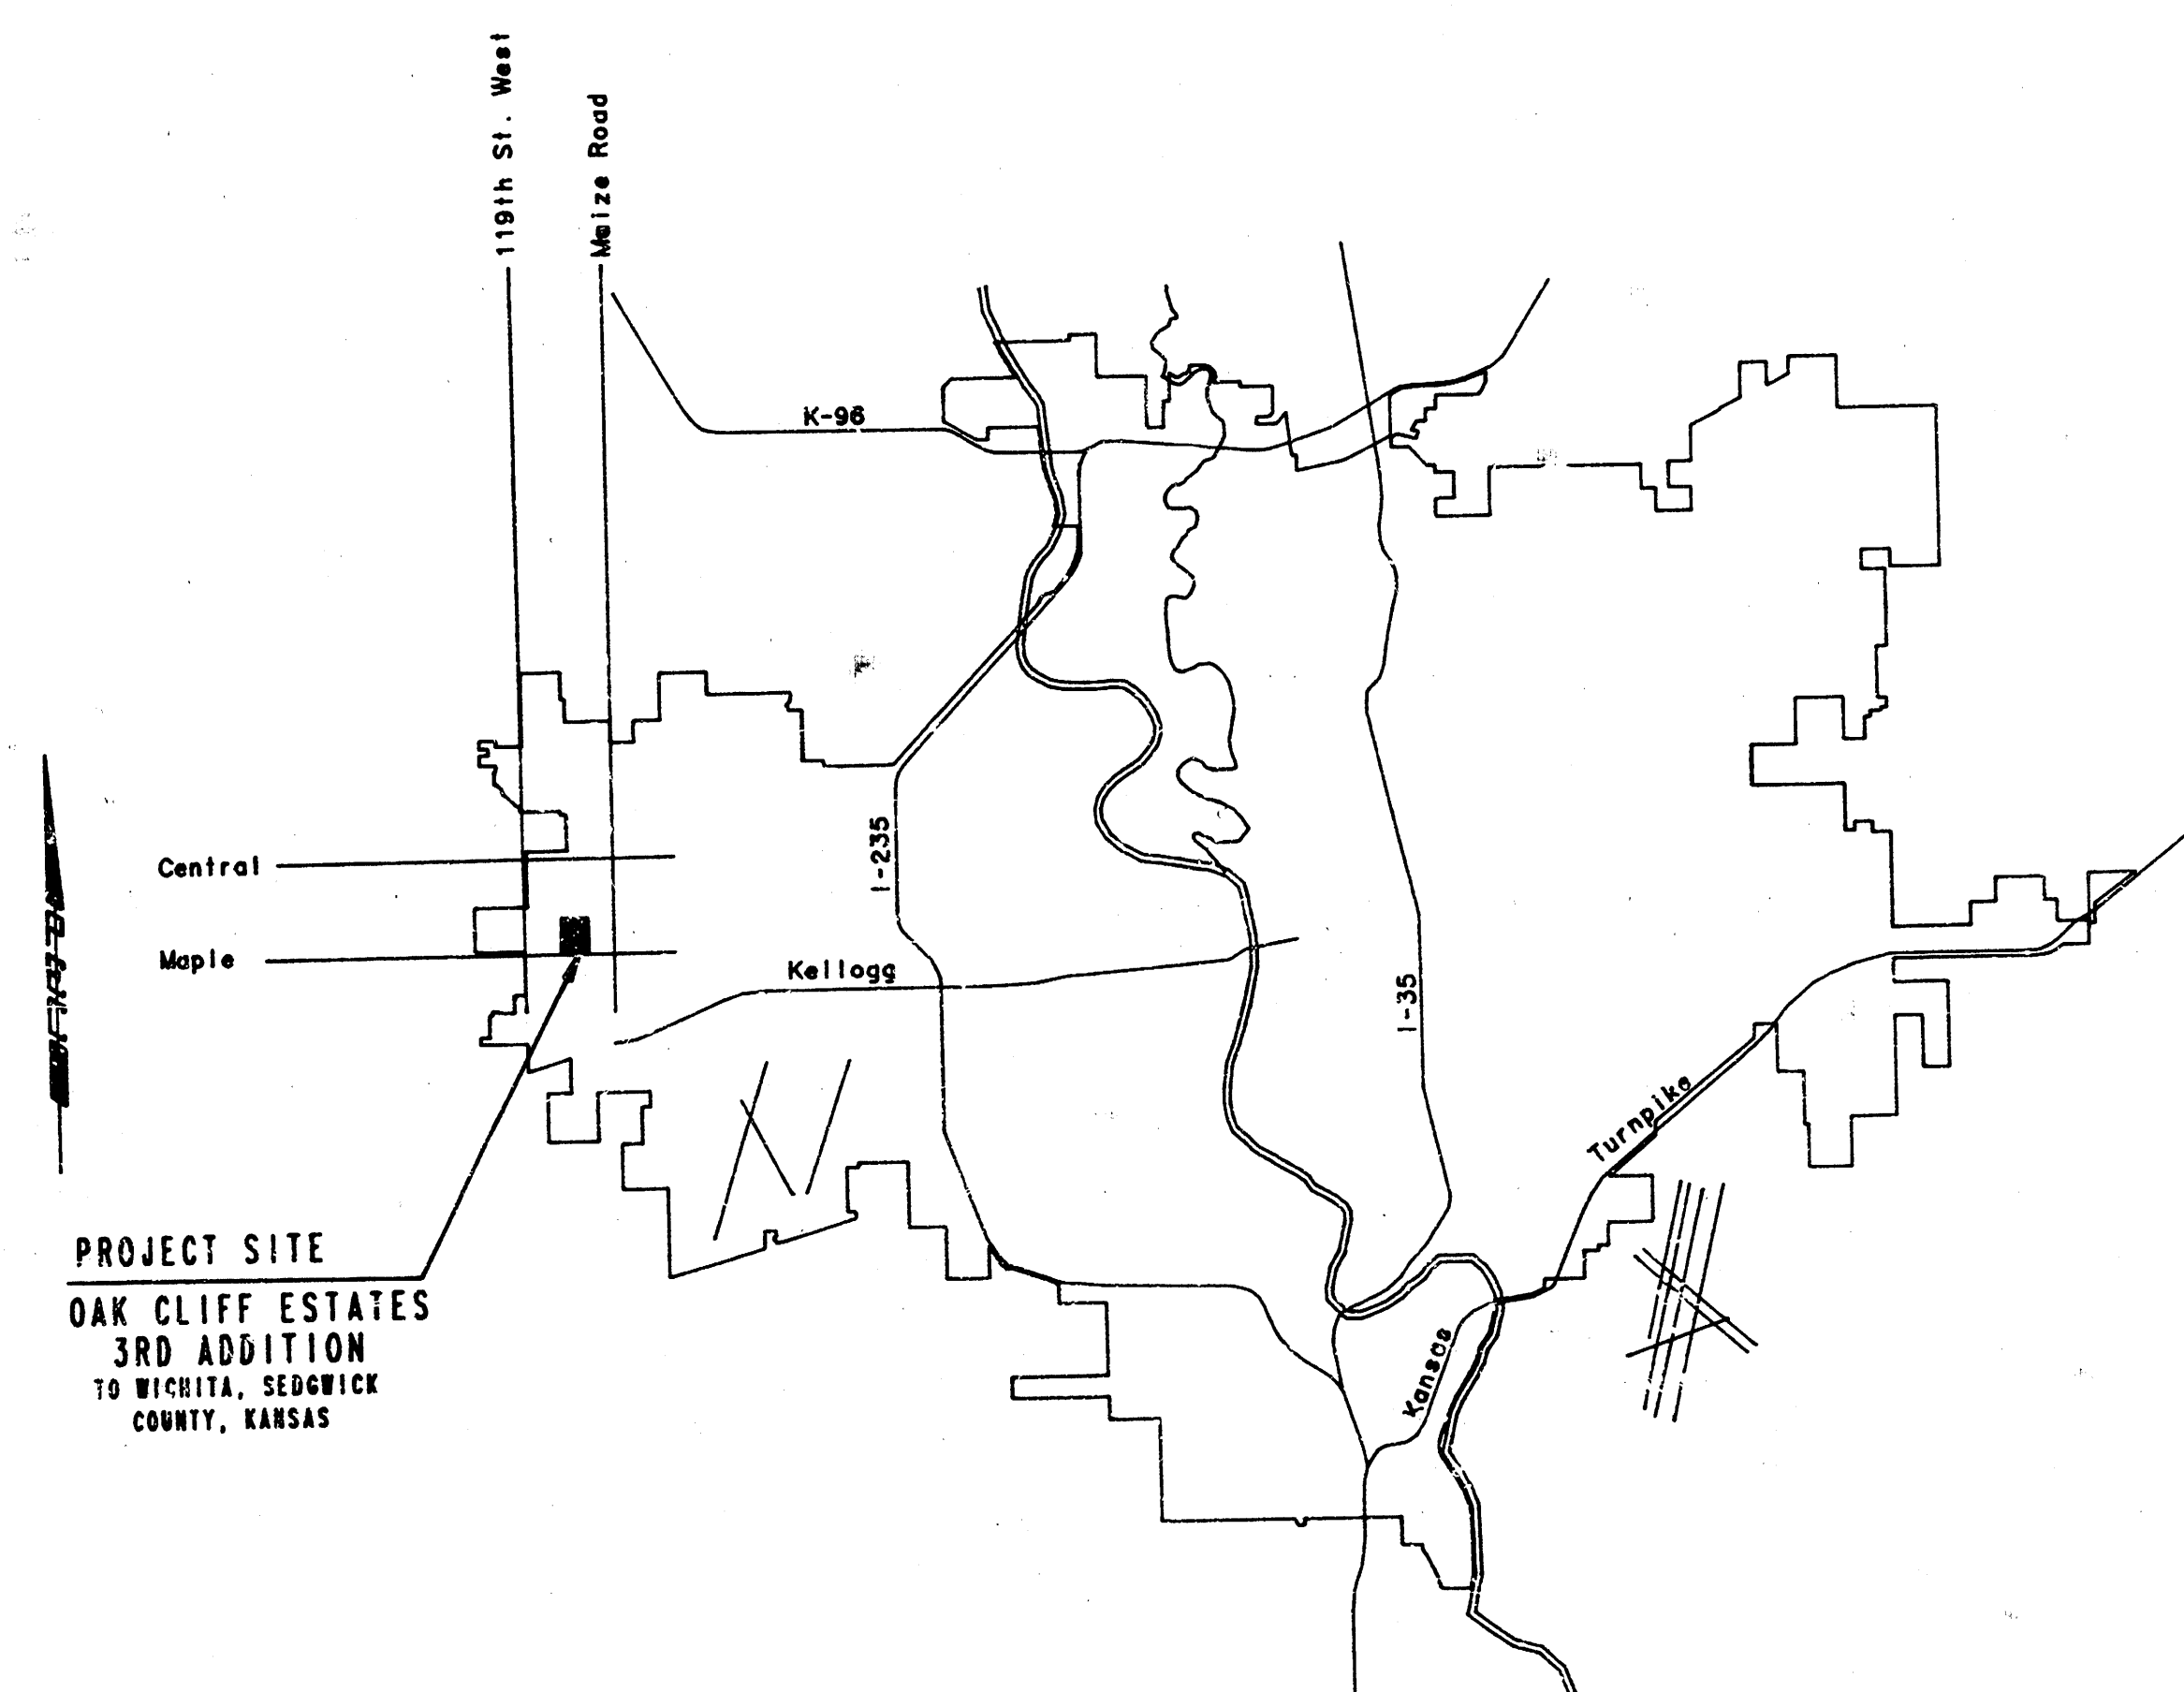

115 Built
S.L.
7-85

LOCATION MAP

CITY OF WICHITA PROJECT NO. 468-76-245-81416-000-000-001

MARCH, 1985

PLANS PREPARED BY
PROFESSIONAL ENGINEERING CONSULTANTS, P.A.,
ENGINEERS
WICHITA, KANSAS



**FILMED FROM THE BEST
AVAILABLE COPY.....**

