

LATERAL 201 S.W.I.

WESTLINK VILLAGE SIXTEENTH ADDITION

Lots 1 - 11 & 14 - 24, Block 10

Lots 1 - 11 & 14 - 24, Block 11


468-76-245-81439-000-000-001

GENERAL NOTES

- Existing utilities and their locations, as shown on the plans, represent the best information obtainable for design. The Contractor will be required to work around existing utilities within the right-of-way which do not conflict with proposed construction.
- Trees and shrubs in public right-of-way which are in direct conflict with proposed new construction shall be removed by the Contractor with the Engineer's approval. Trees and shrubs which are not in direct conflict with proposed new construction shall be saved and protected from damage.
- The Contractor shall be responsible for preserving property irons. The Contractor will be required to re-establish any property irons which are damaged or destroyed by his construction operations. Such irons shall be re-established by a licensed land surveyor in accordance with state laws.

BENCHMARKS

- R.R. Spike in 'Iron' Road (NE 1/4 side)
103 ft. So. & 47 ft. W. of NE Corner
Lot 15, Block 2, Westlink Village
Sixteenth Addition.
Elev. = 157.76 City datum
- 1/4 cut Top Curb (E. Return Ob. Inlet)
31 ft. W. of NE Corner Lot 15, Block
13, Westlink Village Sixteenth
Addn. Elev. = 157.96 City datum

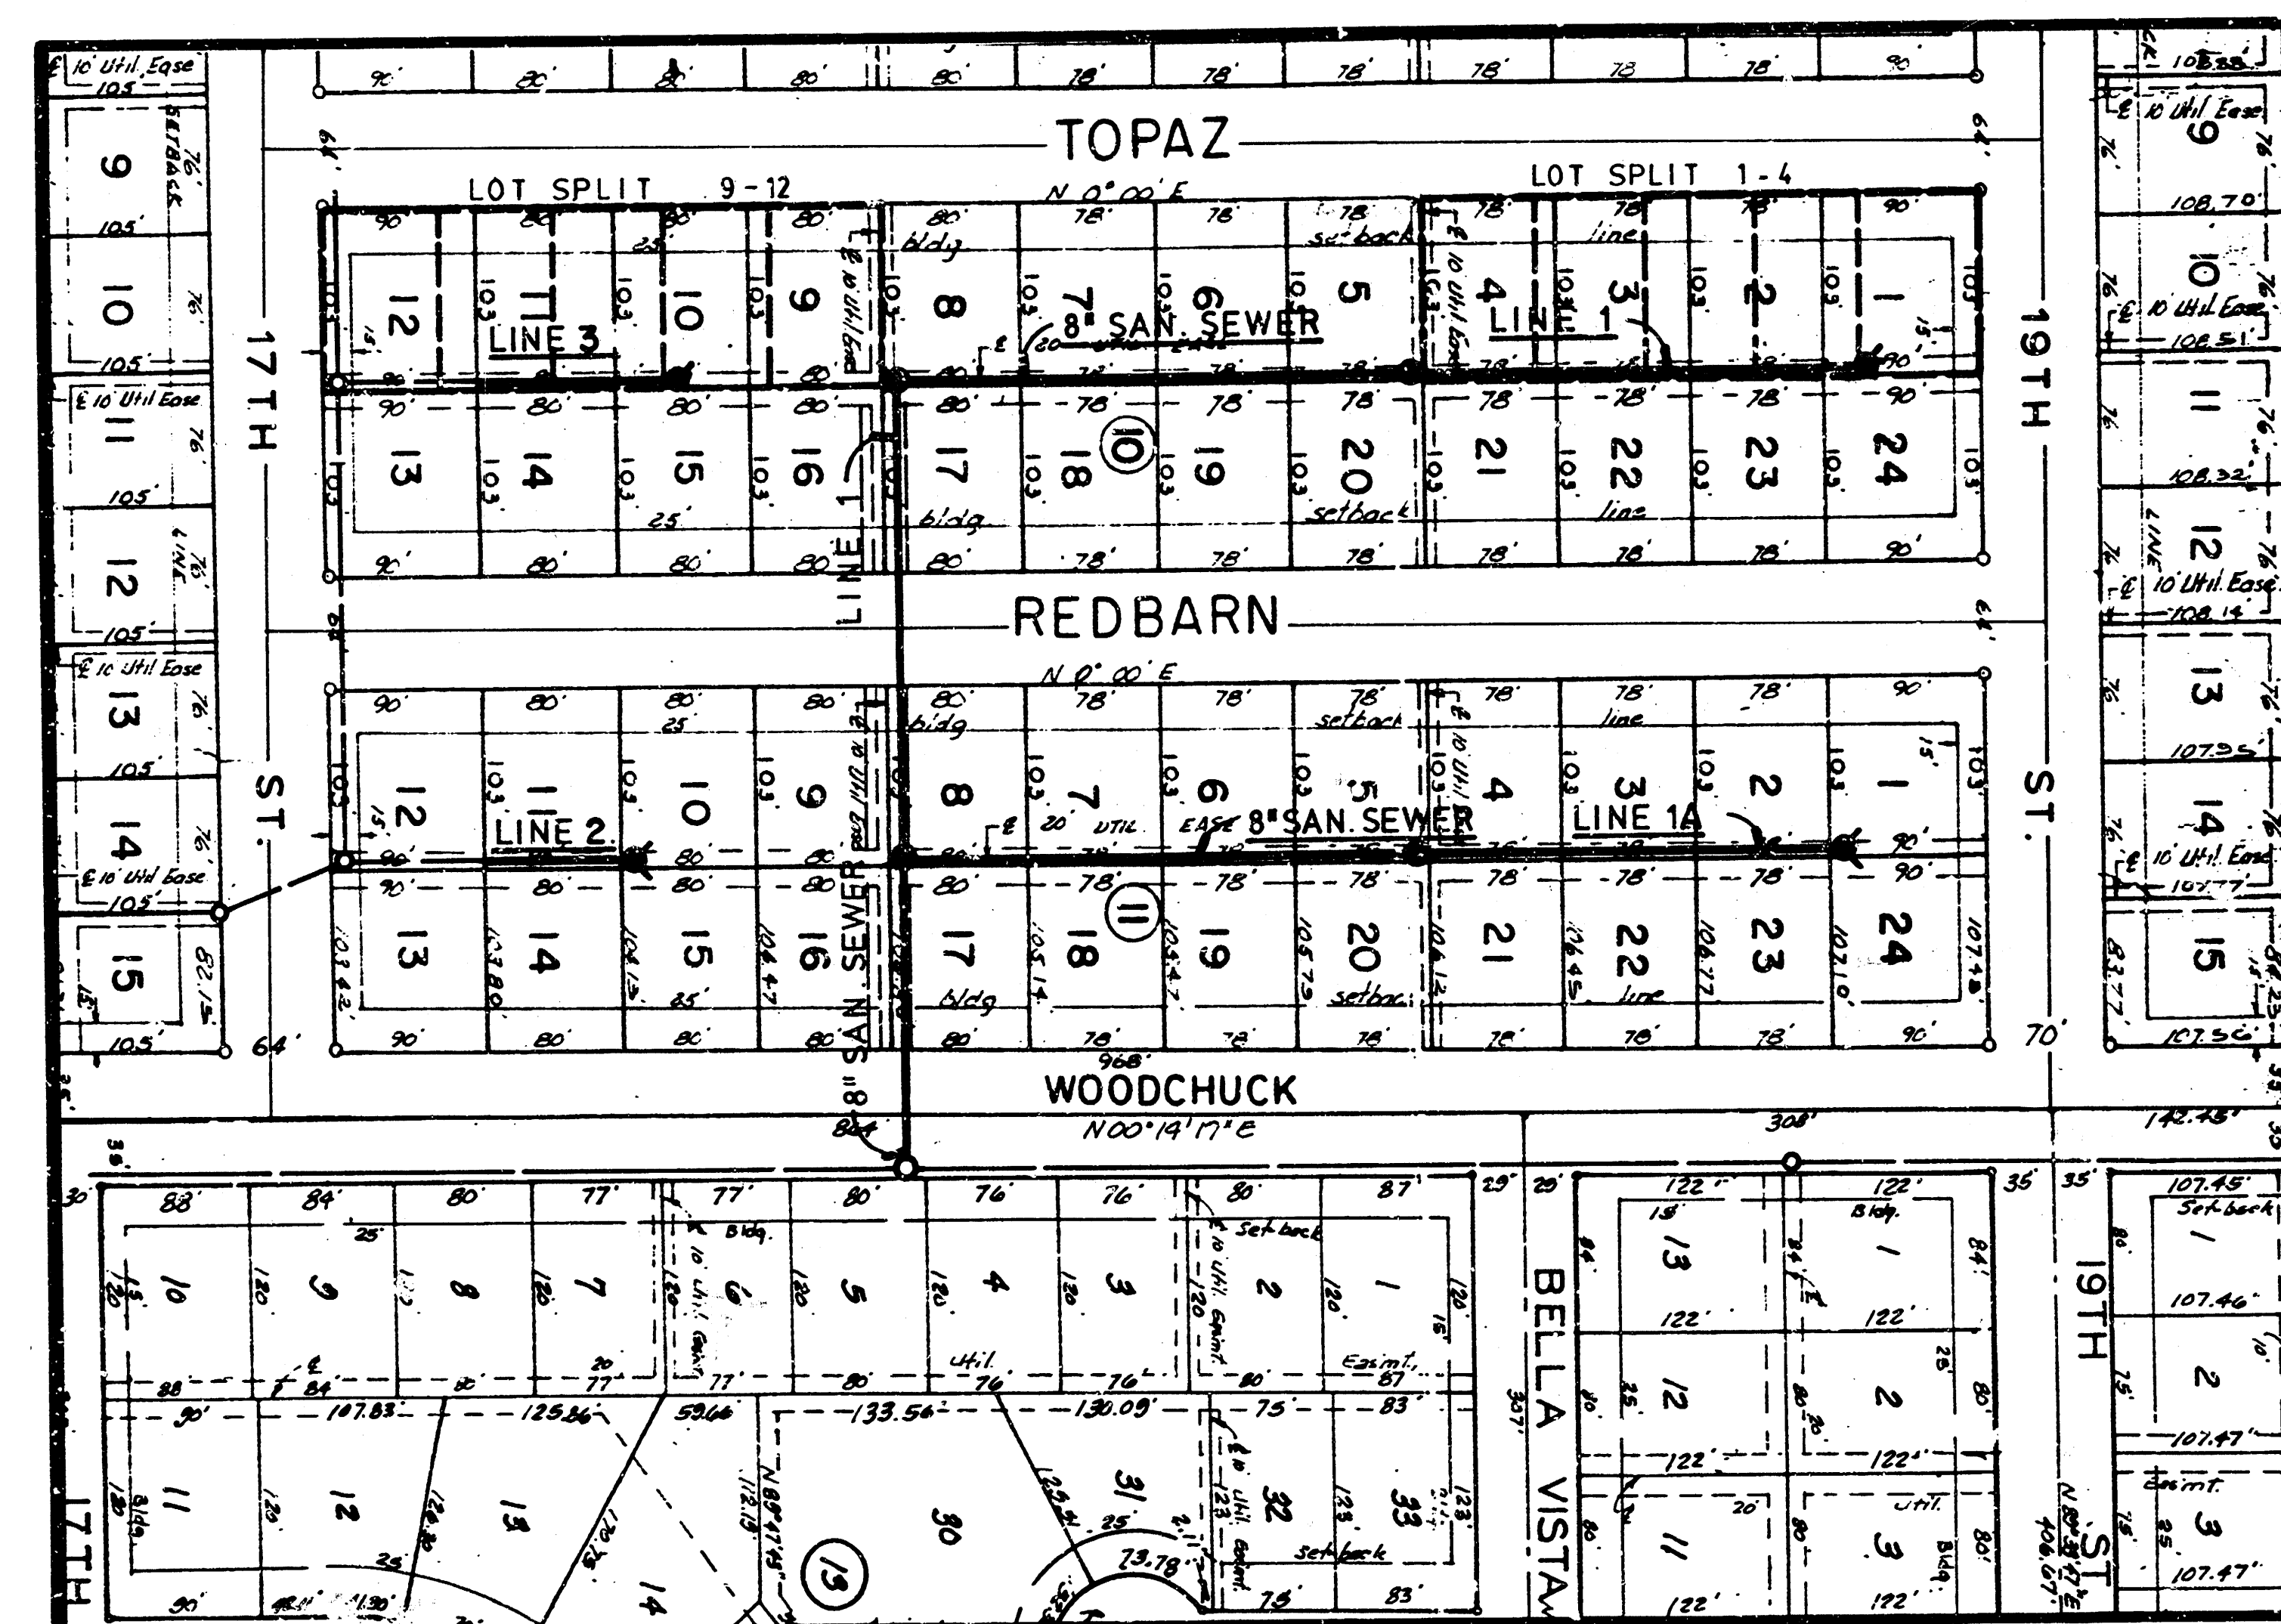


IMPROVEMENT DISTRICT ☐

CITY of WICHITA, KANSAS

MICHAEL E. LINDEBAK
CITY ENGINEER

INDEX of SHEETS



- Title Sheet
- Plan/Profile ~ Line 1
- Plan/Profile ~ Line 1A & 2
- Plan/Profile ~ Line 3

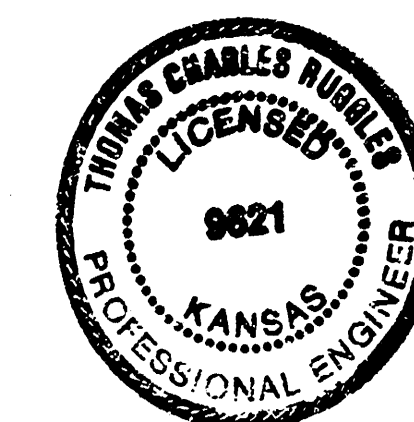

BOOKED
AS PER PLAN
RPL
9-88

TITLE SHEET			
BAUGHMAN COMPANY, P.A. SURVEYING & ENGINEERING 316/262-7271 • 315 ELLIS • WICHITA, KANSAS 67211			
Design: NBL/TCR	Drawn: SGL/jr	Approved: Apr. 88	Scale: as shown

- BENCHMARKS**
1. R.R. Spike in "Kino" (NE 1/4 side)
123 ft. Sp. 4' 7 1/2" N. of NE Cor.
Lot 15, Blk. 2, Westlink Village
Sixteenth Addition. Elev. = 157.75 City datum
 2. 10' Cut Top Curb (E. Return abutment)
311 ft. W. of NE Cor. Lot 15, Blk. 13,
Westlink Village Sixteenth Addition.
Elev. = 157.25 City datum

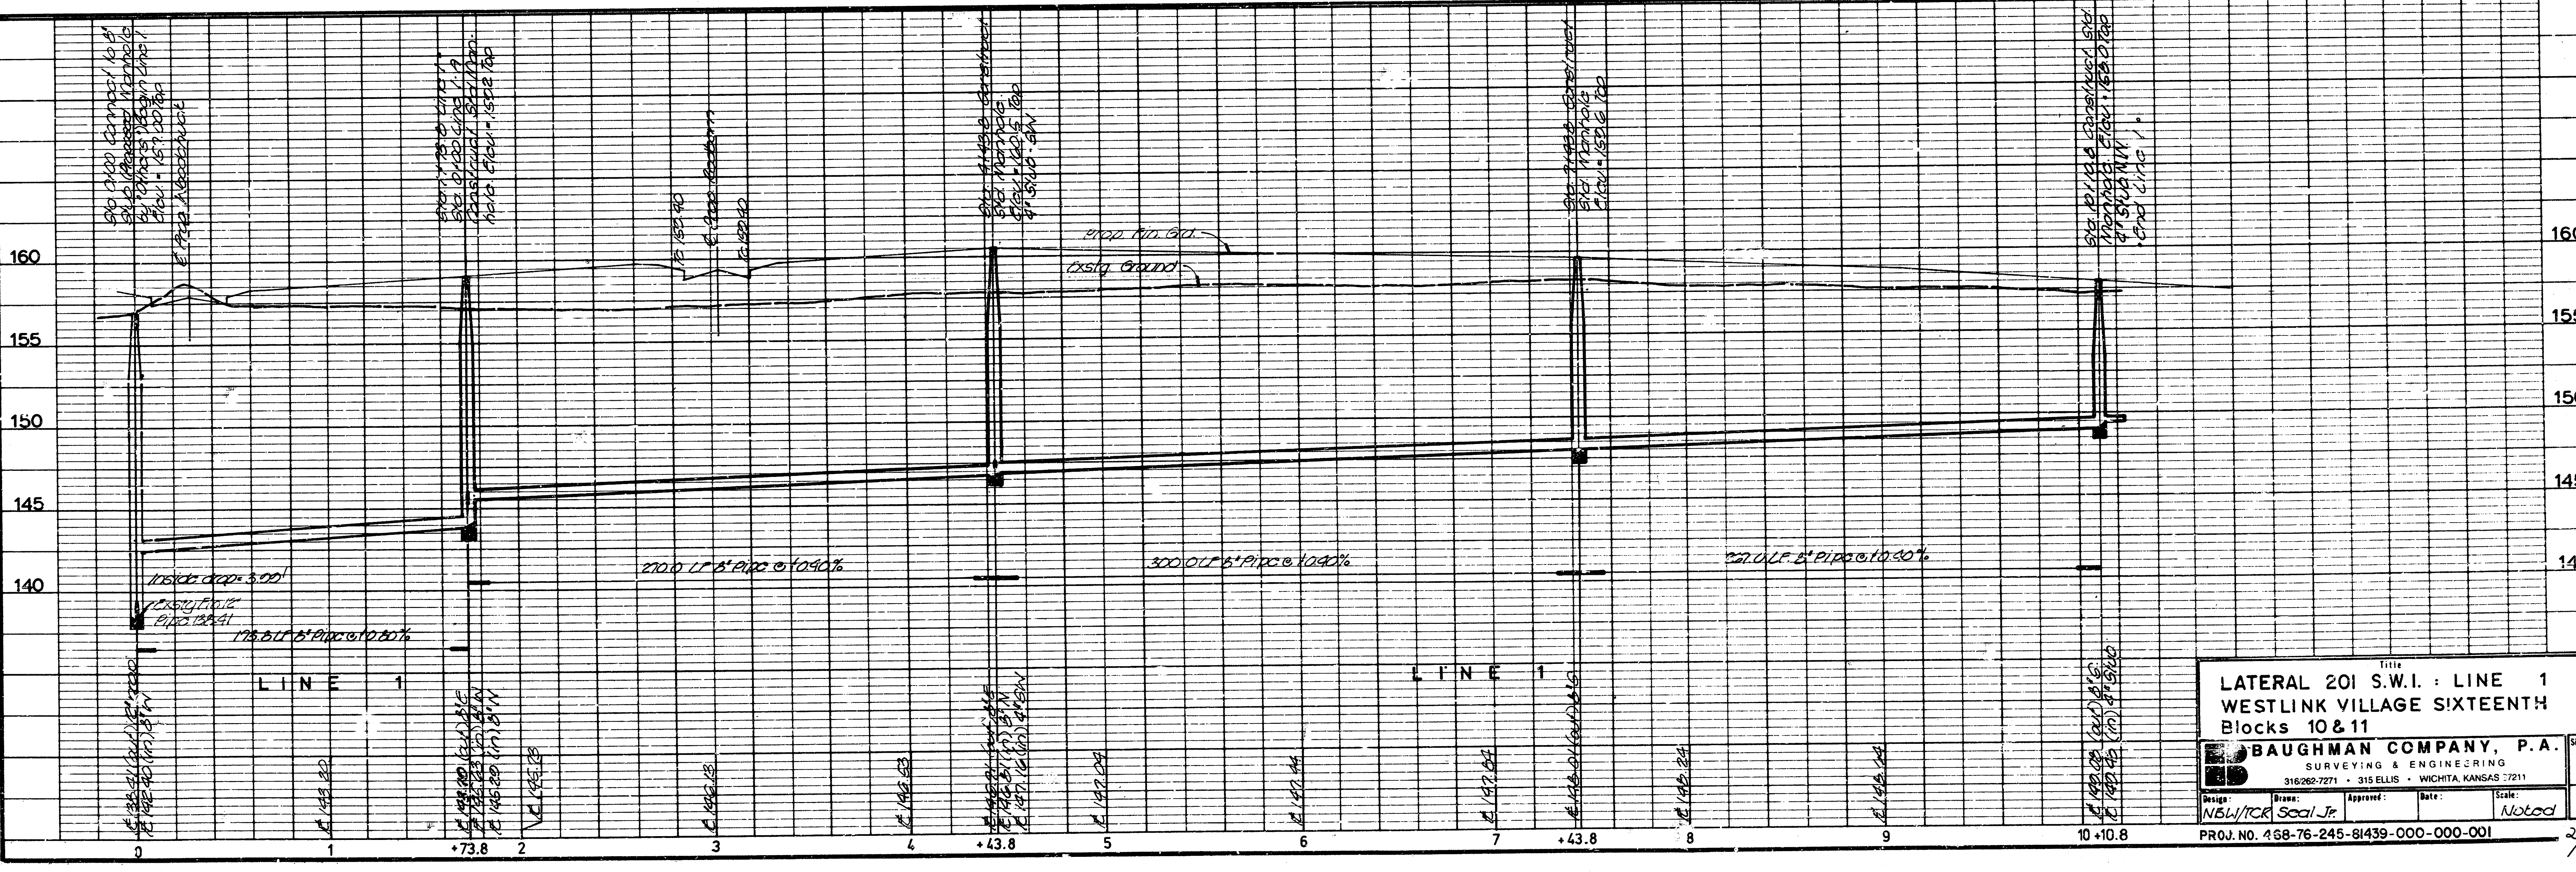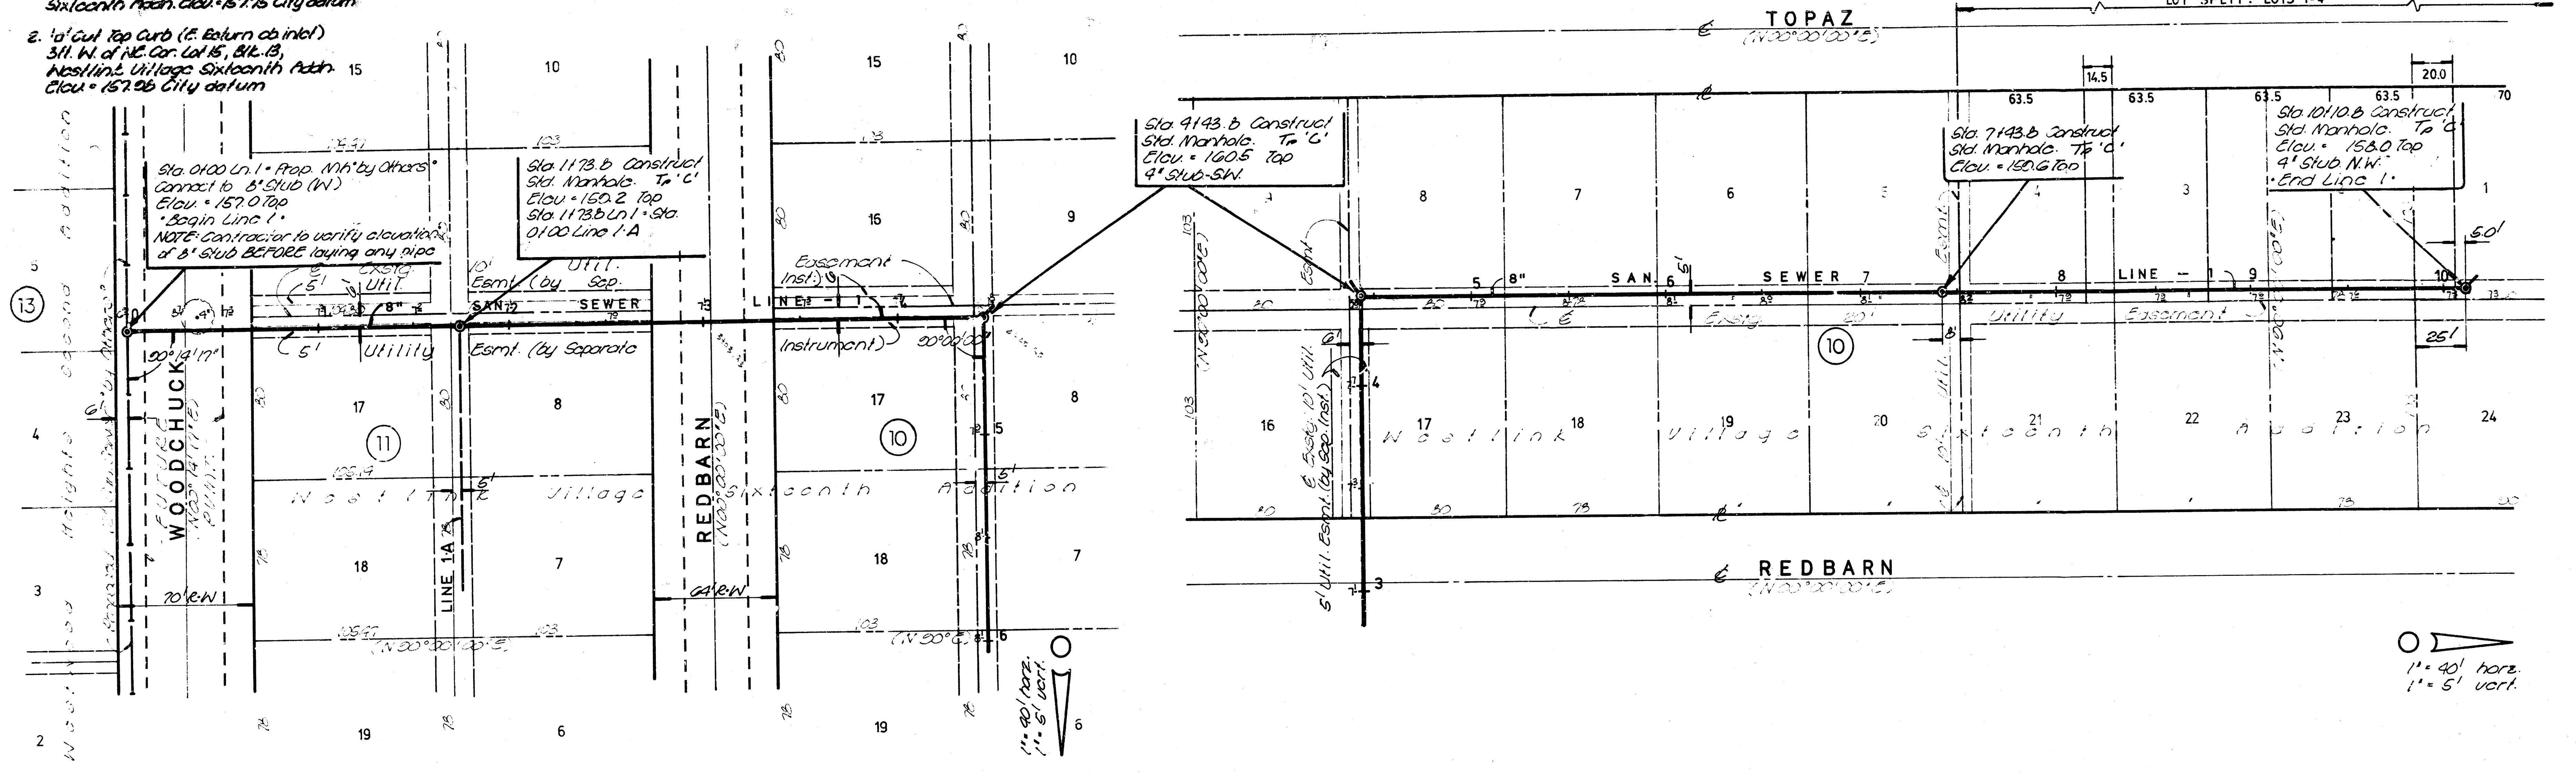

LATERAL 201 S.W. I. LINE 1
WESTLINK VILLAGE SIXTEENTH
Blocks 10 & 11




BAUGHMAN COMPANY, P.A.
 SURVEYING & ENGINEERING
 316/262-7271 • 315 ELLIS • WICHITA, KANSAS 67211

Design: **NSW/TCR** Scale: **1/4"**
 Approved: **Seal Jr.** Date: **Noted**


PROJ. NO. 468-76-245-81439-000-000-001

Sheet **2** of **4**

- BENCH MARKS**
1. R.R. spike in 'land' (NE 1/4 side)
123.11 S. & 47.11' N. of NE Cor.
Lot 15, Blk. 2, Westlink Village
Sixteenth Addition. Elev. = 157.75 City datum
 2. 'a' cut top curb (E. Return ab. int.)
341' W. of NE Cor. Lot 15, Blk. 13,
Westlink Village Sixteenth Addition
Elev. = 157.95 City datum

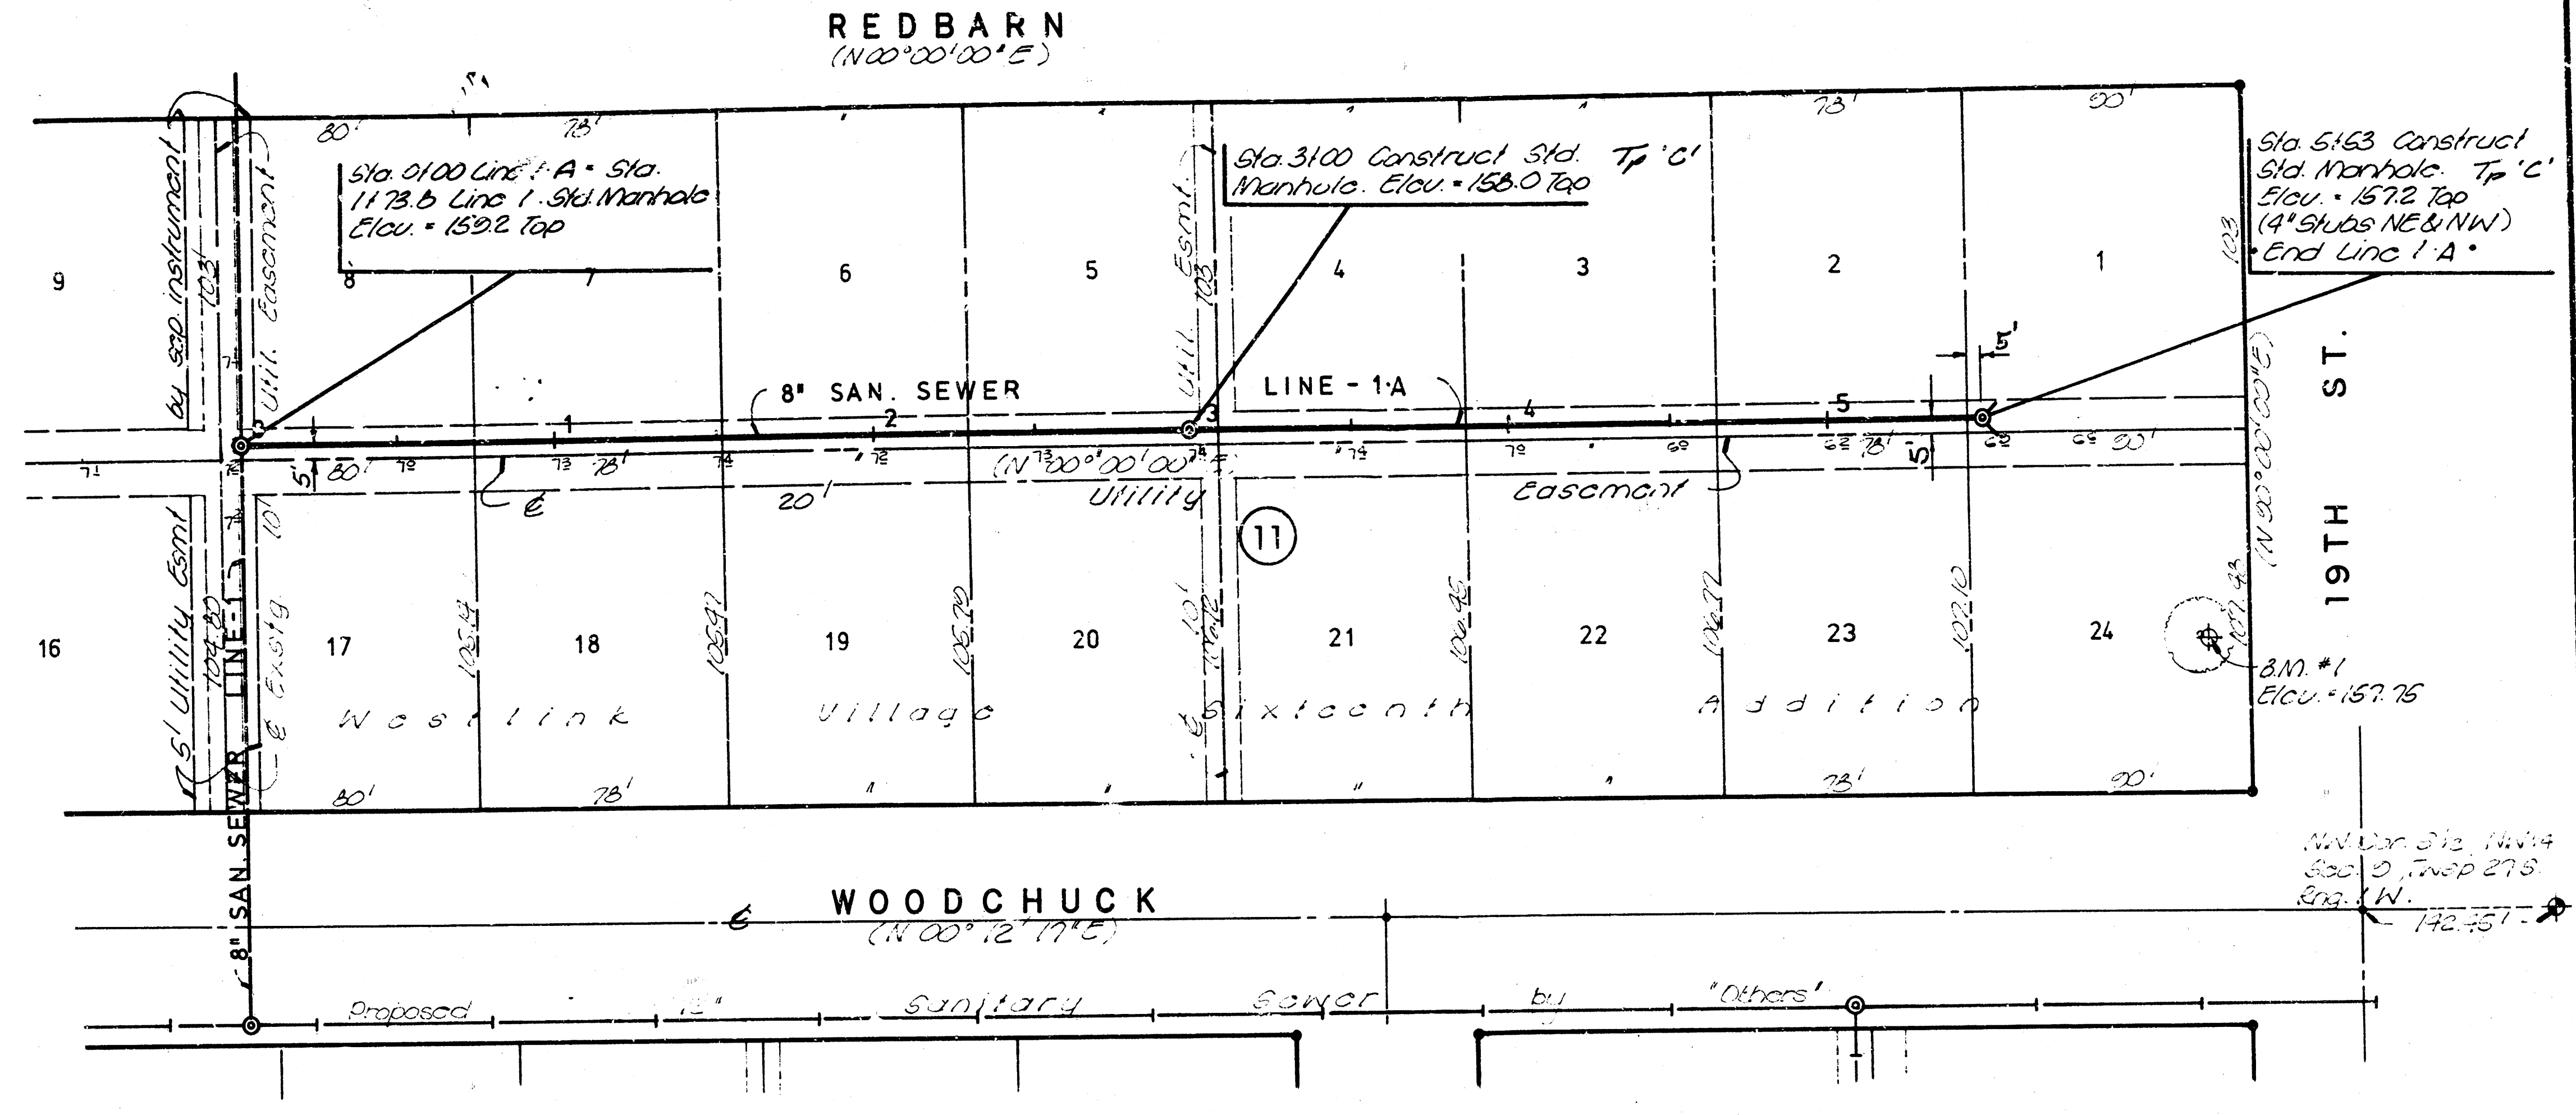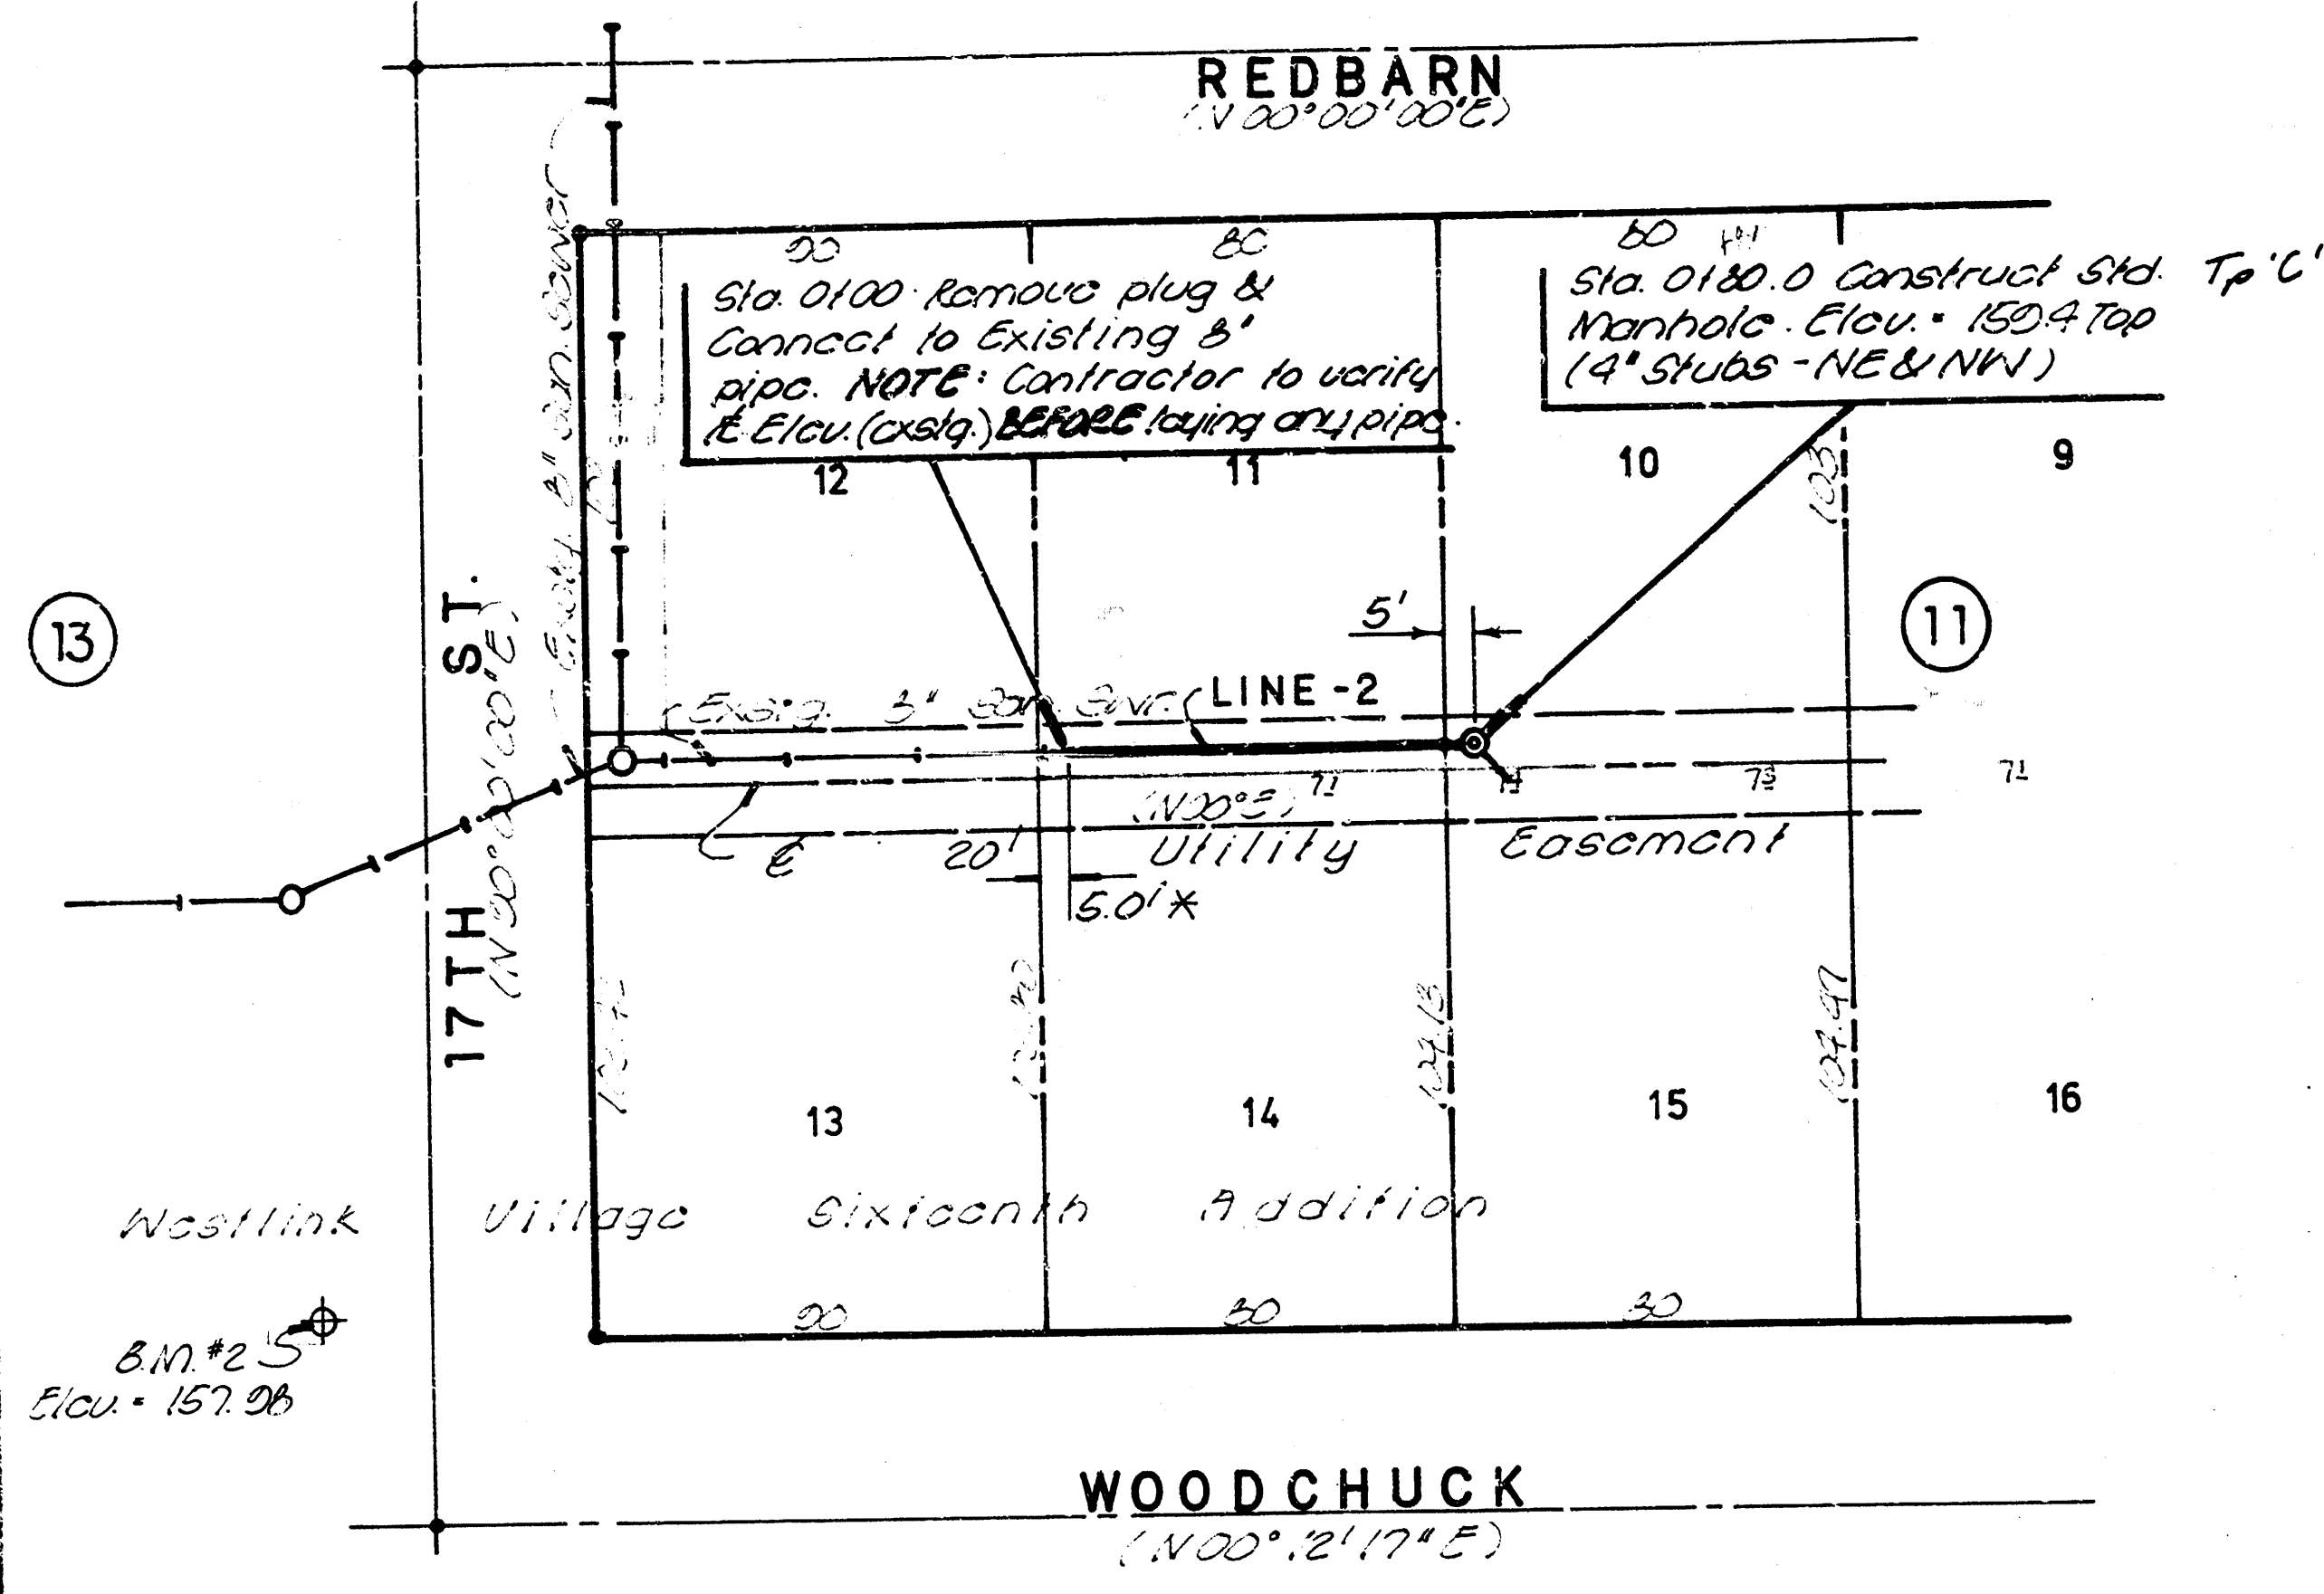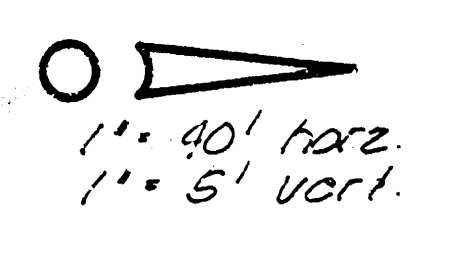

* 75 per const. plan. Lot 200, S.W. 1.
468.76 215.61433 000 000 001
(C & H)

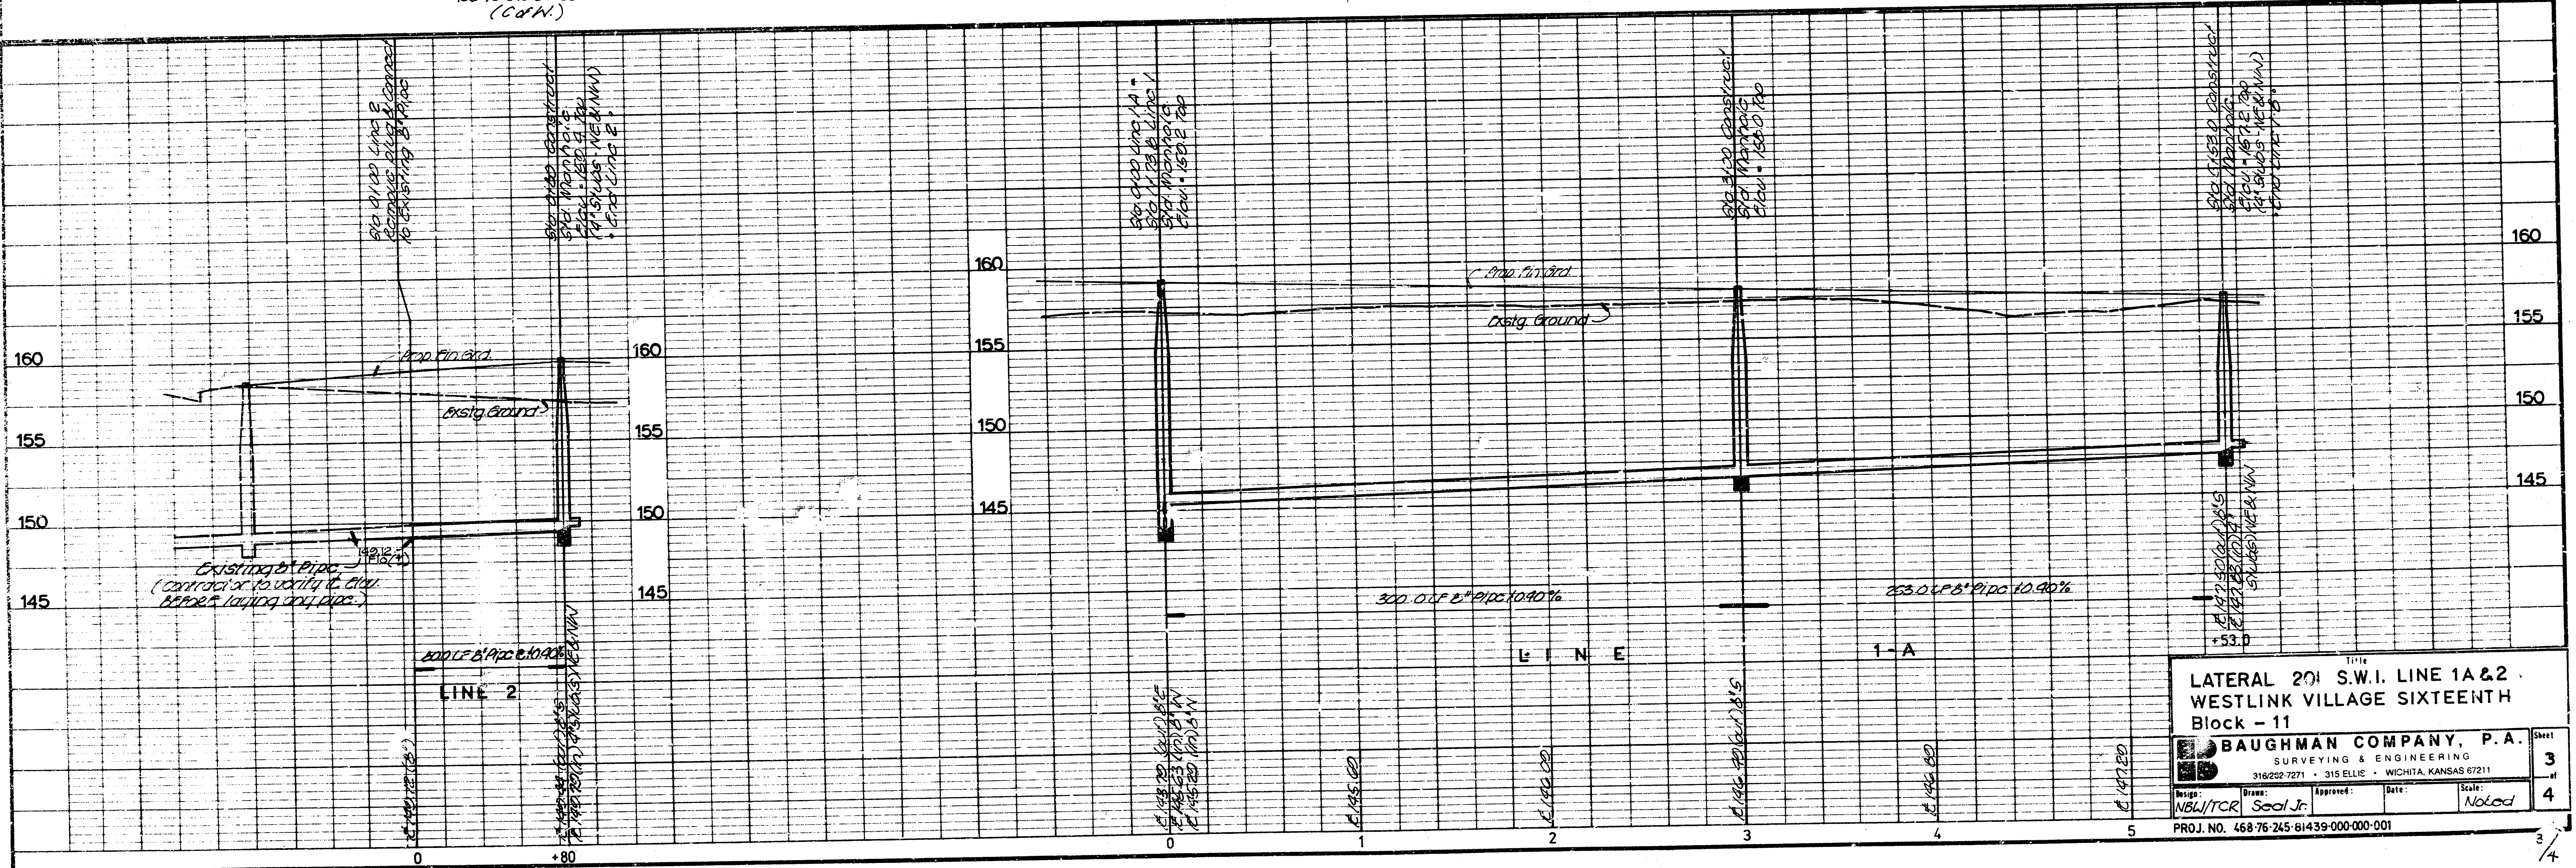

**LATERAL 20' S.W. 1. LINE 1A & 2
WESTLINK VILLAGE SIXTEENTH
Block - 11**


BAUGHMAN COMPANY, P.A.
SURVEYING & ENGINEERING
315 ELLIS • WICHITA, KANSAS 67211

Drawn: NBL/TGR
Scale: As Shown
Checked: [Signature]
Date: [Date]
Noted: [Signature]

PROJ. NO. 468.76 215.61433 000 000 001

Sheet 3 of 4

1. E.E. Spikes in 'kane' (kane (N.E.ly side)
193 ft. S. & 49 ft. N. of N.E. Cor.
Lot 15, Blk. 2, Westlink Village
Sixteenth Addr. Elev.: 157.75 City datum
2. 'a' Cul Top Curb (E. Return ab. int'l)
3 ft. N. of N.E. Cor. Lot 15, Blk. 13,
Westlink Village Sixteenth Addr.
Elev.: 157.96 City datum

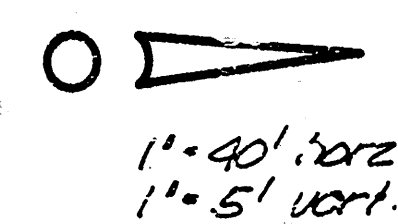

BAUGHMAN COMPANY, P.A.
SURVEYING & ENGINEERING

Design:	Drawn:	Approved:	Date:	Scale:
NBLWTCR	Seal Jr			Noted

PROJ. NO. 468-76-245-81439-000-000-001

1 2 3 4