


CITY OF WICHITA, KANSAS
SANITARY SEWER EXTENSION
TO SERVE
LOTS 1 THROUGH 4 INCLUSIVE AND LOTS 9 THROUGH 12 INCLUSIVE
BLOCK D, WESTRIDGE VILLAGE ADDITION
LATERAL 280, SOUTHWEST INTERCEPTOR
PROJECT NO.: 468-76-245-81933-000-000-001

INDEX #: 607663

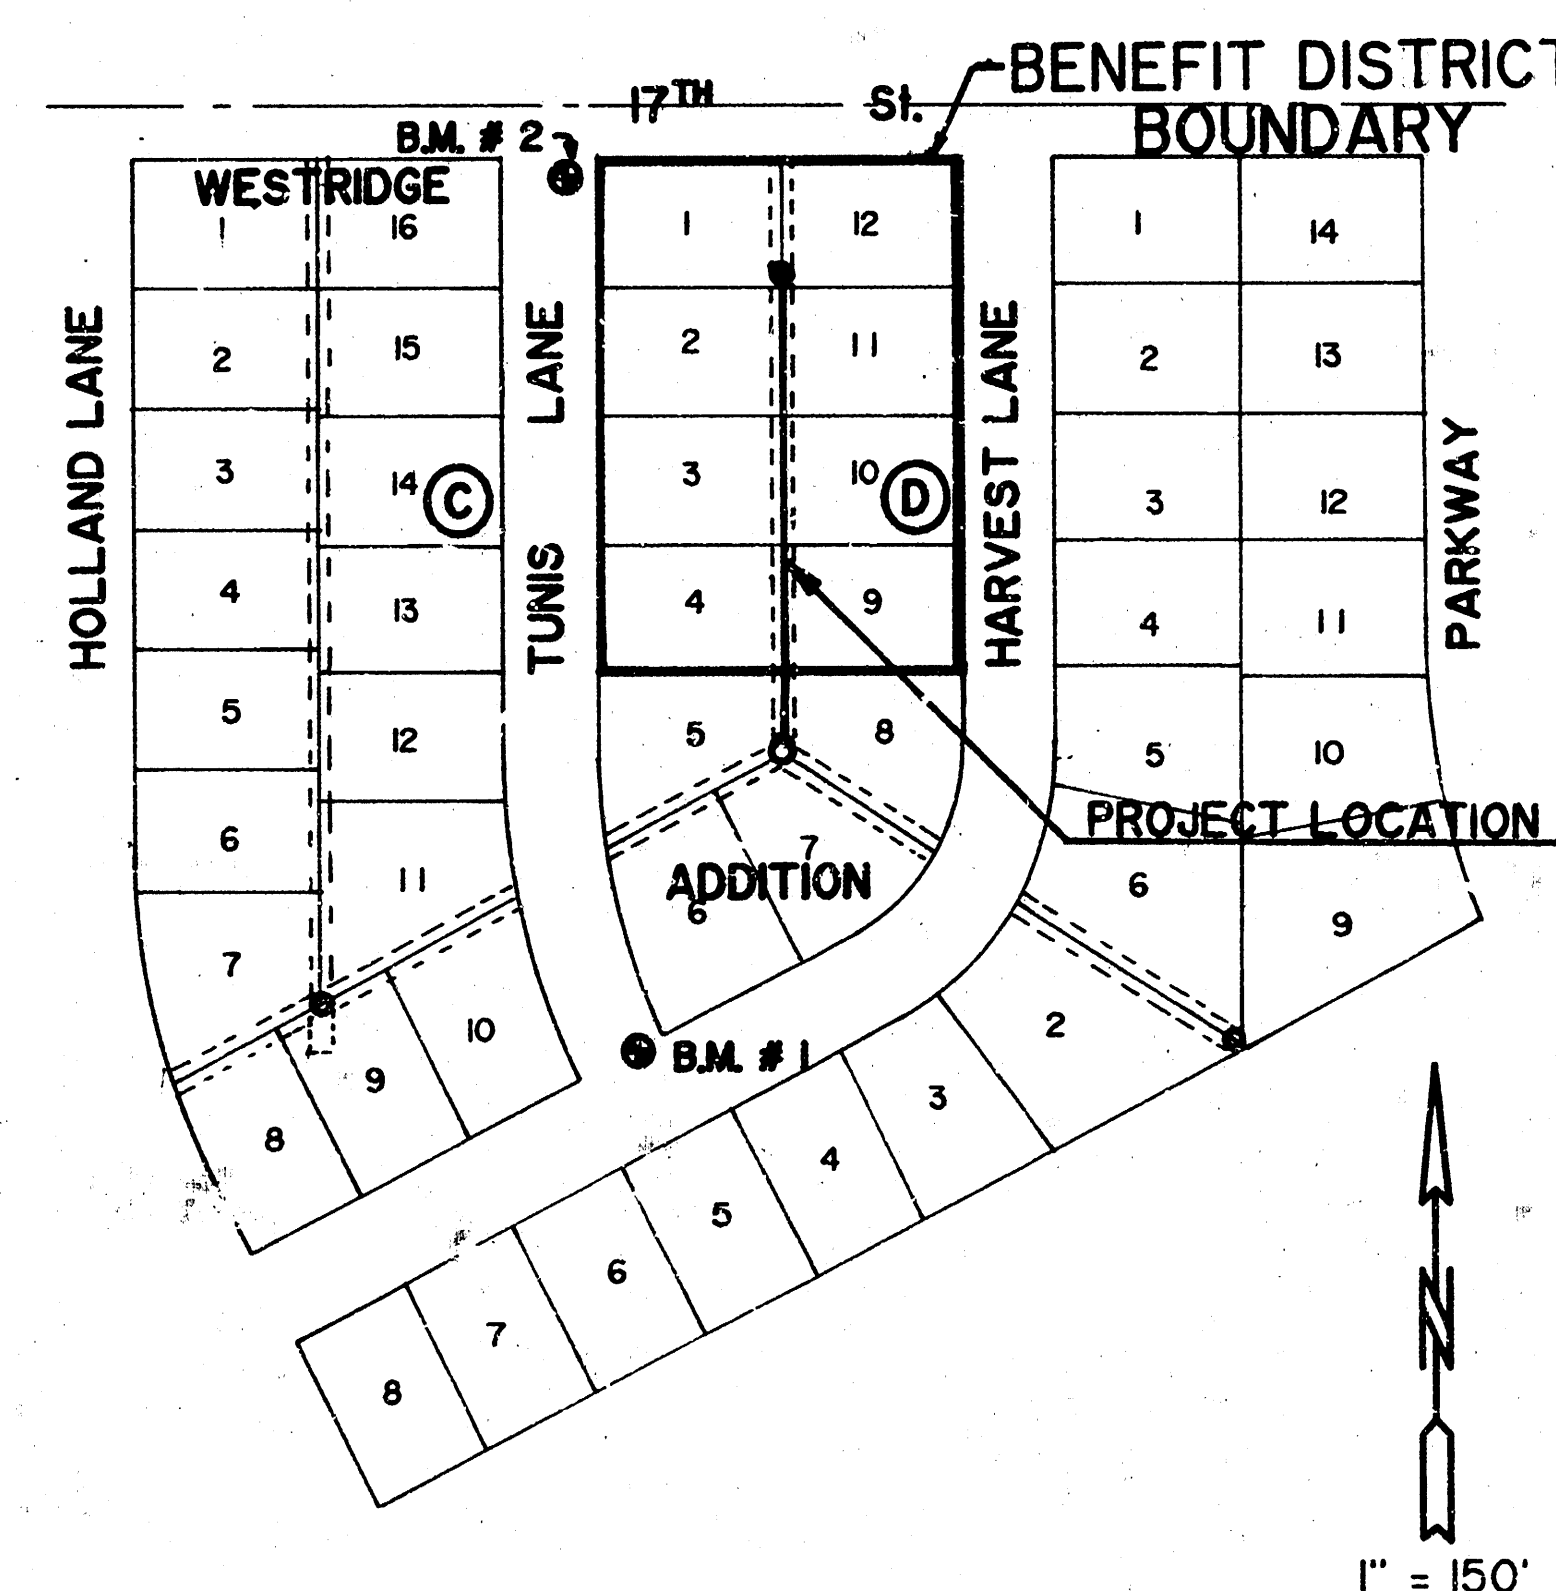

LOCATION MAP


MICHAEL E. LINDEBAK, P.E., CITY ENGINEER

INDEX :

SHEET 1 OF 2 TITLE
SHEET 2 OF 2 PLAN & PROFILE


GENERAL NOTES :

1. The Contractor shall be responsible for preserving property irons. The Contractor will be required to re-establish any property irons which are damaged or destroyed by his construction operations. Such irons shall be re-established by a licensed land surveyor or a licensed professional engineer in accordance with state laws.
2. All construction shall be in accordance with City of Wichita, Kansas Standard Specifications for Sanitary Sewers.
3. Bench Marks :
1 - "d" Cut on end return east side of Tunis Lane
NEC intersection of Tunis & Harvest Lane.
ELEV. = 156.87
2 - "d" Cut on end return east side of Tunis Lane
SEC intersection of Tunis & 17TH Street.
ELEV. = 156.76

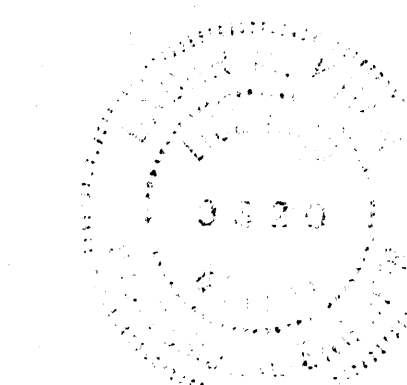


*BUILT PER PLAN
RCL
5-89*

SCALE: AS SHOWN		APPROVED BY:		DRAWN BY: M.W.	
DATE: 2 - 89		REVISOR		REVISION	
MUNICIPAL ENGINEERS Civil Engineers & Land Surveyors 264 Laura, Suite 301 Wichita, Kansas 67211				DRAWING NUMBER	
				1/2	

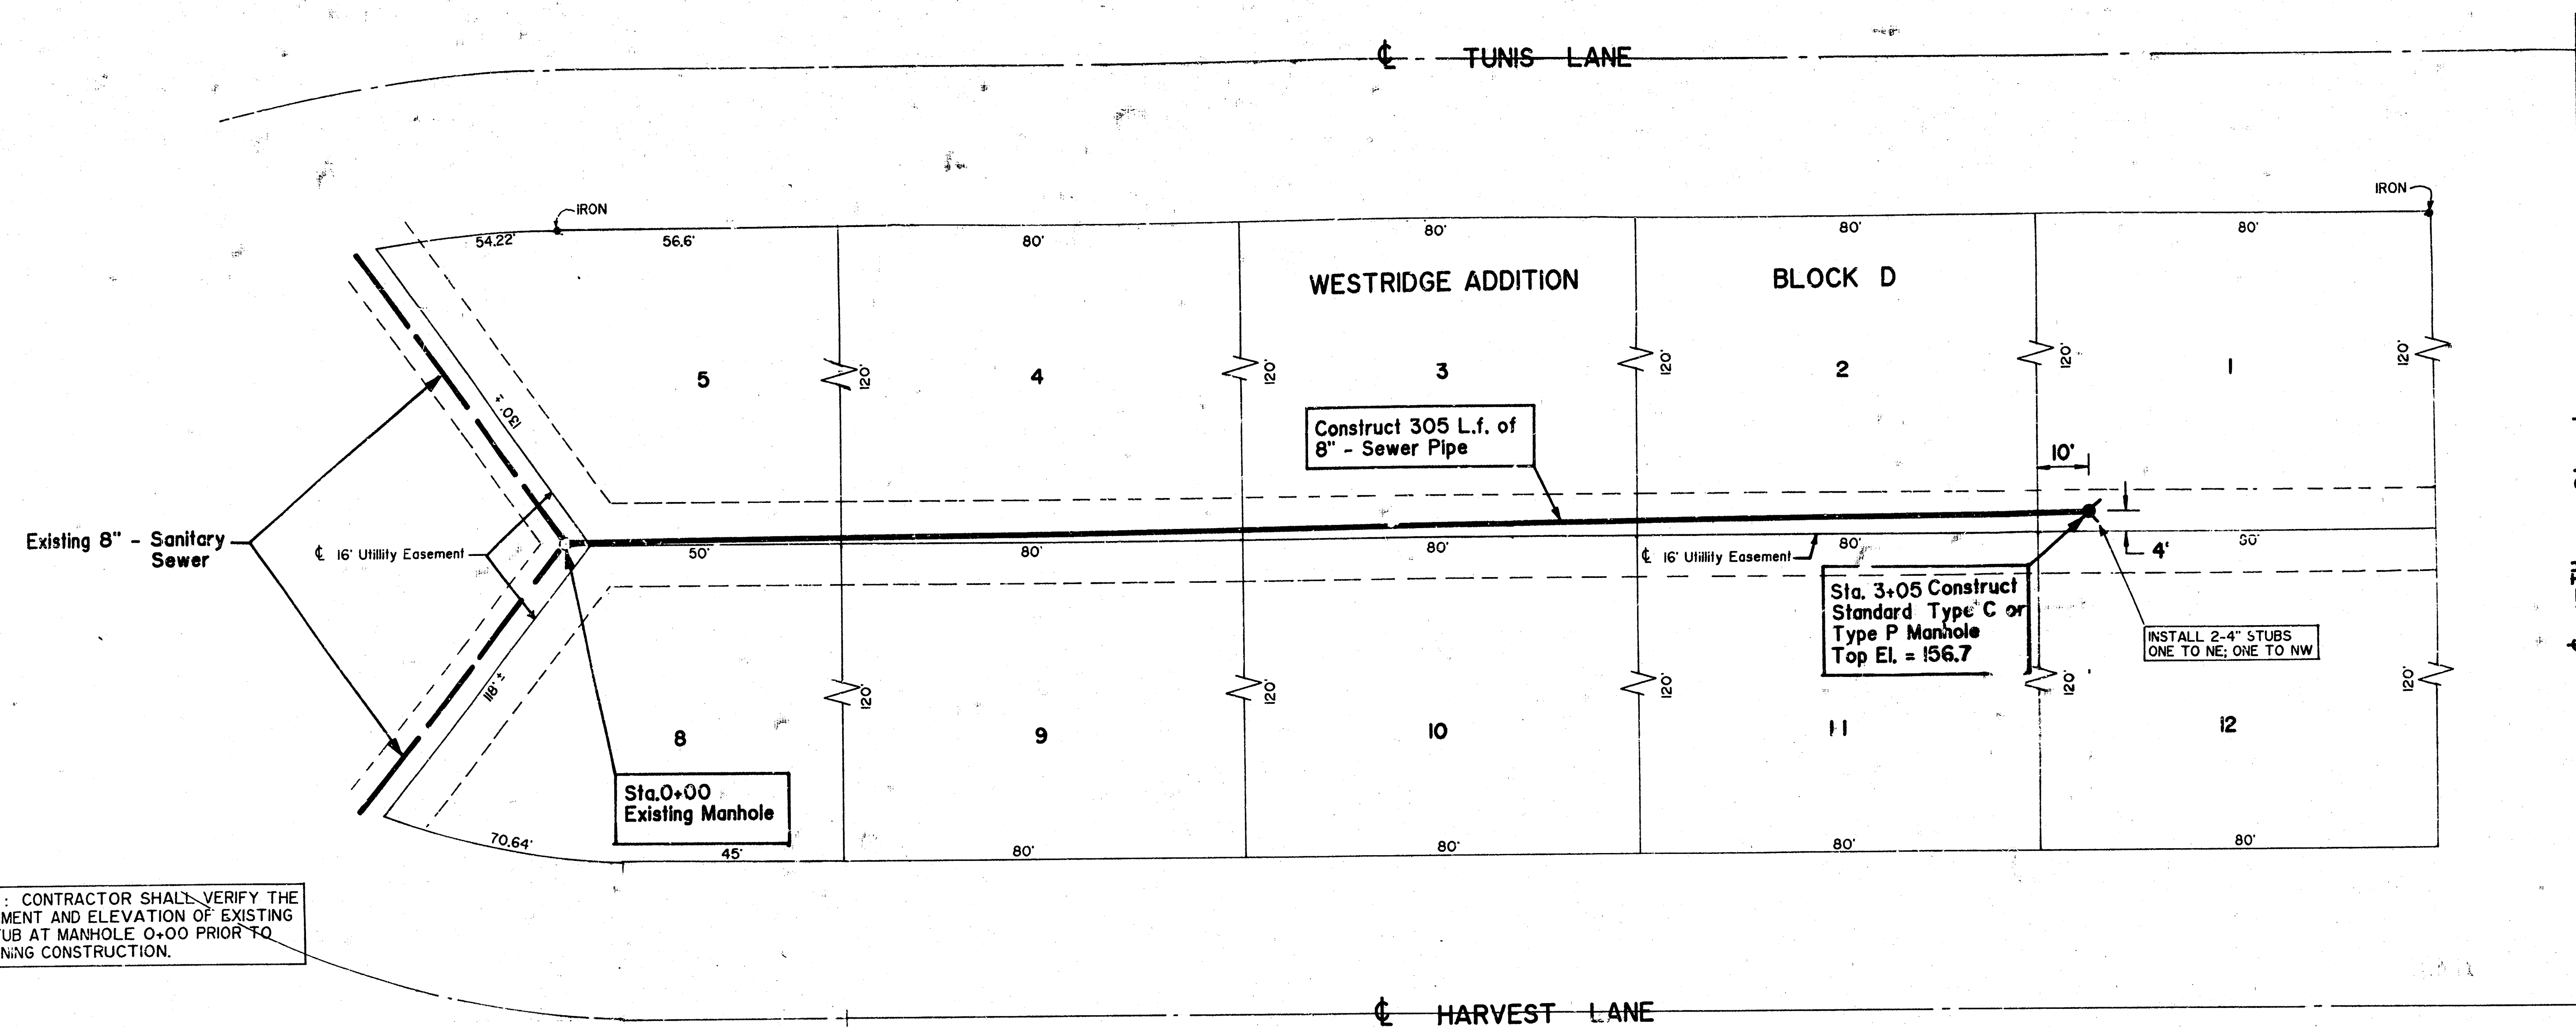

NOTE: CONTRACTOR SHALL VERIFY THE ALIGNMENT AND ELEVATION OF EXISTING 8" STUB AT MANHOLE 0+00 PRIOR TO BEGINNING CONSTRUCTION.

SCALE: PLAN - 1" = 20'
PROFILE - 1" = 20' (H)
1" = 5' (V)

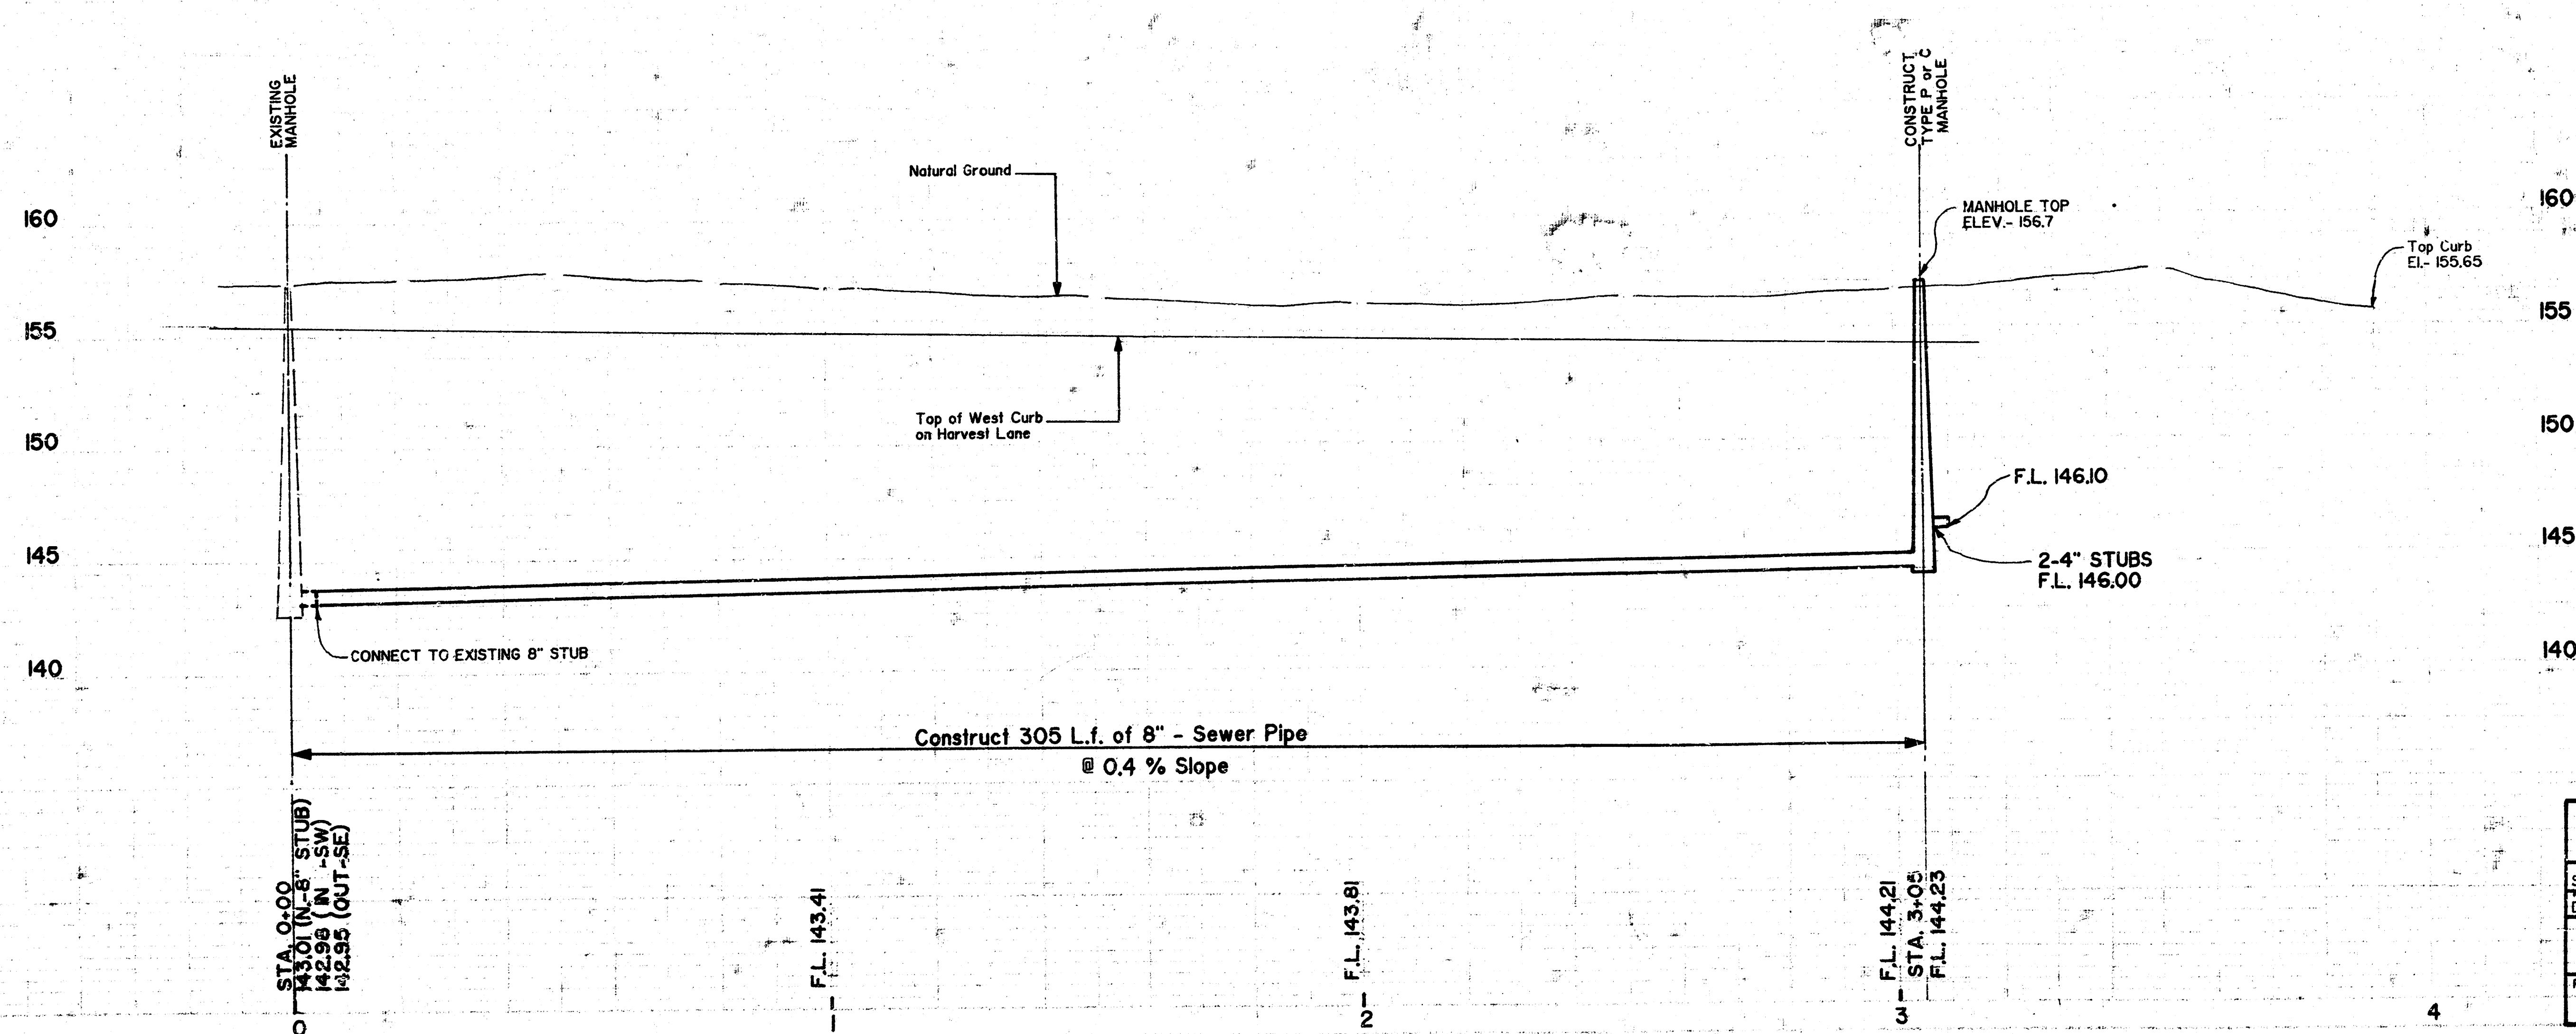

MUNICIPAL ENGINEERS
Civil Engineers & Land Surveyors
264 Laura, Suite 301
Wichita, Kansas 67211

PLAN & PROFILE SHEET			
SCALE: AS SHOWN	APPROVED BY: B.K.	DRAWN BY: M.W.	
DATE: 2-89		REVISED:	
LATERAL 280, S.W. INTERCEPTOR WESTRIDGE VILLAGE BLK D			
PROJECT NUMBER: 468-76-245-89333-000-000-001	DRAWING NUMBER: 2 of 2		

14 10 4 5