

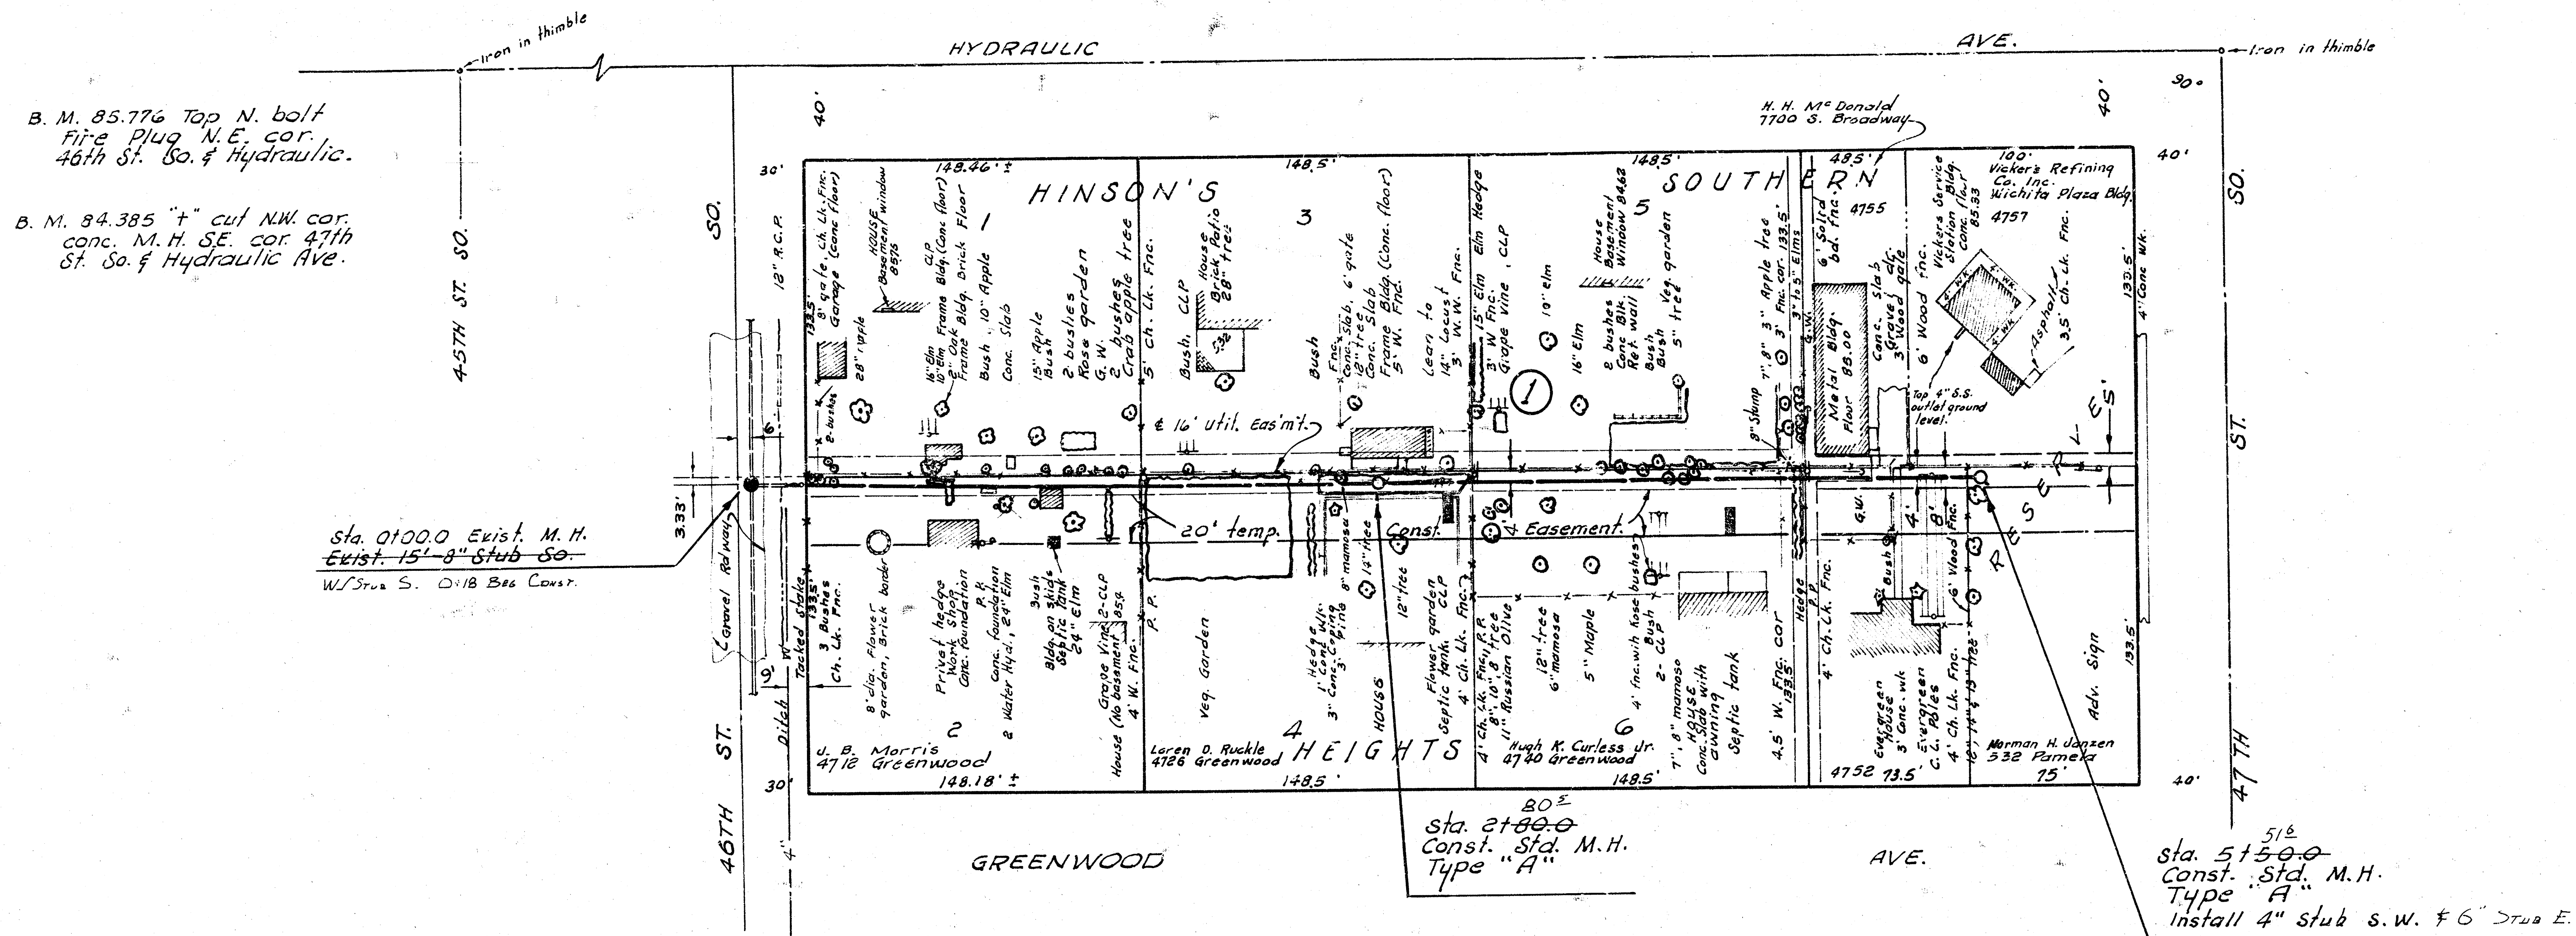


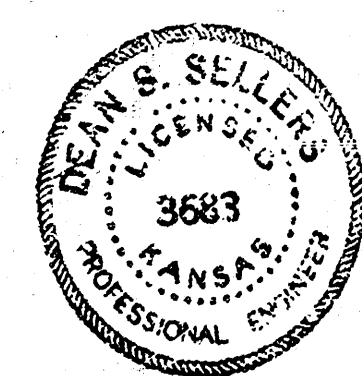

Plan Scale 1" = 40' Horiz.
Profile Scale 1" = 5' Vert.

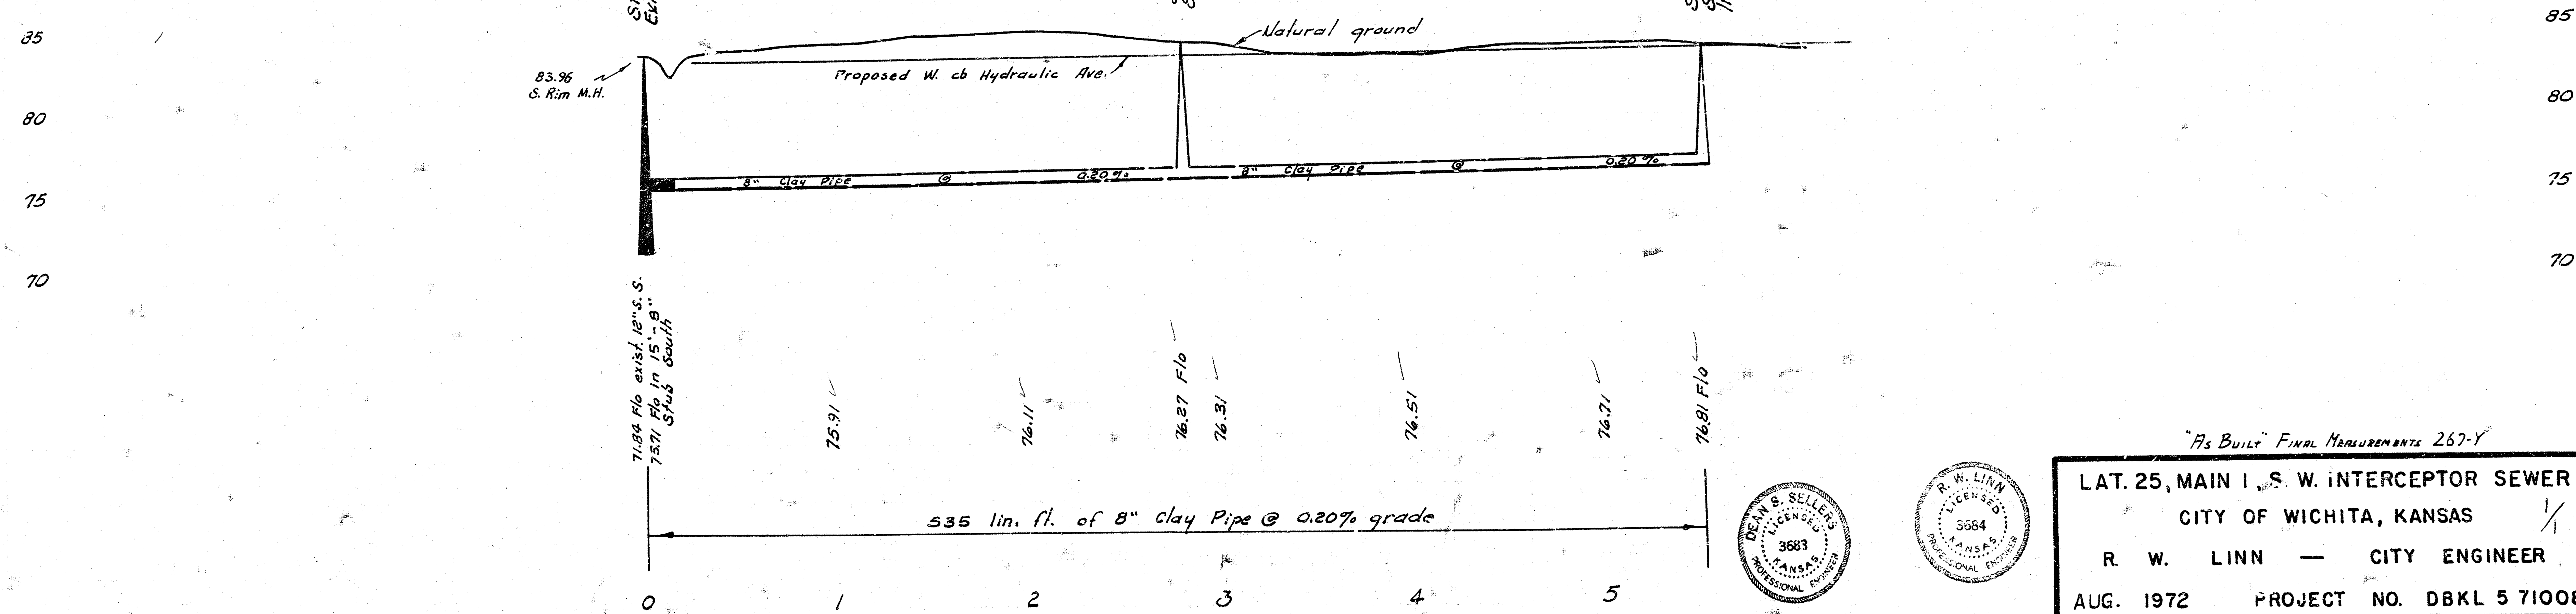

FILMED FROM THE BEST AVAILABLE COPY