

B.M. 85.92 head of 47st
boil "life" hydrant S.W.
cor. A to & Hydraulic.

NOTE: SOUTH RIVERSIDE BAPTIST
CHURCH WANTS THE SEWER
COMPLETED ON THEIR PROPERTY
BETWEEN MONDAY AND FRIDAY
SO THEY CAN USE THE PARKING
ON SUNDAY.

NOTE: START PROJECT AT
EXISTING M.H. - NEW FLO. IN
ELE 75.00


NOTE: CONTRACTOR TO REPLACE ALL PERMITS THAT
ARE REMOVED TO FACILITATE CONSTRUCTION OF THE
SEWER. PERMITS TO BE REPLACED IN A CONDITION
EQUAL TO OR BETTER THAN ORIGINAL.

NOTE: WATER WELL LOCATED ON LOT 14 IS TO BE
PROTECTED DURING CONSTRUCTION OF SEWER TO
PREVENT ANY DAMAGE.


NOTE:
Plug opening in
manhole with
brick and mortar
plug.
GRADE ELEV'S
RAISED 1" BY
CITY ENGR.

LAT. 28, MAIN 1, S. W. INTERCEPTOR SEWER
CITY OF WICHITA, KANSAS
R. W. LINN - CITY ENGINEER
197+ PROJECT NO. DBKL 571033

B. M. 86.195 60 penny nail N-force R.P.
W. L. Ellis 190° N. of & Alia.

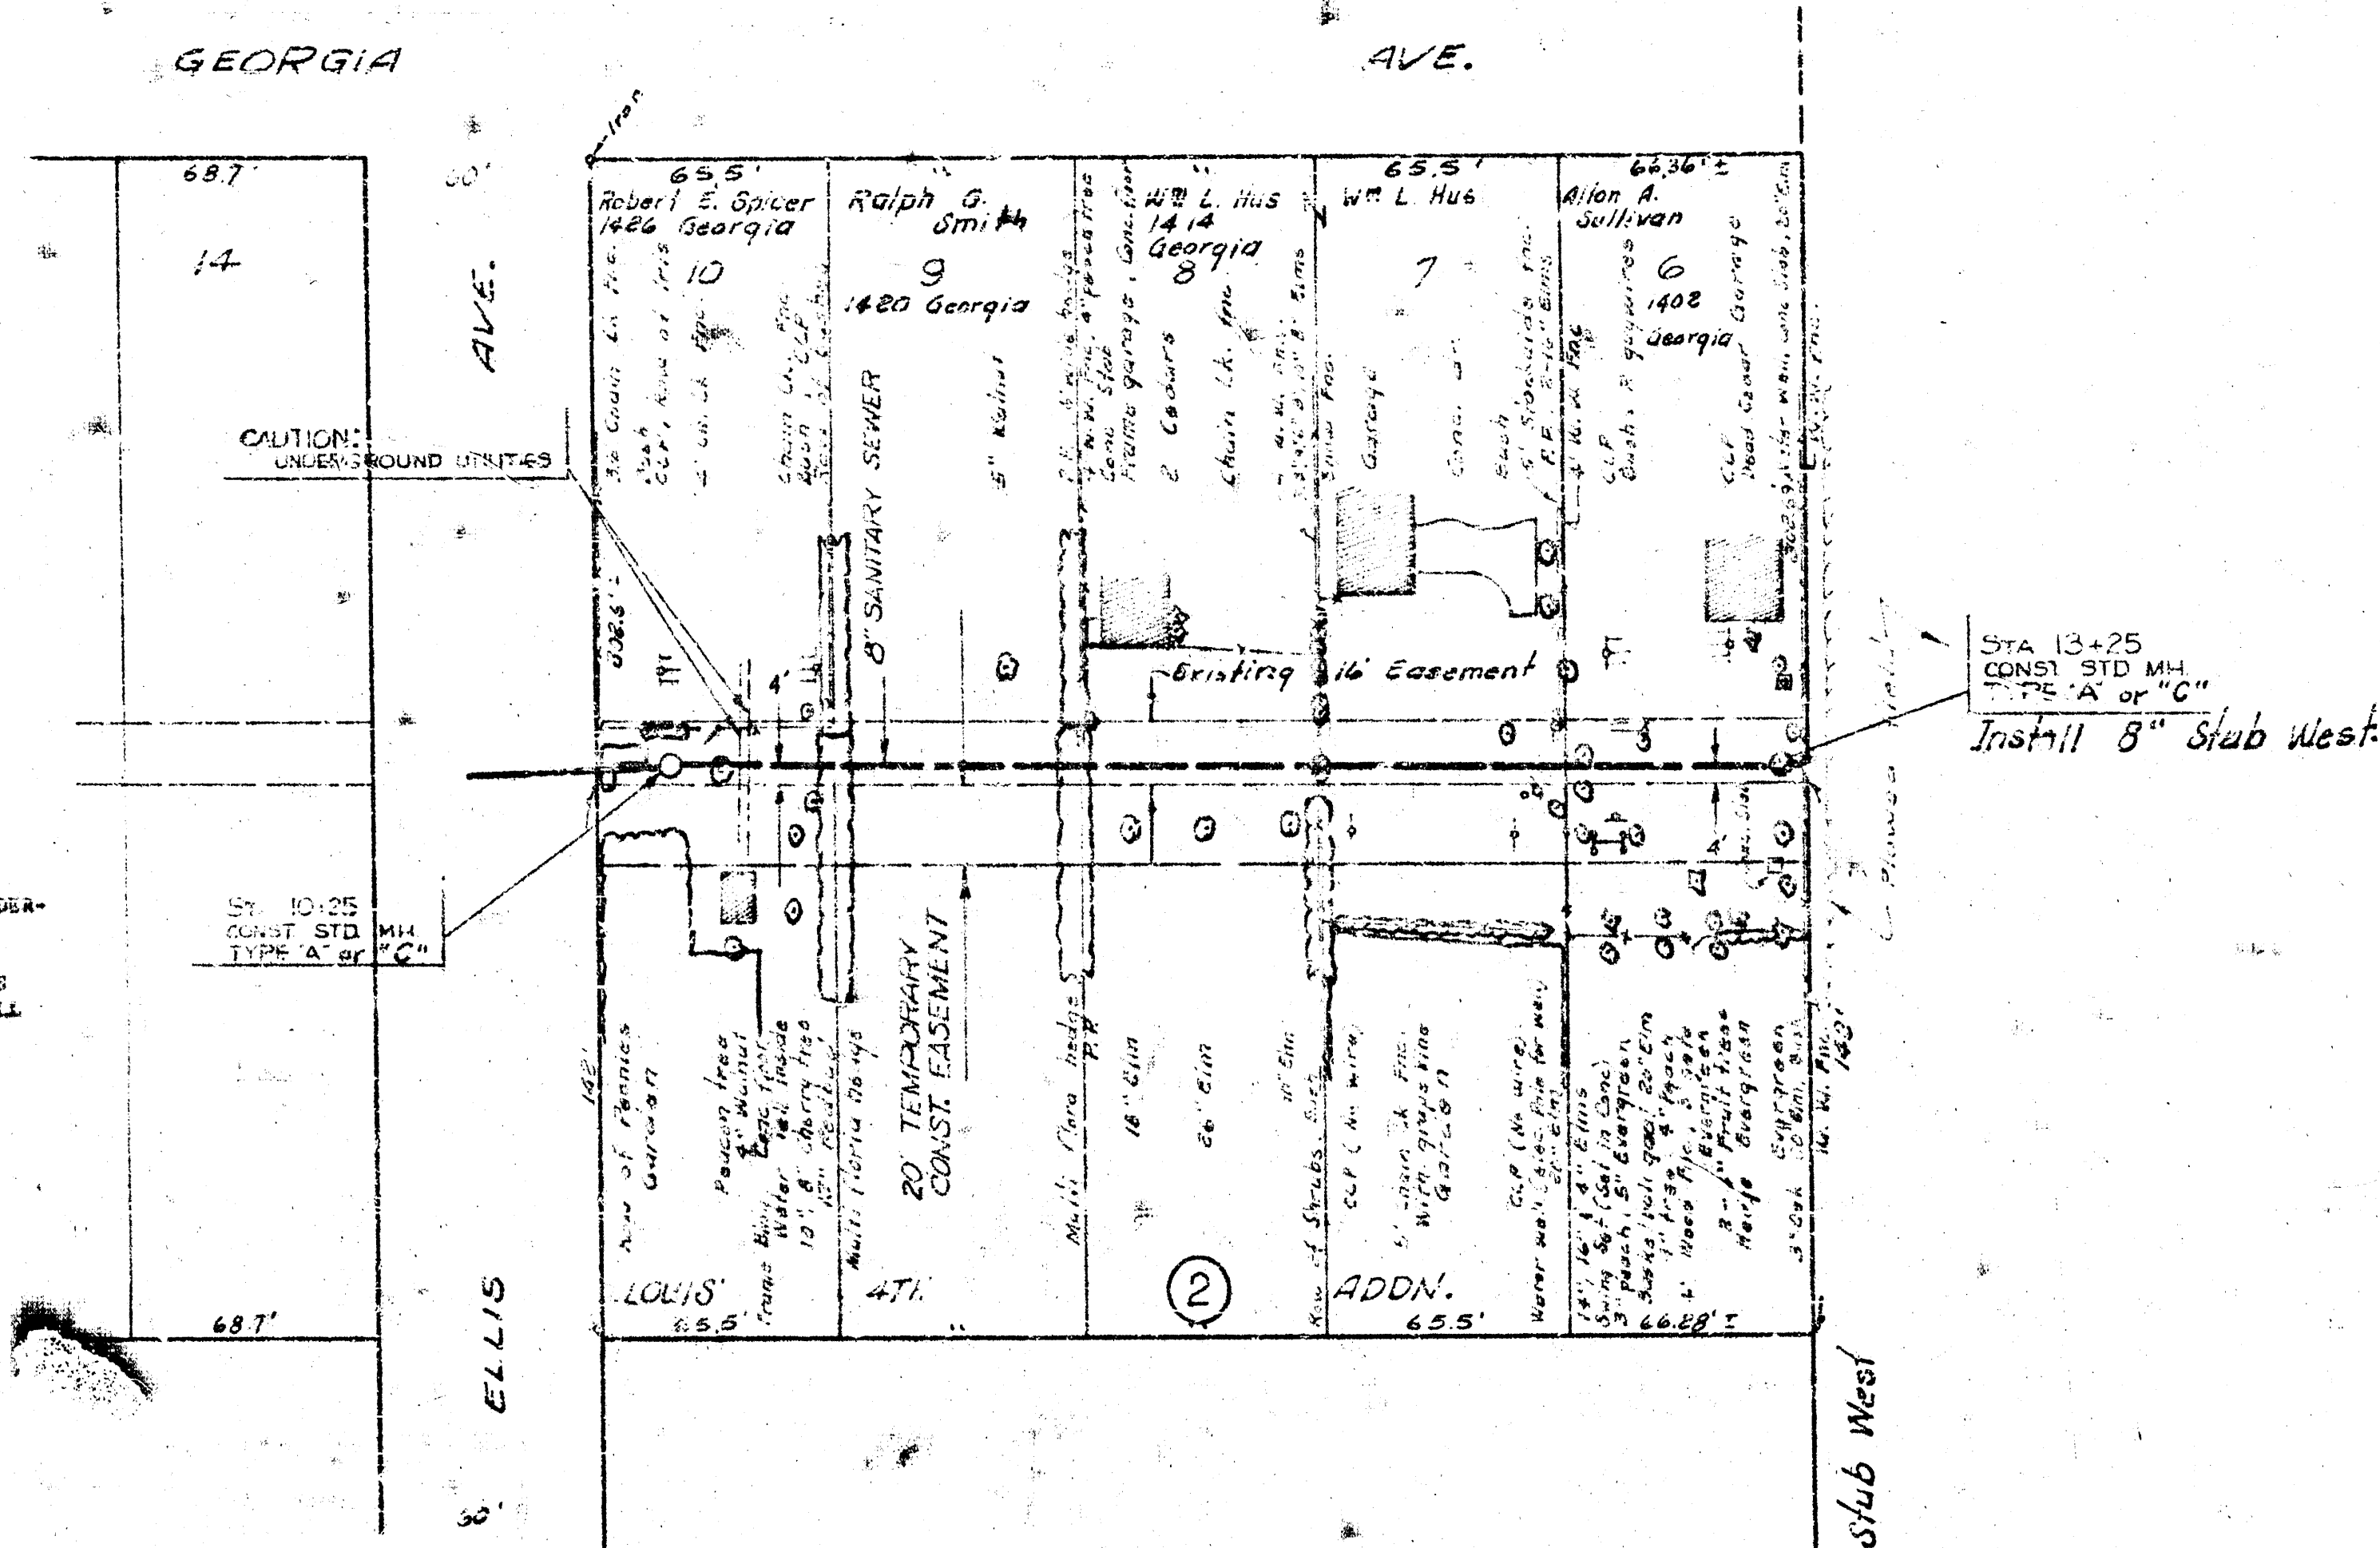

NOTE: CONTRACTOR TO REMOVE AND REPLACE UNDERGROUND WATER LINE AND ELECTRIC LINE AT APPROXIMATELY STA. 10+45 AS NECESSARY TO FACILITATE CONSTRUCTION OF THE SEWER. THIS WORK WILL NOT BE PAID FOR DIRECTLY AND SHALL BE CONSIDERED AS SUBSIDIARY TO THE OTHER ITEMS OF WORK.

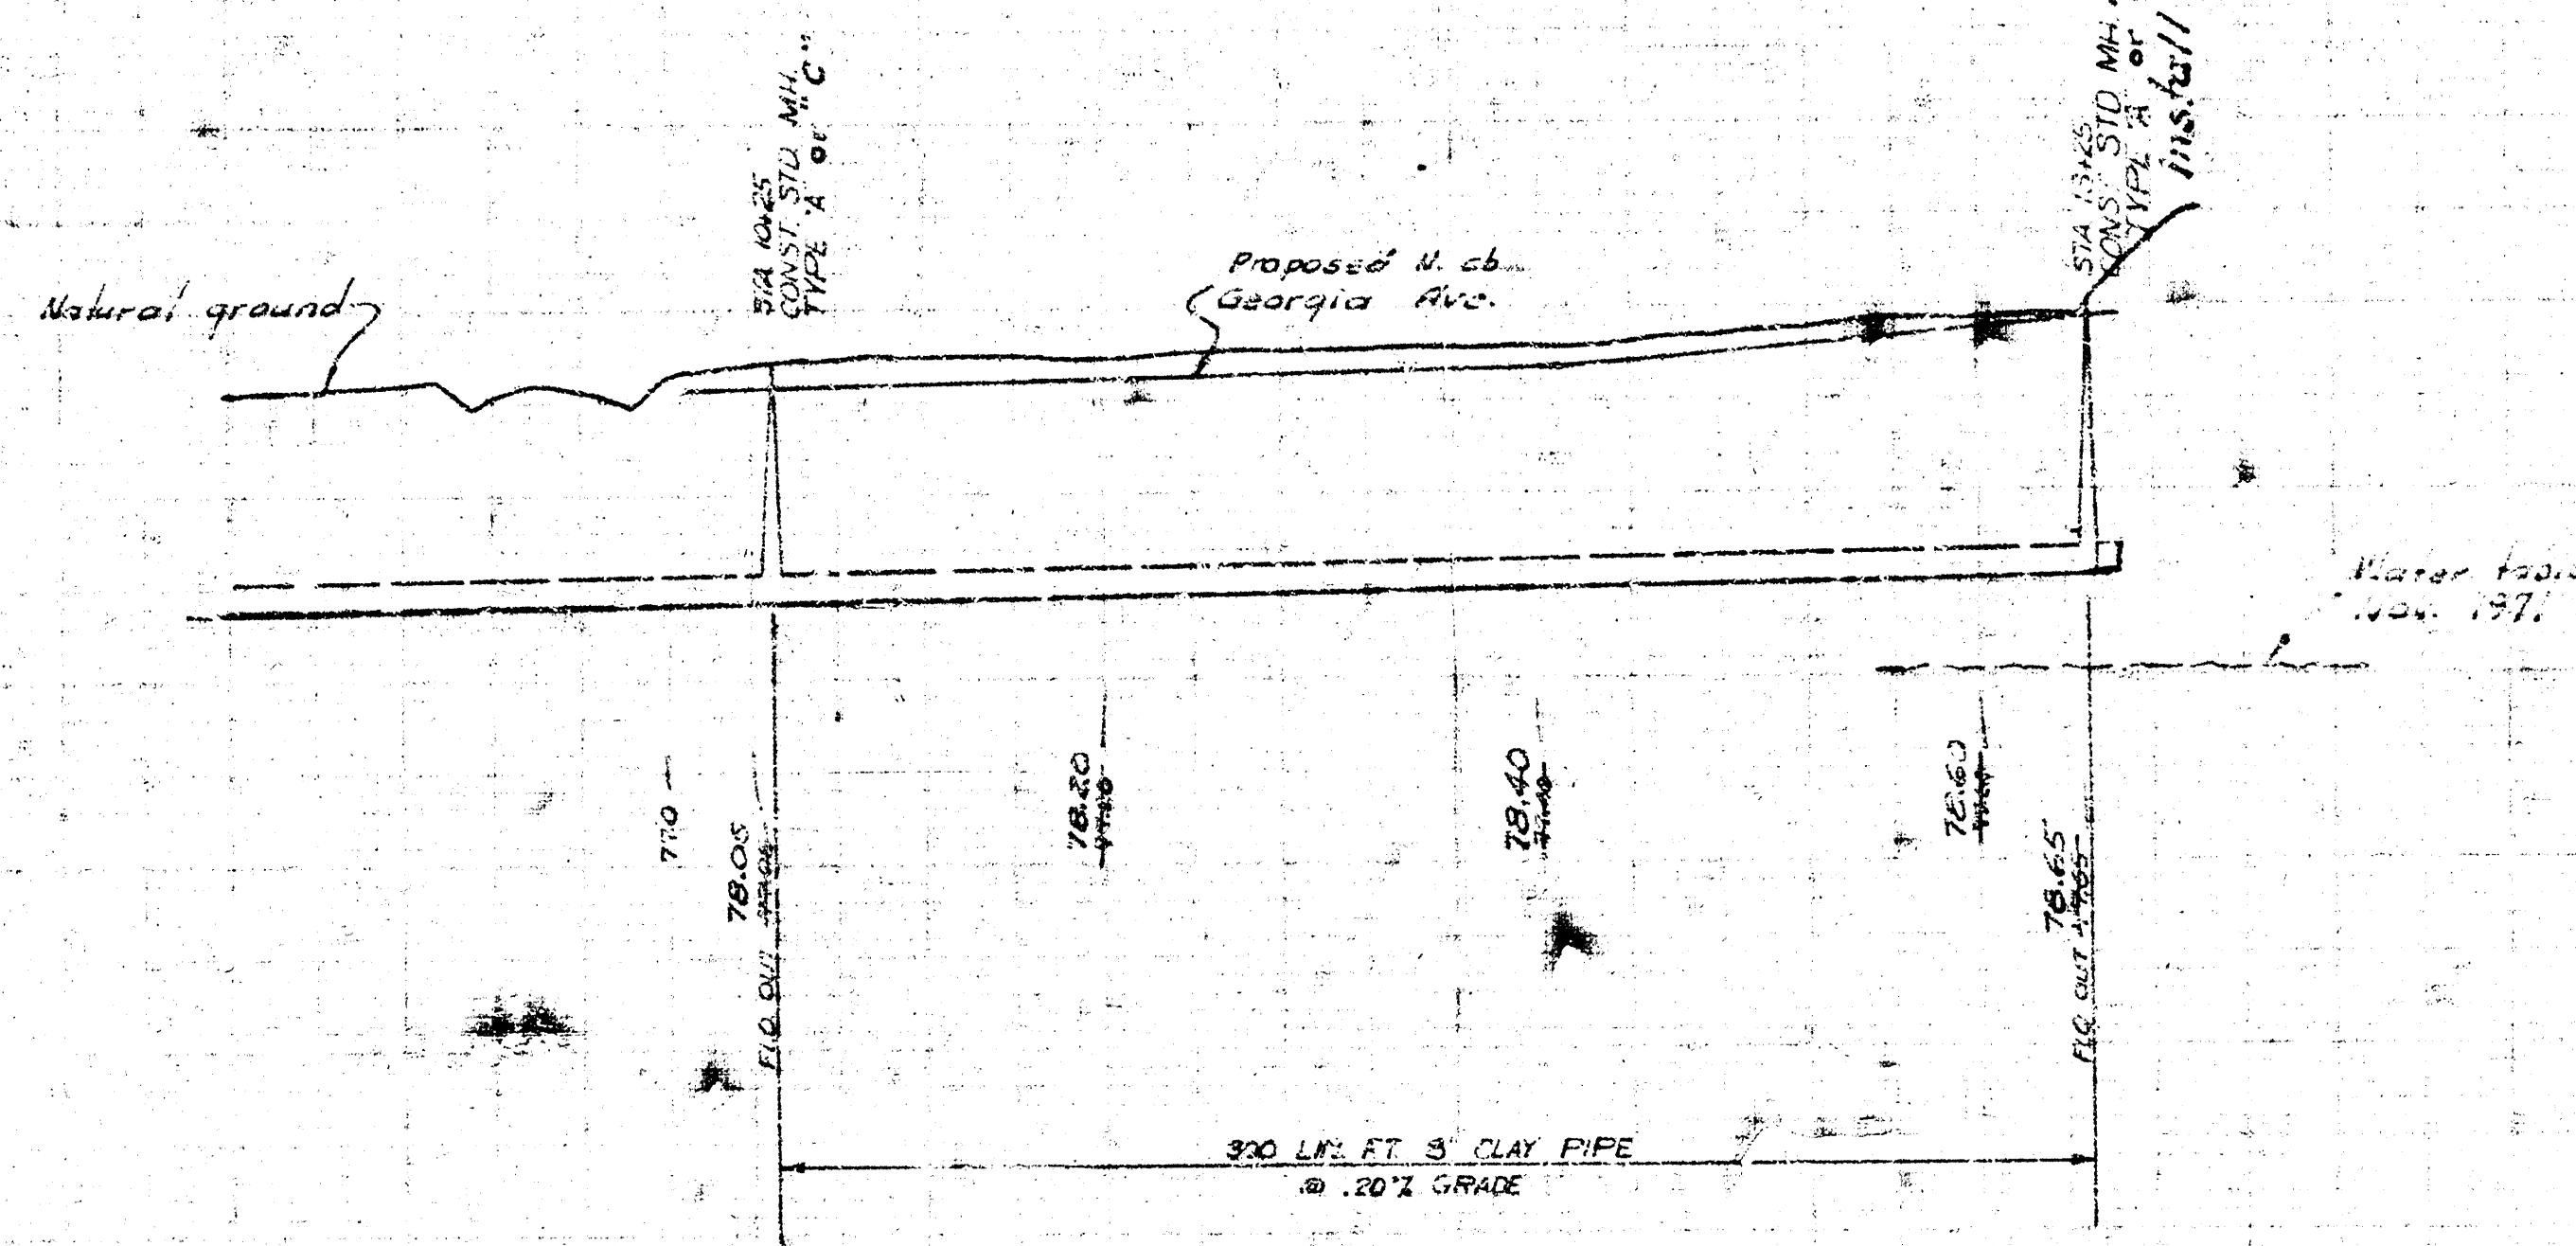

LAT. 28, MAIN L. S. W. INTERCEPTOR SEWER
PROJECT NO. DBKL 571033

14 5 5 ②