BM 86.14 "N" in Mueller, Fire Hyd. Flange @ N.E. cor. Lulu & 47th St. S.

BM 82.53 City Std N.E. cor Ida & 47th St. S.

Benefit Dist: Lots 1 thru 8 incl., Blk 4, Hinson's Southern Heights, Sec. 16, T28S, R1E, Wichita, Kansas.

General Location: Between Lulu & Ellis and 46th So. & 47th So.

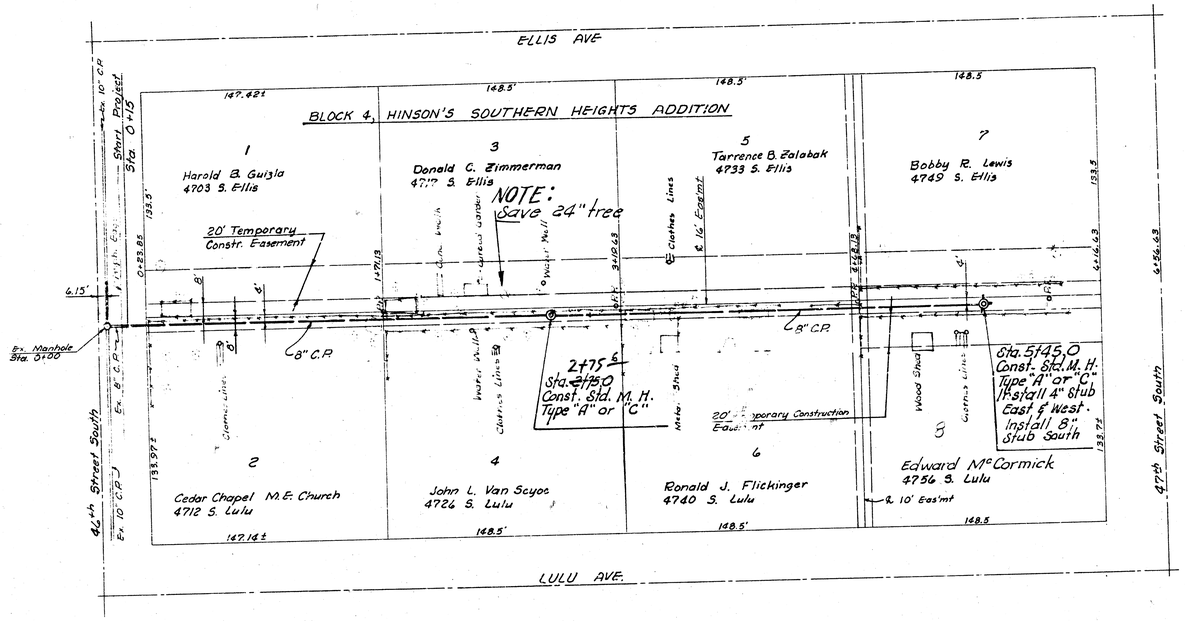

SCALE: Hor. 1"=40'
Ver. 1"=5'

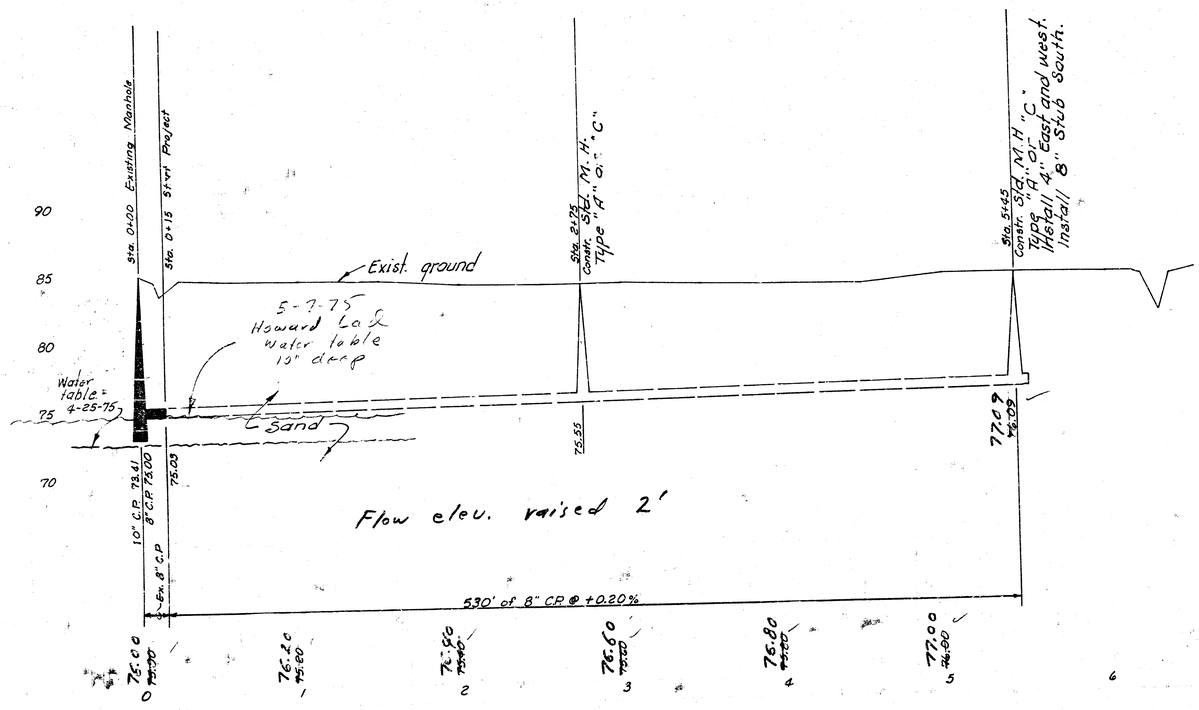

As Built 8-26-75

LAT. 37, SUB. I, S.W. INTERCEPTOR SEWER
CITY OF WICHITA, KANSAS
R.W. LINN, CITY ENGINEER
PROJECT NO. DBKL574020

DATE _____ Sheet 1/1 1

DONALD E. SCHIEDT
LICENSED
6311
KANSAS
PROFESSIONAL ENGINEER