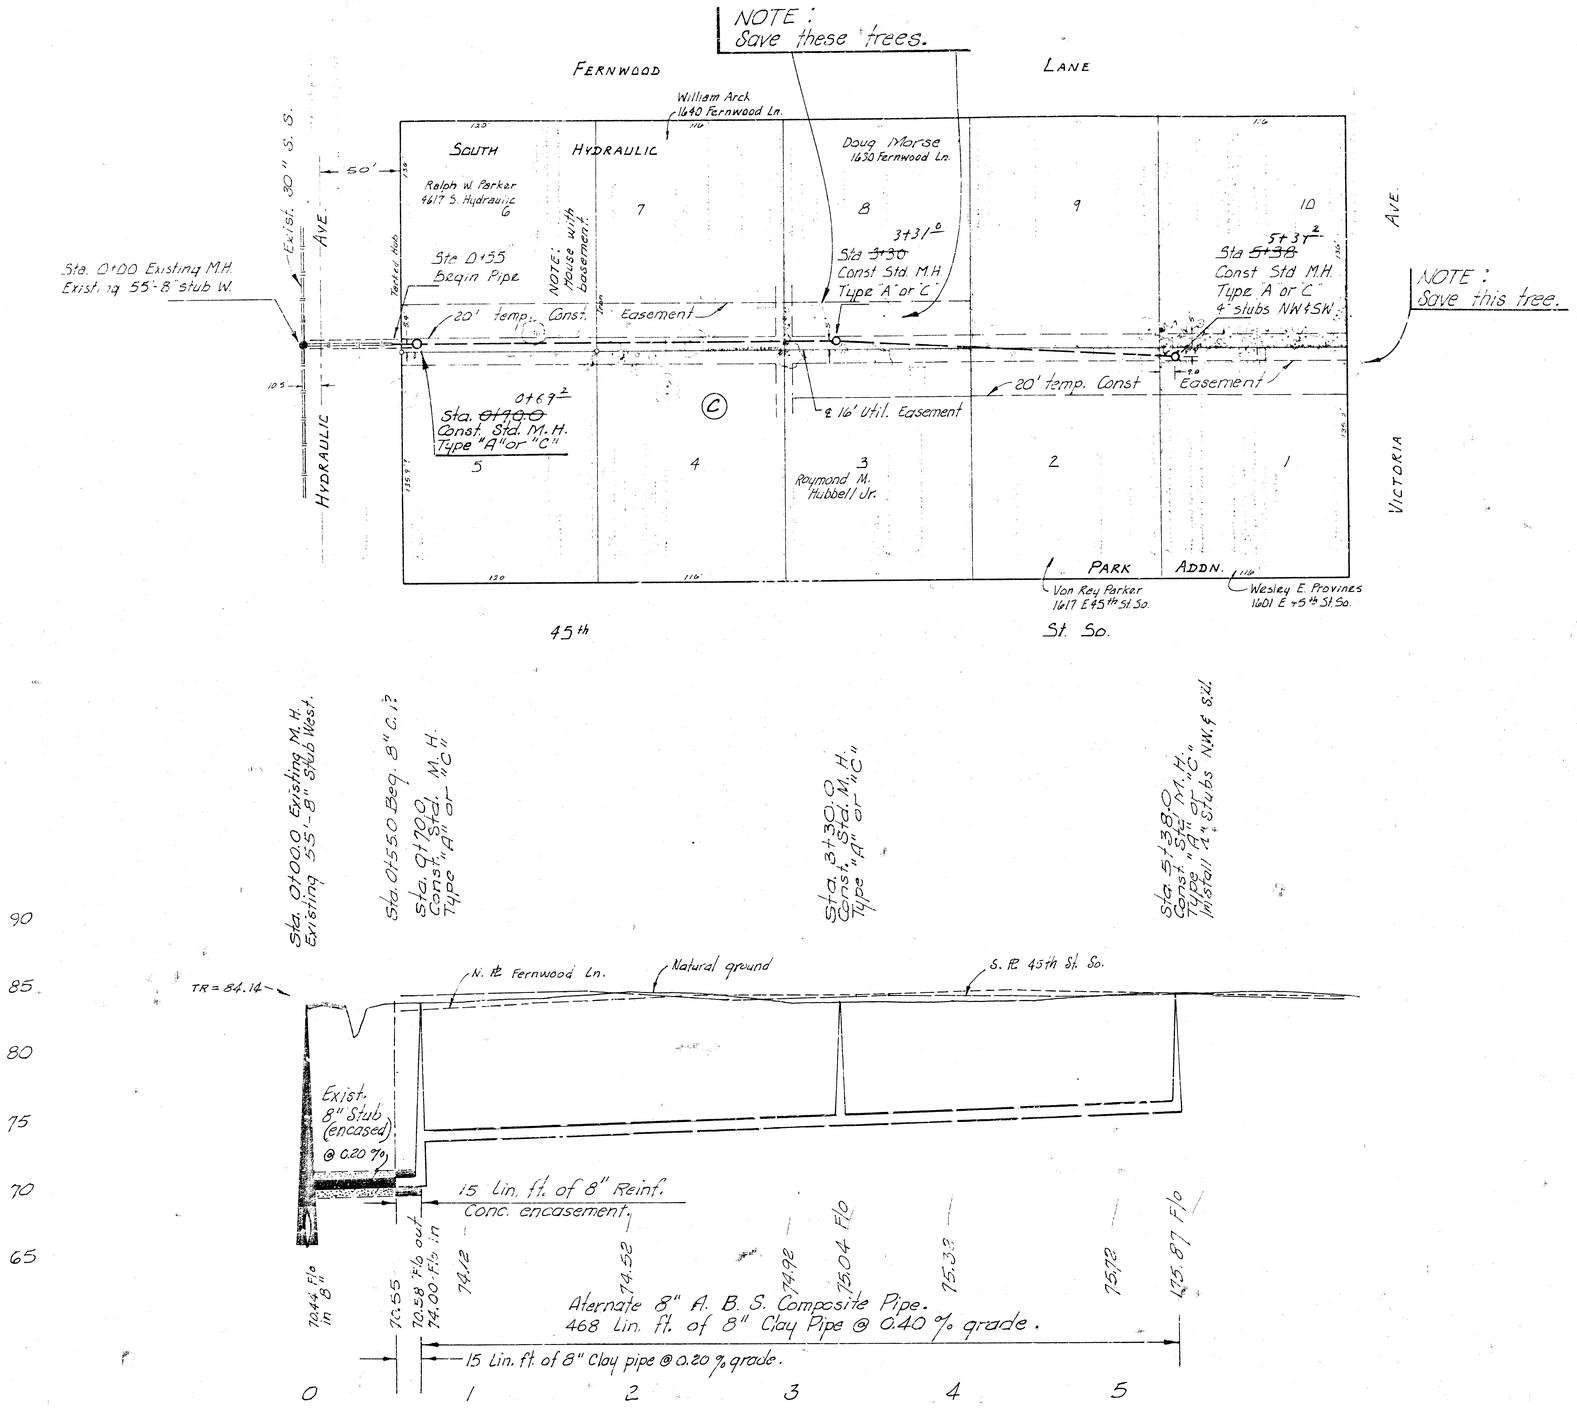

Plan Scale 1" = 40'
Profile Scale 1" = 40' Horz. 1" = 5' Vert.

B.M. B211 City Std. disc 44' W & 42' N. of ℄ & 93'd St. So. & Hydraulic

As built 1-11-77

LAT 41, MAIN 1, S.W.I.
CITY OF WICHITA, KANSAS
R. W. LINN — CITY ENGINEER
SEPT. 1976 PROJECT NO. DBKL575035