




PLAN
 1/8" = 1' HORIZ.
 1/8" = 5' VERT.

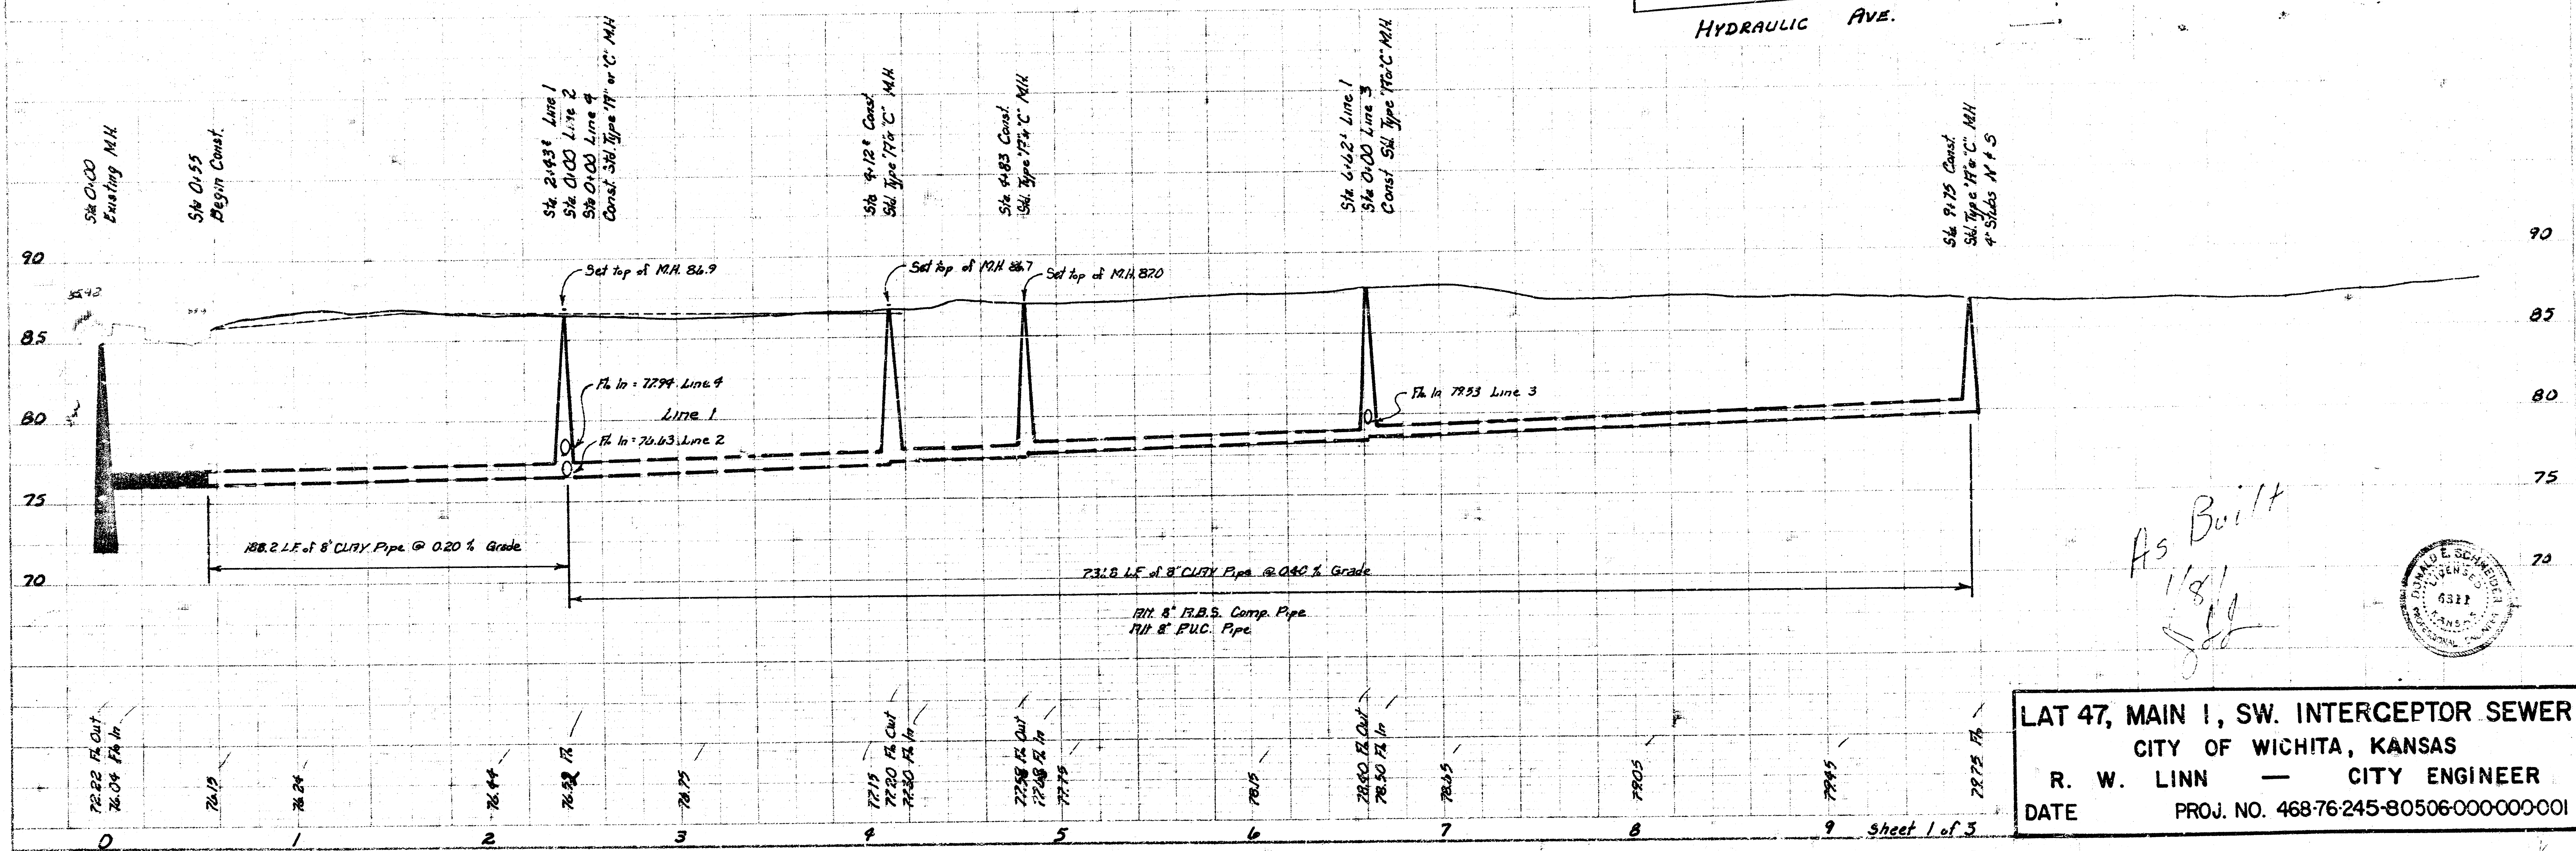

LAT 47, MAIN 1, SW. INTERCEPTOR SEWER
CITY OF WICHITA, KANSAS
R. W. LINN — CITY ENGINEER
 DATE _____ PROJ. NO. 468-76-245-80506-000-000-001

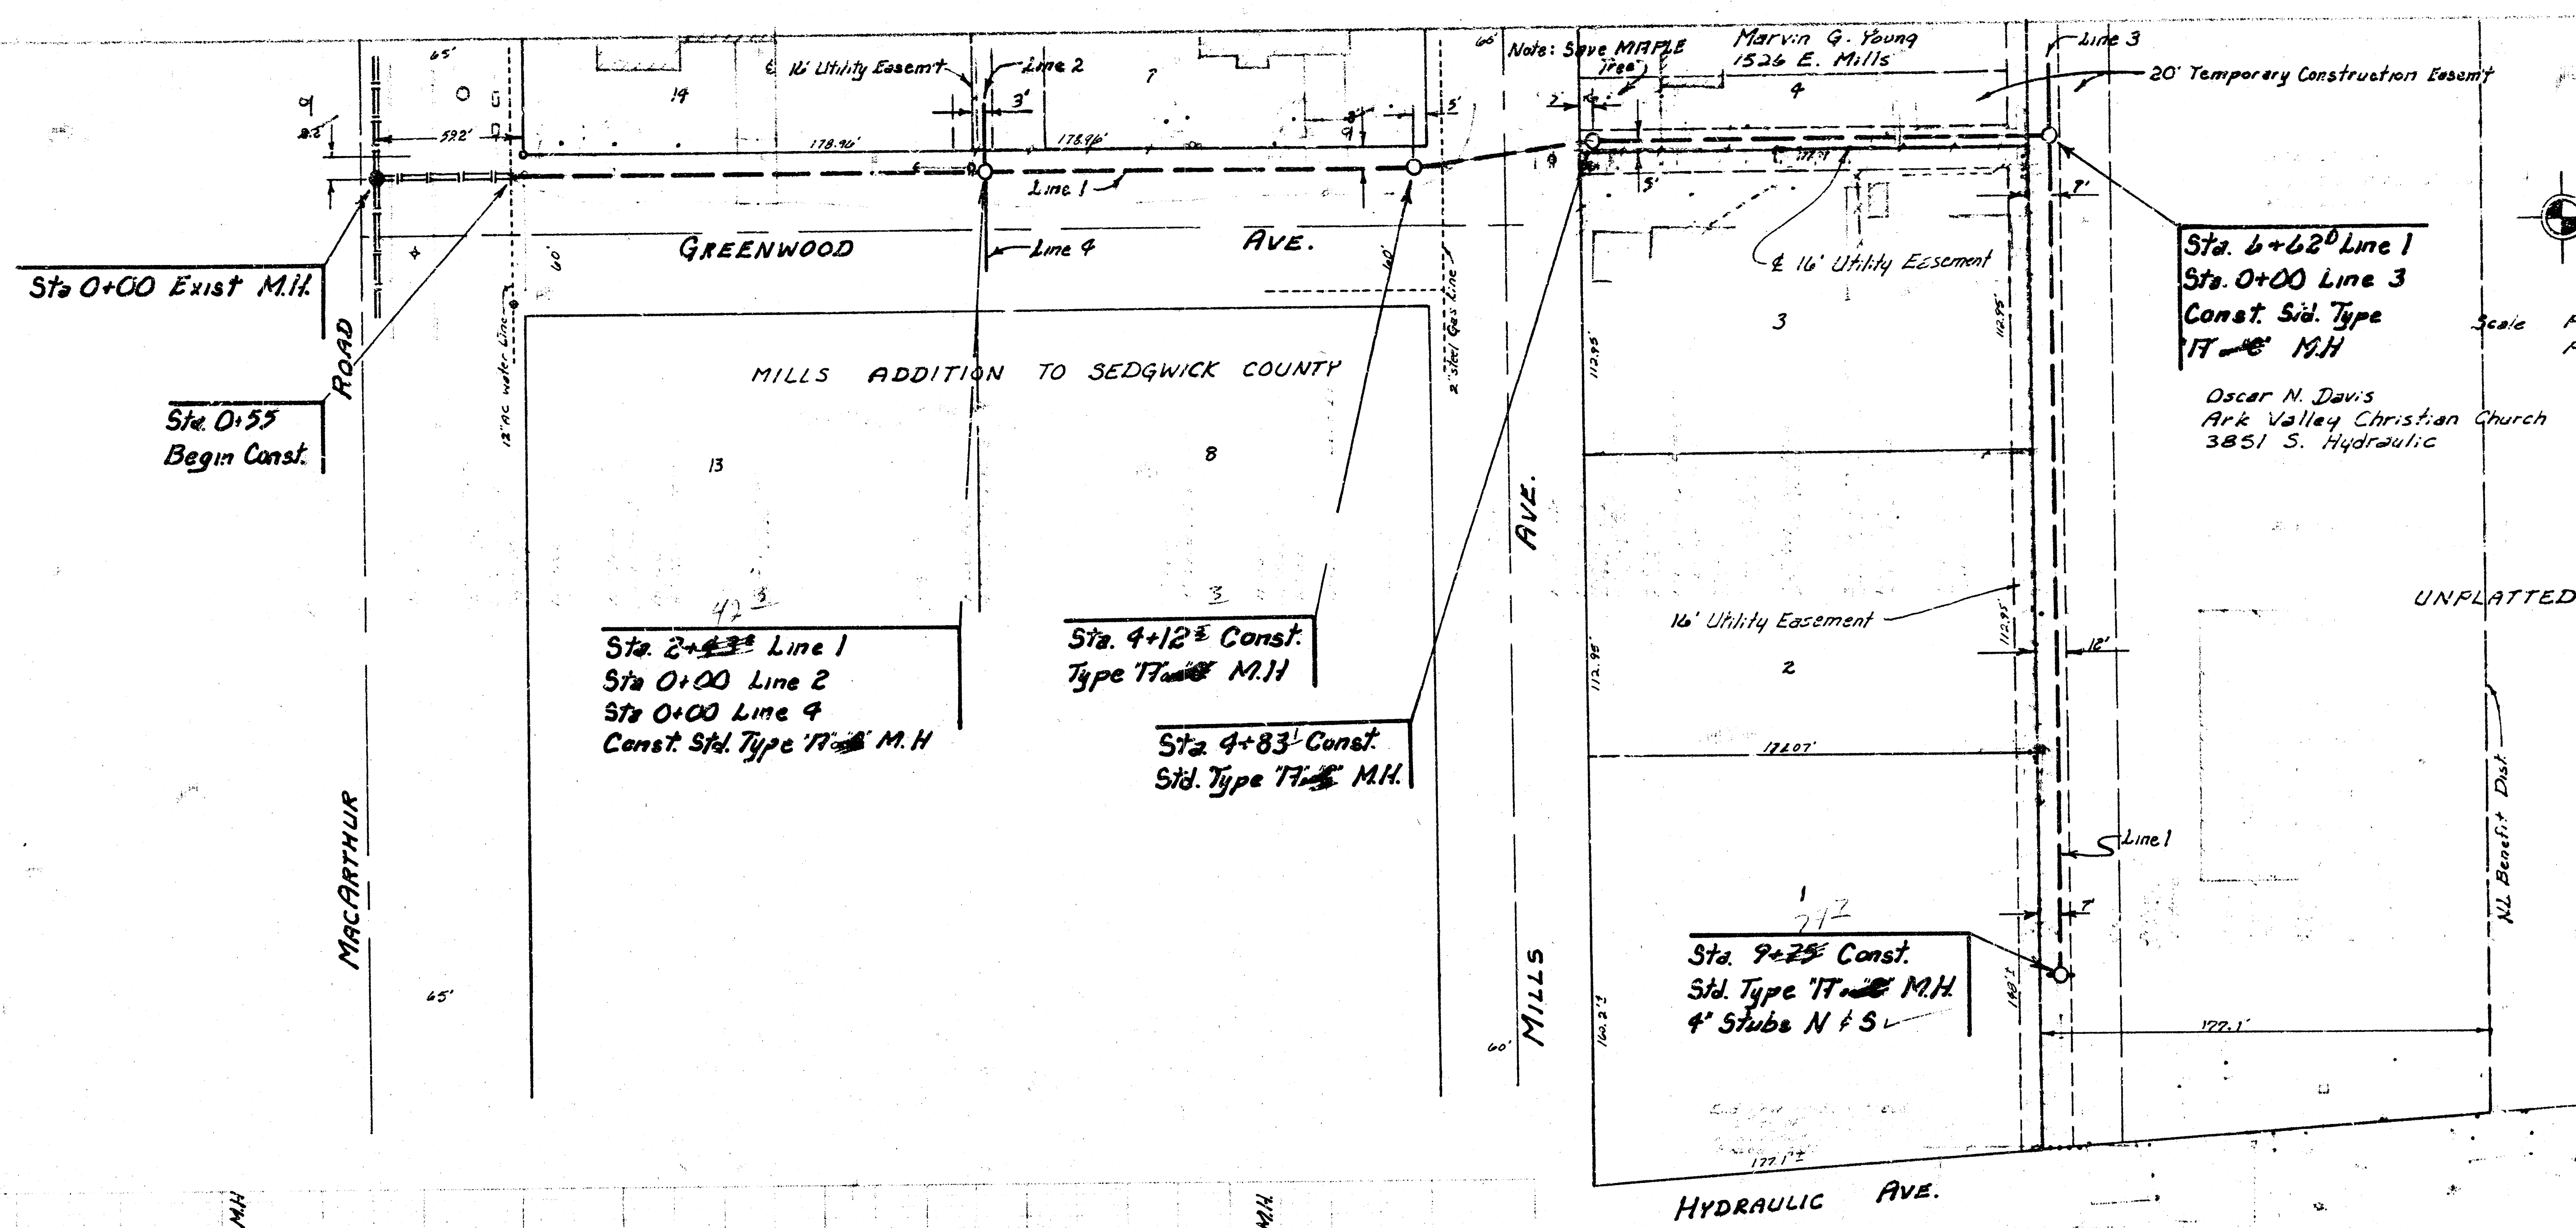

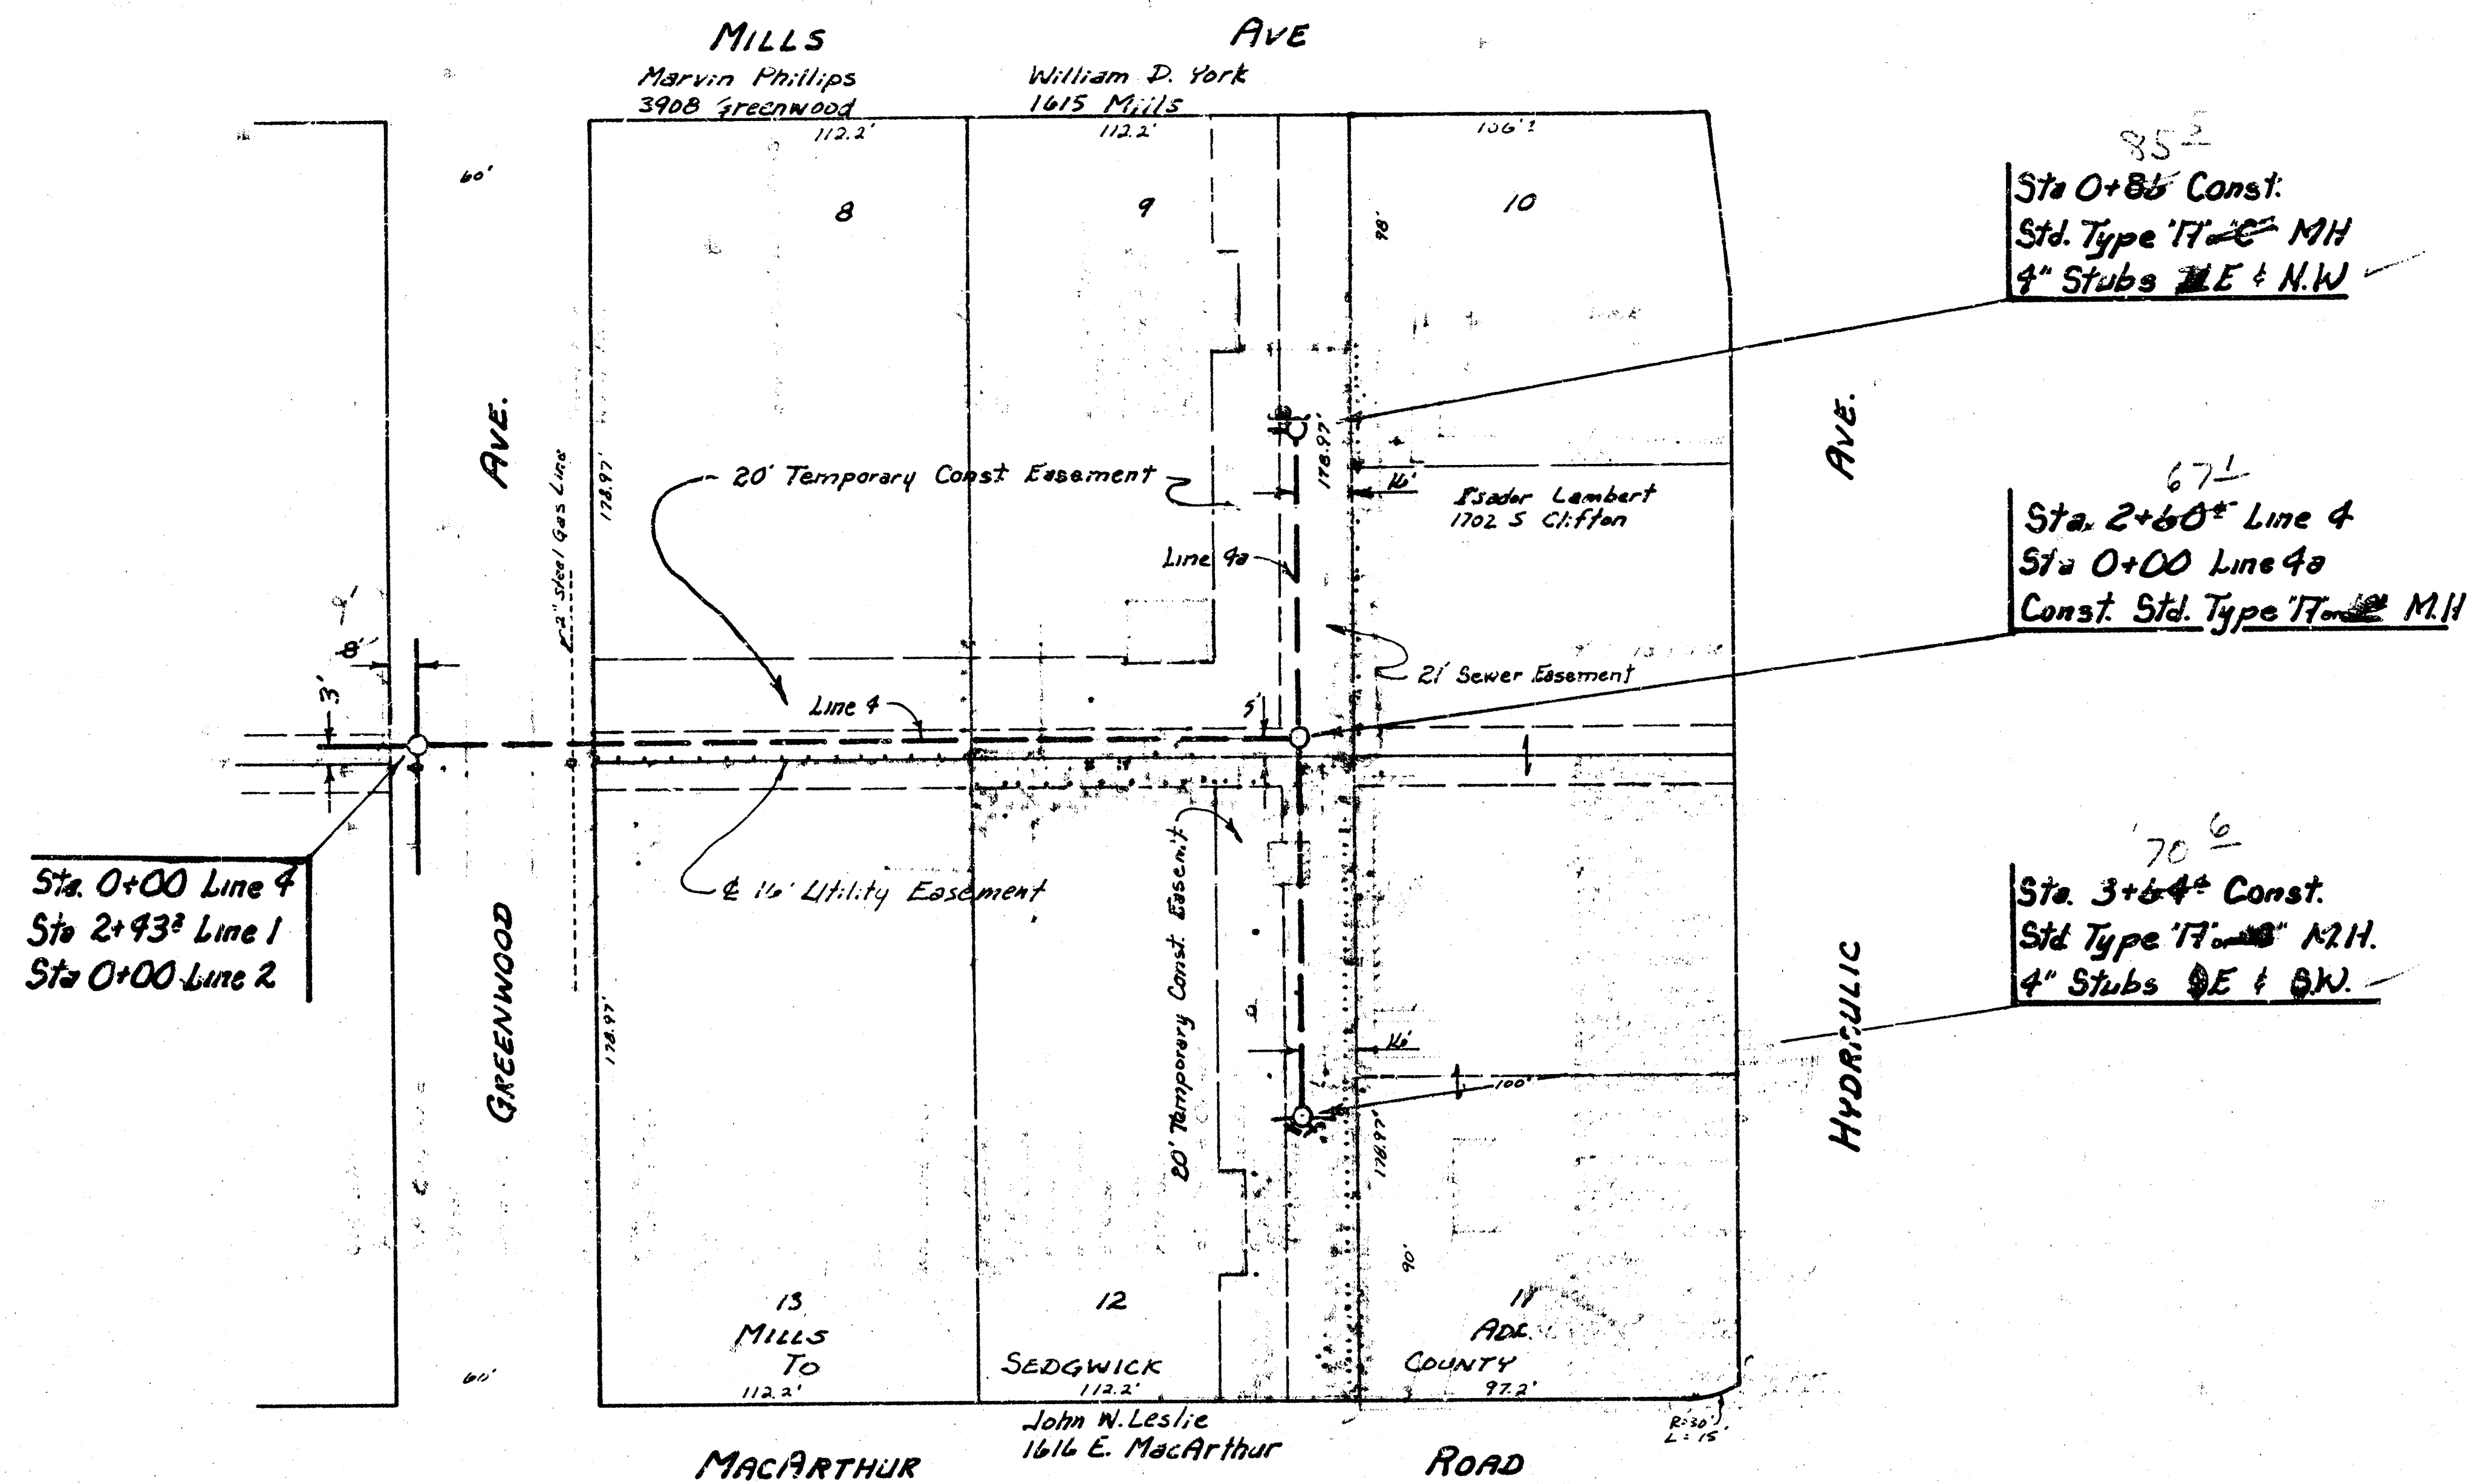

N

Scale Plan 1" = 40'
 Profile 1" = 40' Horiz.
 1" = 5' Vert.

