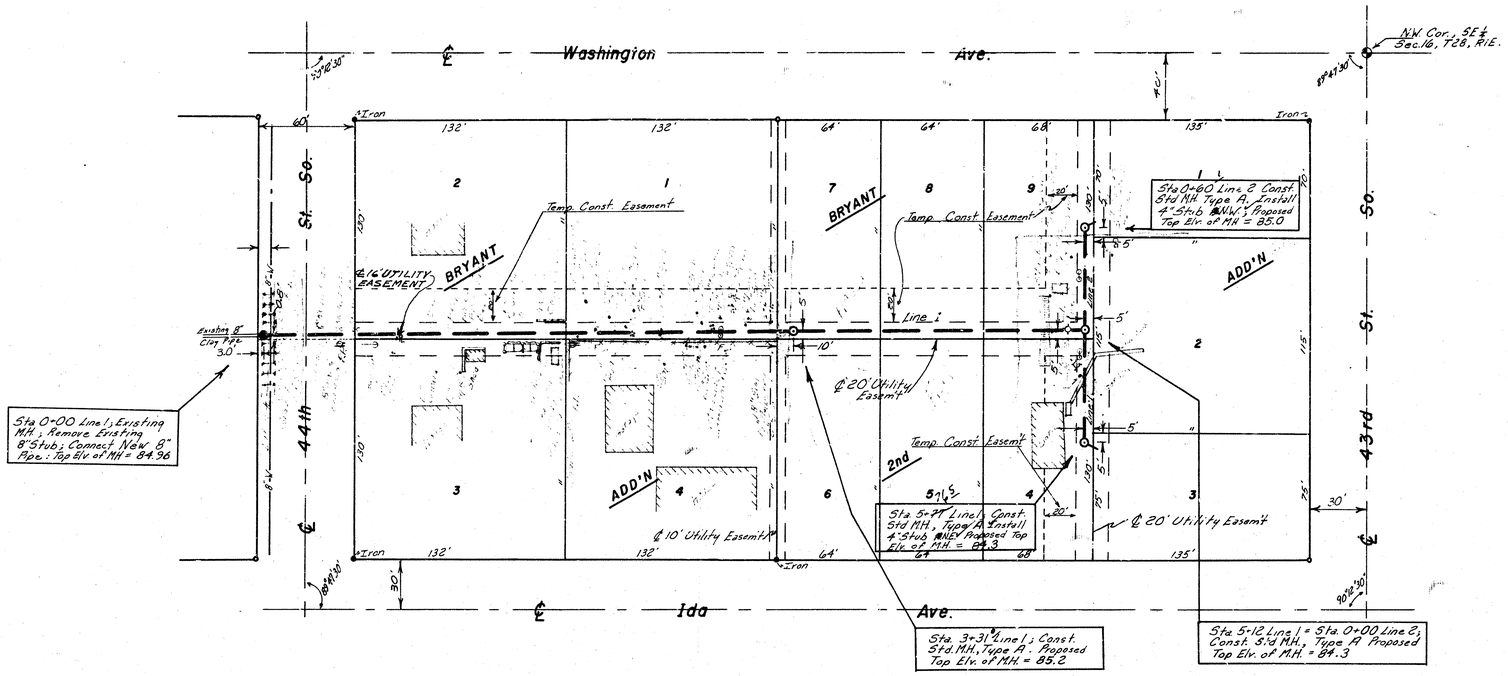

N

Scale: 1" = 40' Plan
Horz. 1" = 40' Profile
Vert. 1" = 5'

Bench Marks: 82.11 - City Std Disc., 44' W. and 42' N. of ℄ of 43rd St. So. and Hydrante.
84.73 - "O" Top of Curb, East side of Washington Ave. @ South end of South return on 44th St. So.

THE CONTRACTOR SHALL BE RESPONSIBLE FOR PRESERVING PROPERTY CORNERS. THE CONTRACTOR SHALL BE REQUIRED TO RE-ESTABLISH ANY PROPERTY CORNERS WHICH ARE DAMAGED OR DESTROYED BY HIS CONSTRUCTION OPERATIONS. SUCH CORNERS SHALL BE RE-ESTABLISHED BY A LICENSED LAND SURVEYOR OR A LICENSED PROFESSIONAL ENGINEER IN ACCORDANCE WITH STATE LAWS.

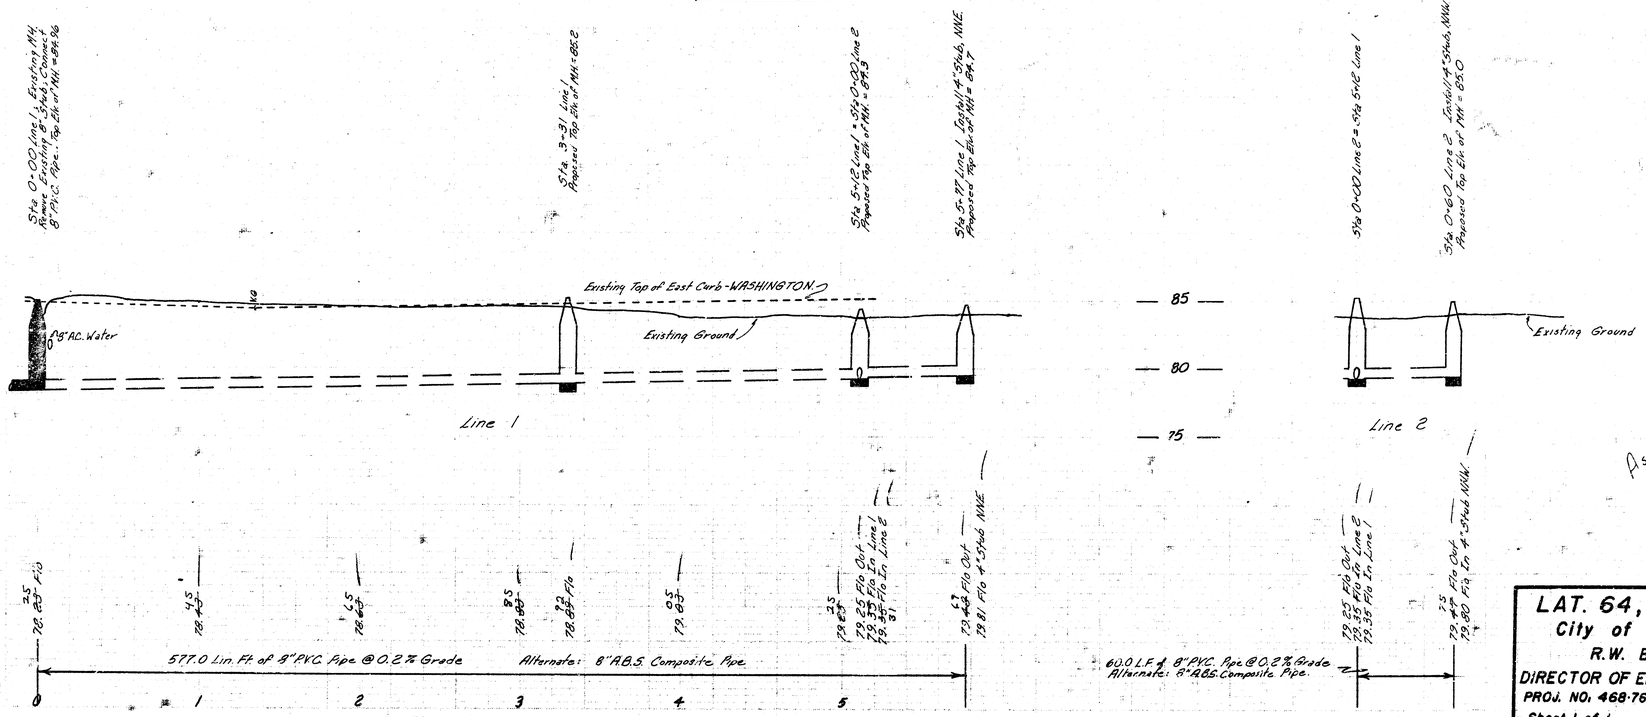

As Built
J.L.L.
6-82

DONALD E. SCHIMEK
LICENSED
6311
KANSAS
PROFESSIONAL ENGINEER

LAT. 64, MAIN 1, S.W.I.
City of Wichita, Kansas
R.W. BRUGGEMAN
DIRECTOR OF ENGINEERING/ CITY ENGR.
PROJ. NO. 468-76-245-81139-000-000-001
Sheet 1 of 1 Date