B.M. 82.97 R.R. spike East side of power pole on N.W. corner of Seneca and 51st St. South.
B.M. 83.925 R.R. spike East side of power pole, East of Seneca, 135' N. of 51st St. South.
B.M. 84.17 R.R. spike North face of power pole, East side of Osage, 135' N. of 51st St. South.

NOTE: ALL FENCES REMOVED TO FACILITATE CONSTRUCTION OF THIS PROJECT SHALL BE REPLACED IN A CONDITION AT LEAST EQUAL TO THE ORIGINAL

Sta ~~0+25~~ 0+25.3
Const. Std. M.H.
Type "A" or "C"
End Clay Pipe.
Begin A.B.S. Composite Pipe

SUNRISE DRIVE

SOUTH SENECA GARDENS 2nd ADDITION

SENECA ST.

OSAGE AVE.

51st. ST. SOUTH

Allan H. Hillman, 1017 W. Sunrise Dr.
Ray Sumner, % Virginia Barnett, 1001 W. Sunrise Dr.
Bill McLaren, 943 W. Sunrise Dr.
Harold C. Shoemaker, 929 W. Sunrise Dr.
May's Co. Inc., 208 N. Broadway
John O. Cleveland, 901 W. Sunrise Dr.
Estel D. Prior, 829 W. Sunrise Dr.
Robert G. Olsen, 817 W. Sunrise Dr.
George D. Horn, 5700 South St. Francis
Glenn H. Goforth, % Lloyd Folger, 510 E. 56th St. South
Evelyn B. Goforth, 1318 Claremont Dr., Davis, California
Earl A. Yarberry, 942 W. 51st St. South
Shirley J. White, 930 W. 51st St. South
James W. Brewer, 918 W. 51st St. South
Harold E. Harris, 3206 S. Wichita
Floyd G. Marshall, 830 W. 51st St. South
Thomas A. George, 818 W. 51st St. South

Sta 0-40
Exist. M.H.

Sta 0+00
~~Exist 40' Stub E~~
Begin Line

Sta ~~2+62~~ 2+62.3
Const. Std. M.H.
Type "A" or "C"

Sta ~~5+62~~ 5+62.3
Const. Std. M.H.
Type "A" or "C"


Sta ~~8+22~~ 8+22.8
Const Std M.H.
Type "A" or "C"

Sta ~~11+14~~ 11+14.3
Const. Std. M.H.
Type "A" or "C"

N

Scale 1"=40'

Scale: Hor. 1"=40'
Ver. 1"=5'

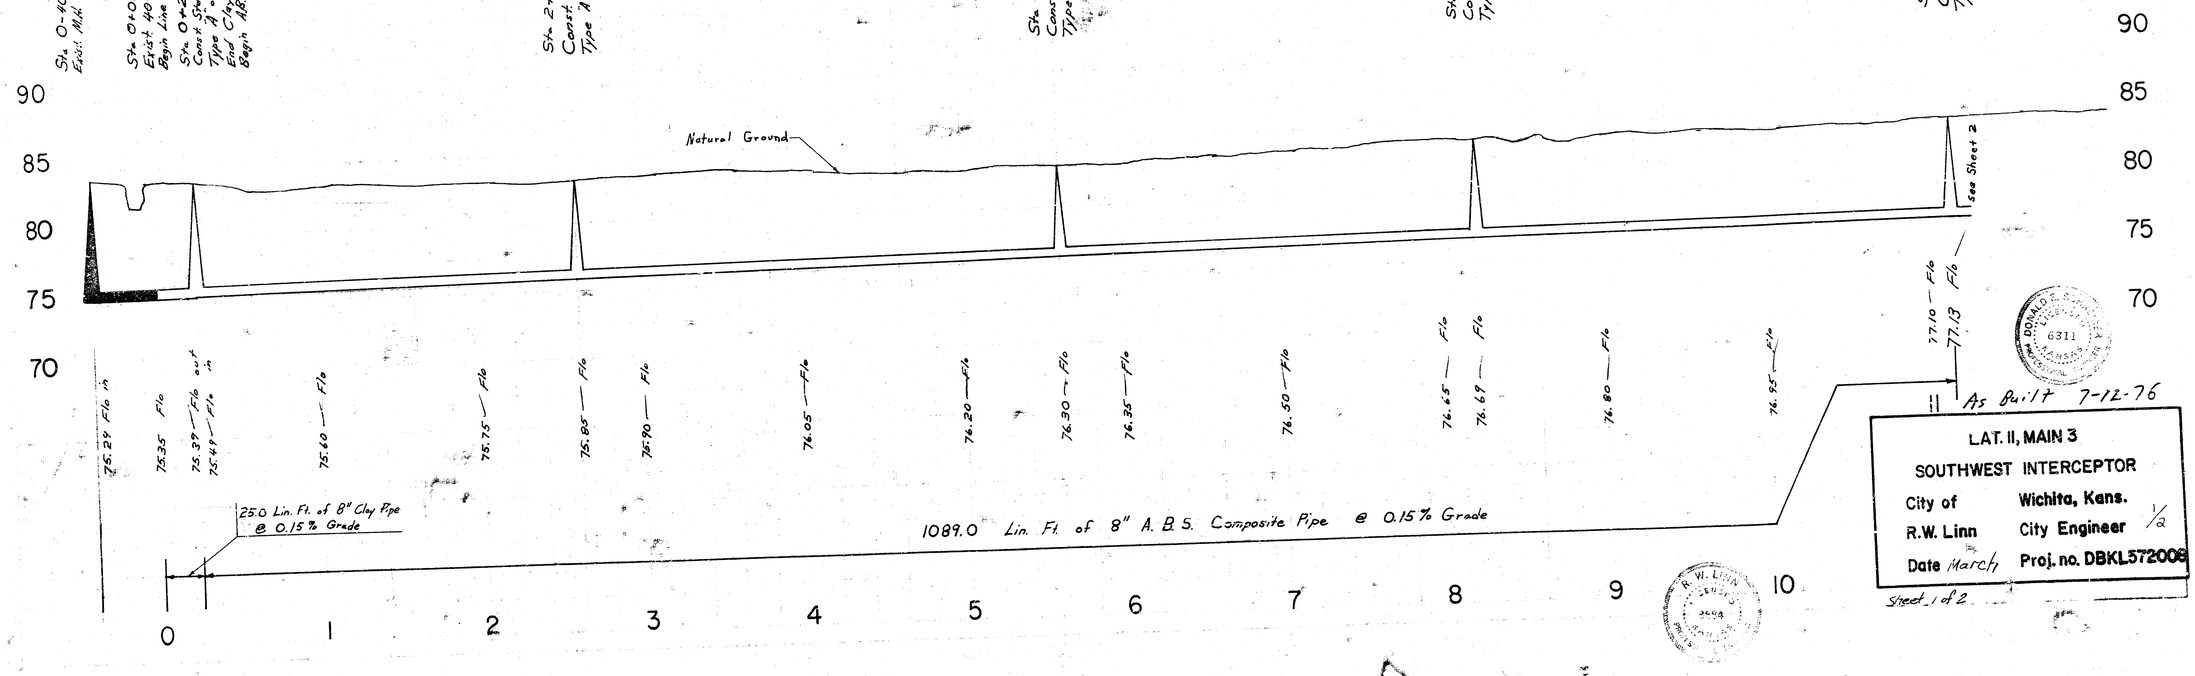


As Built 7-12-76


LAT. II, MAIN 3
SOUTHWEST INTERCEPTOR
City of Wichita, Kans.
R.W. Linn City Engineer
Date March Proj. no. DBKL572006

Sheet 1 of 2

B.M. 85.42 ; I.R. spike N.W. face of power pole, East side of Sycamore, 195' N. of 51st St. South.

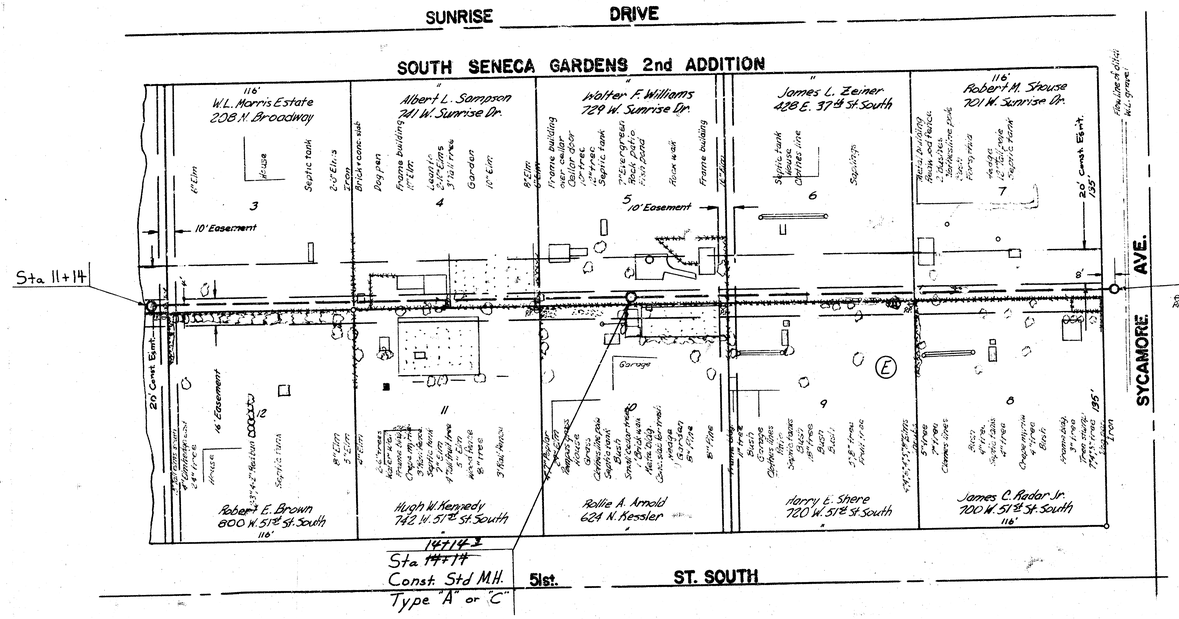

Scale 1" = 40'

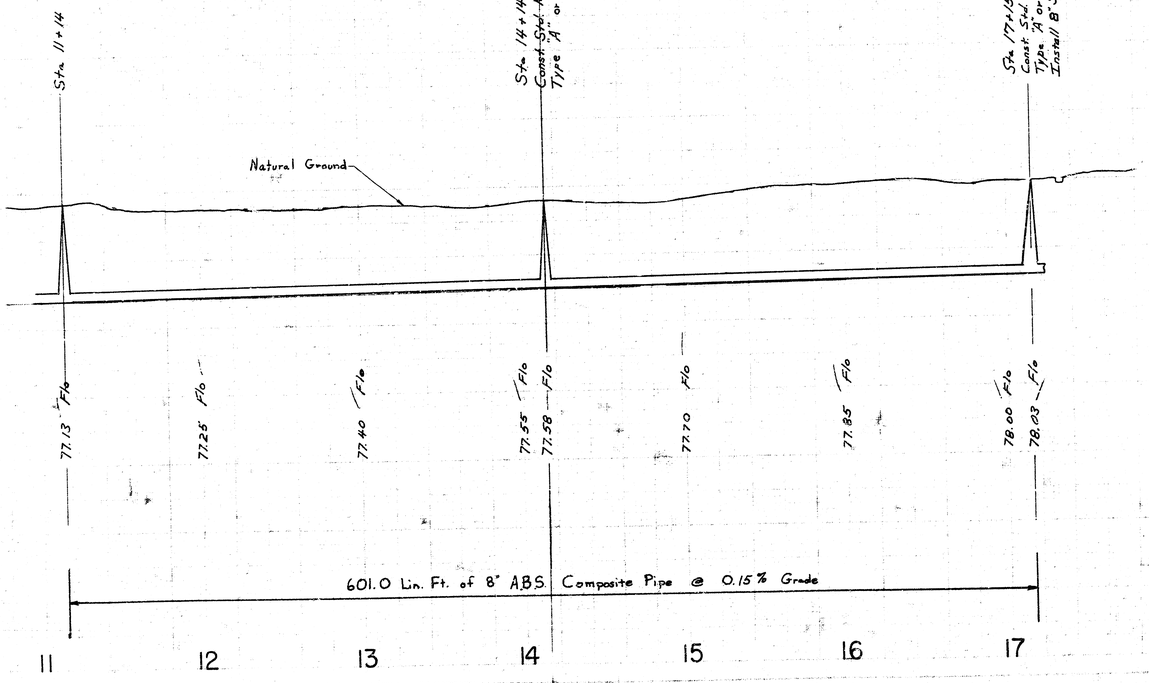

LATERAL 11, MAIN 3,
S.W. INTERCEPTOR 2/2
PROJ. NO. DBKL572008

Sheet 2 of 2