
B. M. 92.23 "X" in conc. on S-end of wing wall @ N. end of bridge span on W-side of Seneca & Carey Lane.

N

Plan Scale 1" = 40'
Profile Scale 1" = 40' Horz.
1" = 5' Vert.

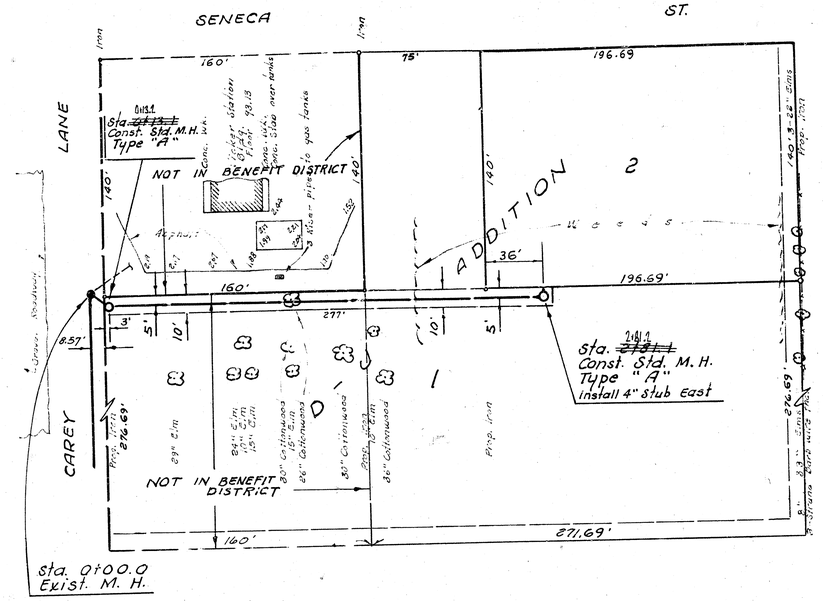

NOTE: Sewer pipe must have 30" cover.

"As Built" final measurements in S.S. #11 J.K.

LAT. 12, MAIN 3, S. W. INTERCEPTOR SEWER
CITY OF WICHITA, KANSAS
R. W. LINN — CITY ENGINEER
Sept. 1972 PROJECT NO. DBKL572039

D. S. K.
U. R. W.
123
Checked by [illegible]

14 4 S 12

FILMED FROM THE BEST