


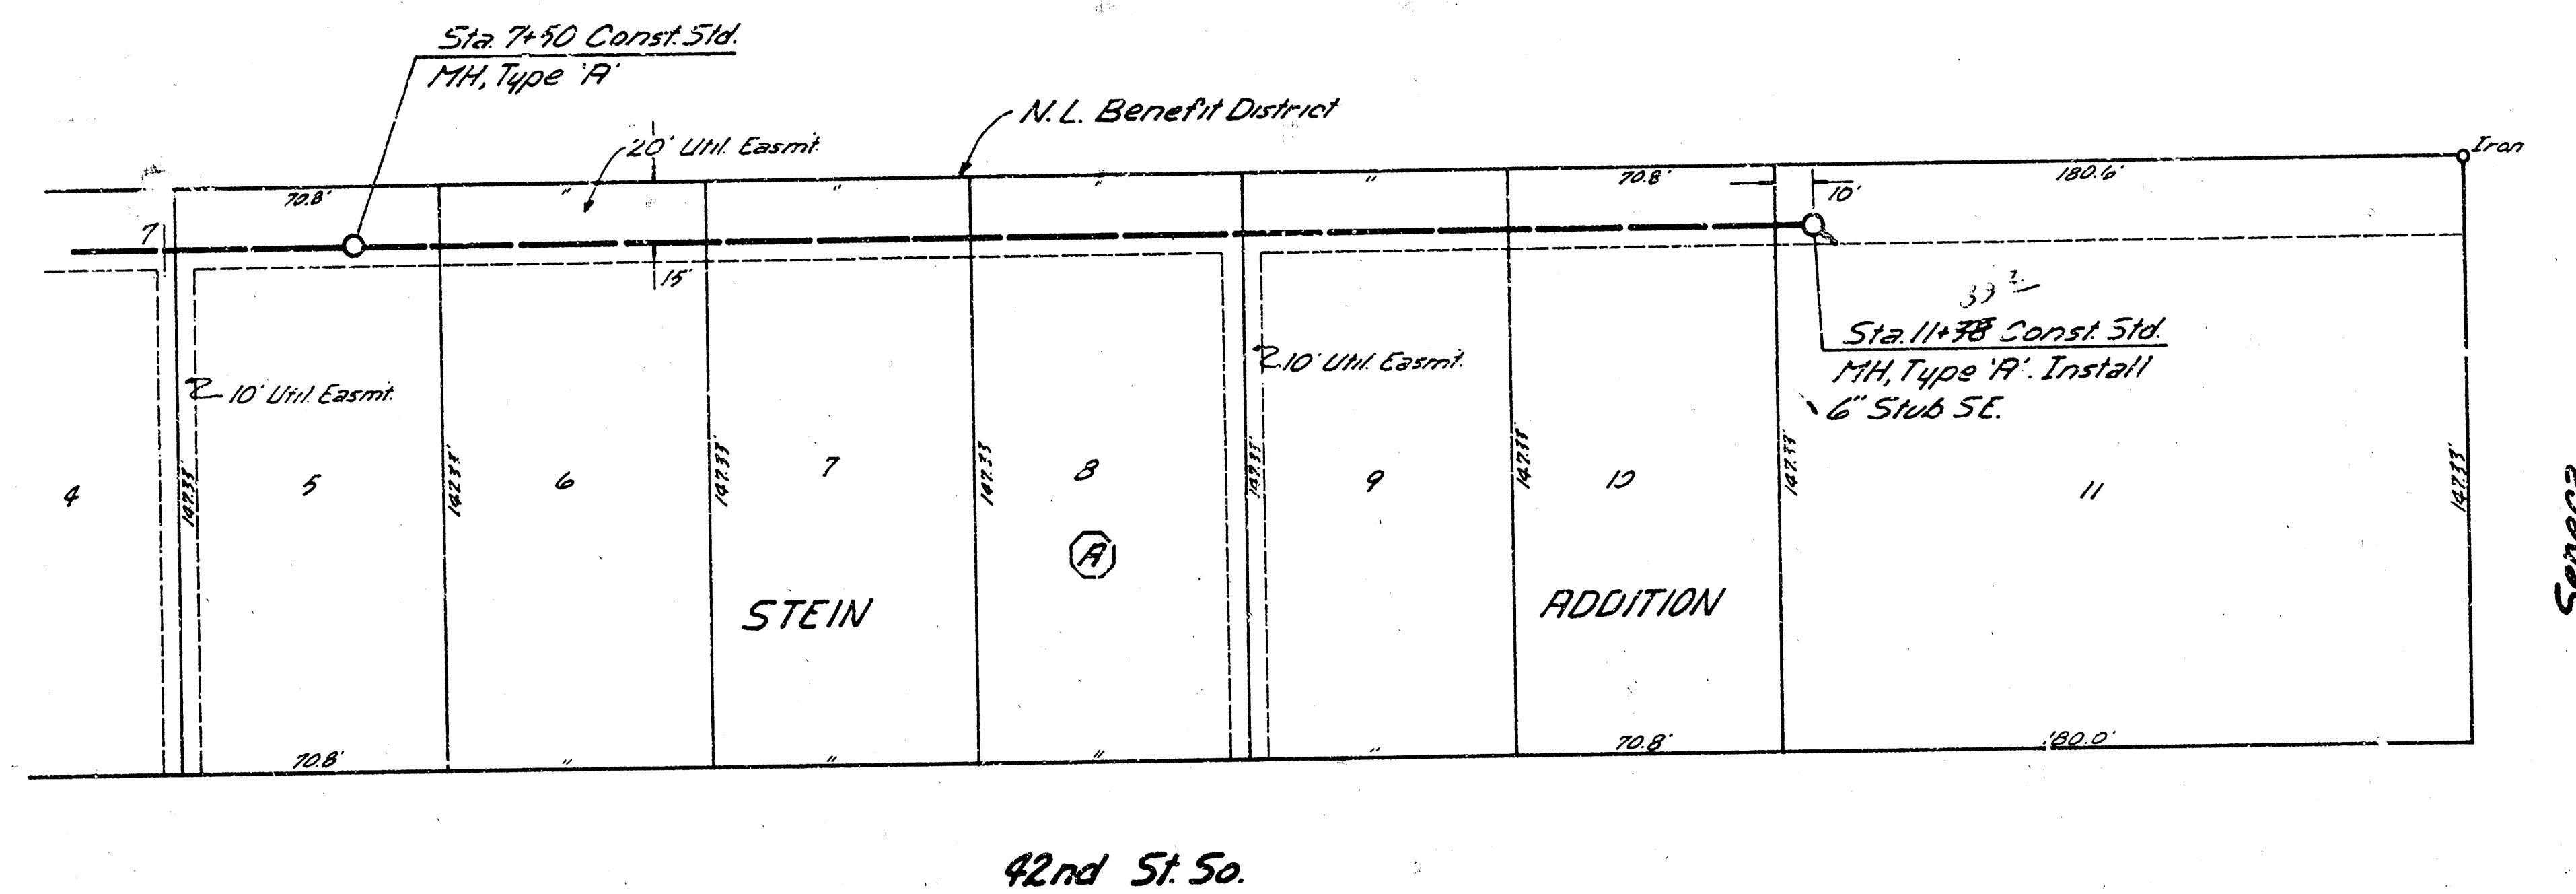

SCALE
Hort. 1"=40'
Vert. 1"=5'

