


**LATERAL 38, MAIN 3
SOUTHWEST INTERCEPTOR SEWER**


Project no. 468-76-245-80854-000-000-001

**CITY OF WICHITA, KANSAS
MIKE LINDEBAK CITY ENGINEER**

*TS Built
J.H.
4-84*

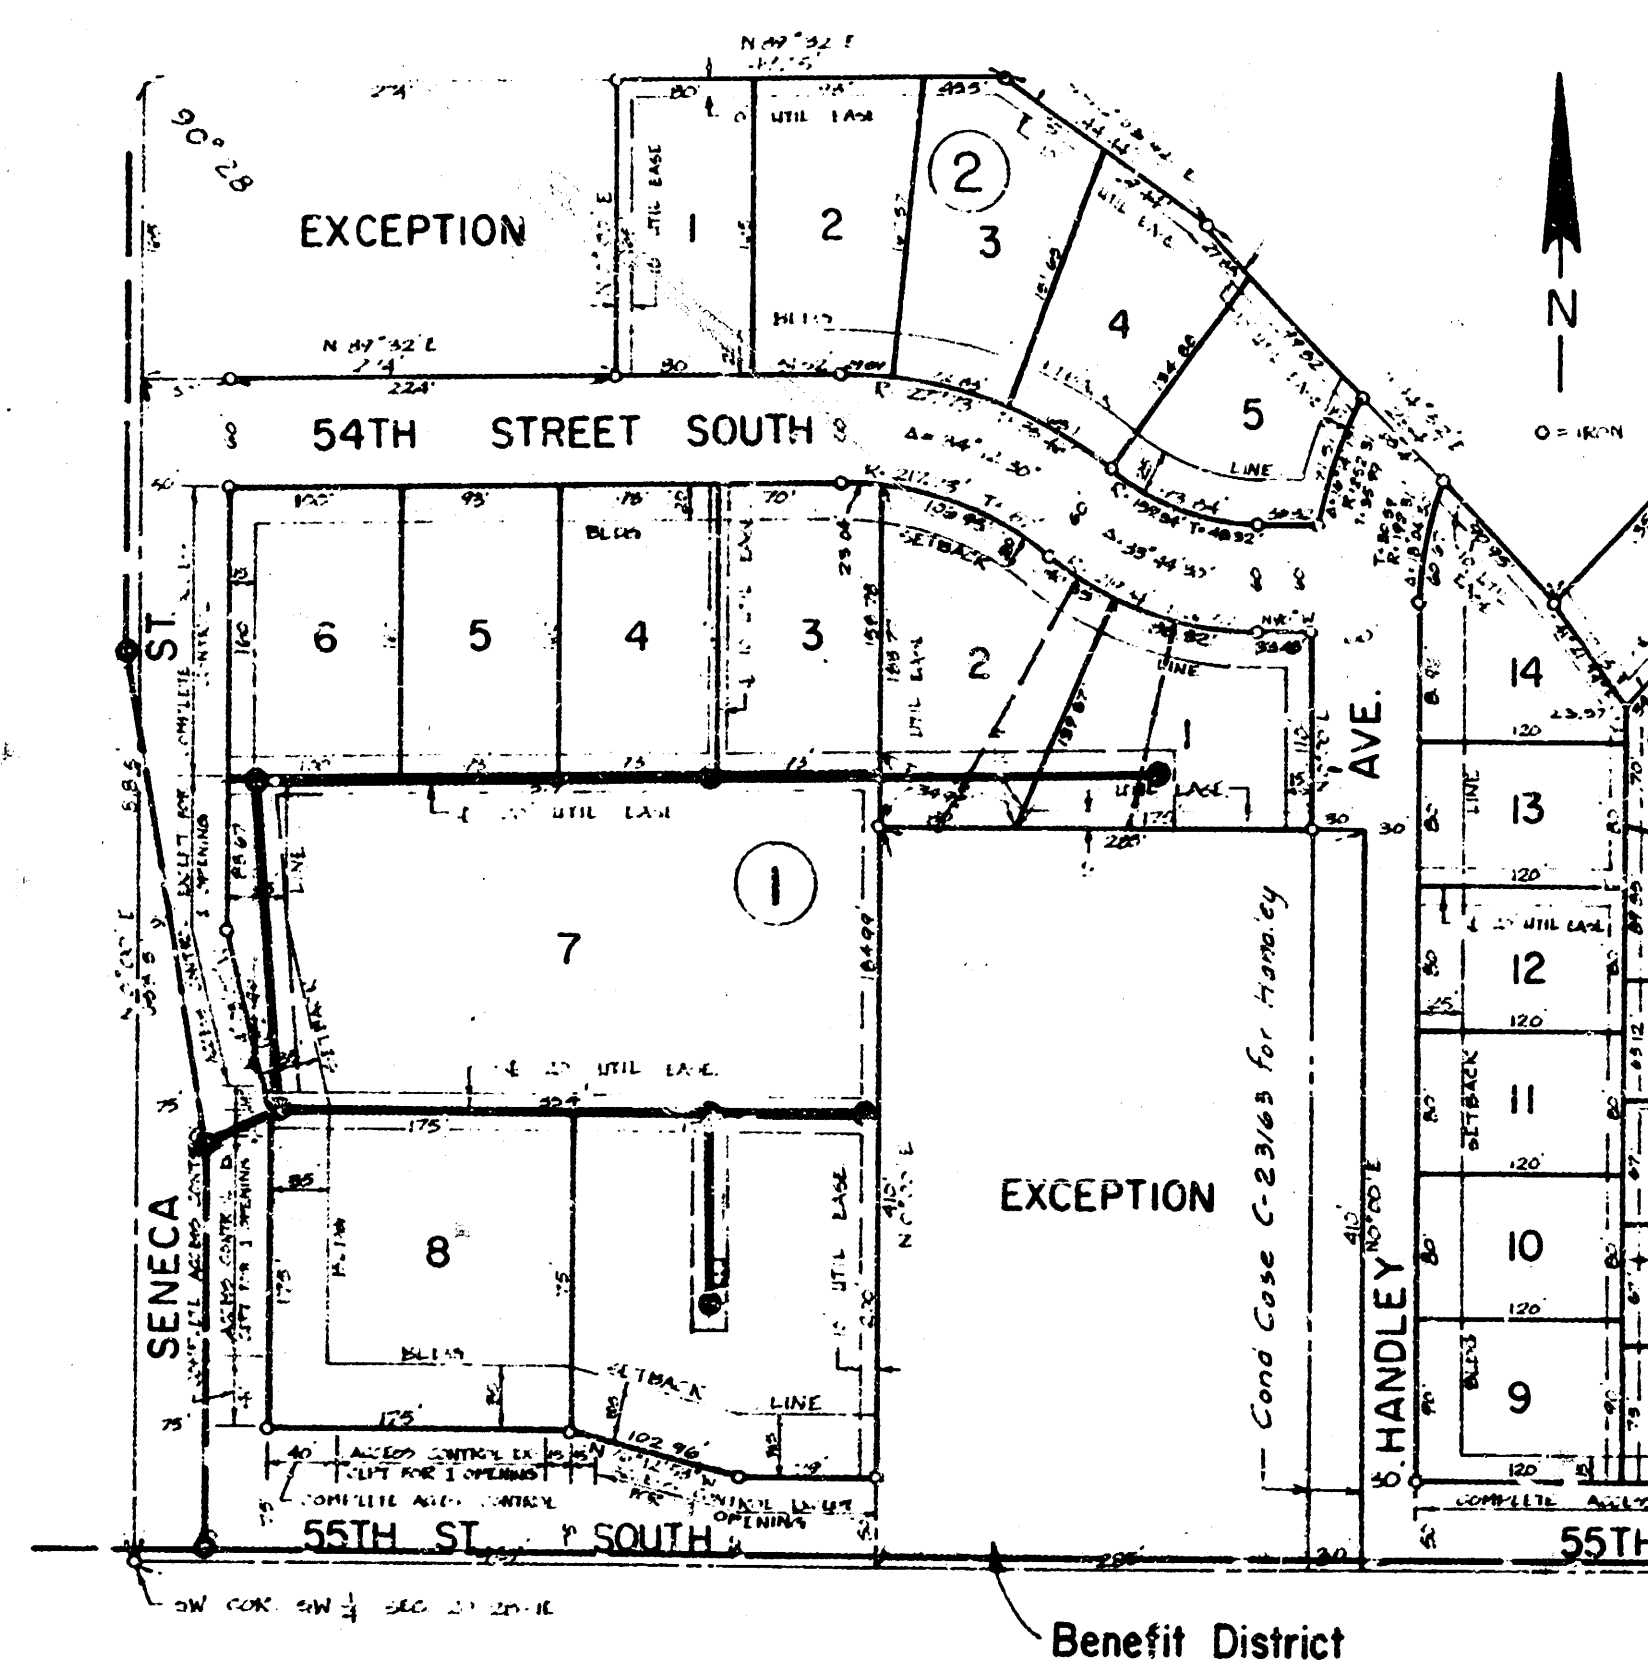

*1/3
Revised 1-24-84*

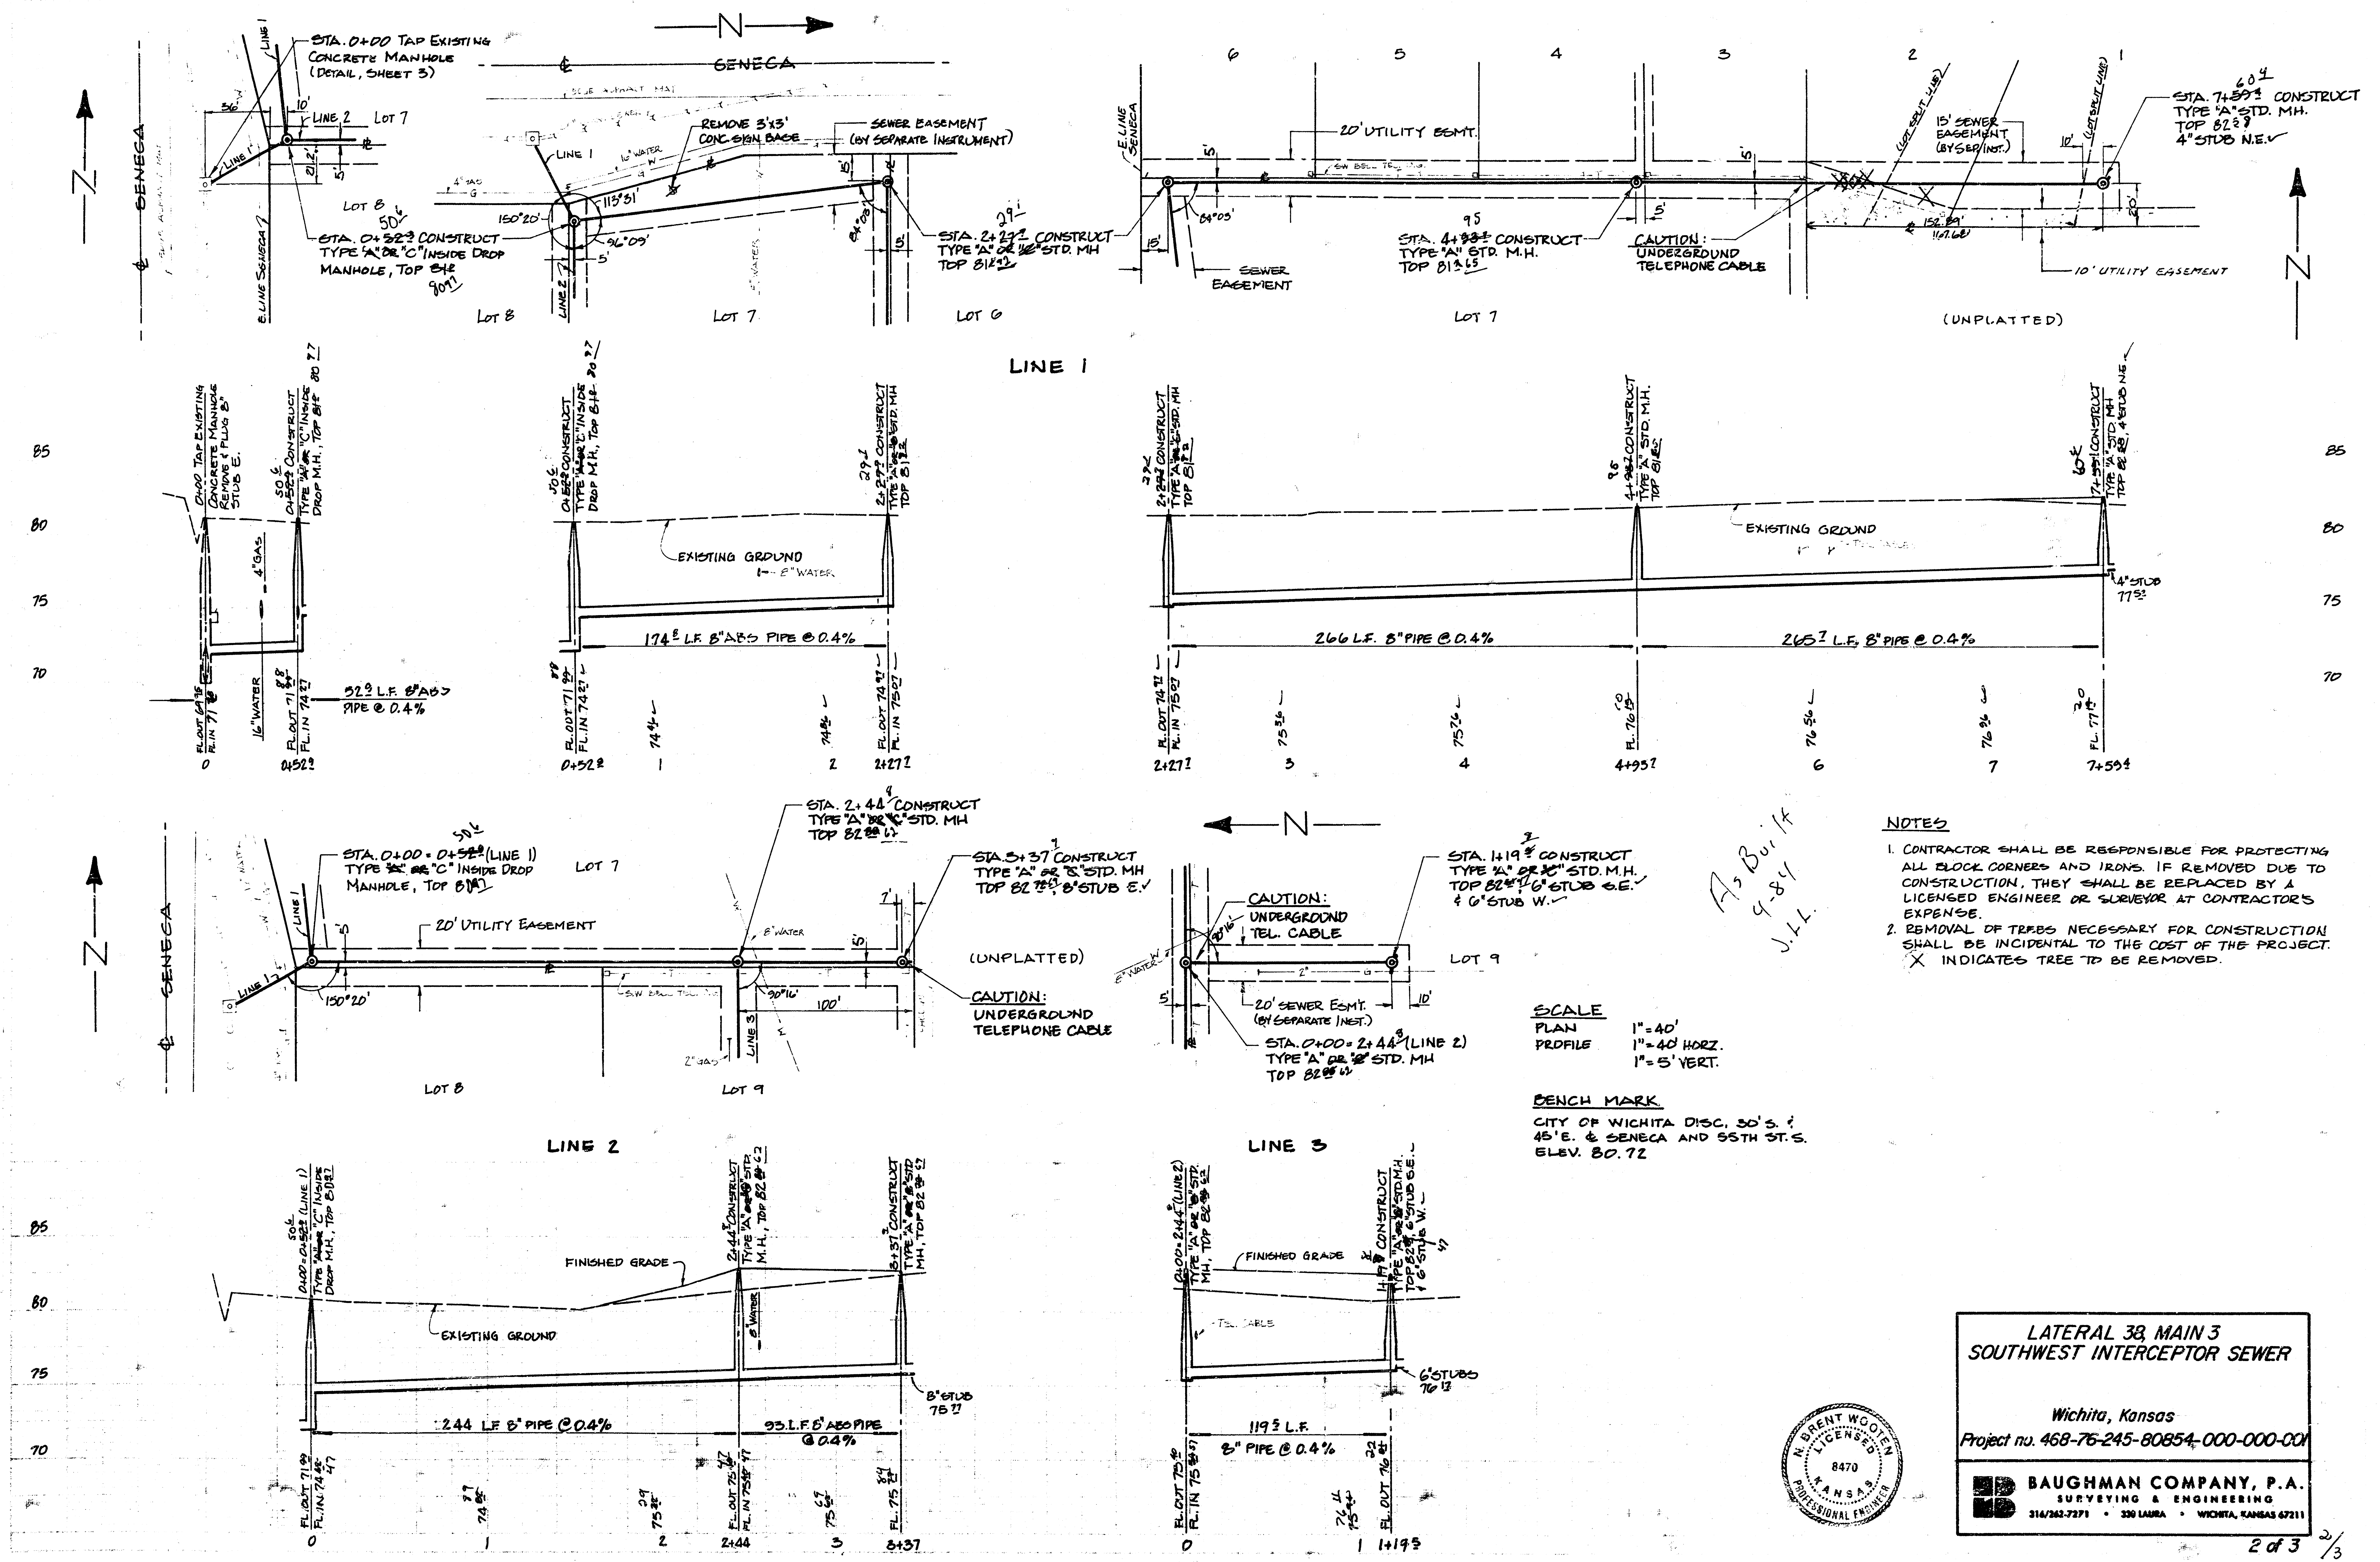



**LATERAL 38, MAIN 3
SOUTHWEST INTERCEPTOR SEWER**

Wichita, Kansas




Project no. 468-76-245-80854-000-000-000

BAUGHMAN COMPANY, P.A.
SURVEYING & ENGINEERING
314/363-7271 • 330 LAURA • WICHITA, KANSAS 67211

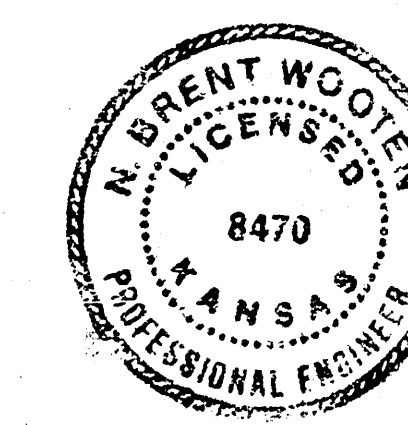

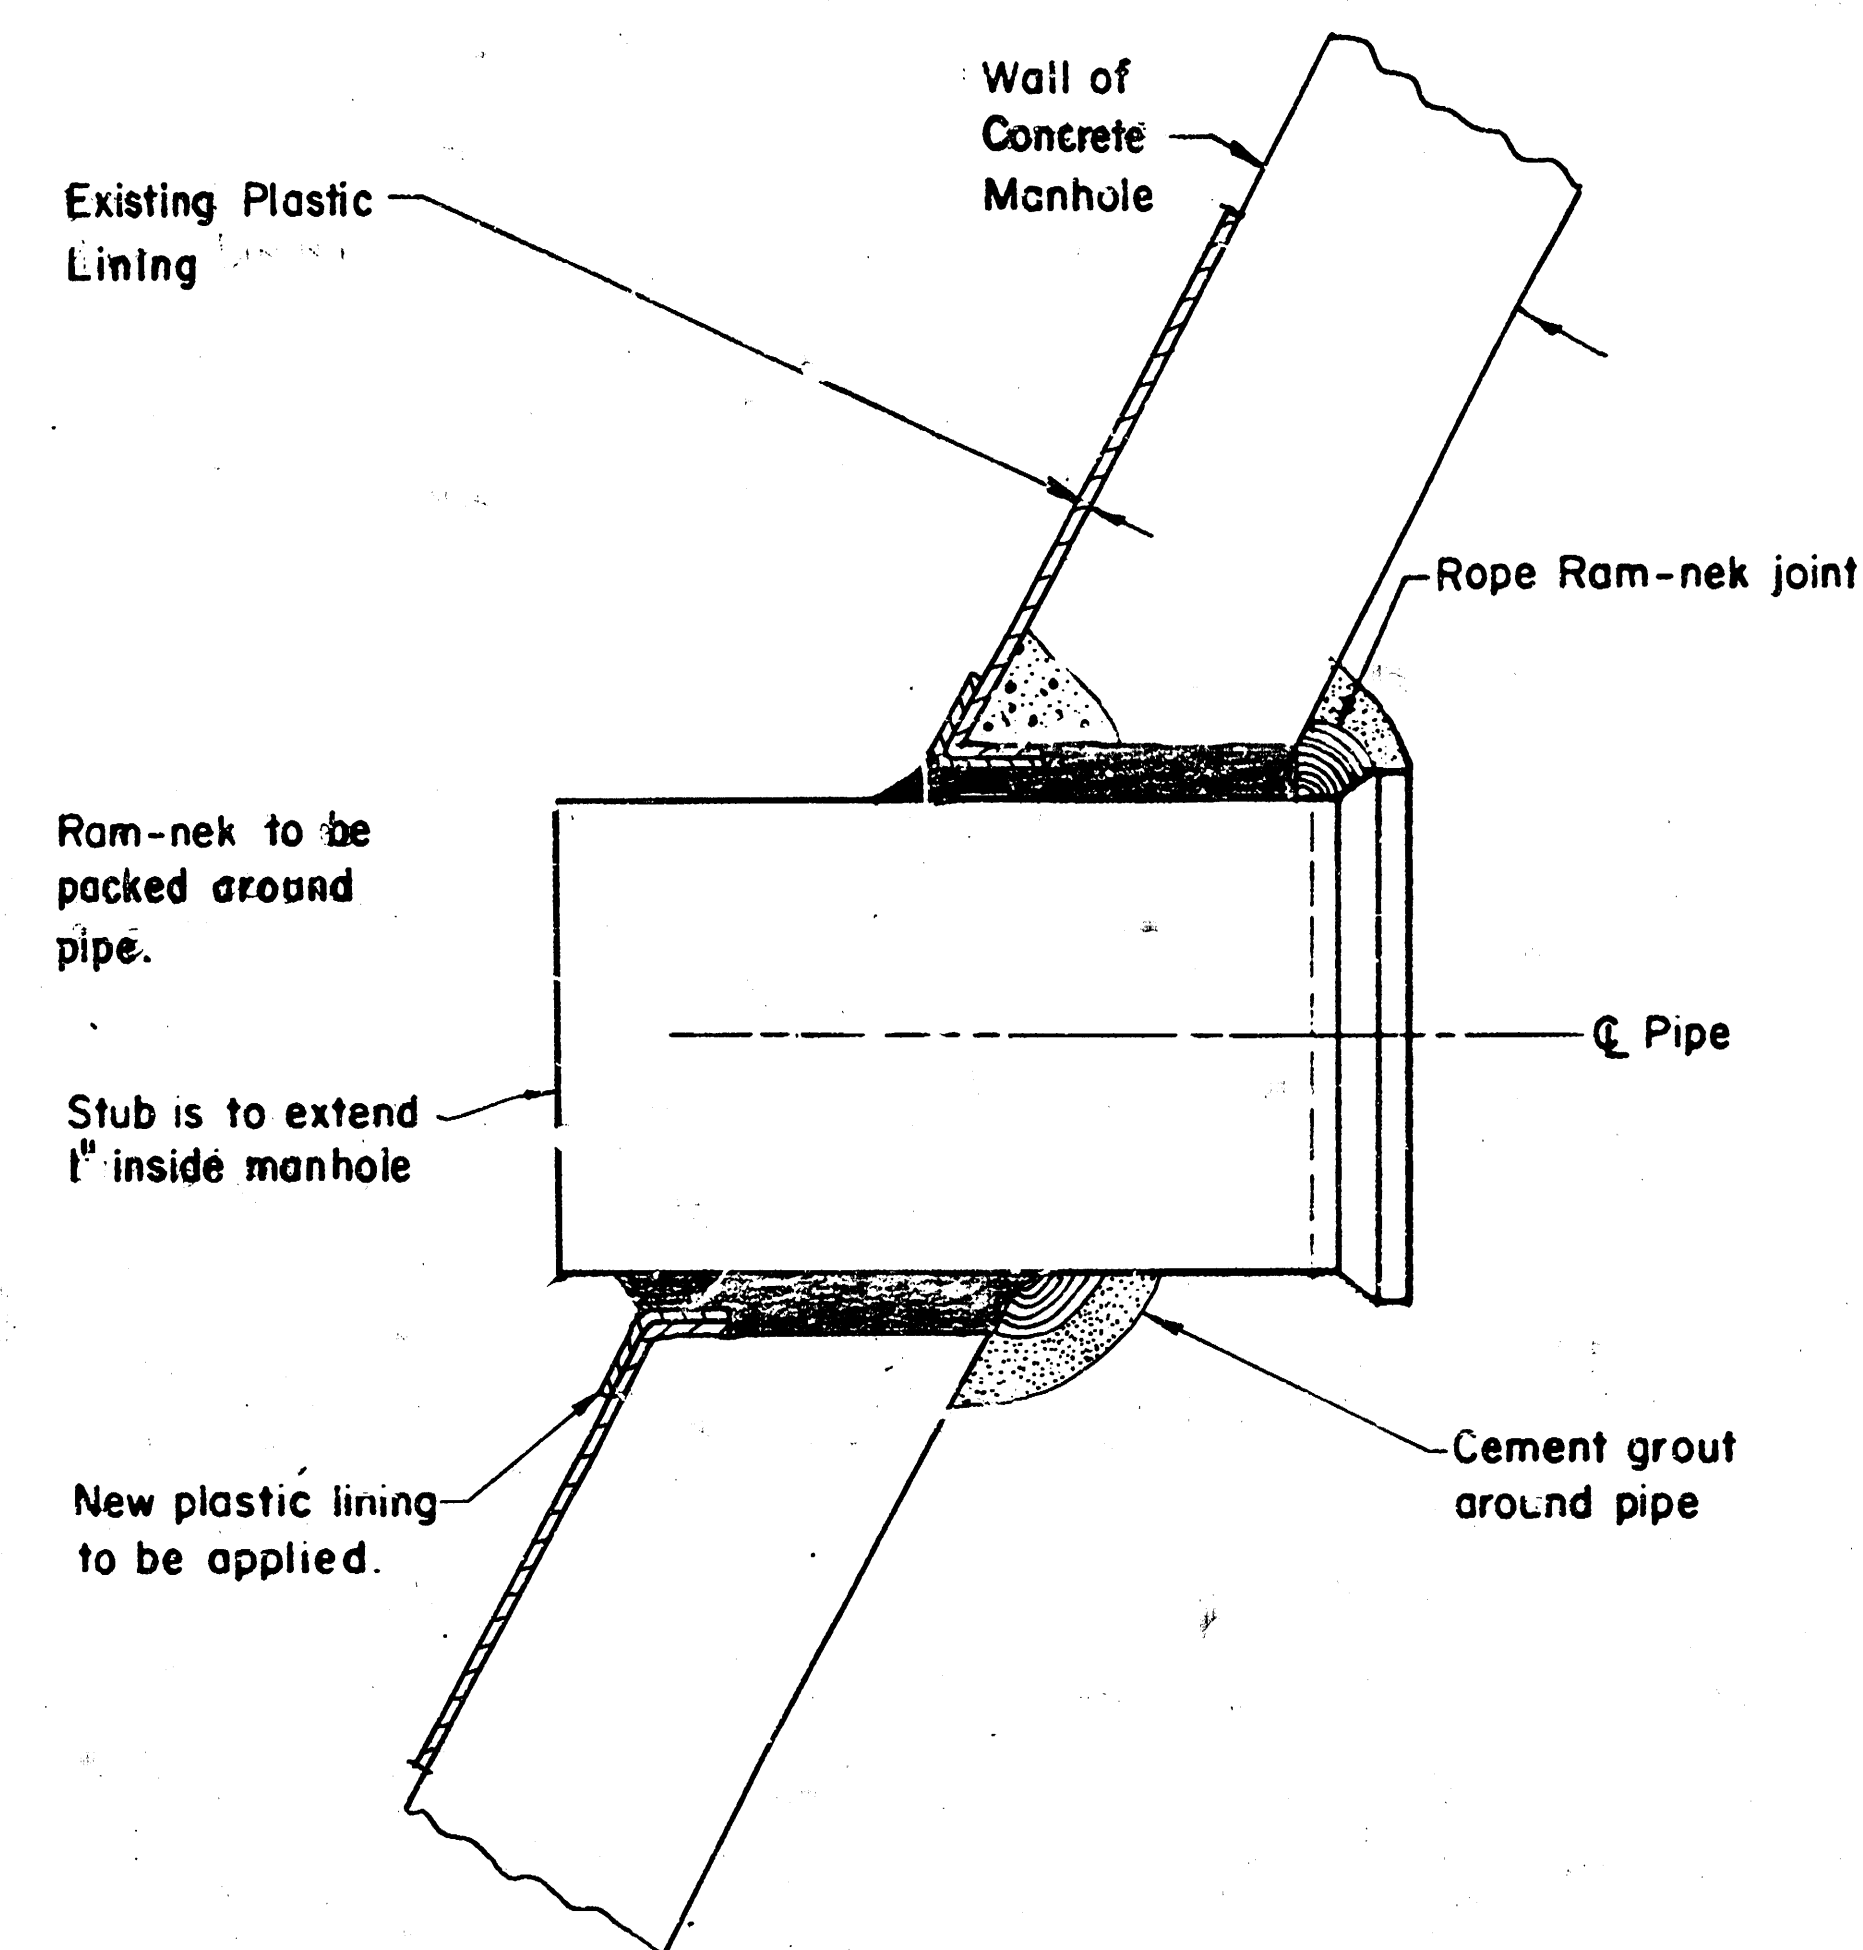

SECTIONAL PLAN

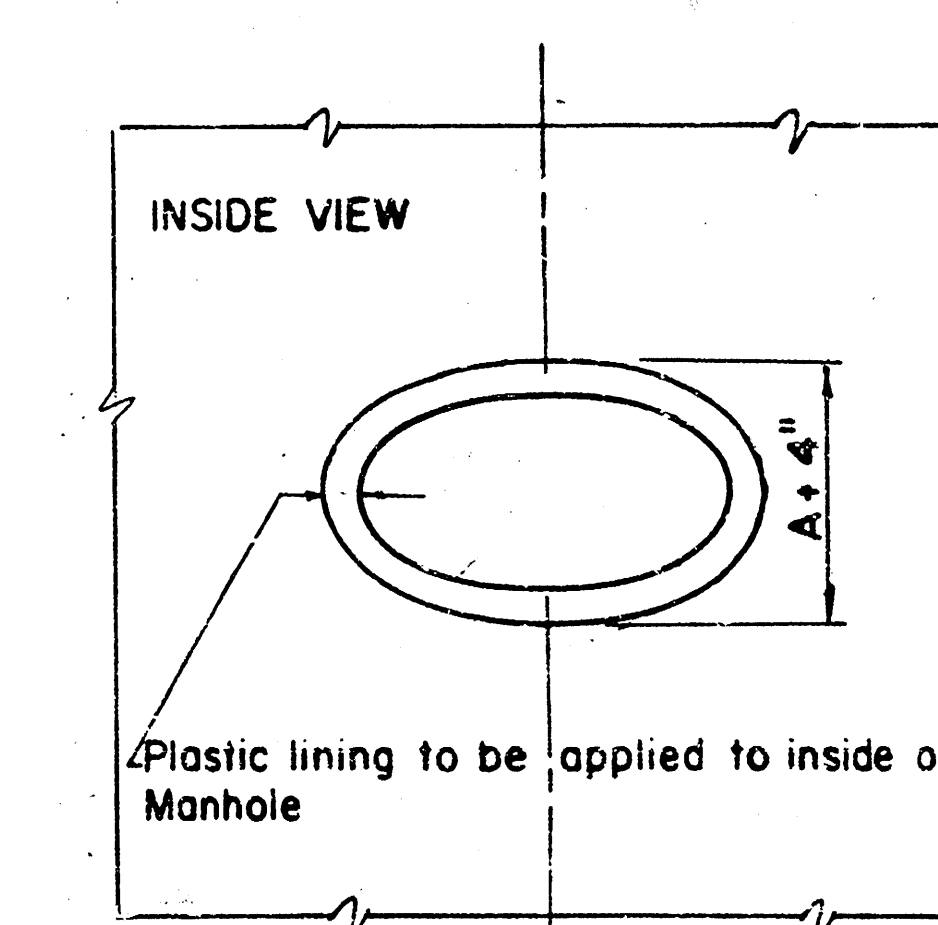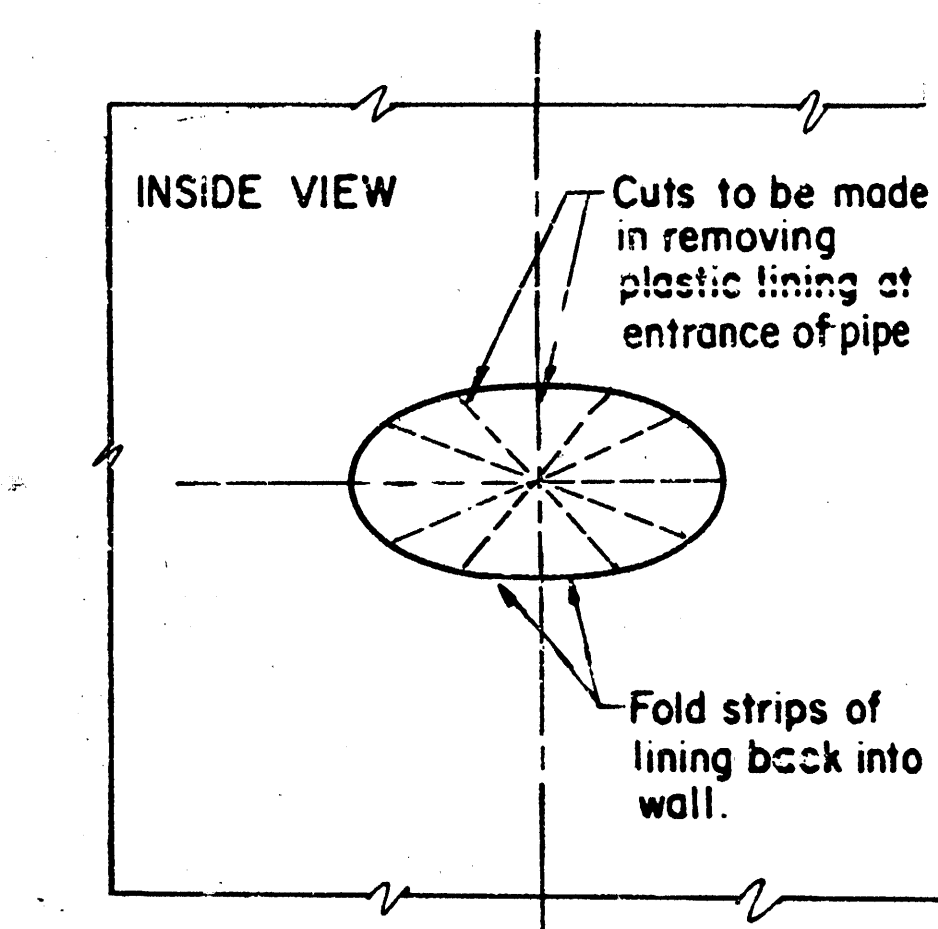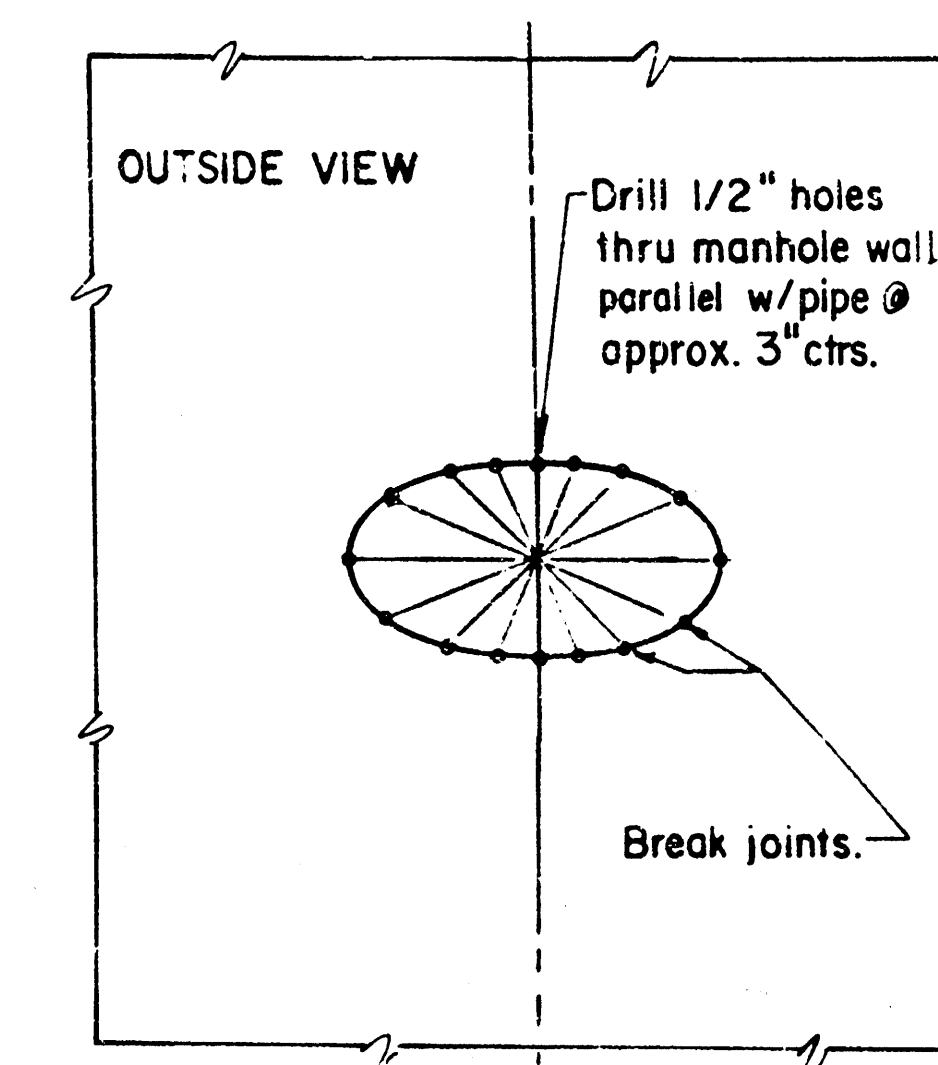

A = OUTSIDE DIAMETER OF PIPE + 2"

DETAIL OF PIPE CONNECTION
TO PLASTIC-LINED MANHOLE
CITY OF WICHITA, KANSAS

PROJECT NUMBER: 468-76-245-80854-000-000-001