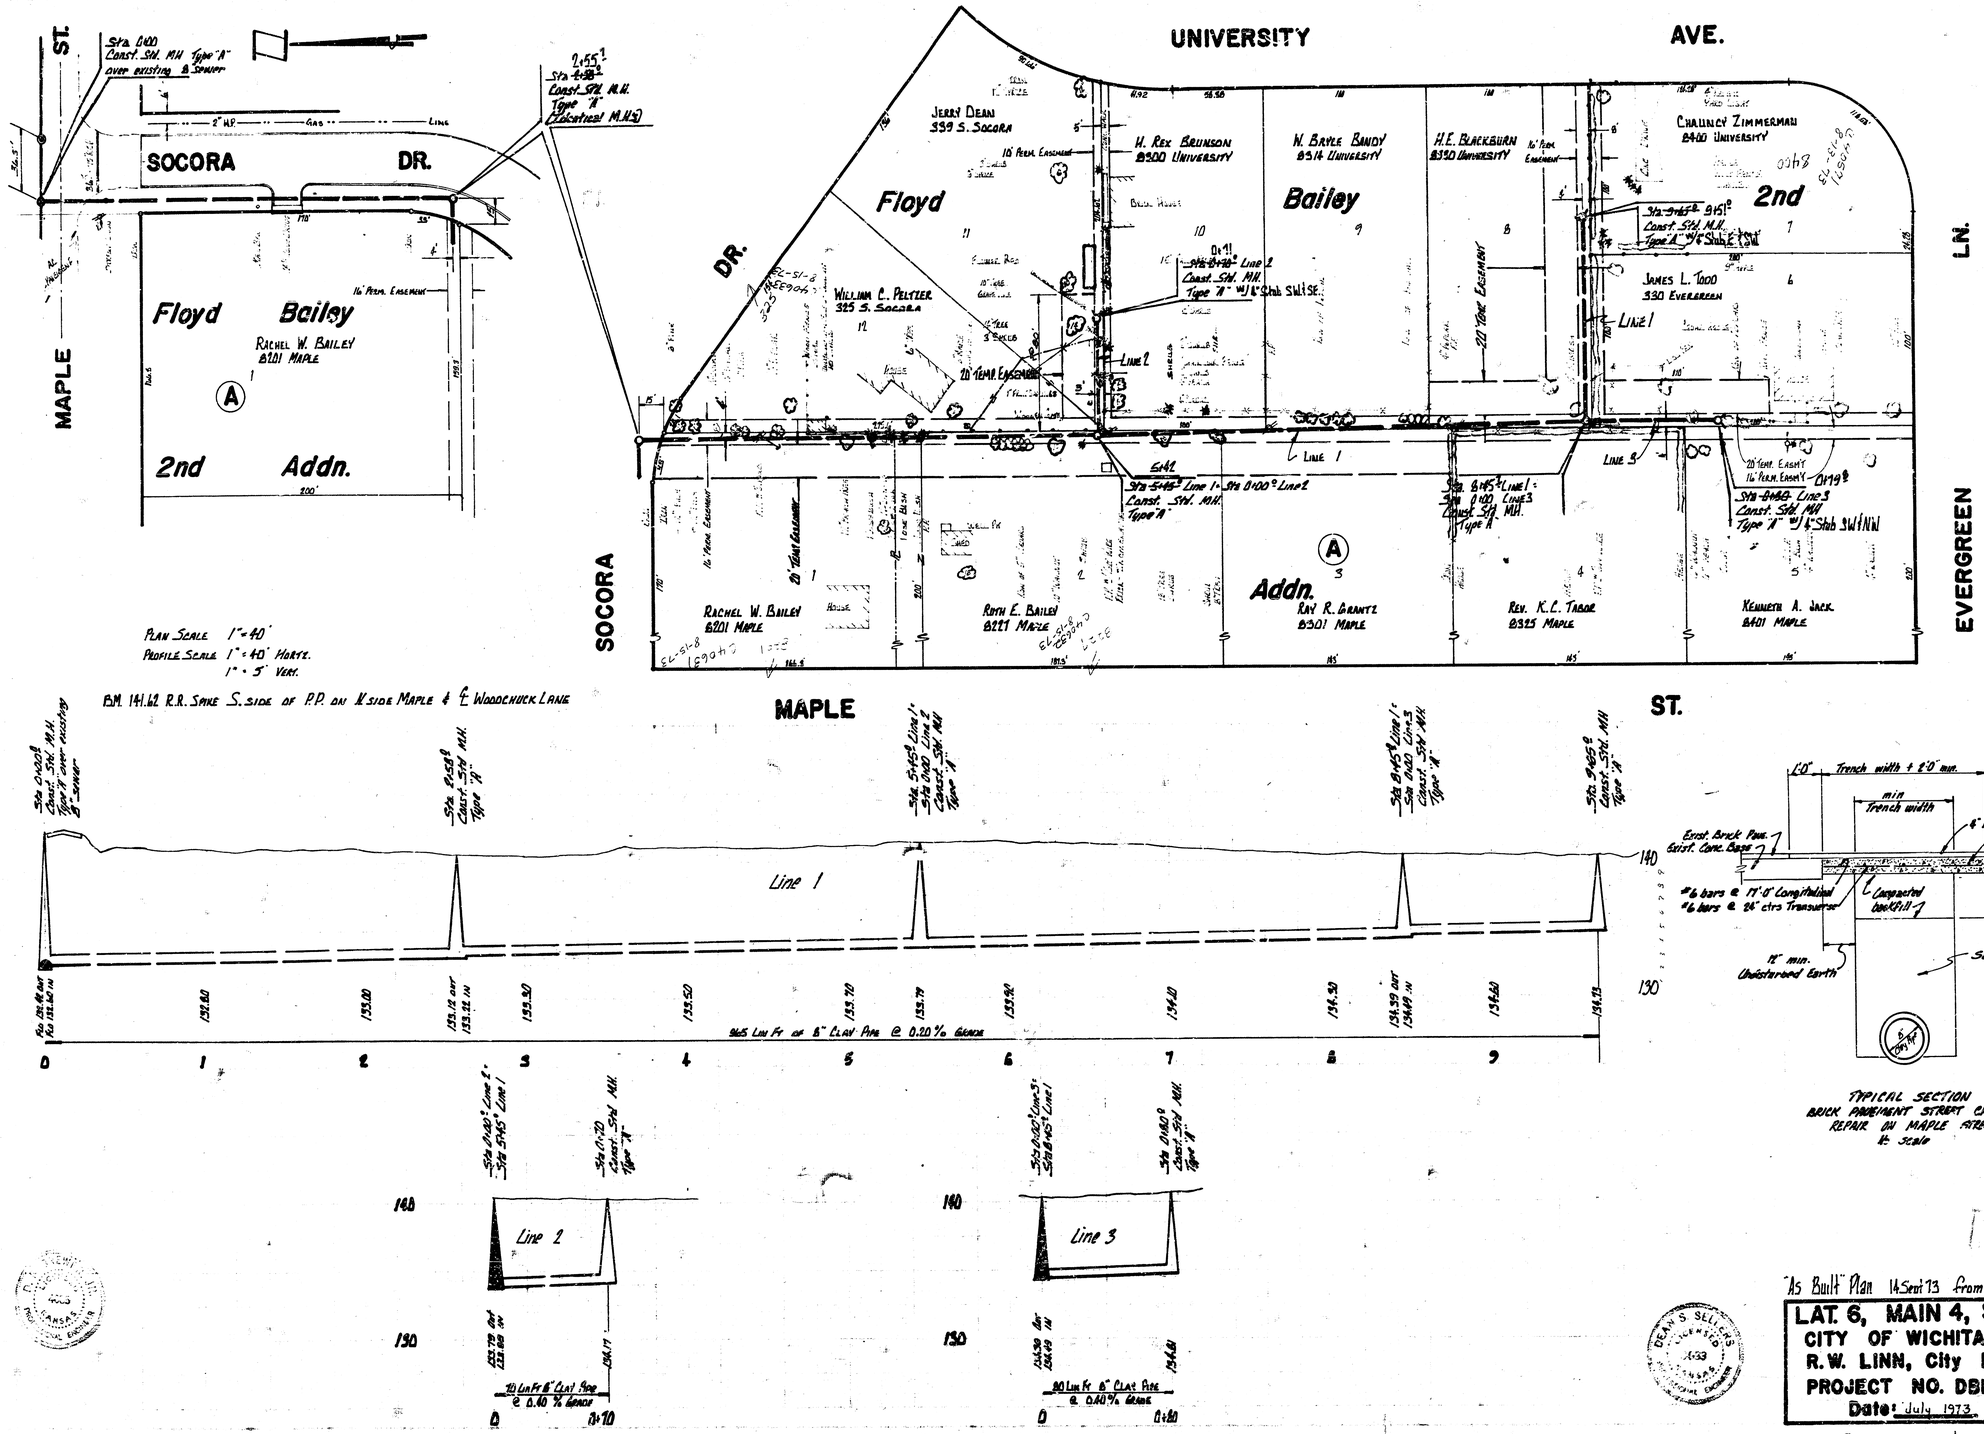

"As Built" Plan 14 Sept 73 from K-105

LAT. 6, MAIN 4, S.W. INT.
CITY OF WICHITA, KANSAS
R.W. LINN, City Engineer
PROJECT NO. DBKL571036
Date: July 1973

10-Sewer
1-Water

FILMED FROM THE BEST AVAILABLE COPY....