



B. M. 130.58 R. R. Spk. S-Side R. P. on N.E. cor. Taft & Ralstin

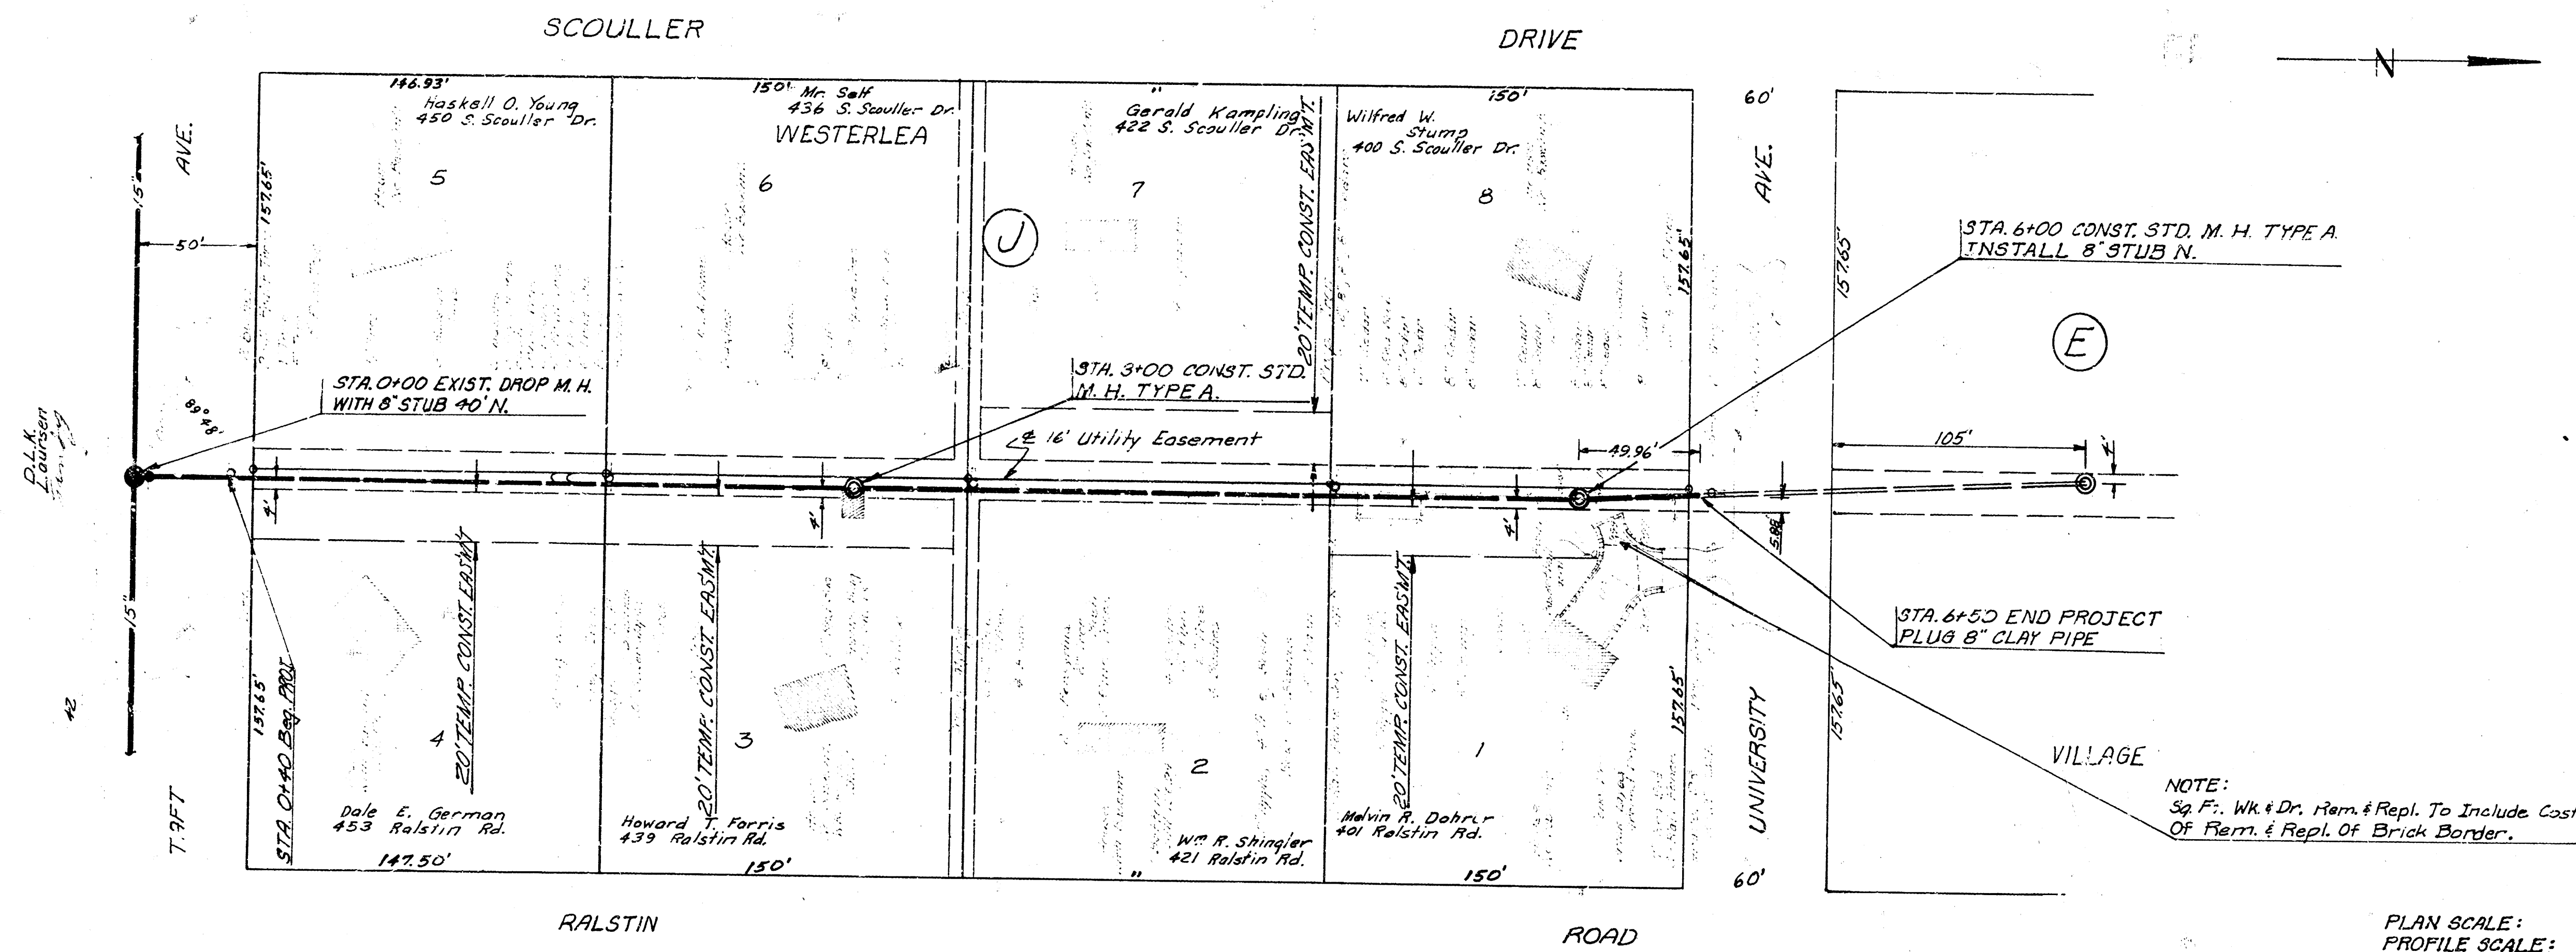

PLAN SCALE: 1"=40'
PROFILE SCALE: 1"=40' HOR. 1"=5' VERT.

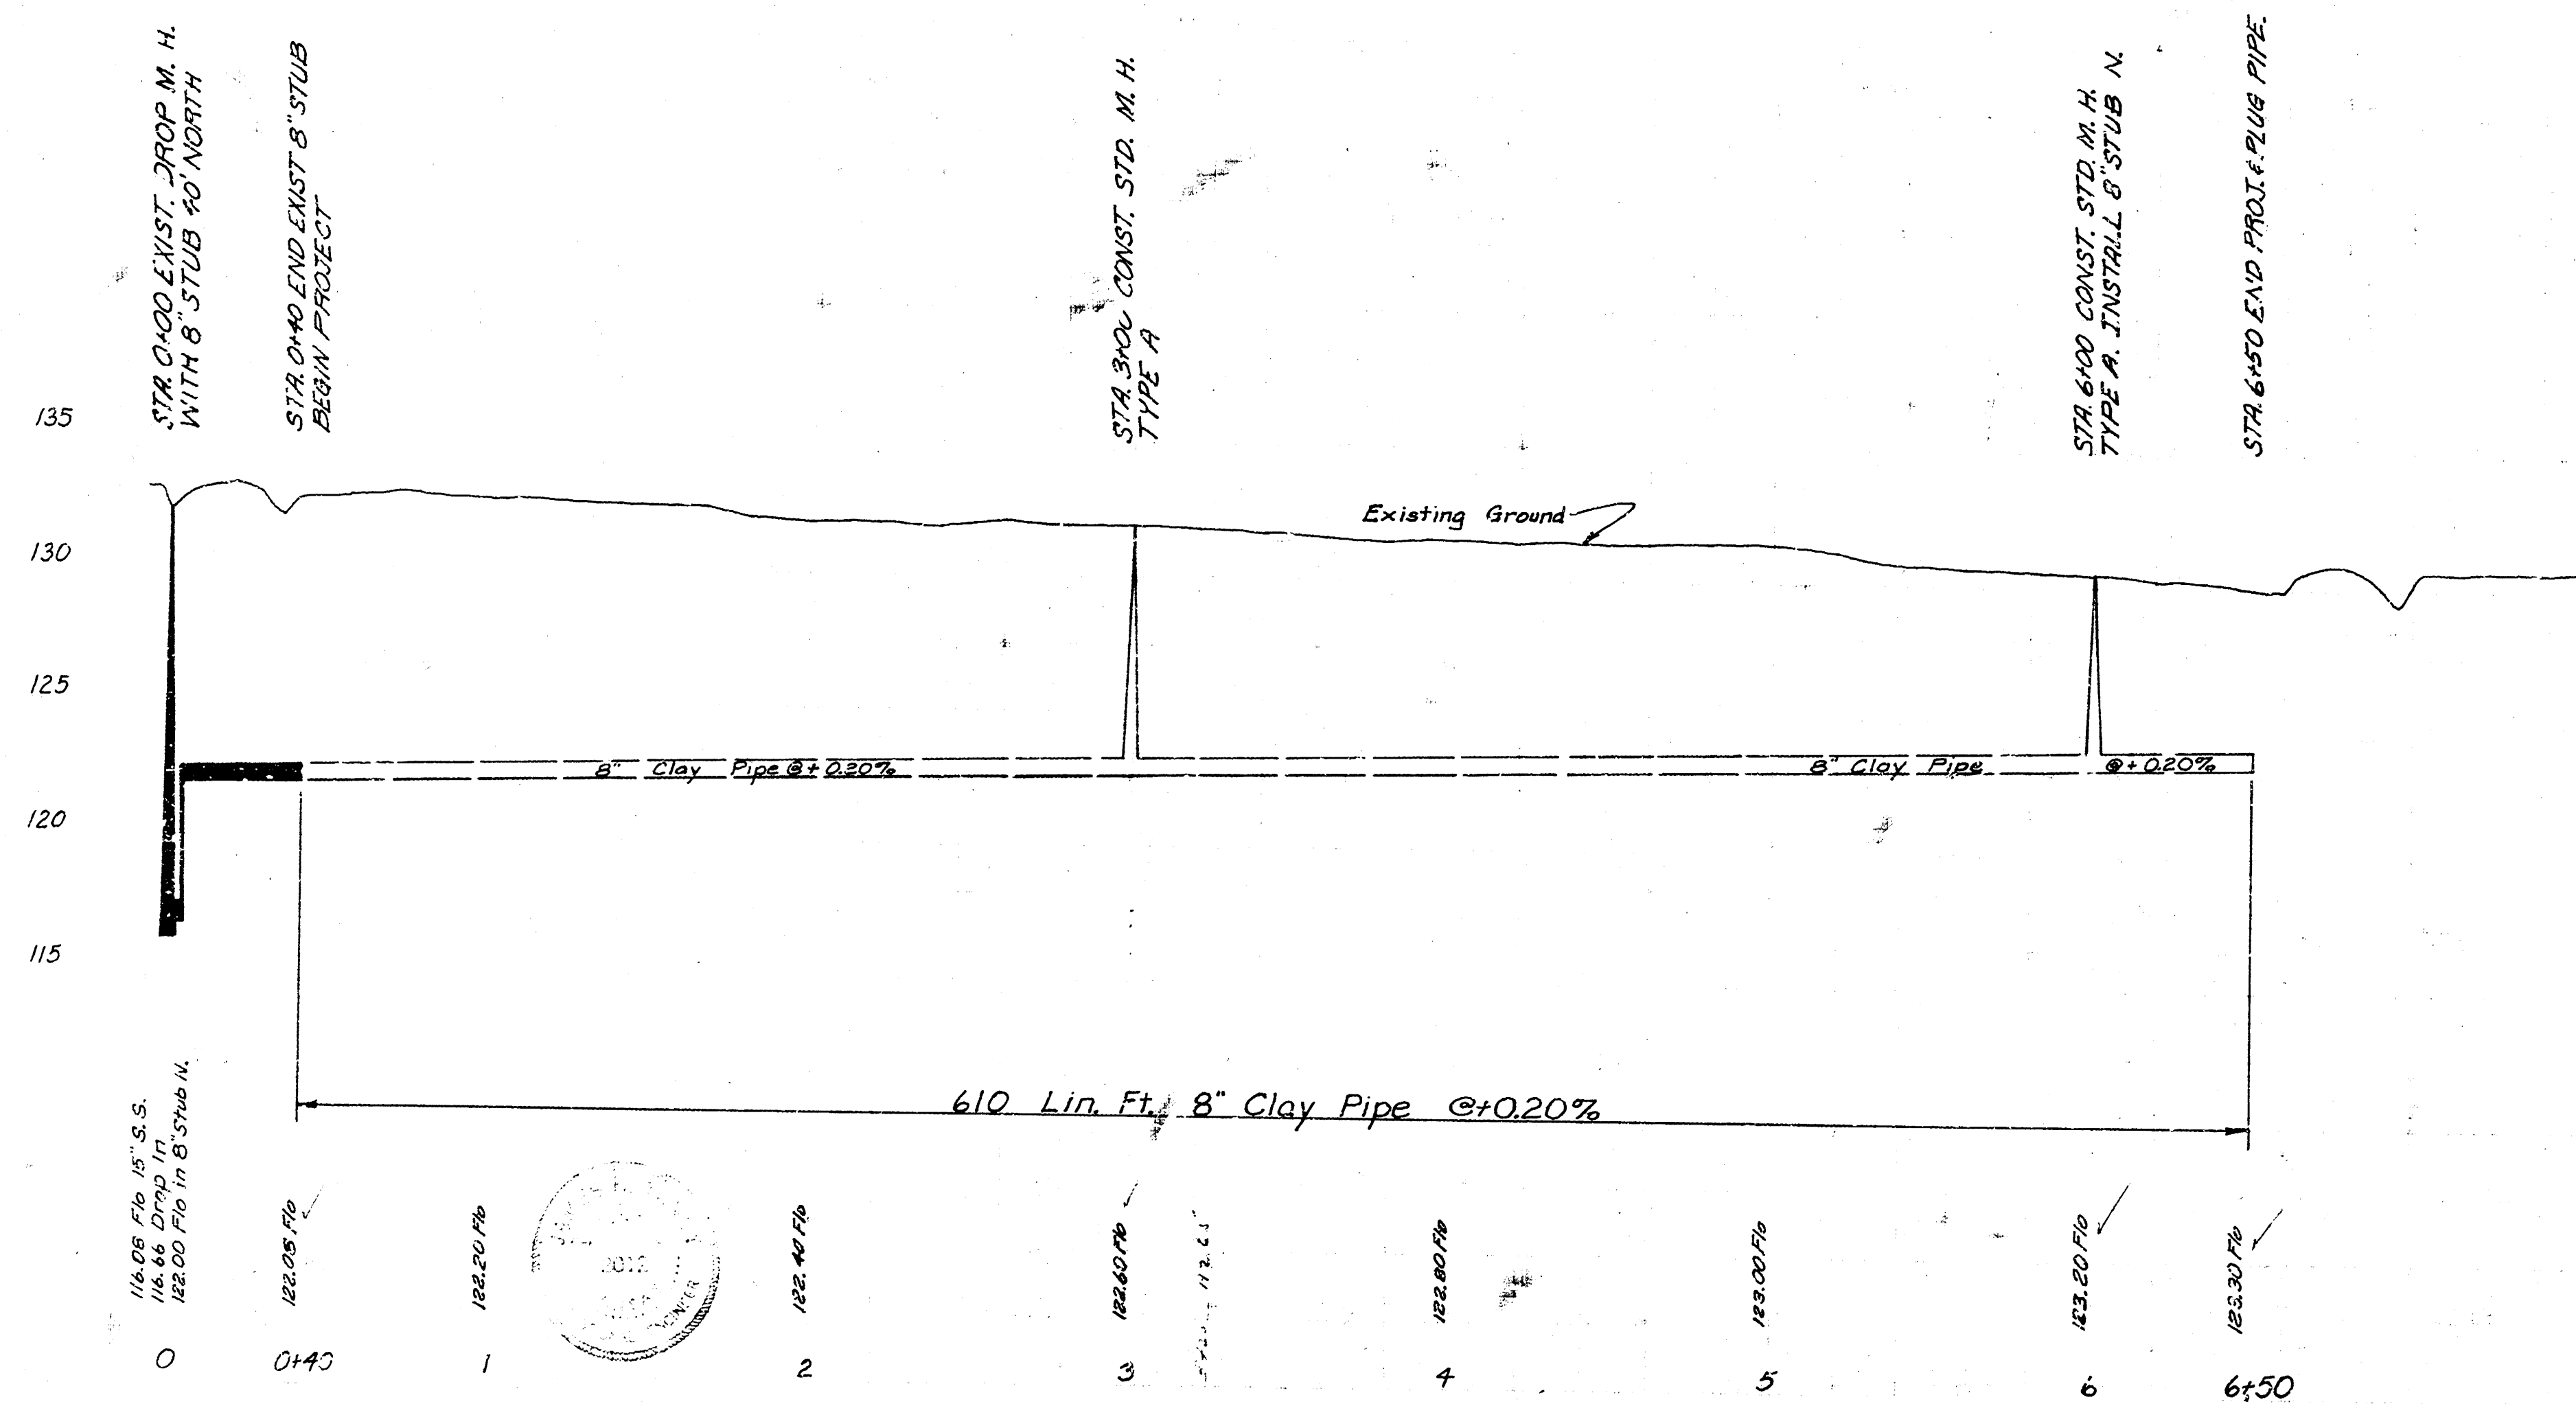

LAT. 12, MAIN 4, S. W. INTERCEPTOR SEWER
CITY OF WICHITA, KANSAS
R. W. LINN CITY ENGINEER
PROJ. NO. DBKL 572009 DATE: MAR. 1972

14 3 4 2