

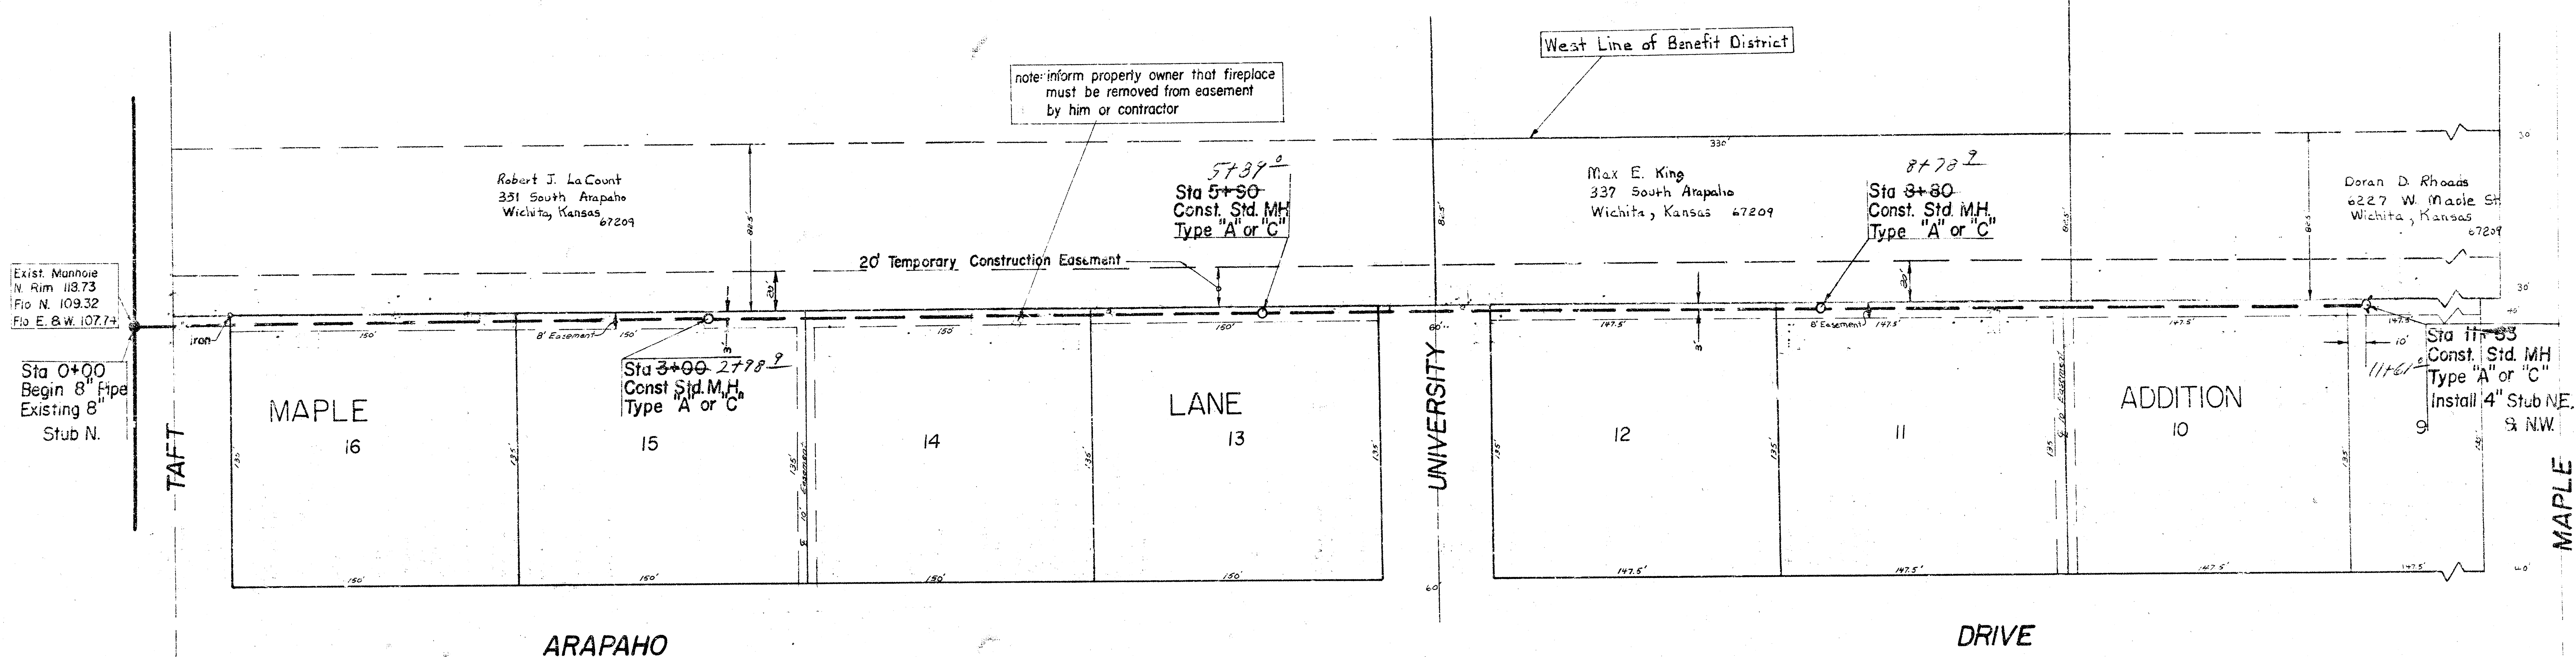


BM 121.85 City disc 337' W. & 343' S. of NW. cor. of N.E. 1/4, Sec. 27 T27S R1W
 BM 120.90 R.R. spike SW. side Bell pole 30' S. of Q. Maple & approx. 200' W. W.L. Arapaho
 BM 119.74 R.R. spike W. side Power pole, 150' N. of N.L. Taft & 135' W. W.L. Arapaho

Plan Scale 1" = 40'
 Profile Scale 1" = 40' Horiz.
 1" = 5' Vert.

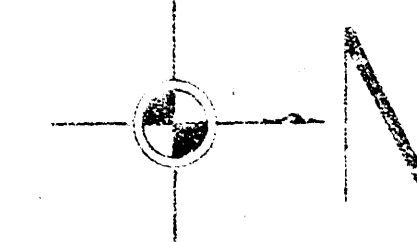

NOTE: CONTRACTOR SHALL NOT REMOVE ANY TREES WITHOUT FIRST OBTAINING APPROVAL FROM THE ENGINEER.

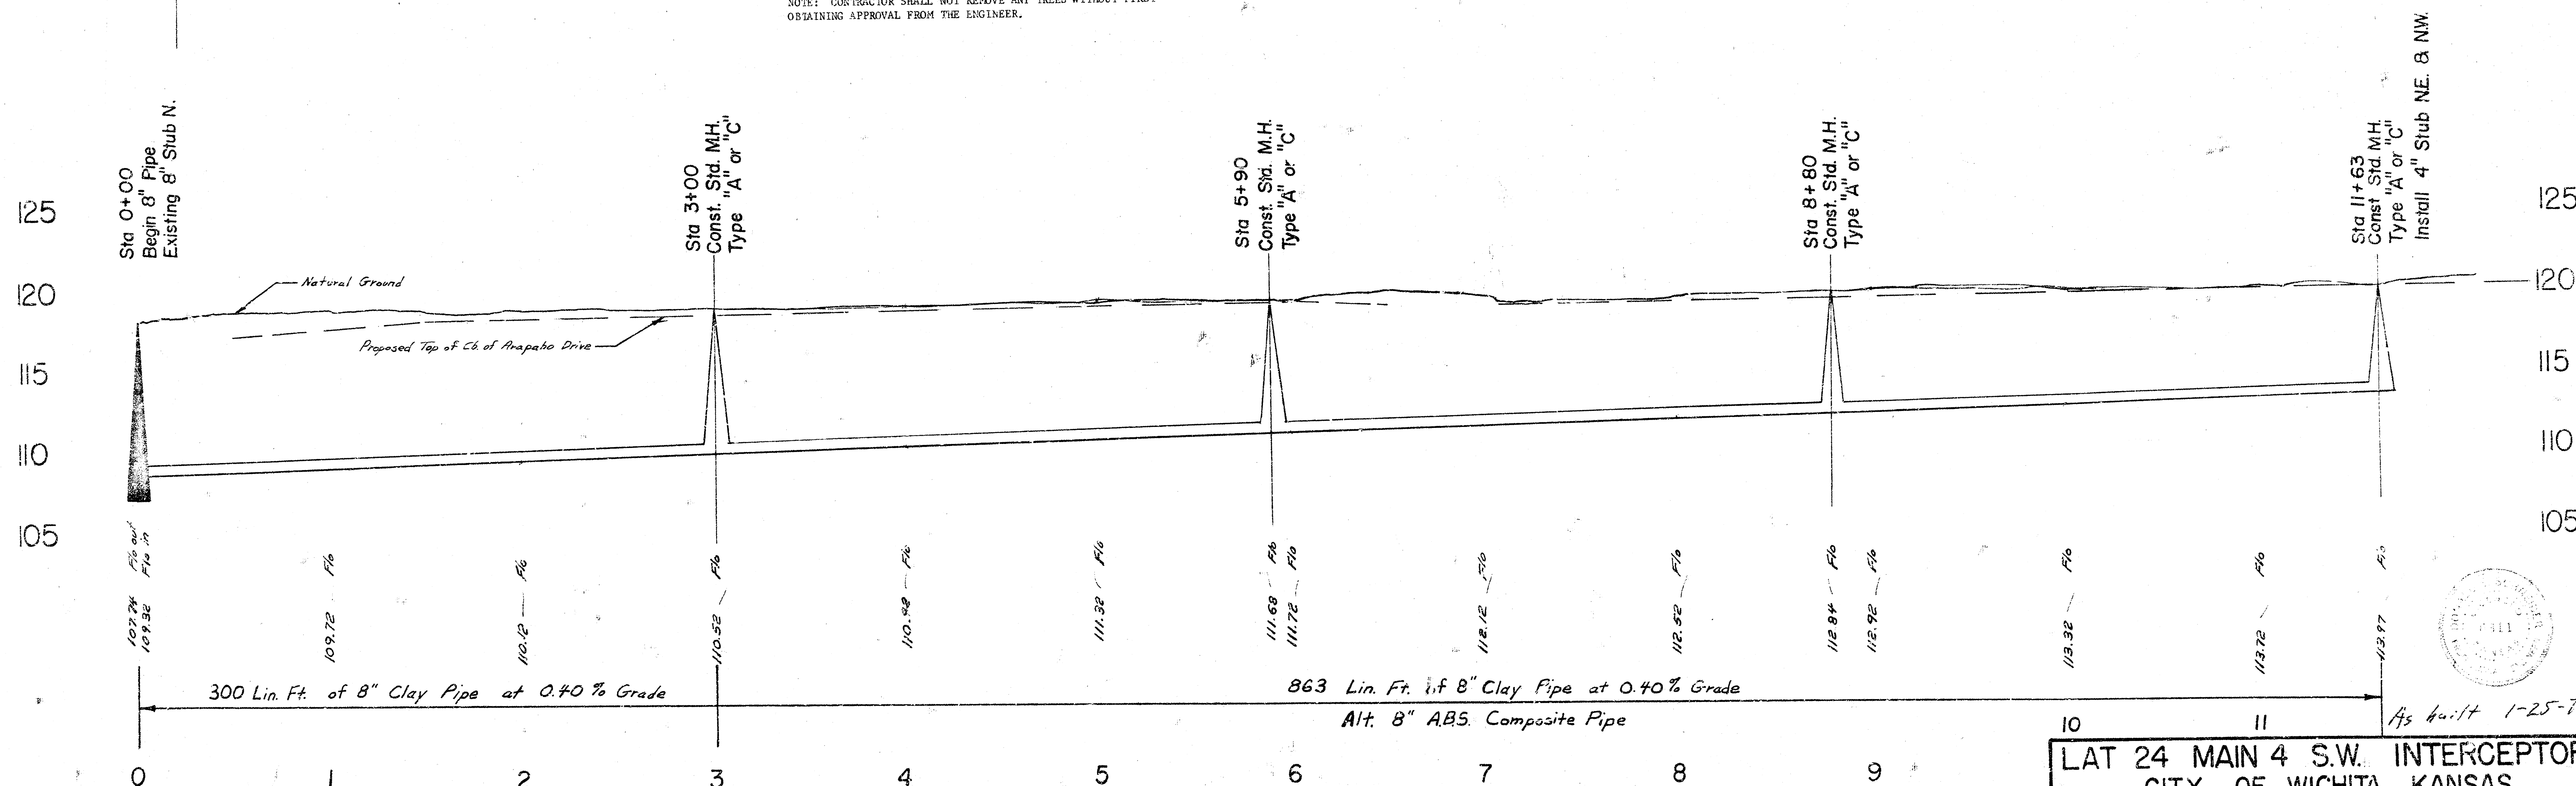

LAT 24 MAIN 4 S.W. INTERCEPTOR
 CITY OF WICHITA, KANSAS
 R. W. LINN — CITY ENGINEER
 Project Number DBKL576031
 Nov 1976