


Lateral 34, Main 4, Southwest Interceptor 468-76-245-80856-000-000-001

CITY of WICHITA, KANSAS
DEPT. of PUBLIC WORKS-ENG. DIV.
DEAN S. SELLERS-ACTING CITY ENGINEER
DATE _____


NOTE: FIELD ENGINEER SHALL SET TOPS OF MANHOLES TO MATCH PROPOSED FINISHED GRADE AS SHOWN ON THIS PLAN. ALL RISERS SHALL BE CONSTRUCTED TO MATCH PROPOSED FINISHED GRADE. RISERS AND ADDITIONAL RISERS SHALL BE INSTALLED ON THIS PROJECT TO SERVE INDIVIDUAL LOTS AS SHOWN ON THIS PLAN. ENGINEER. RISER CONSTRUCTION SHALL CONFORM TO THE REQUIREMENTS AS SHOWN ON THESE PLANS. THE TOP OF THE RISERS SHALL BE MARKED BY PATENTED GLENN-LEARNED CONCRETE RISE MARKERS. THE TOP OF THE RISERS SHALL BE TO THE GROUND SURFACE AS THE EXCAVATION IS BACKFILLED SUCH THAT THE RISERS WILL BE VISIBLE WHEN THE PROJECT IS COMPLETED. ALL RISERS SHALL BE CONSTRUCTED USING S.D. 15 RISERS OR E.V. 15 RISERS. ELEVATIONS OF ALL RISERS SHALL BE SUCH THAT WILL FACILITATE DRAINAGE OF ALL LOTS AND THE RISERS SHALL BE CONSTRUCTED.



General Notes

1. Field Engineer to Set Top of Manholes to Match Proposed Finished Grade as Shown on Plans. If Manholes are Destroyed or Damaged, They Shall Be Replaced and Rebuilt to Match Proposed Finished Grade.
2. Contractor to Contact Utility Companies for Location of any Underground Lines.
3. Field Engineer to Set Top of Manholes to Finish Grade as Determined by the Developer Unless Otherwise Noted on Plans.

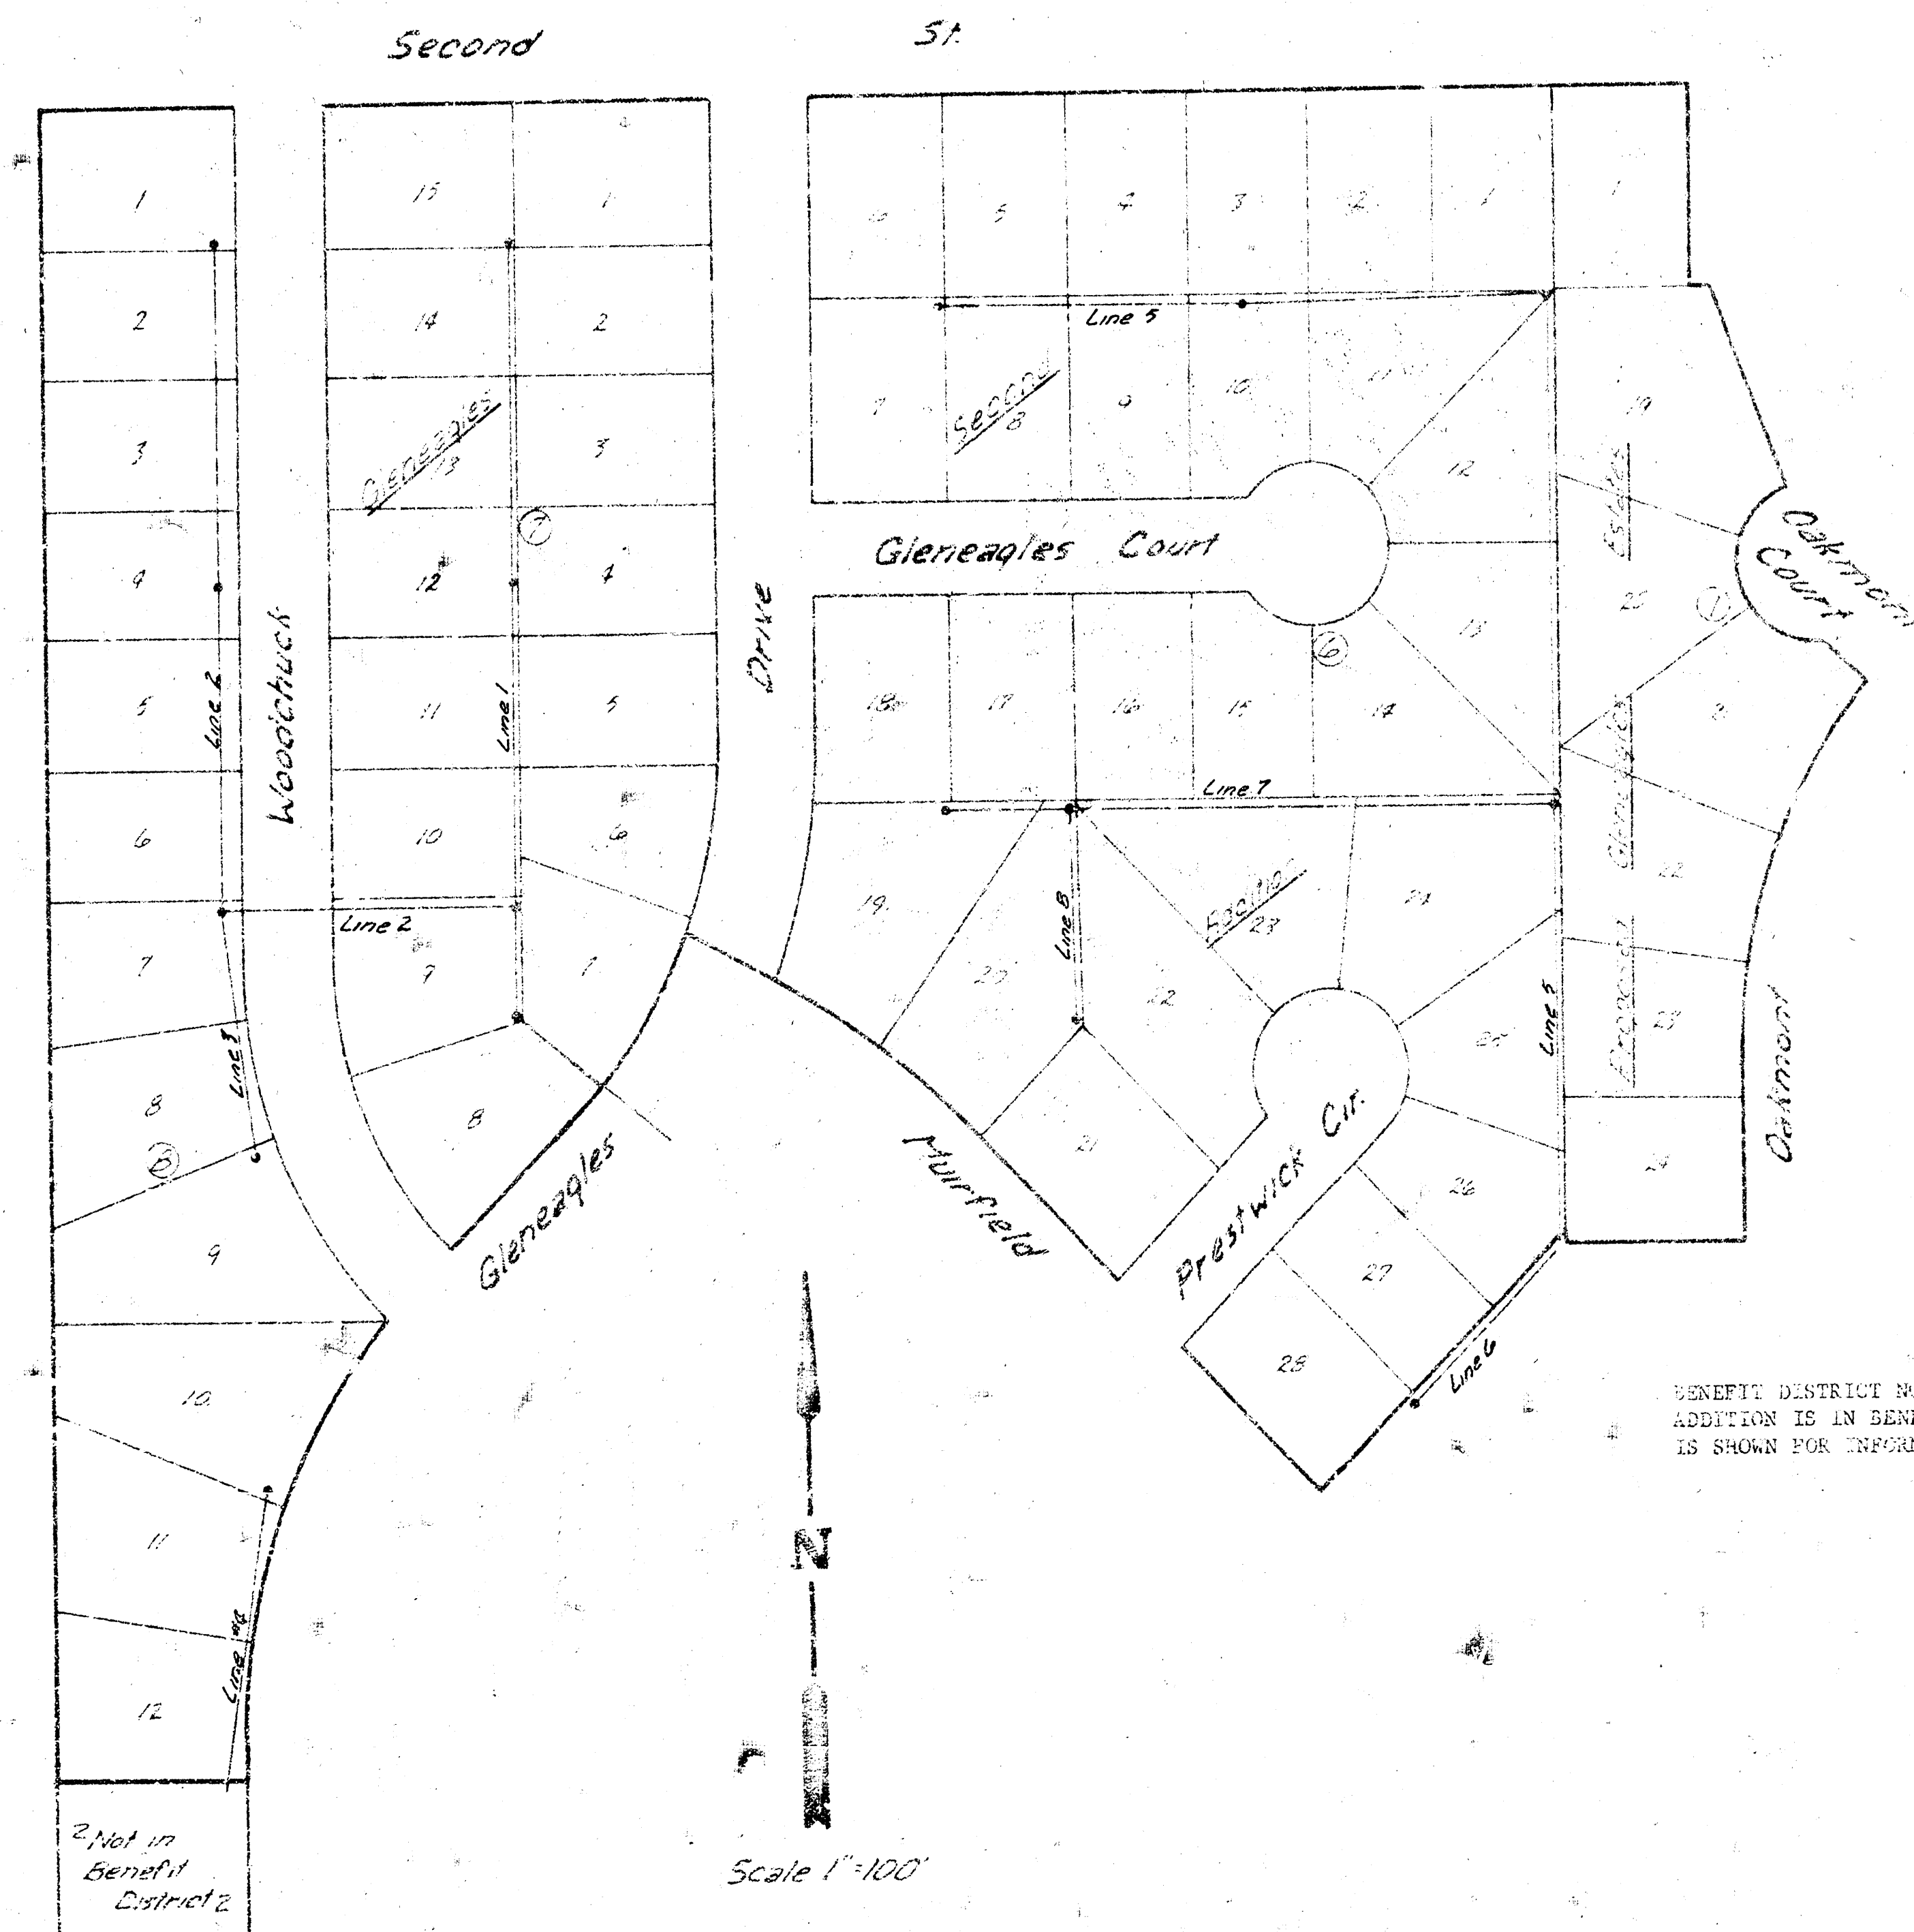


As. Div. 4 11/15/20
J.L. 8384

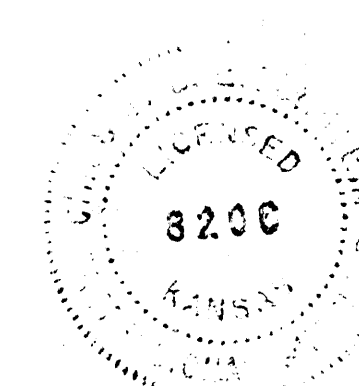

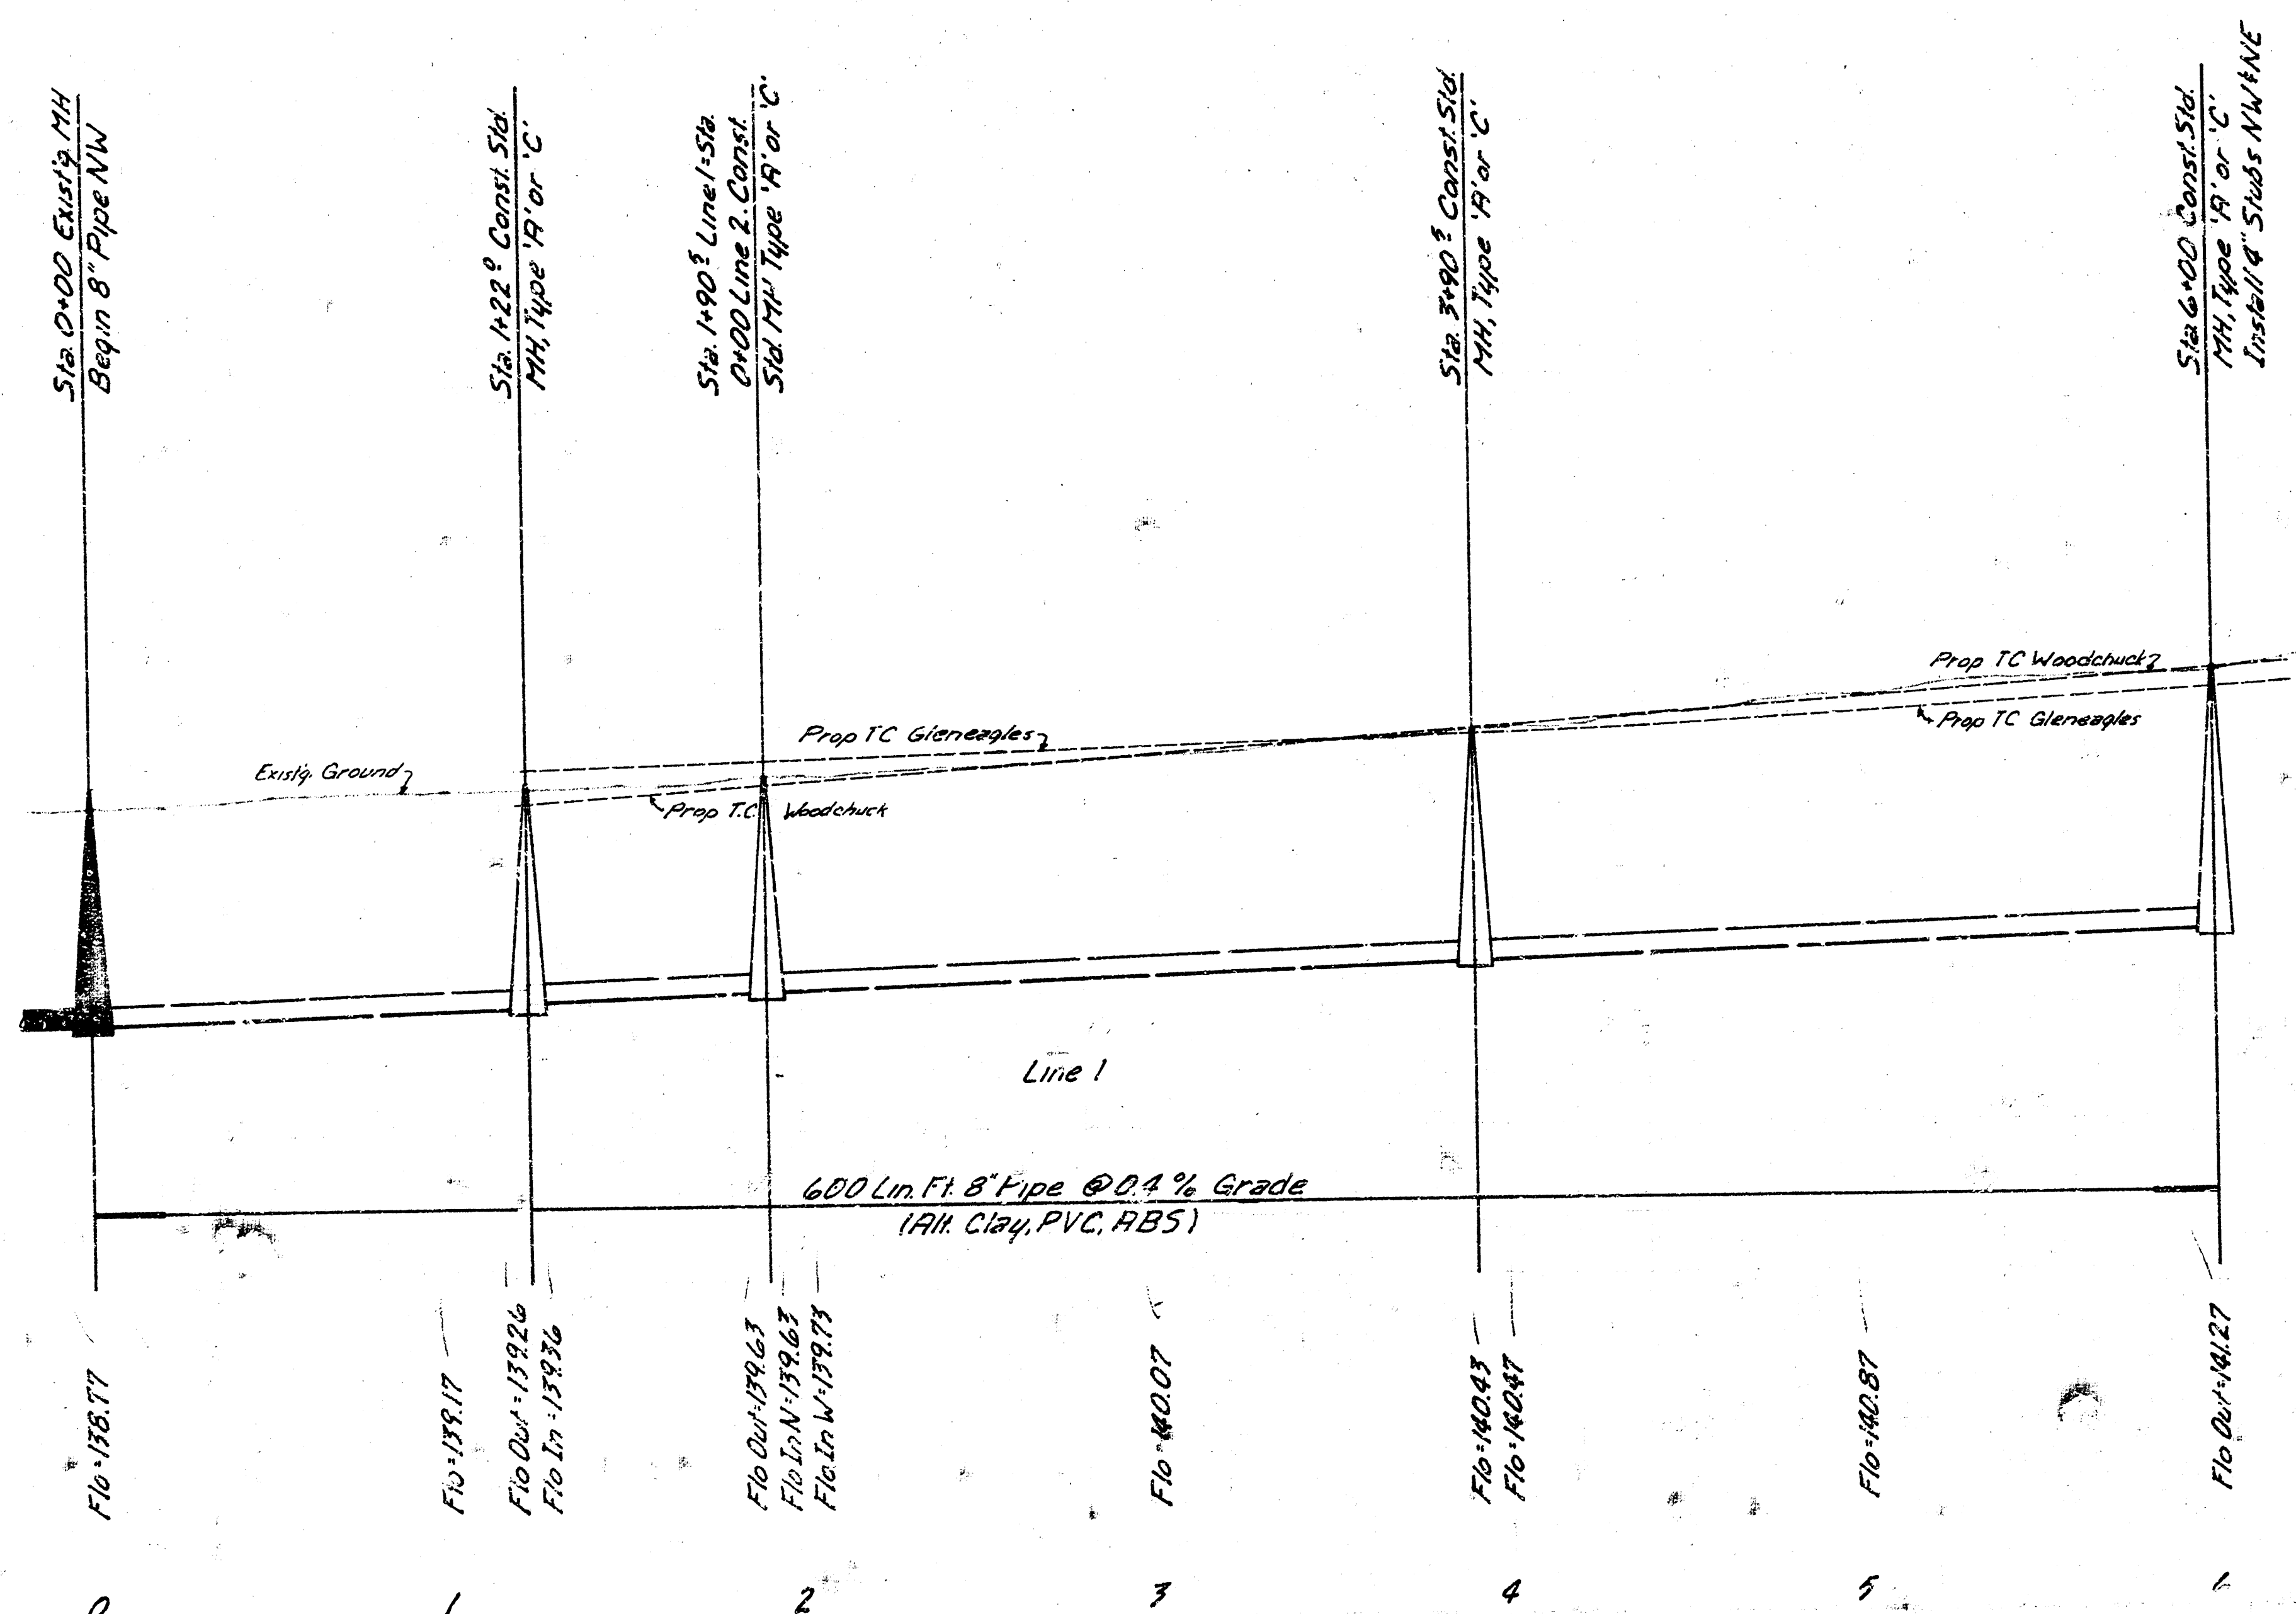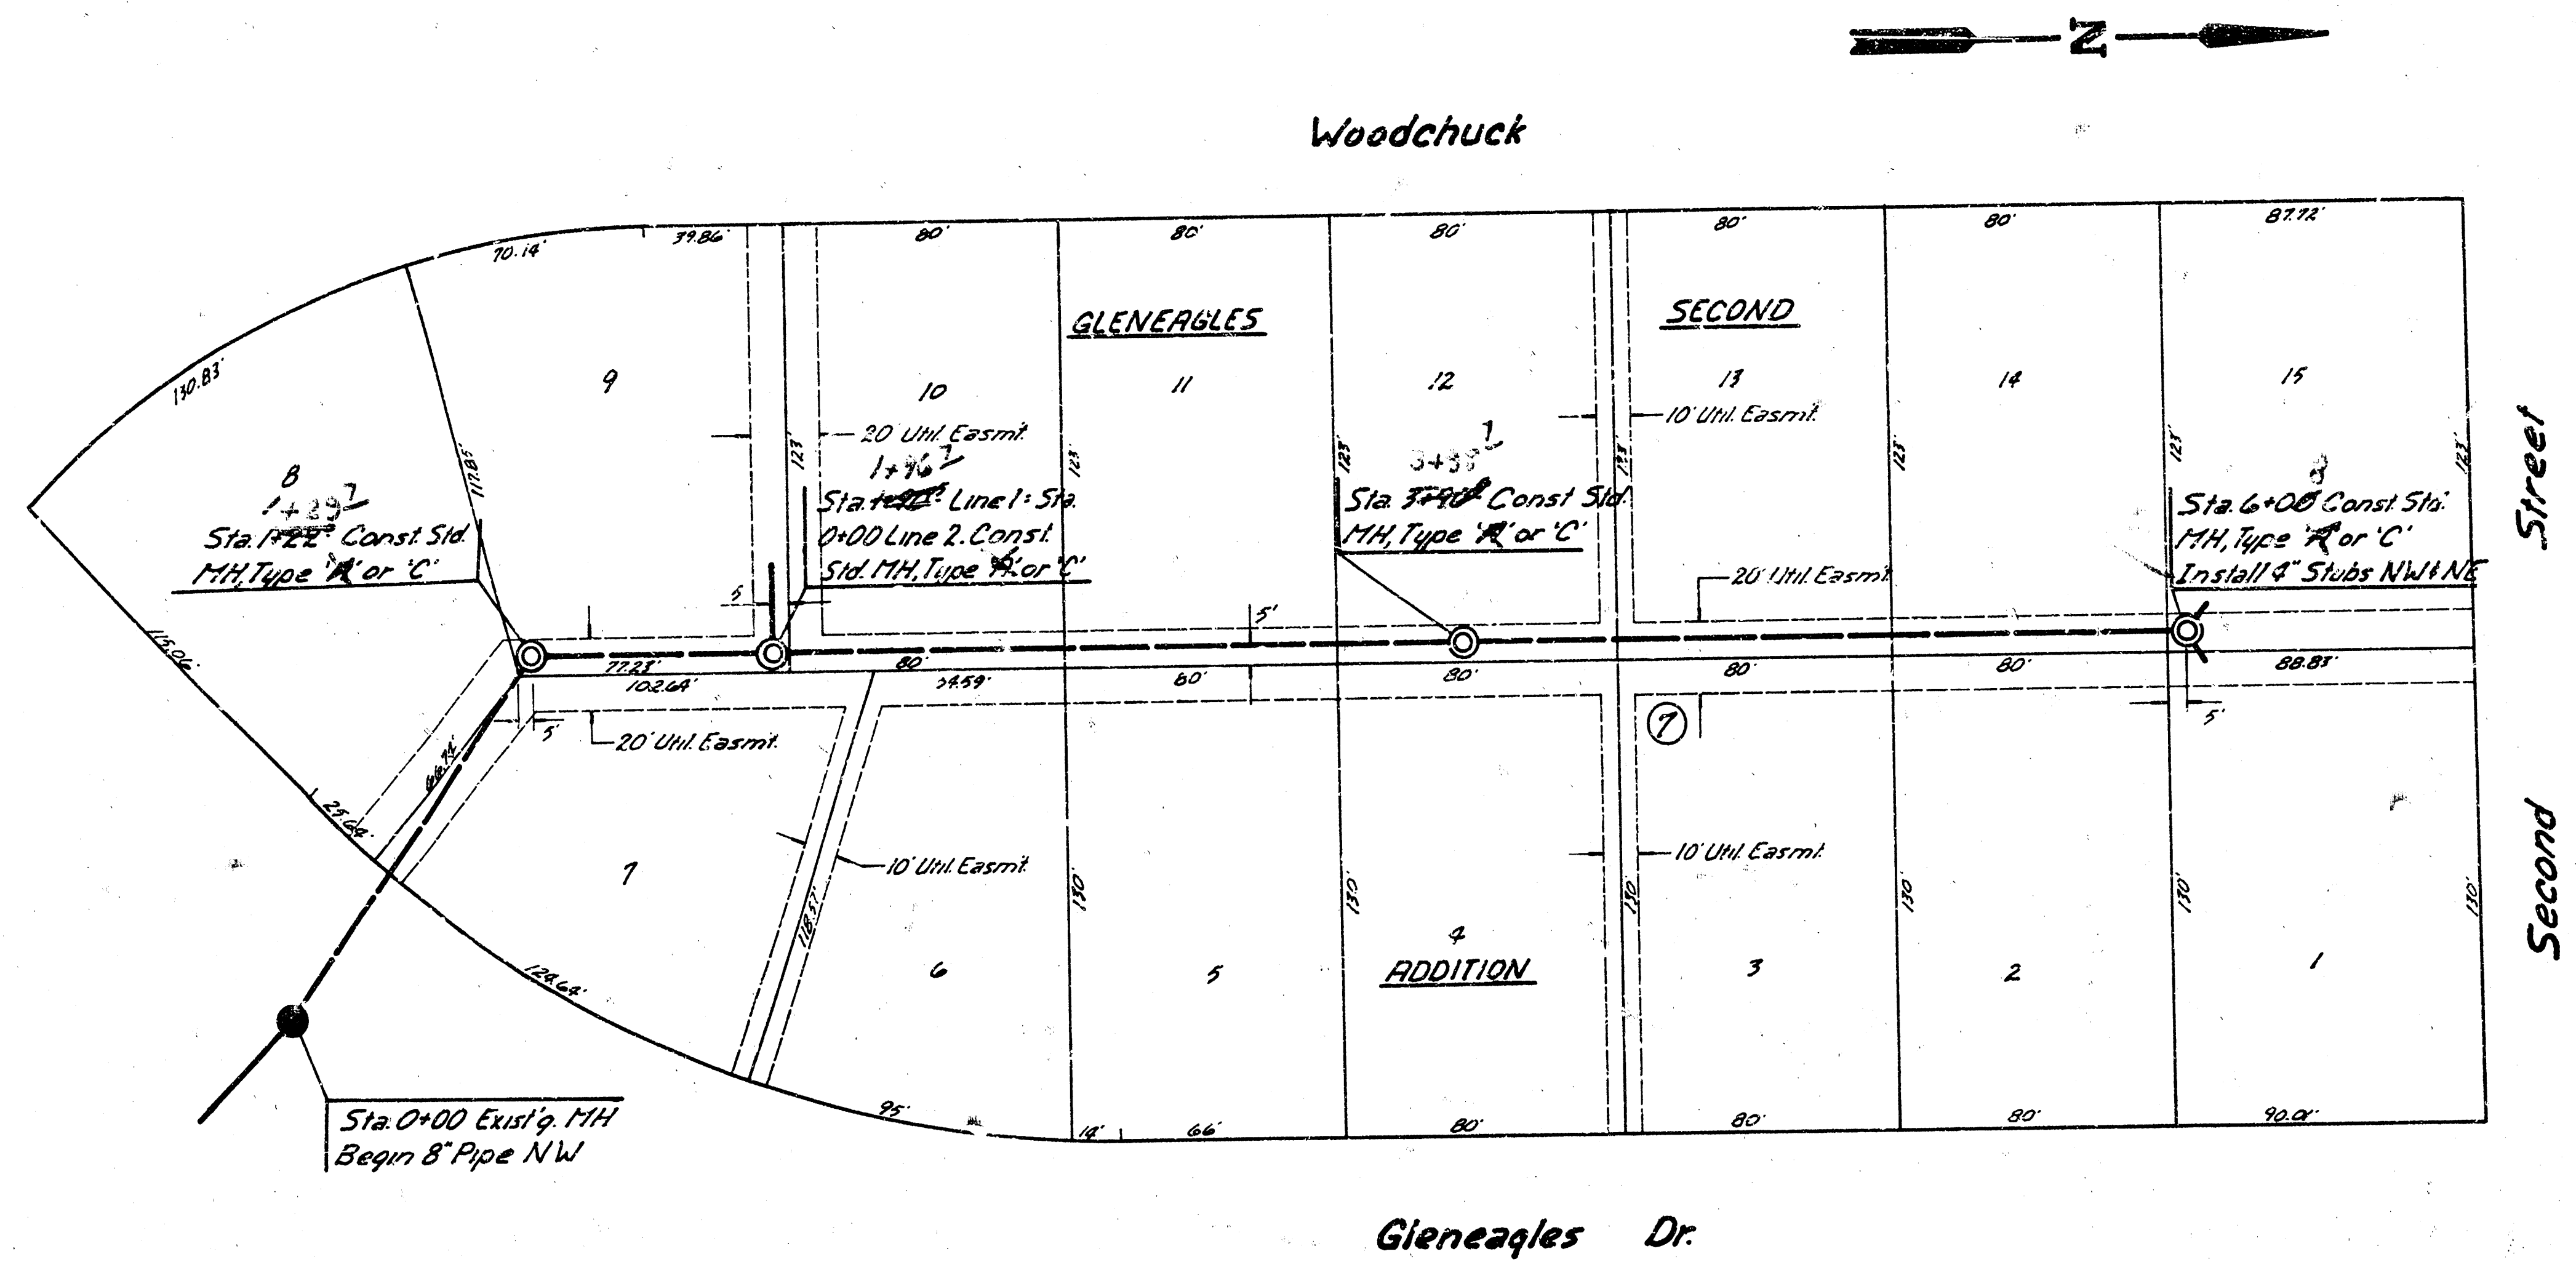


B.M. 191.58 R.R. Spk. N. Face HLP 25' N. 176' E. of Ctr. Sec. 21, T27S, R1W (2nd. & Woodchuck IV)



SCALE
Plan 1"=40'
Profile Horiz 1"=40'
Vert 1"=5'

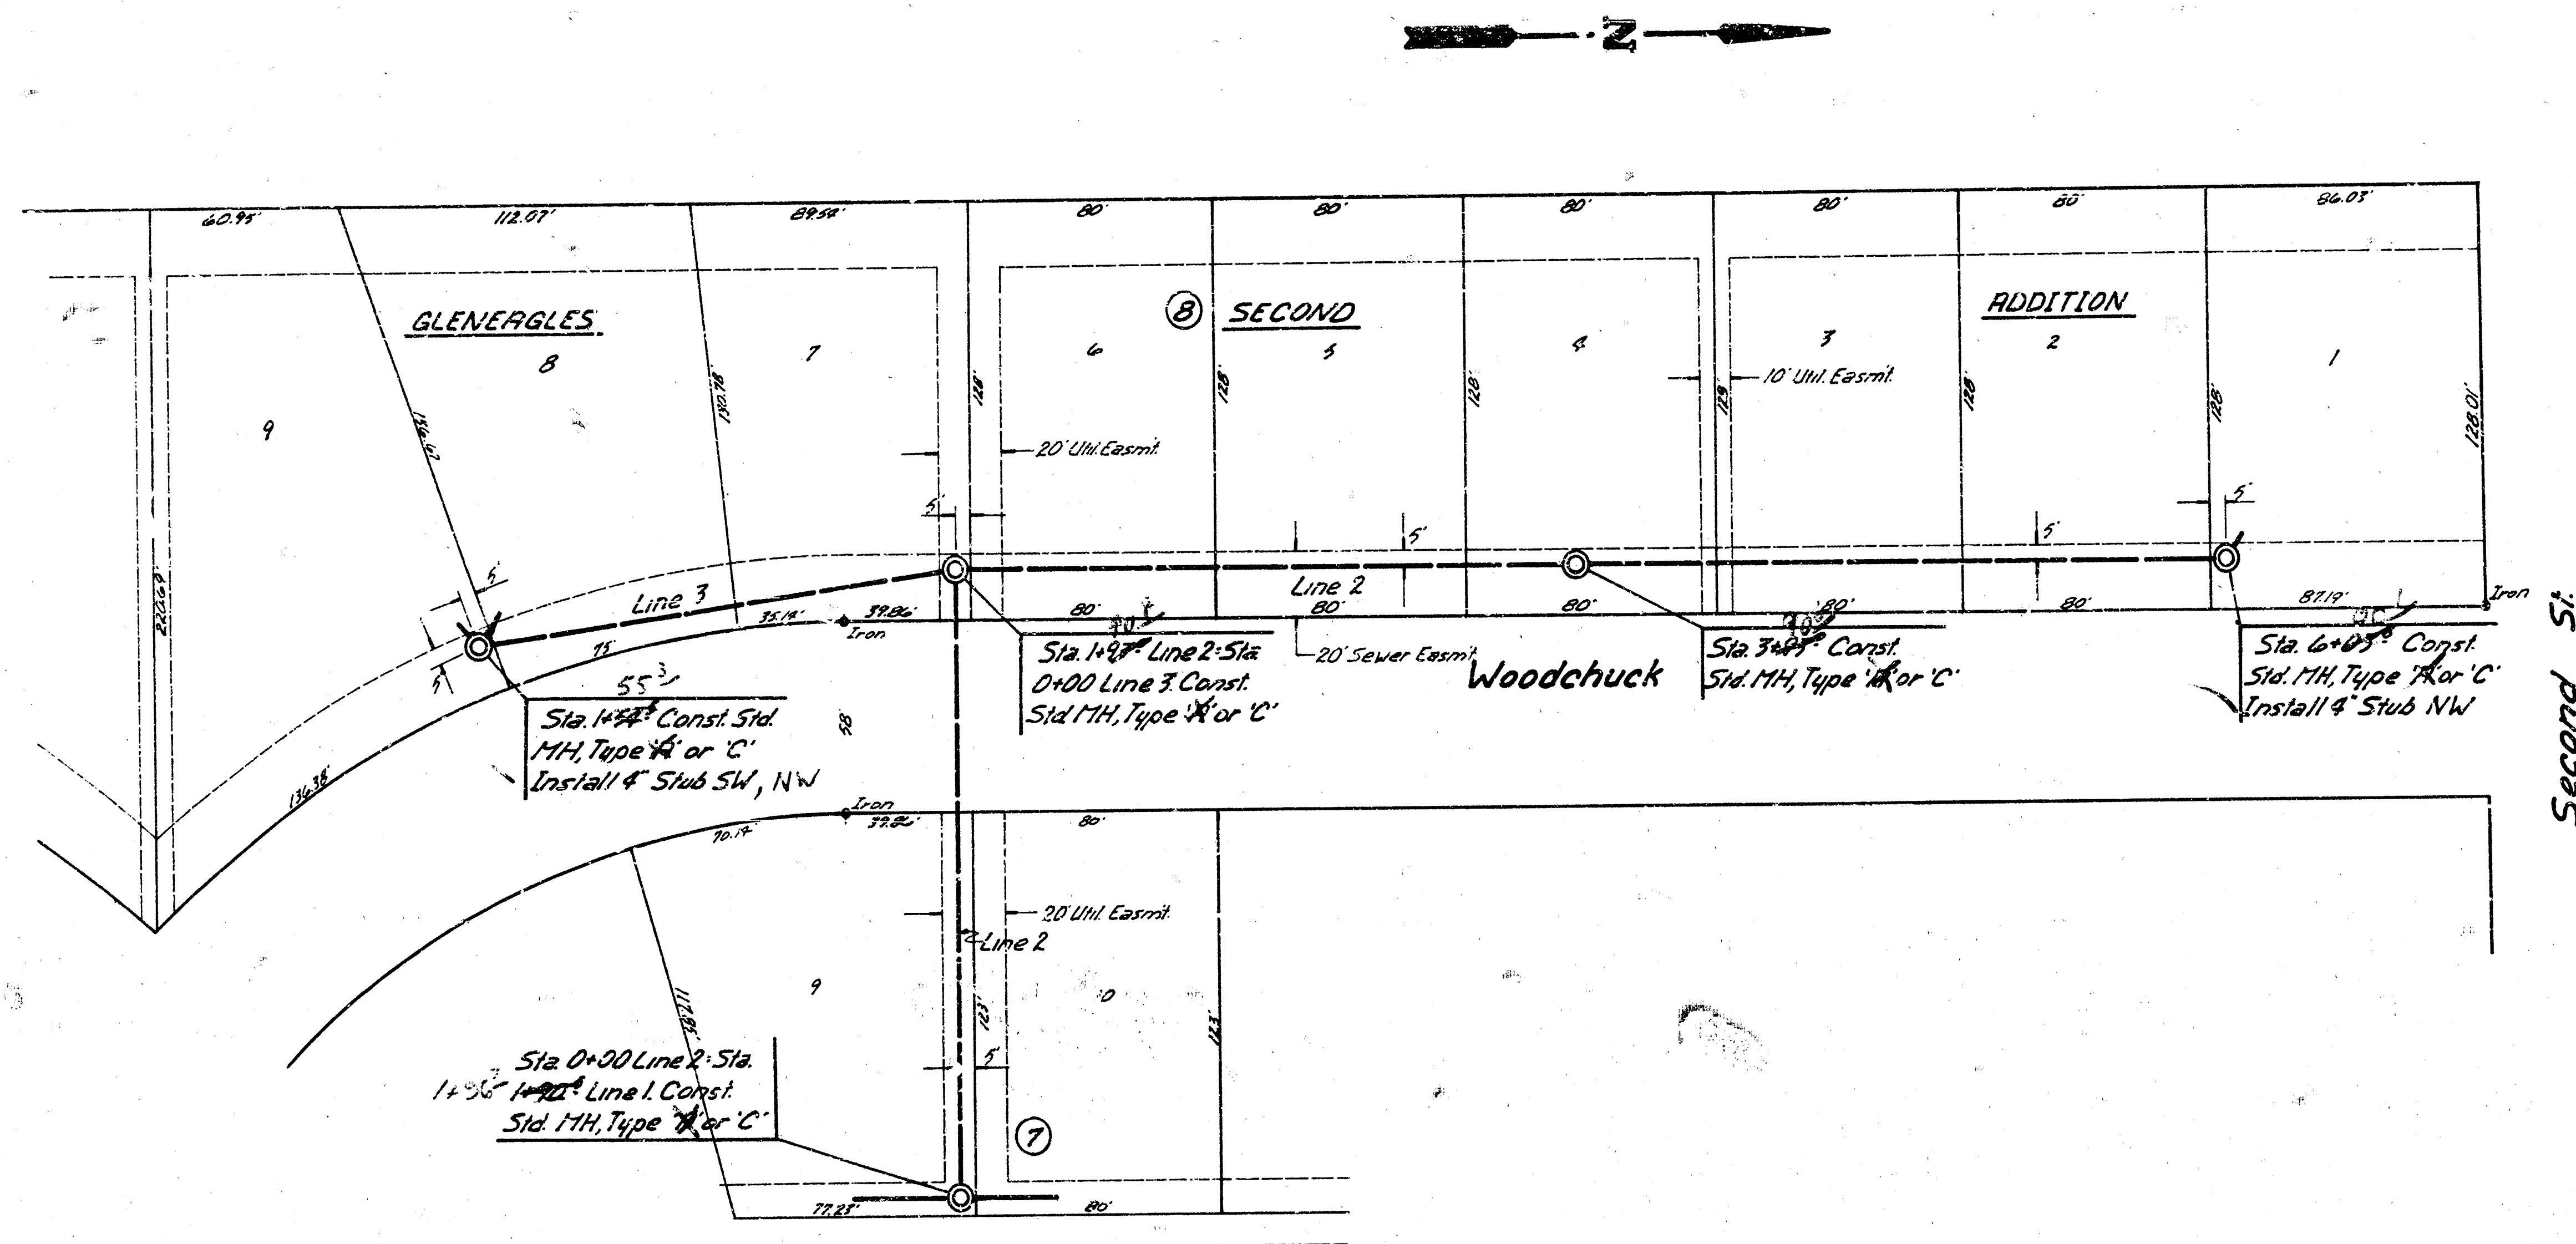

SCALE
Plan 1"=40'
Profile Vert 1"=5'


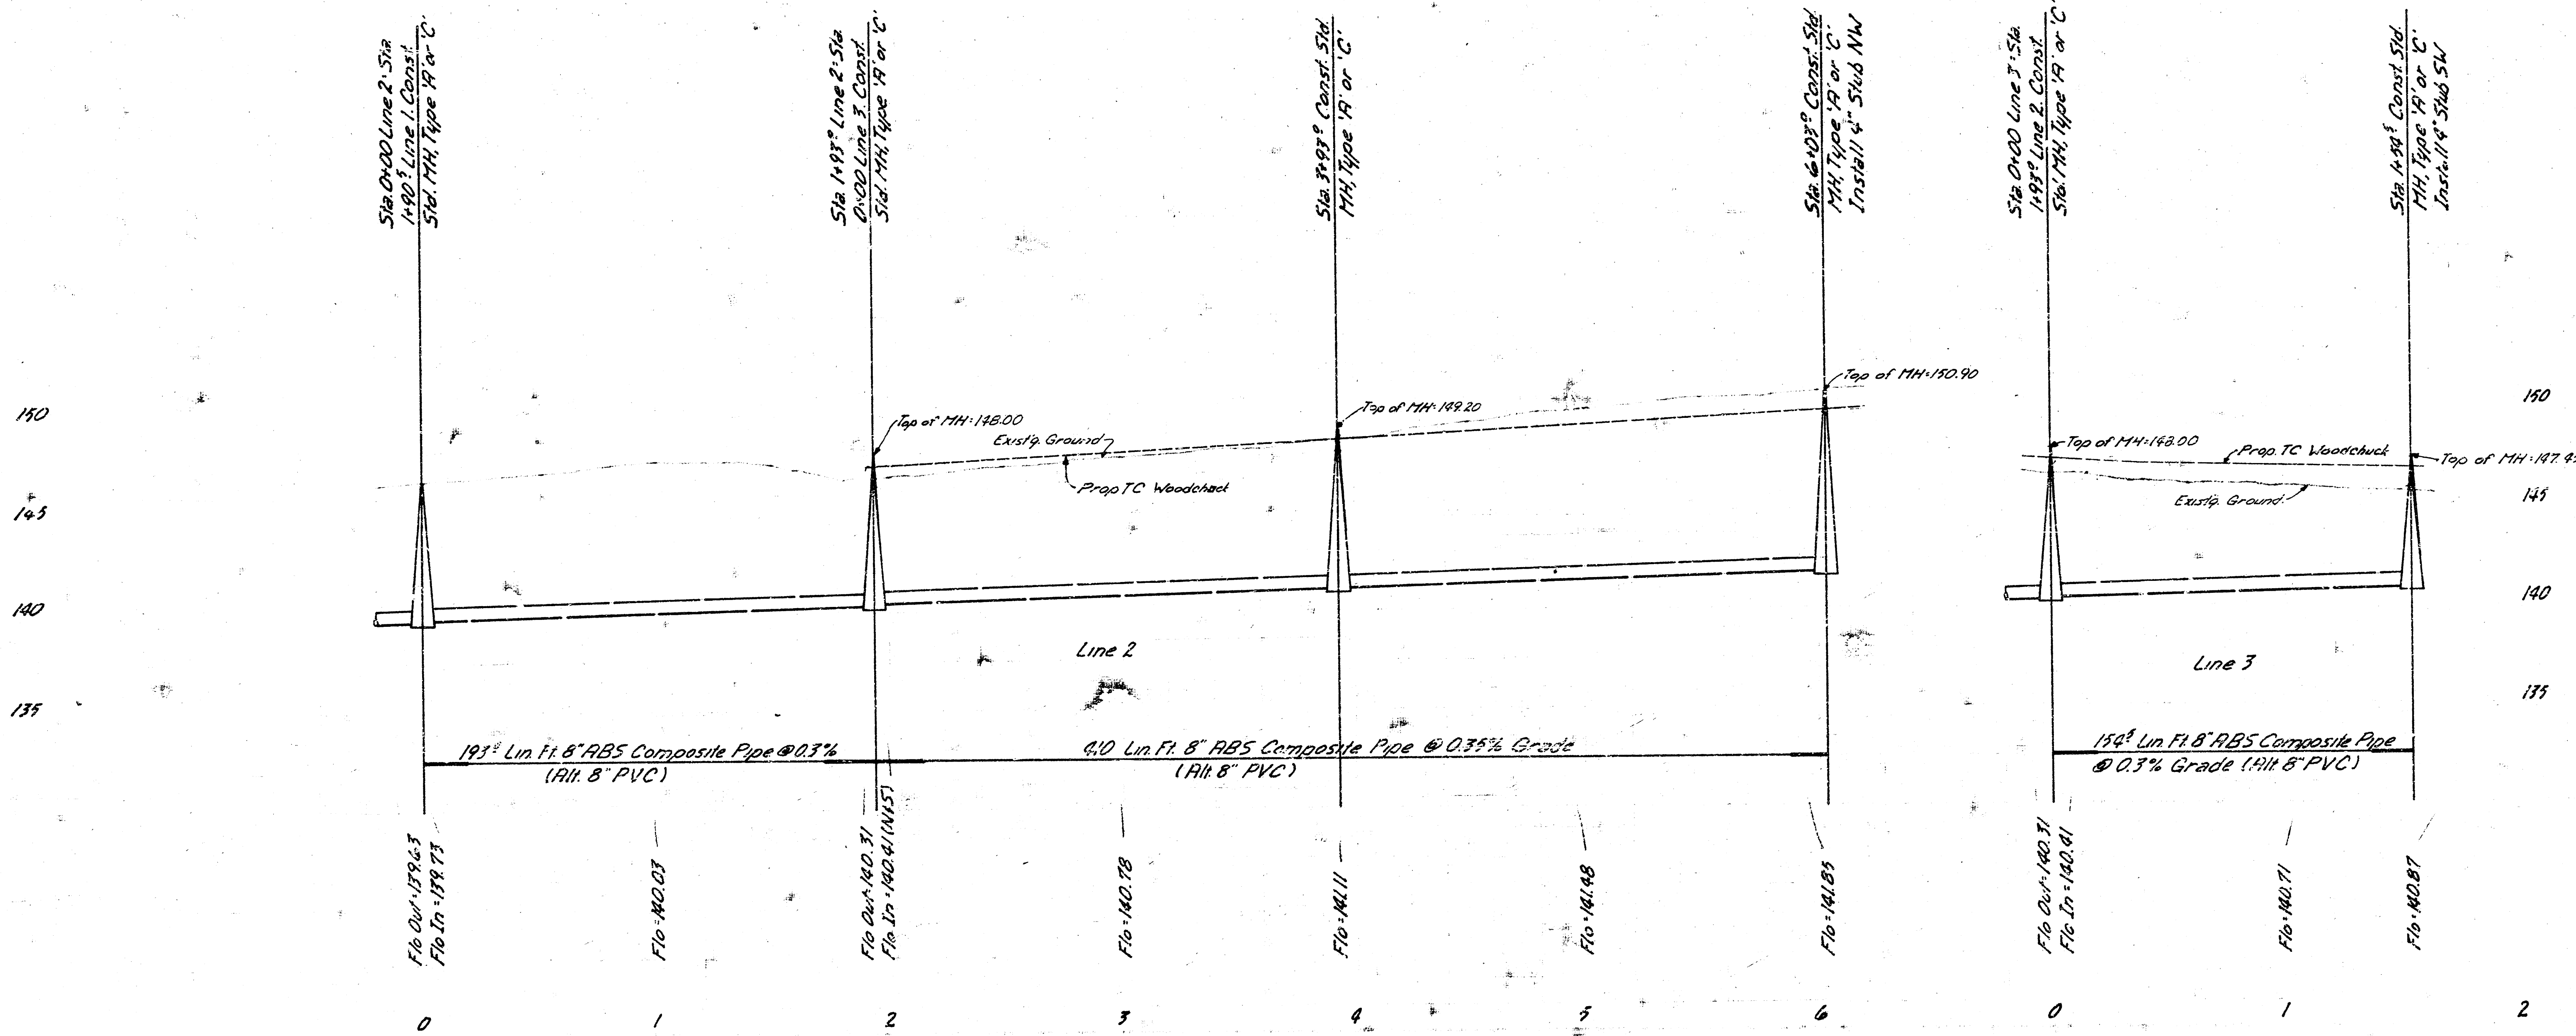


Lines 2 & 3
Lateral 39, Main 4, SWI

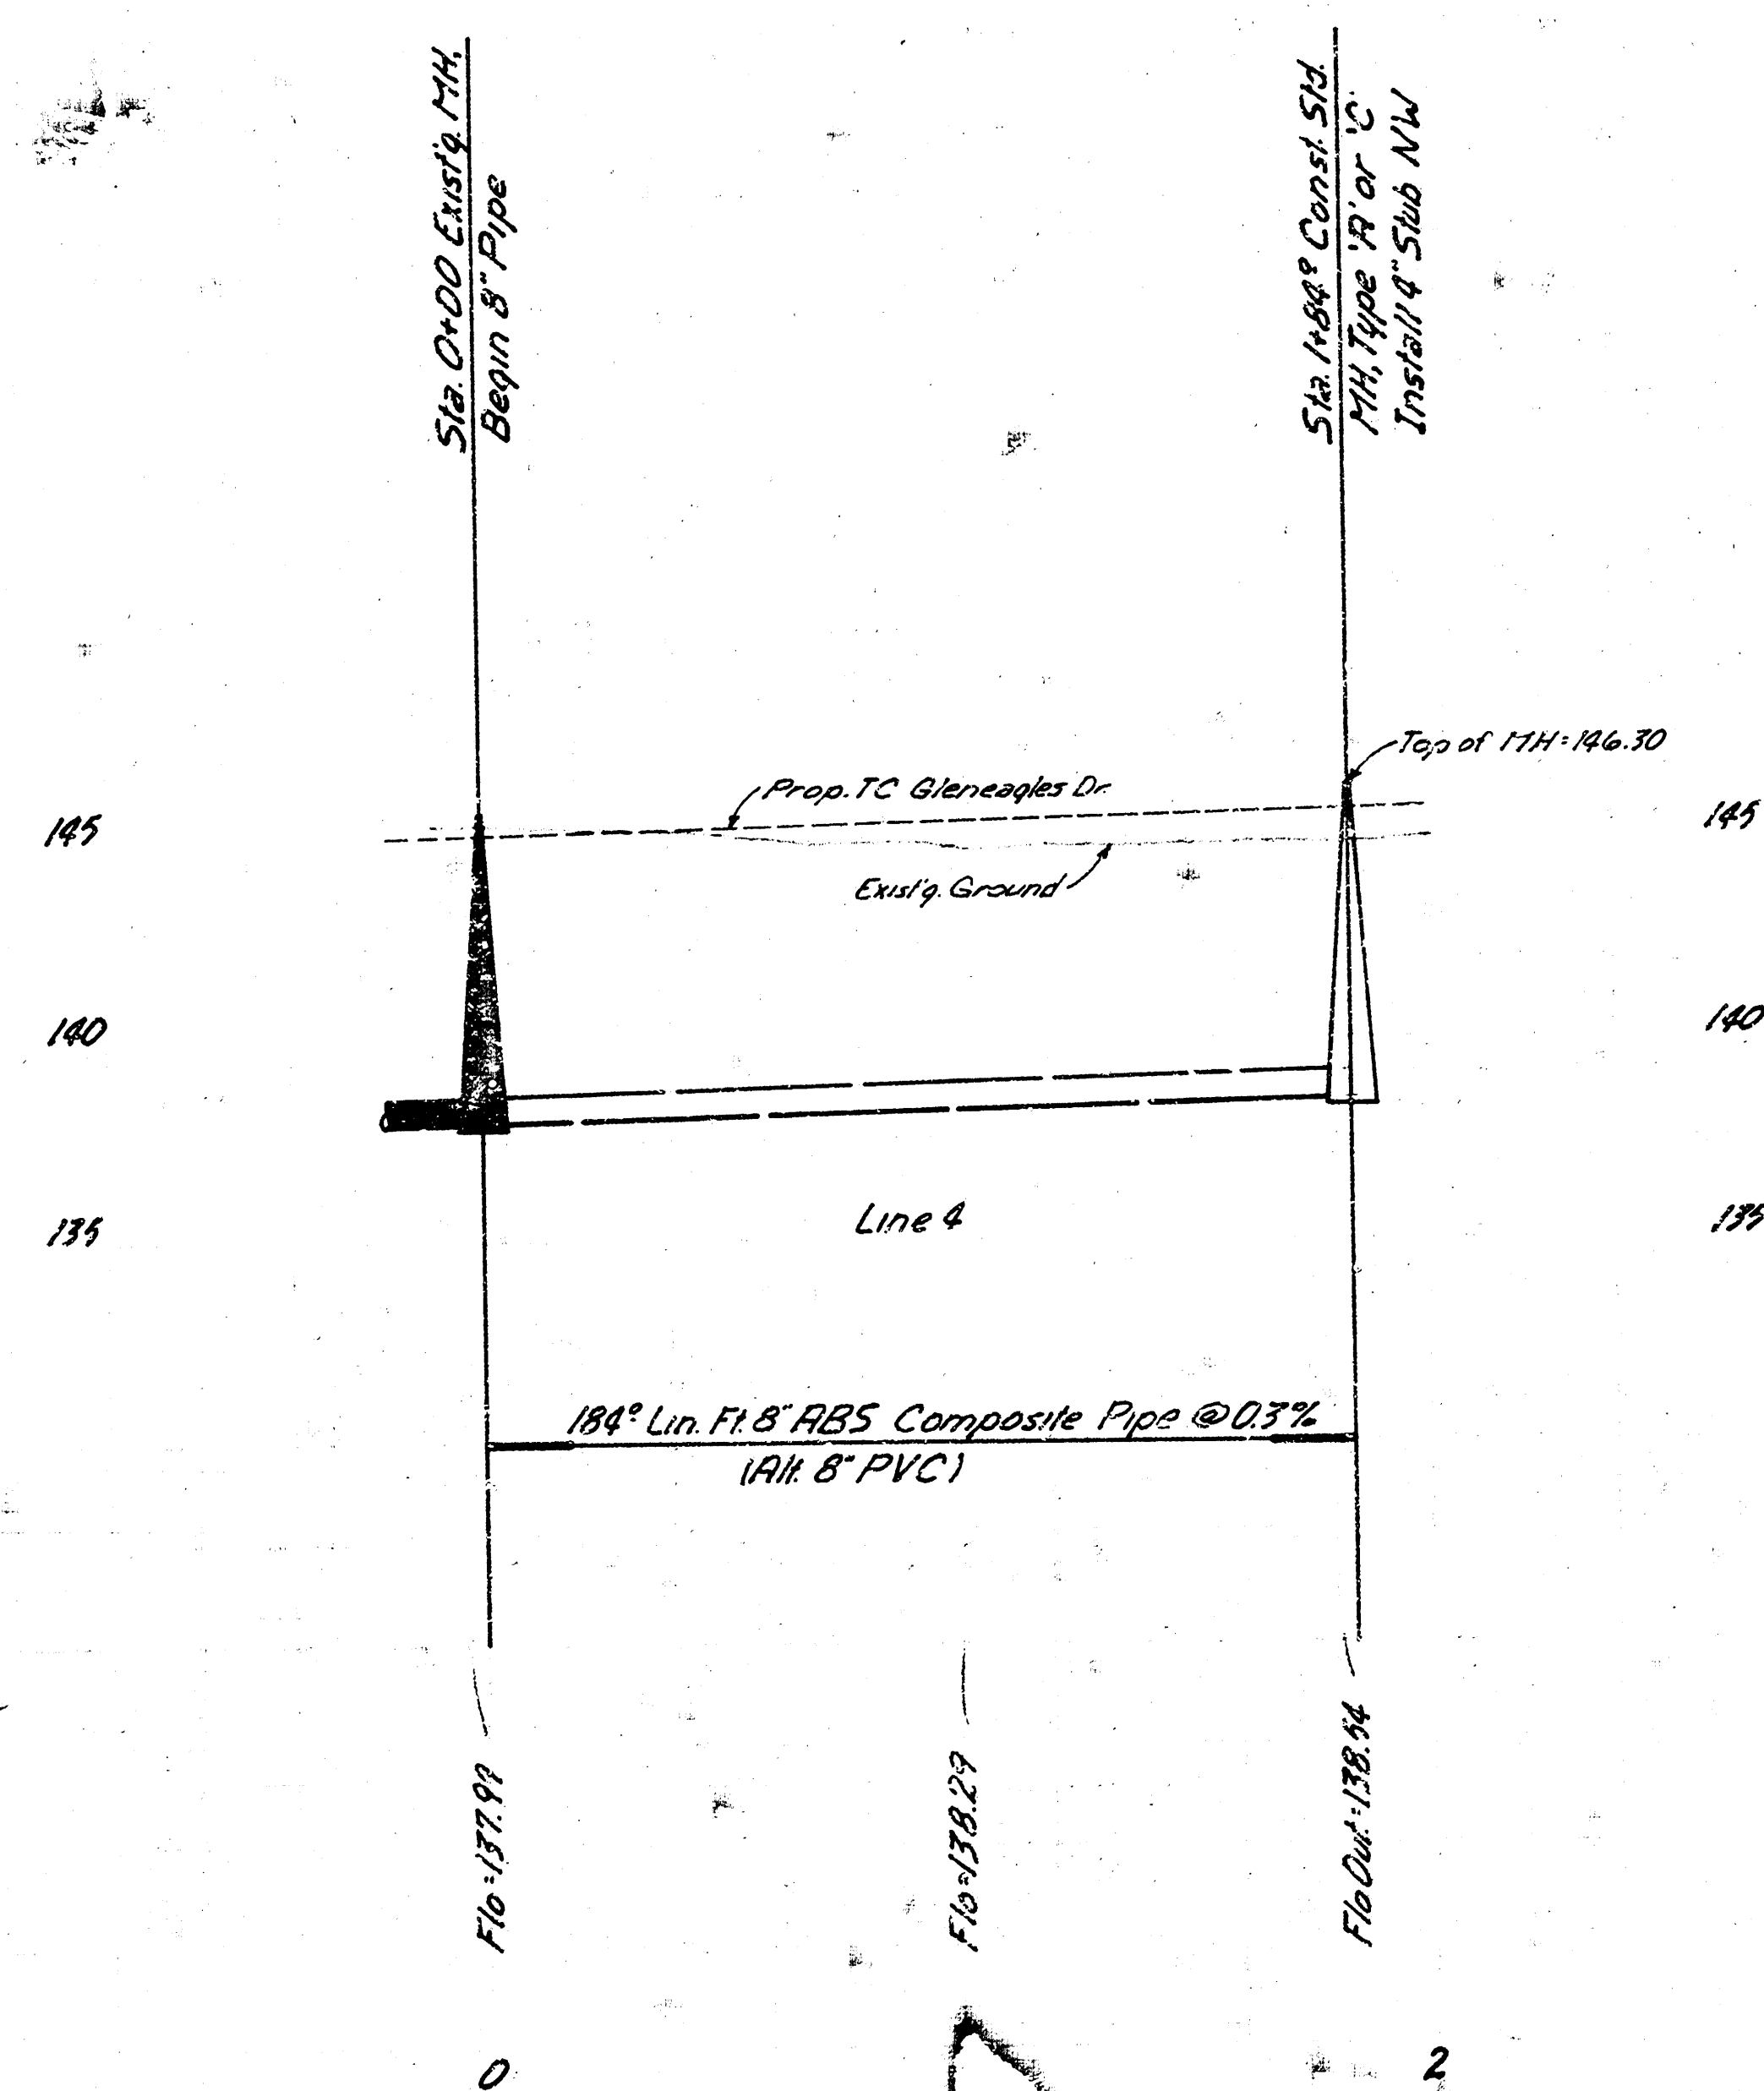
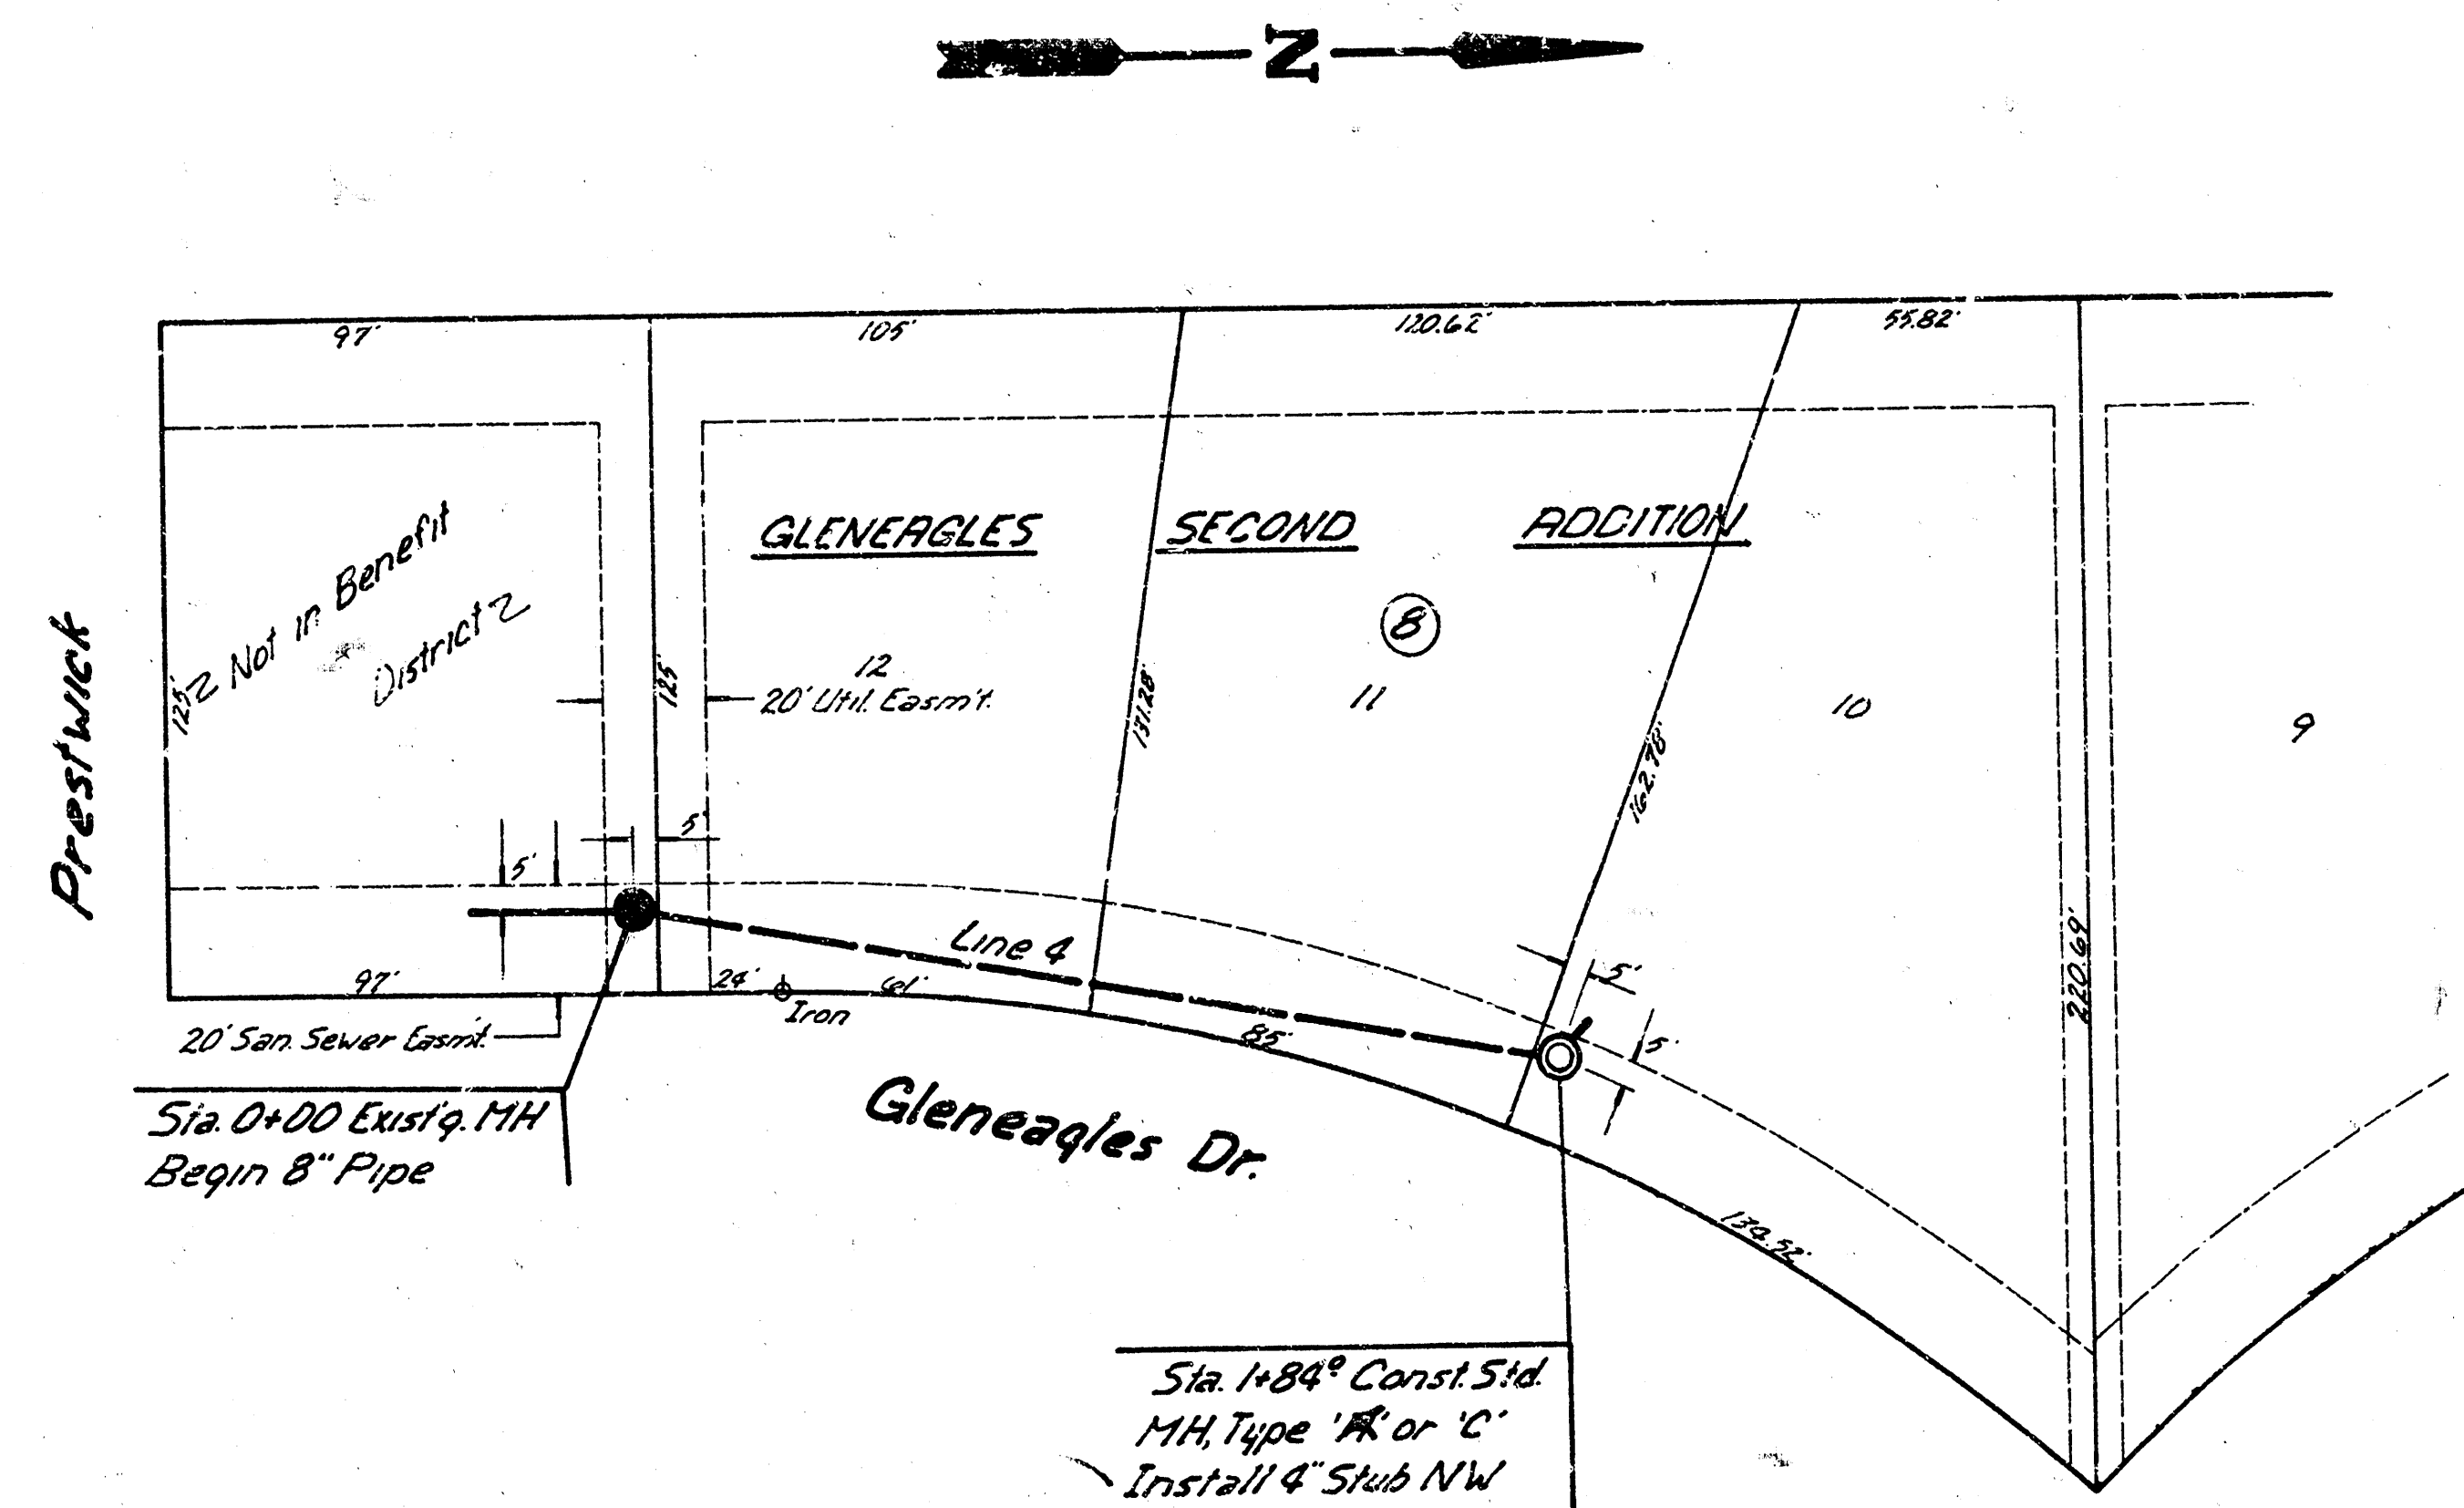


SCALE
Plan 1"=40'
Profile Horz 1"=40'
Vert 1"=5'






Line 4 7/6
Lateral 3/4 Main 4.5WI

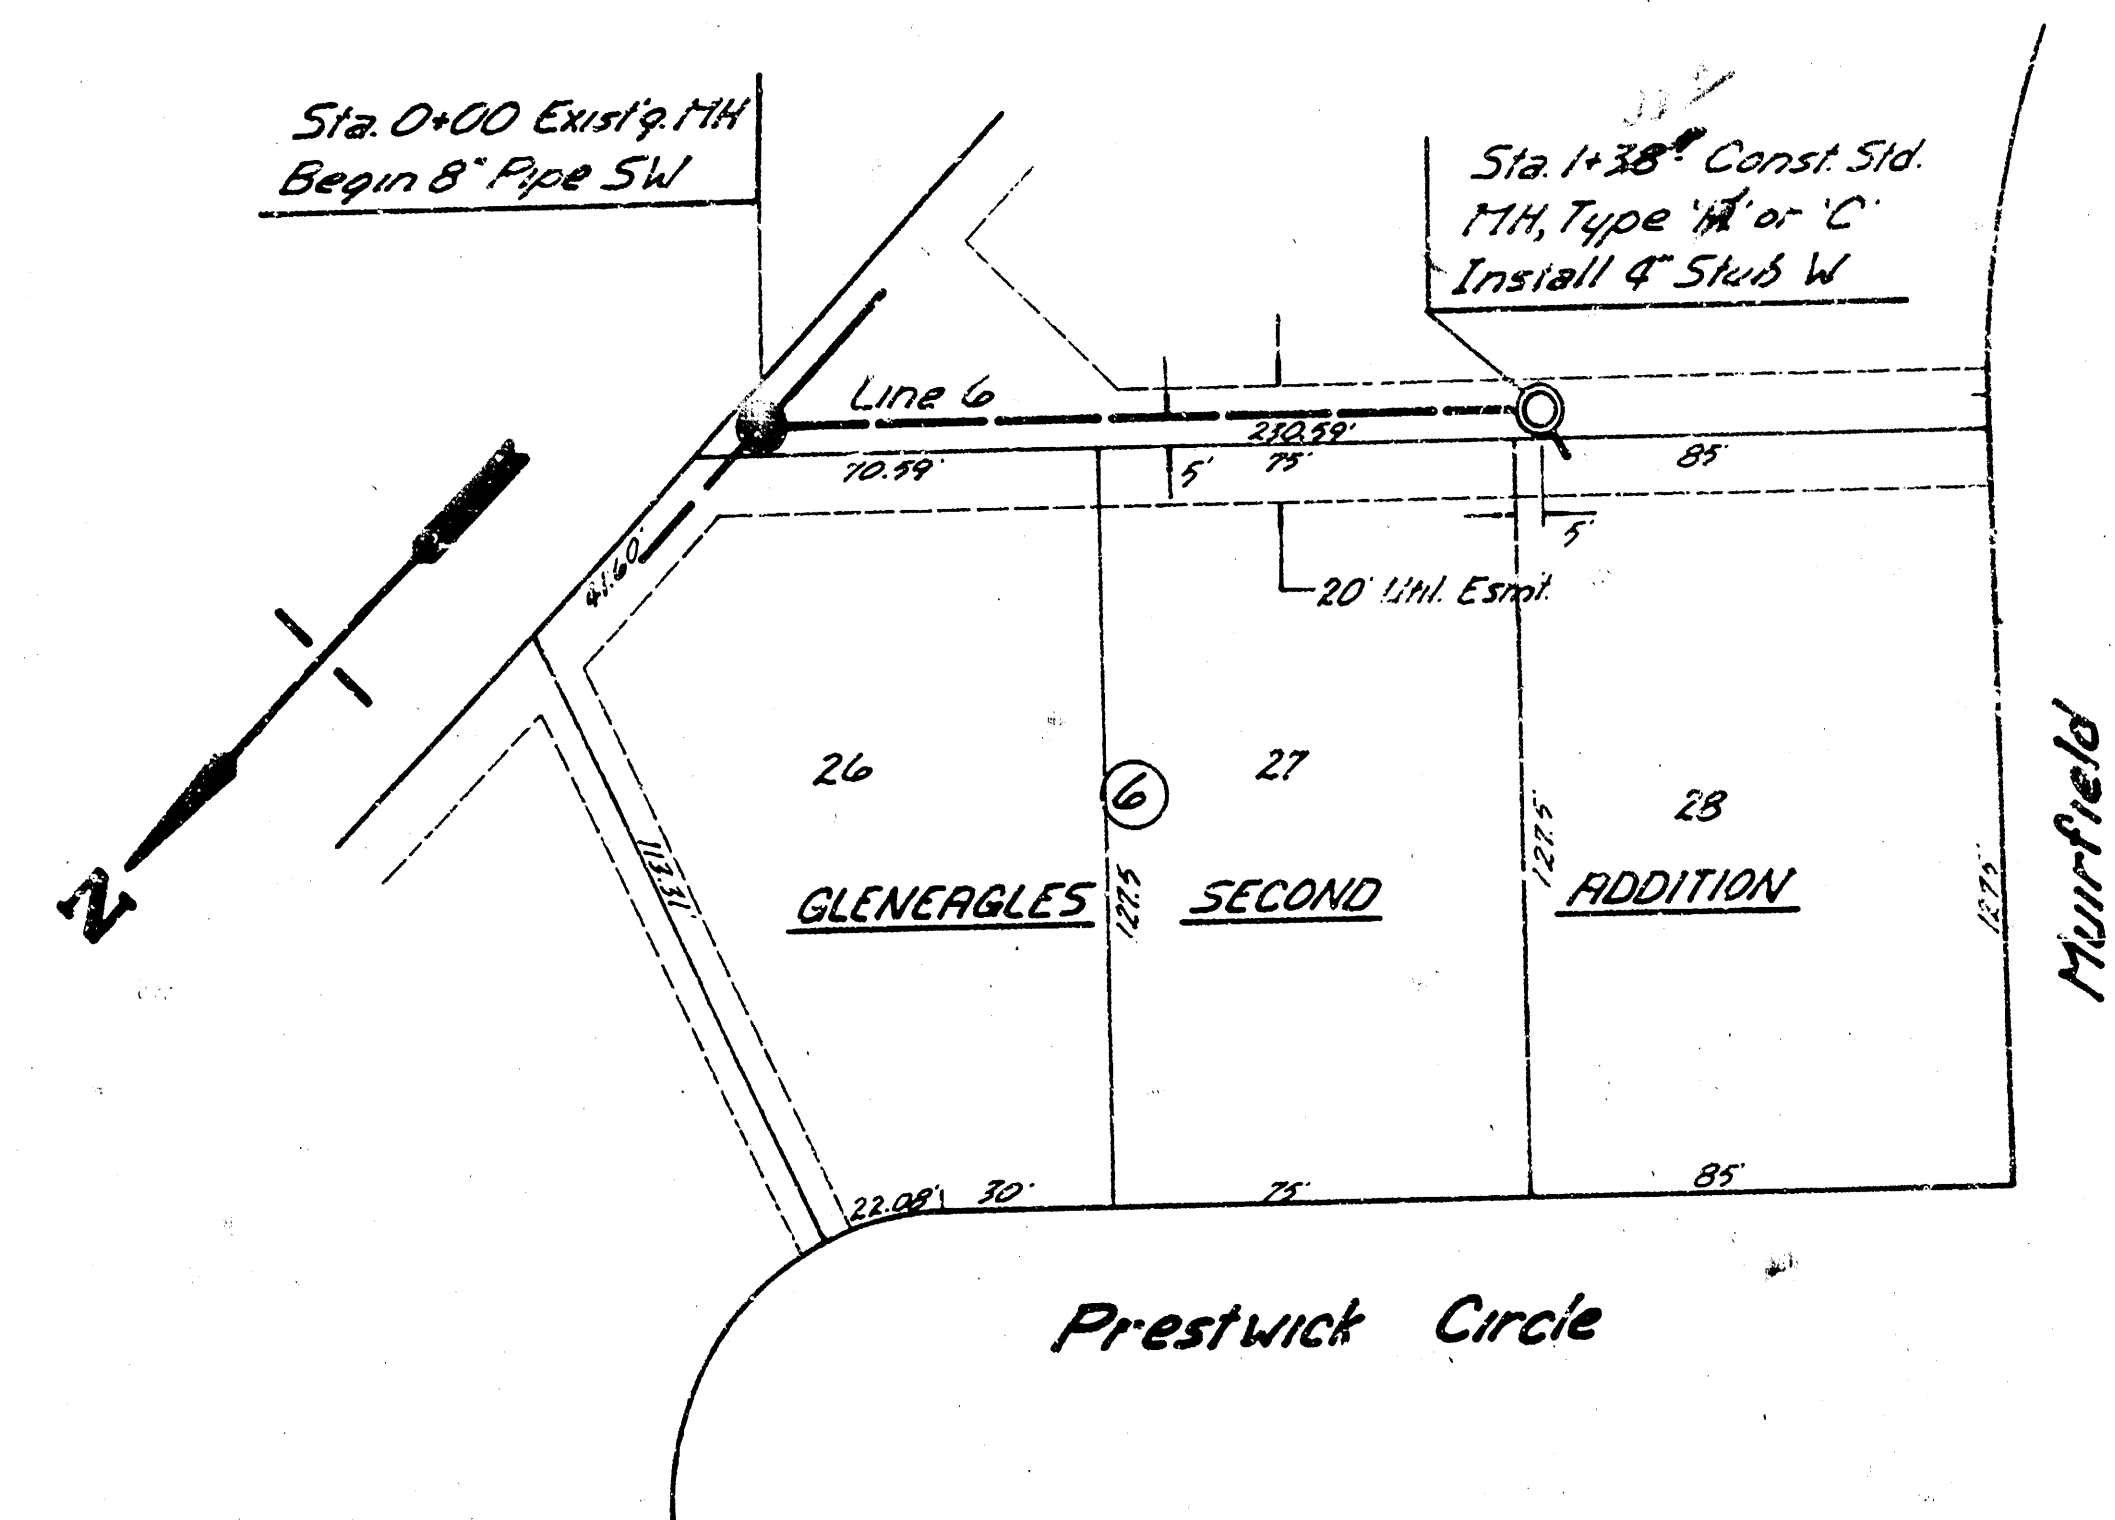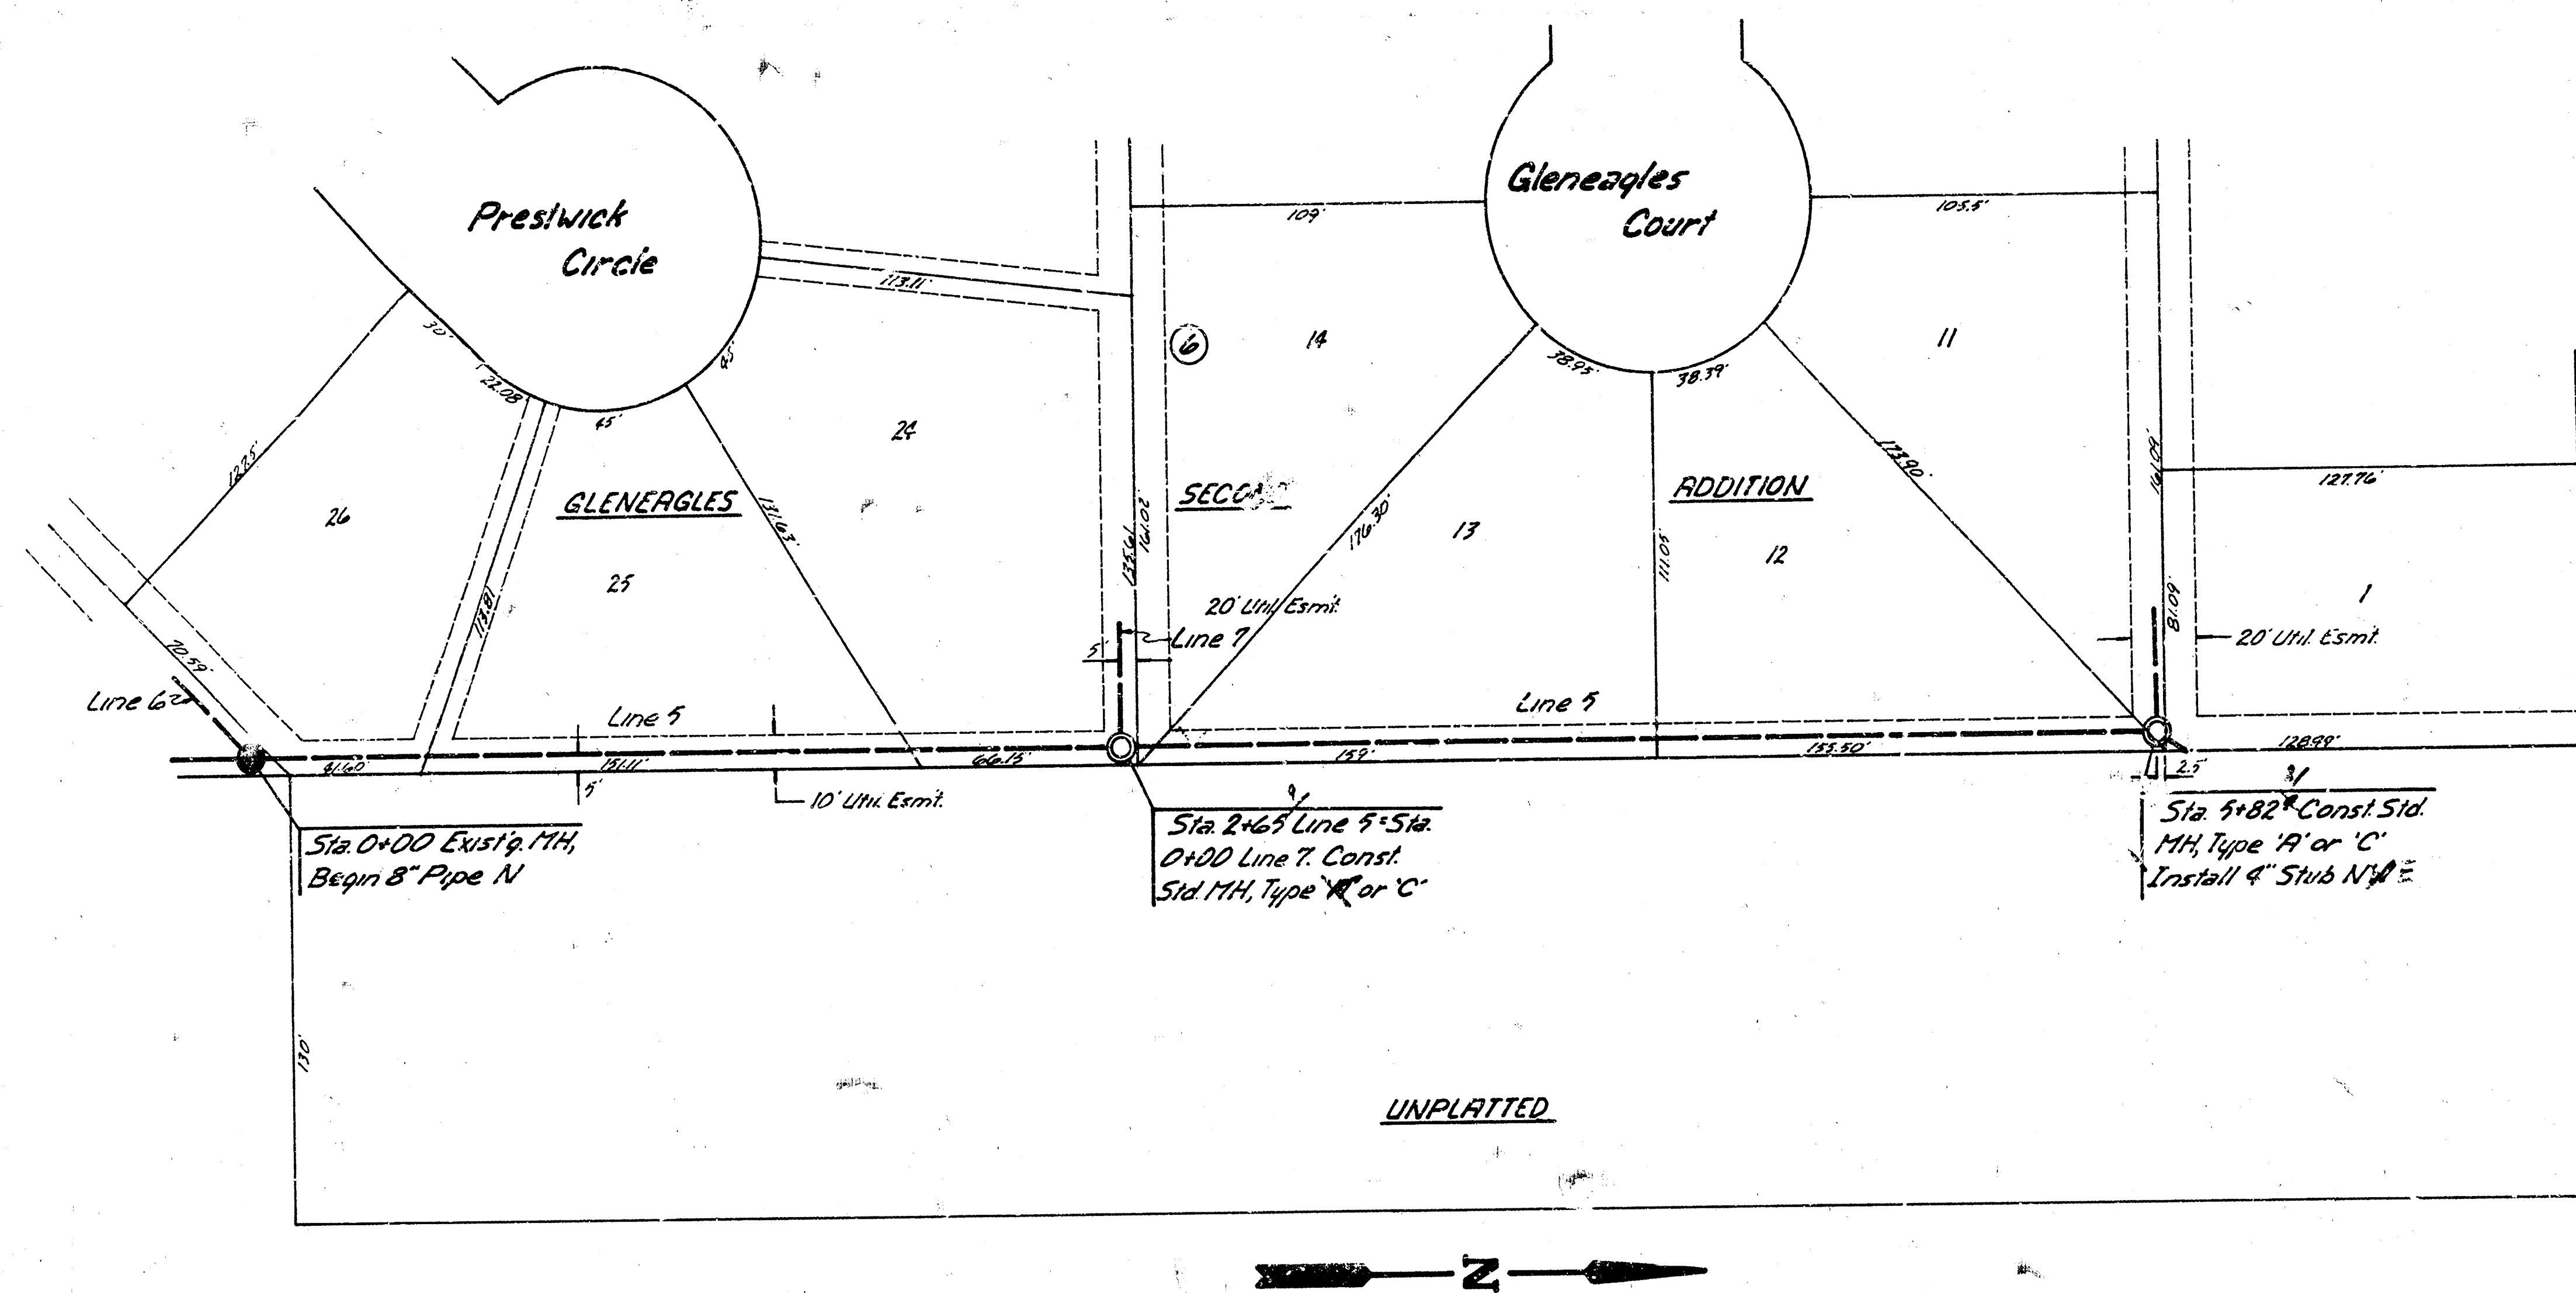

SCALE
Plan 1"=40'
Profile Hor: 1"=40'
Vert: 1"=5'

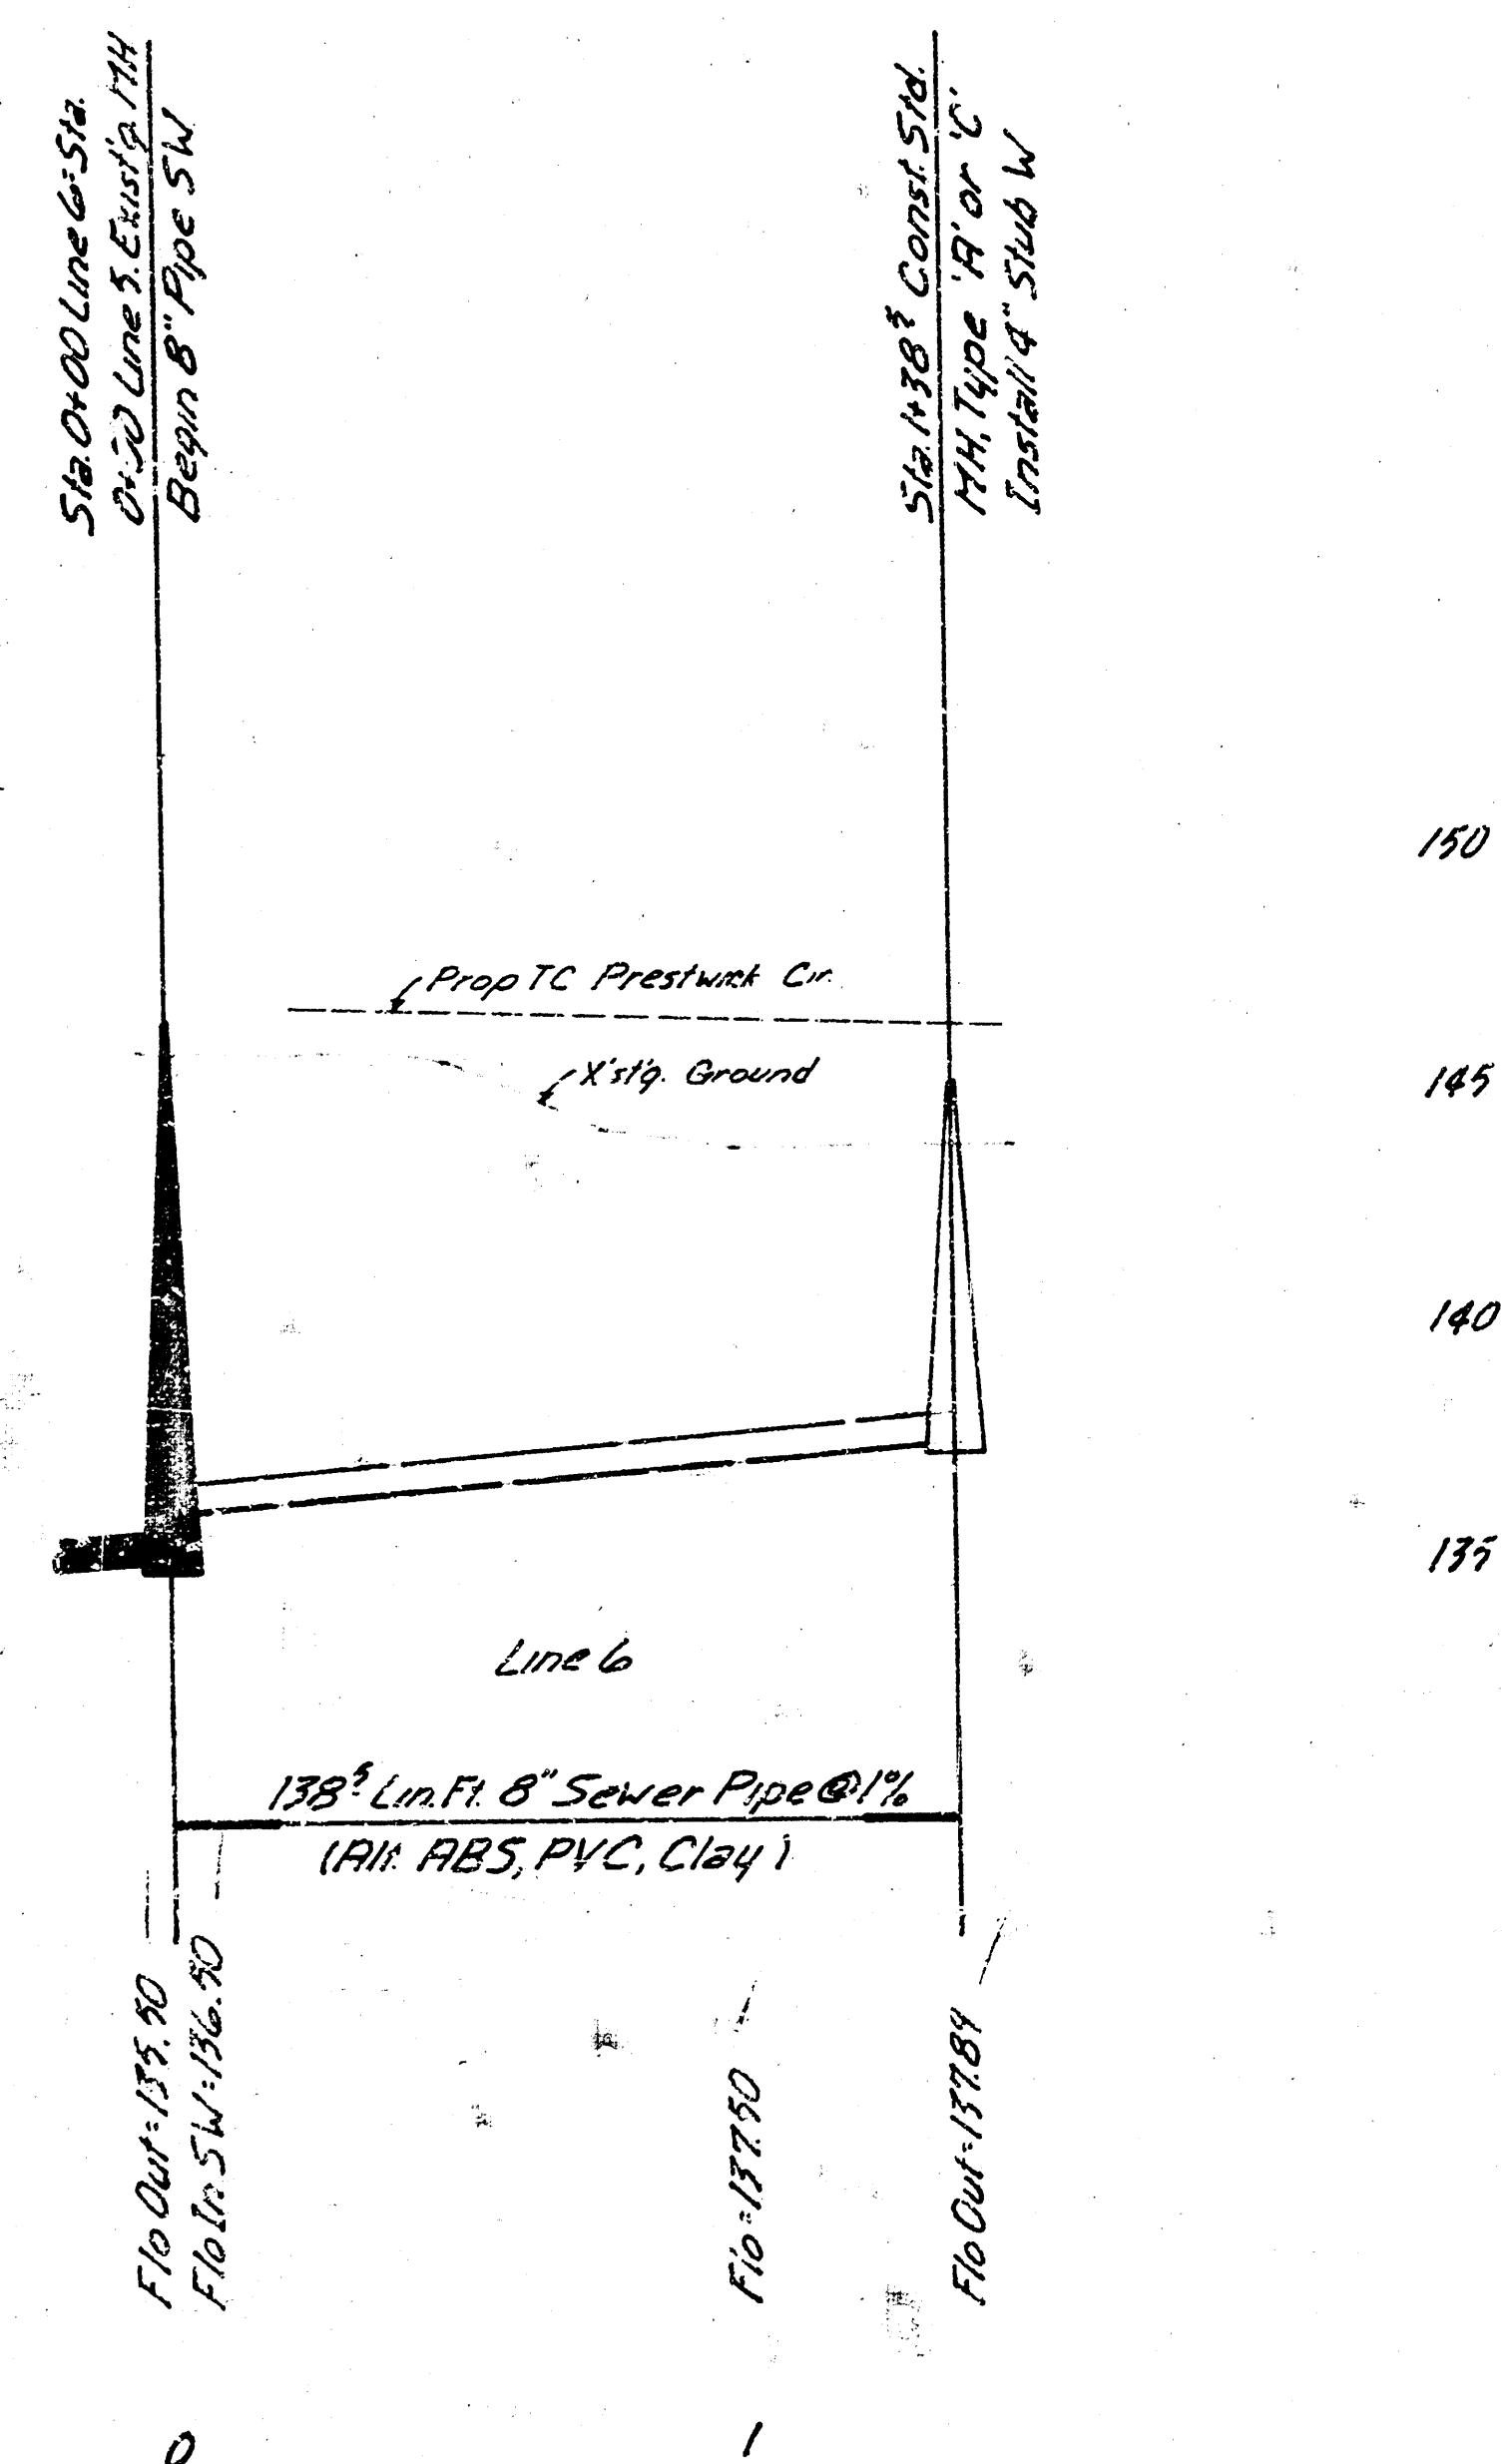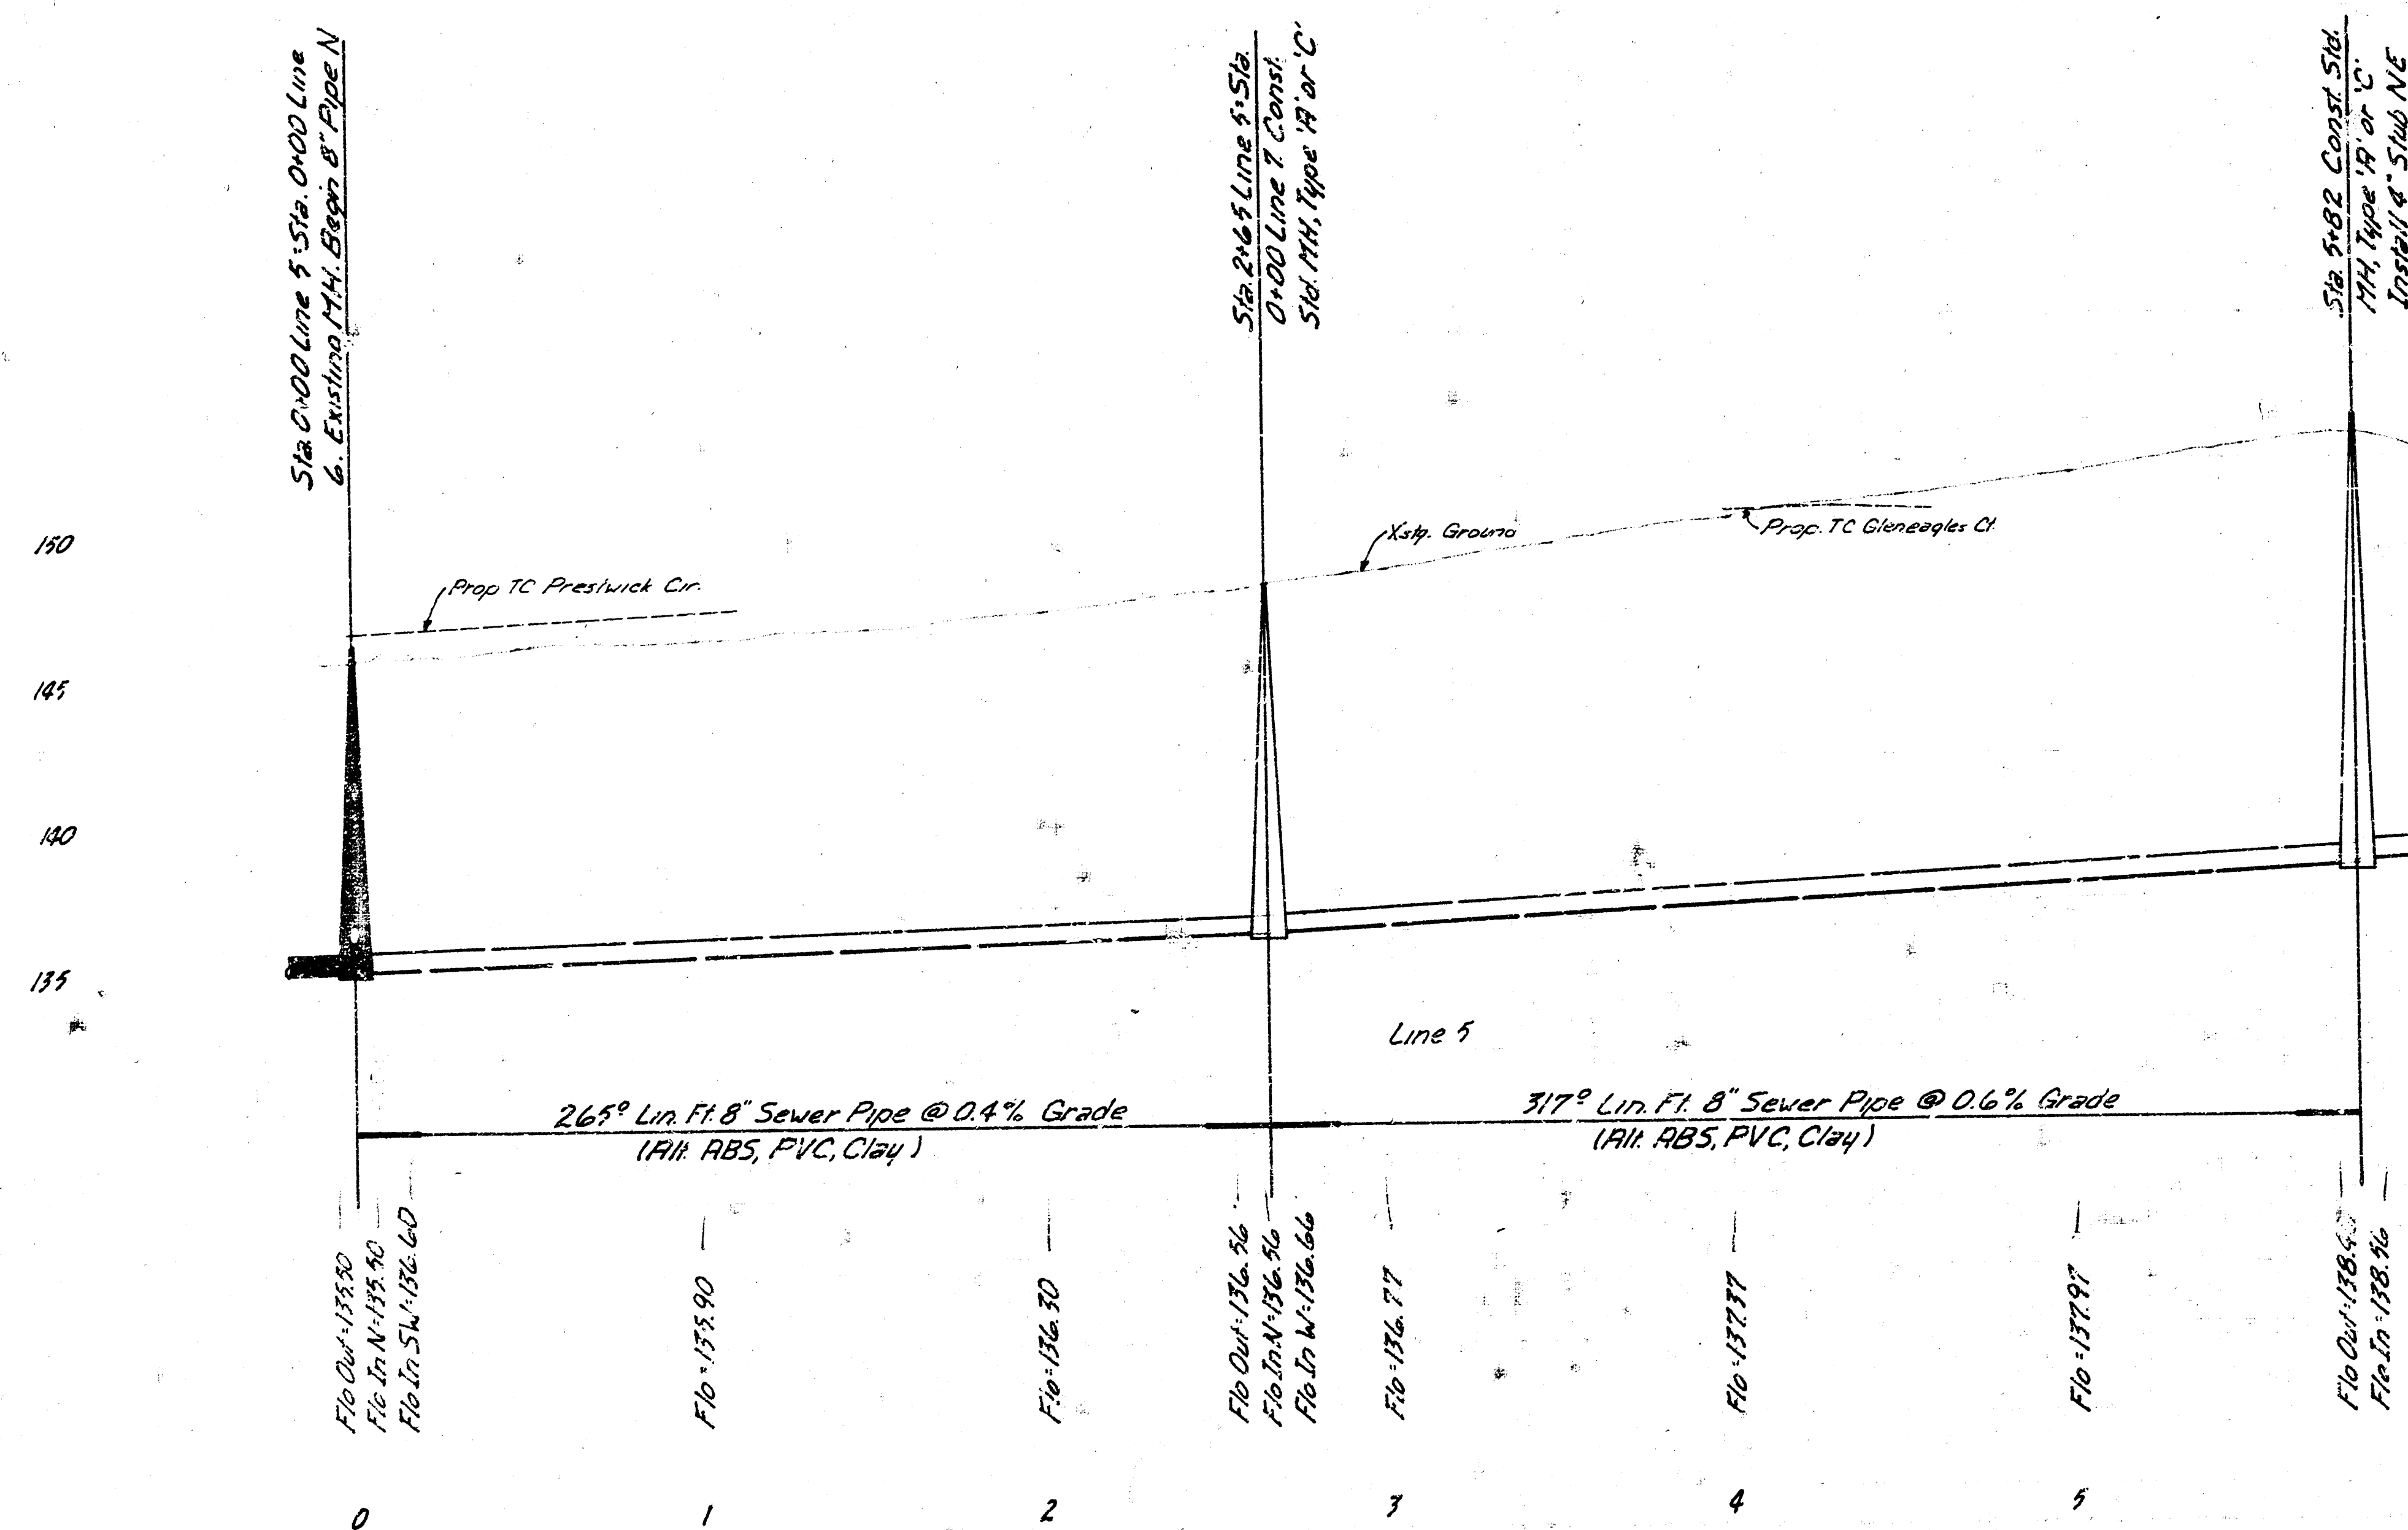

Lines 5 & 6
Lateral 34, Main 4, SW 1

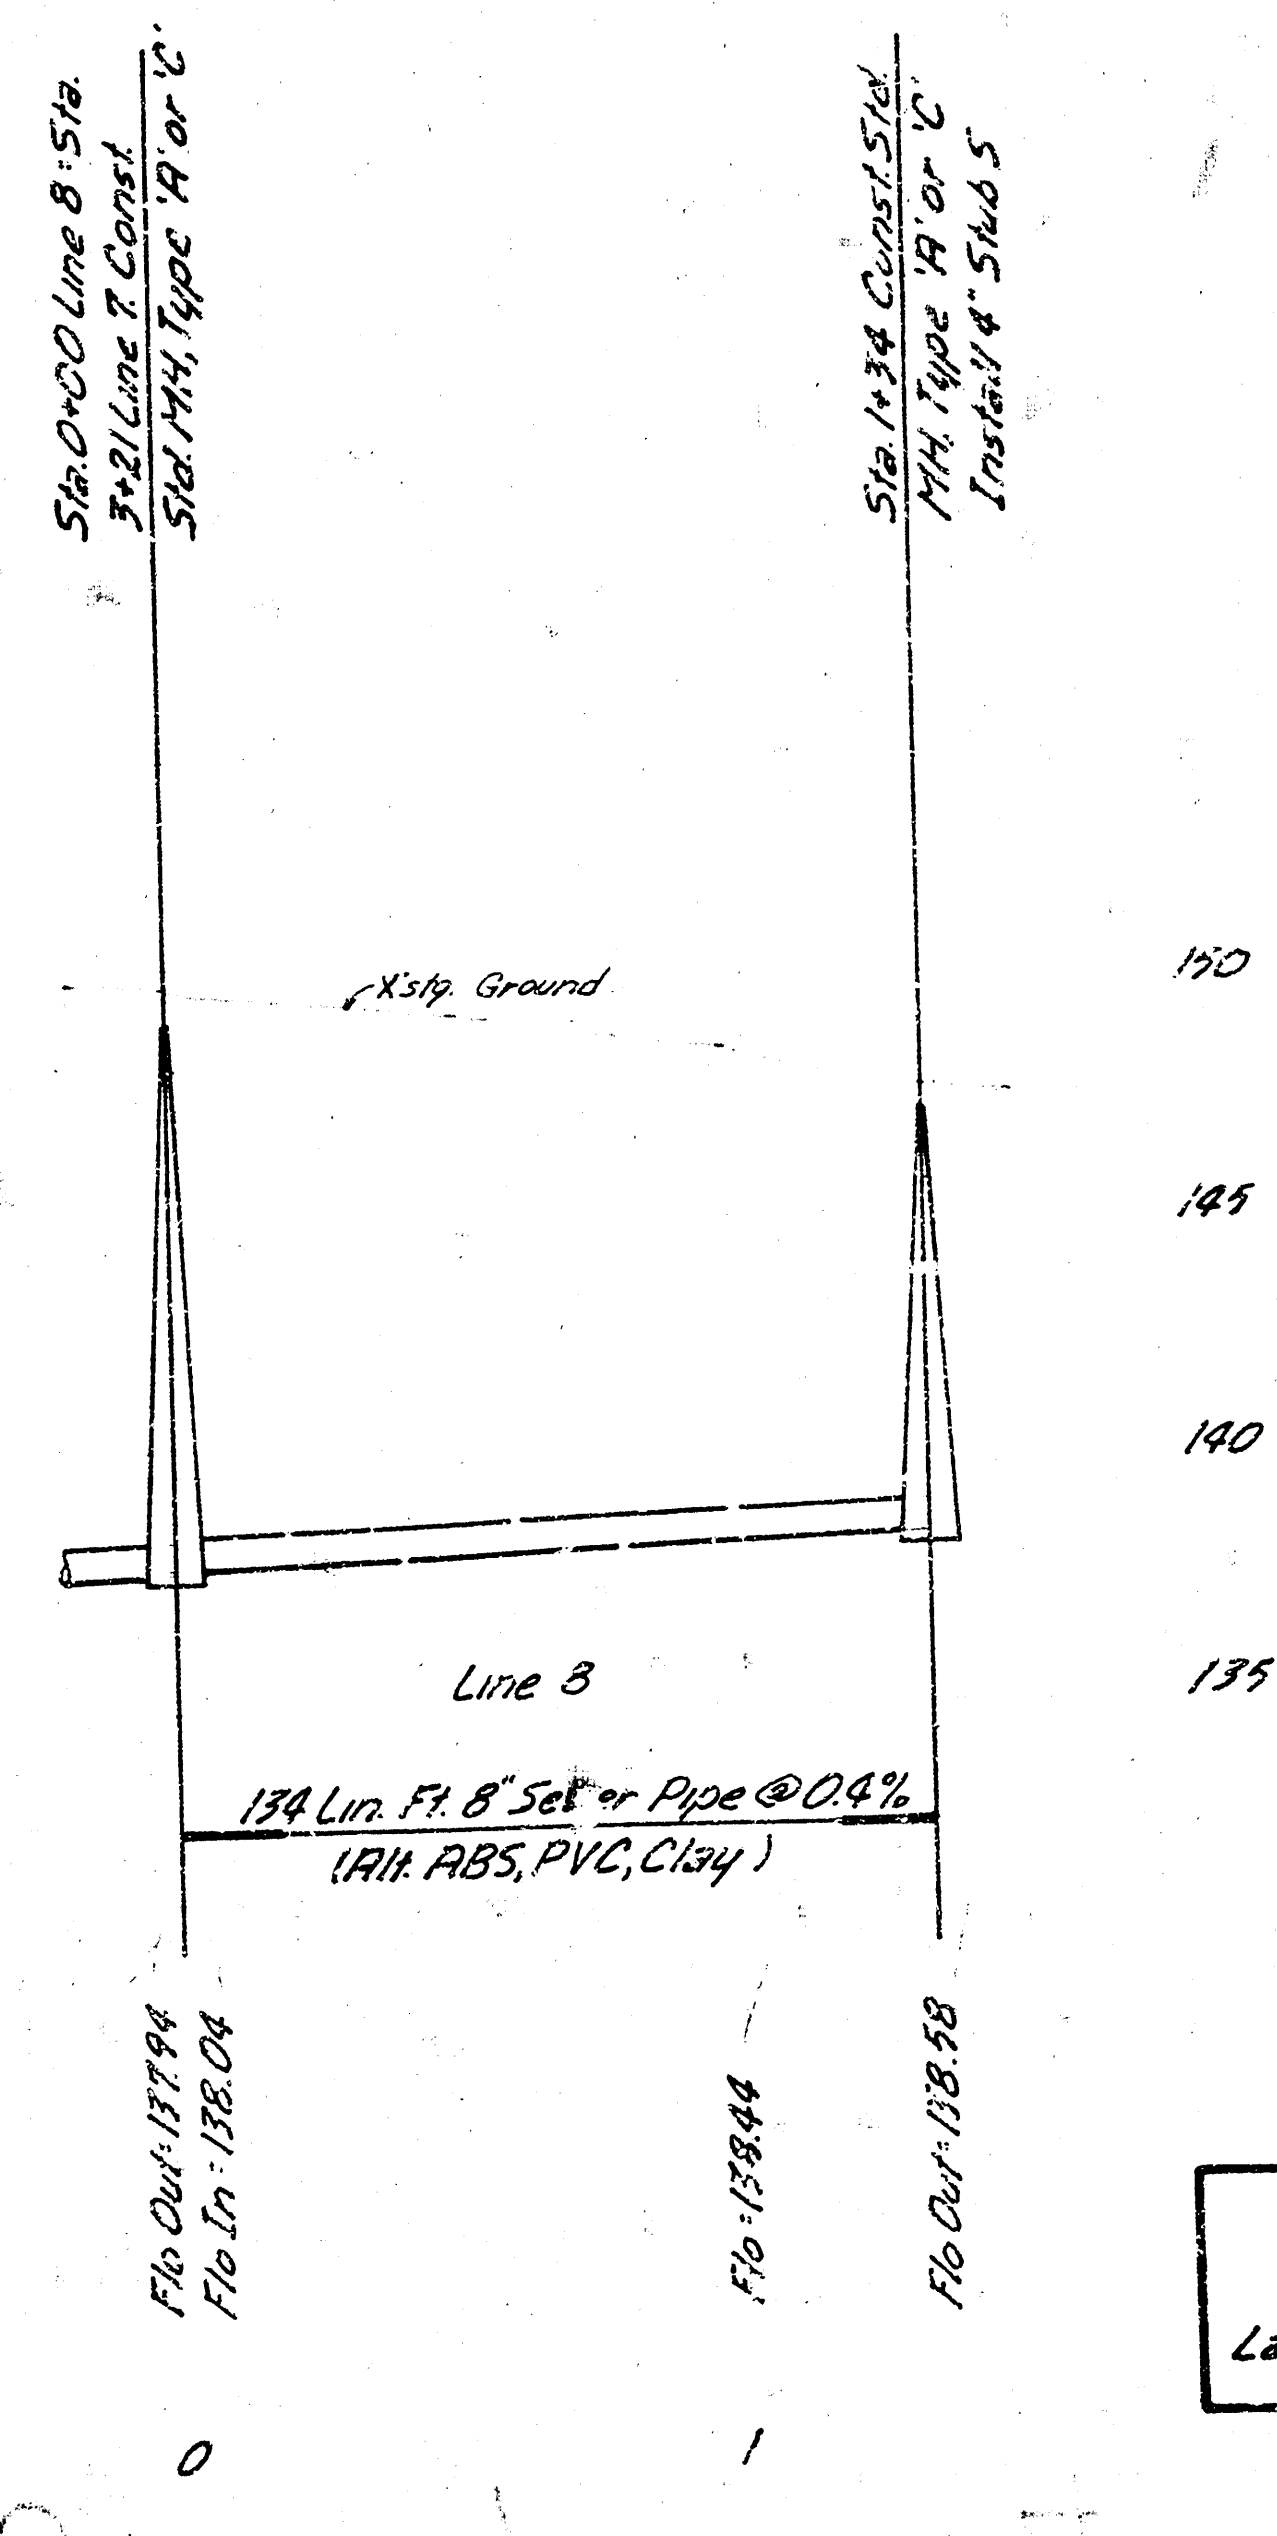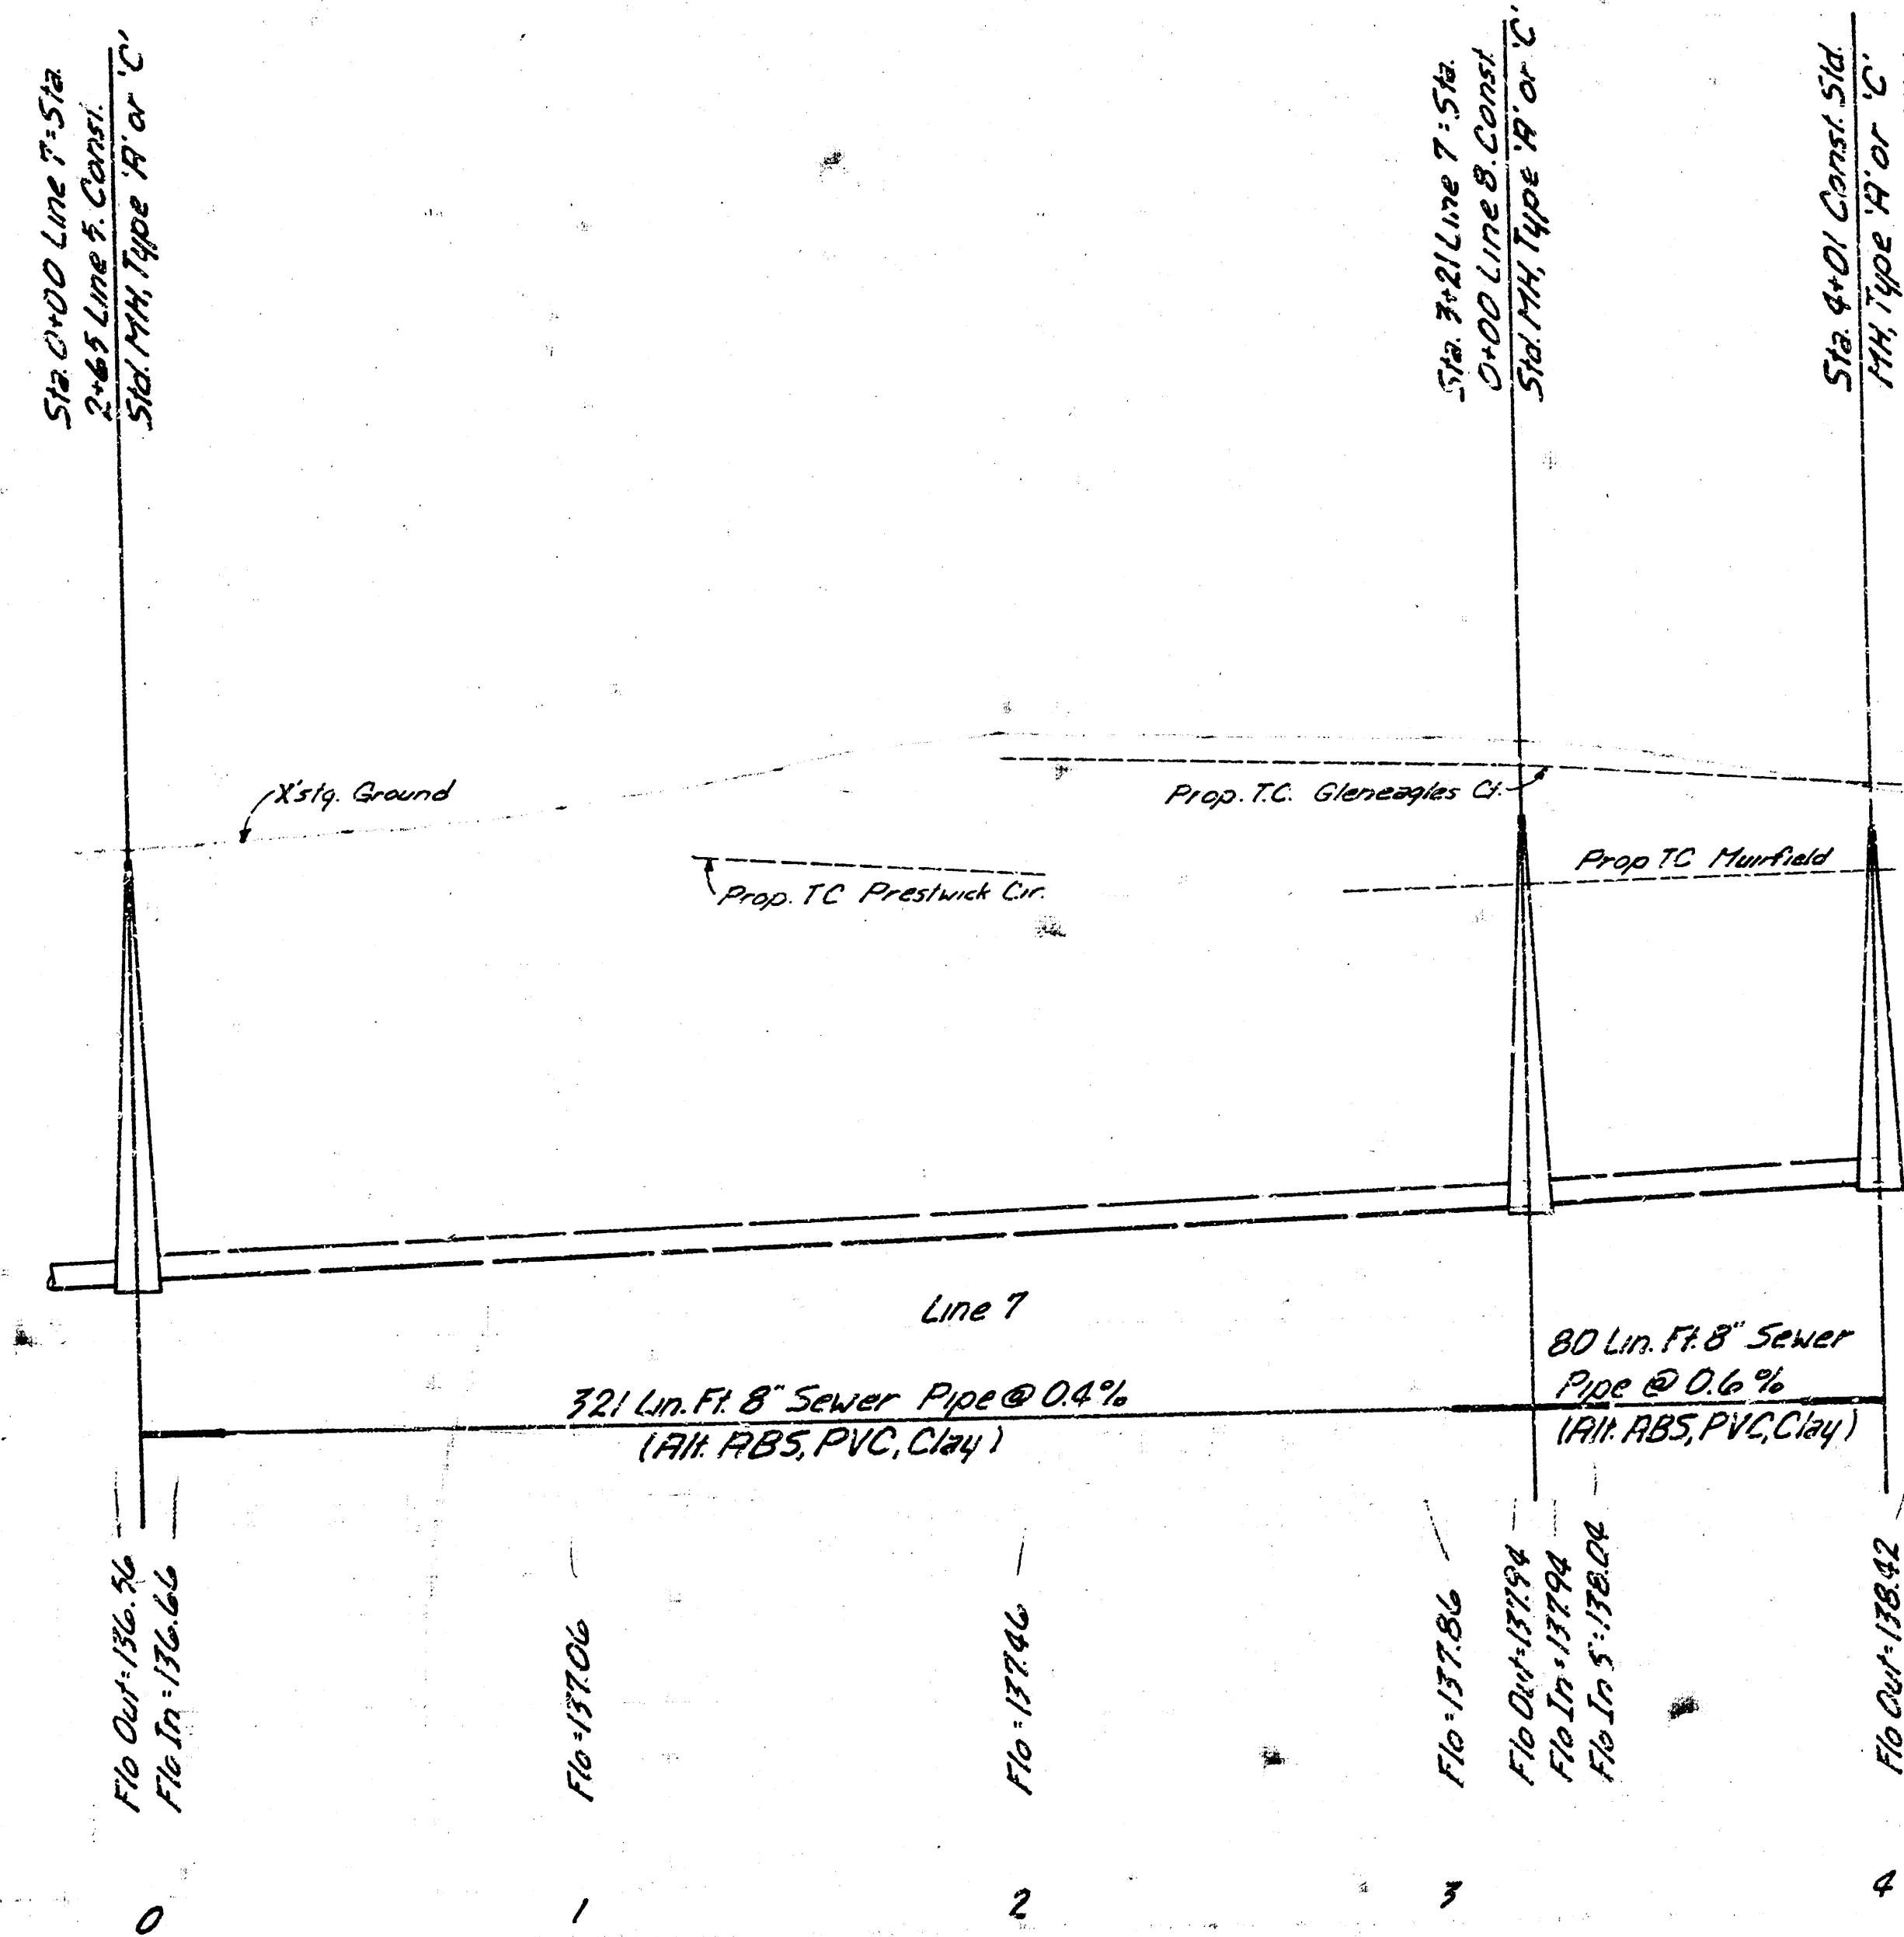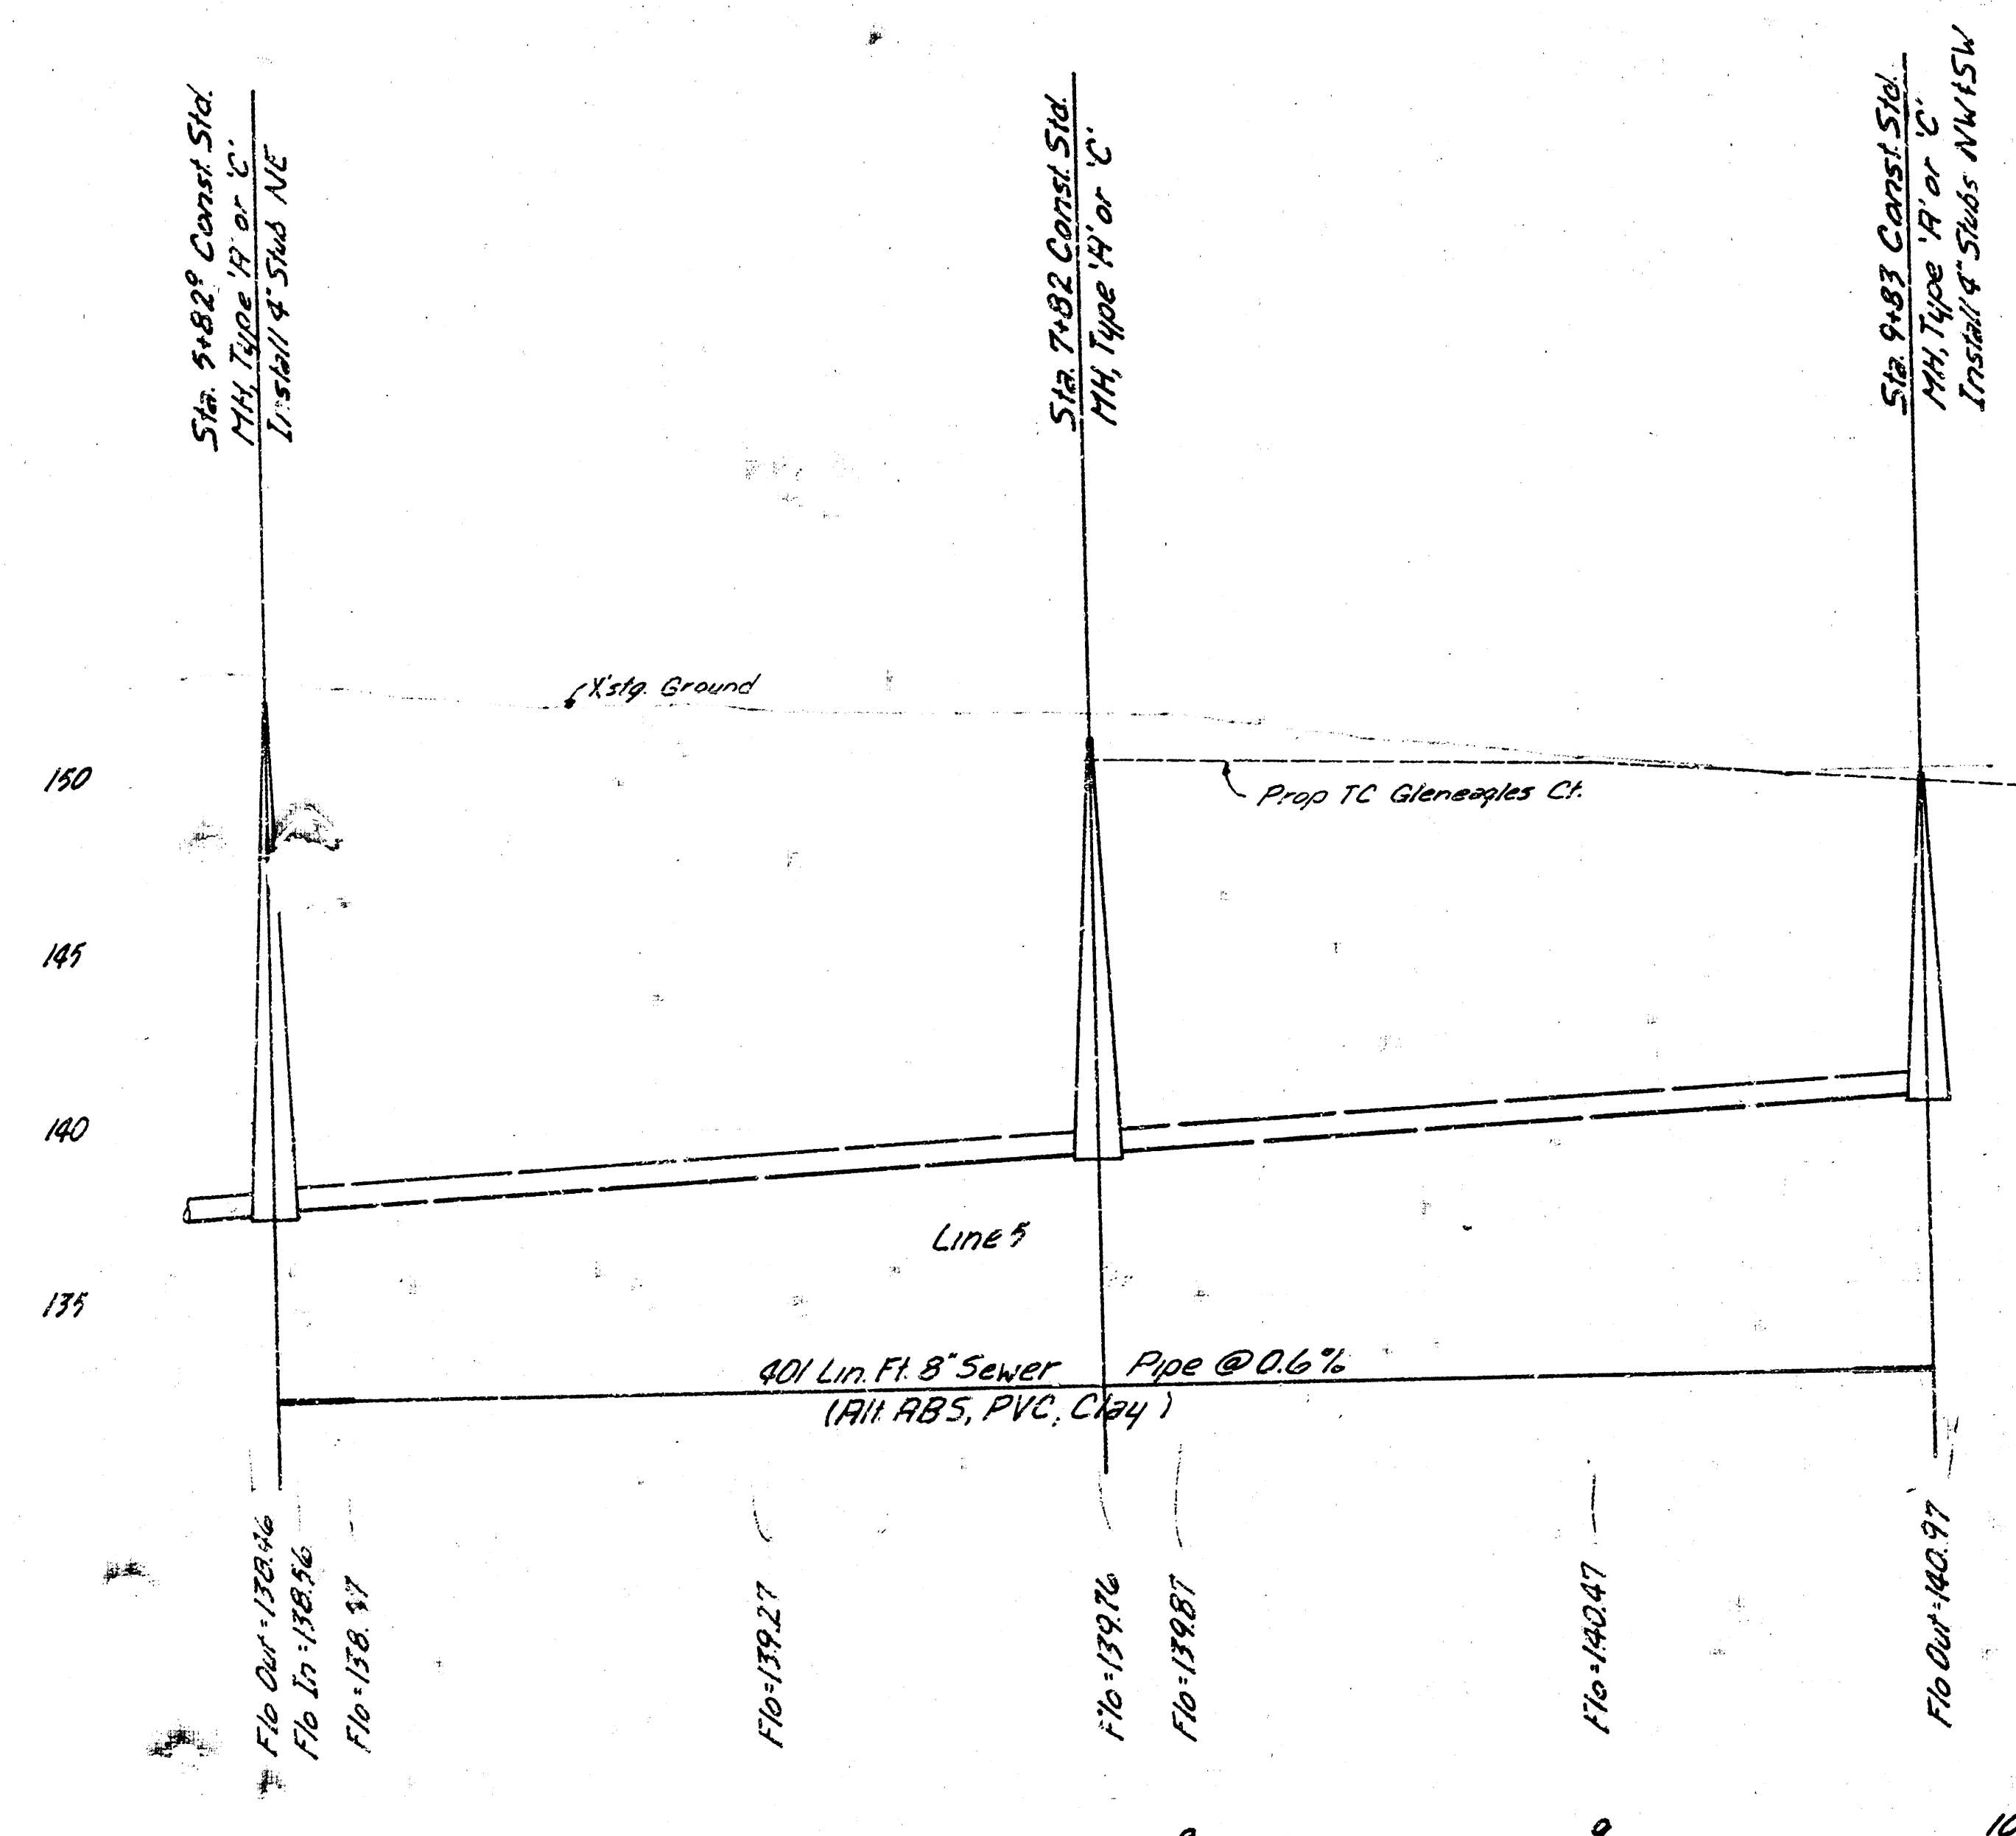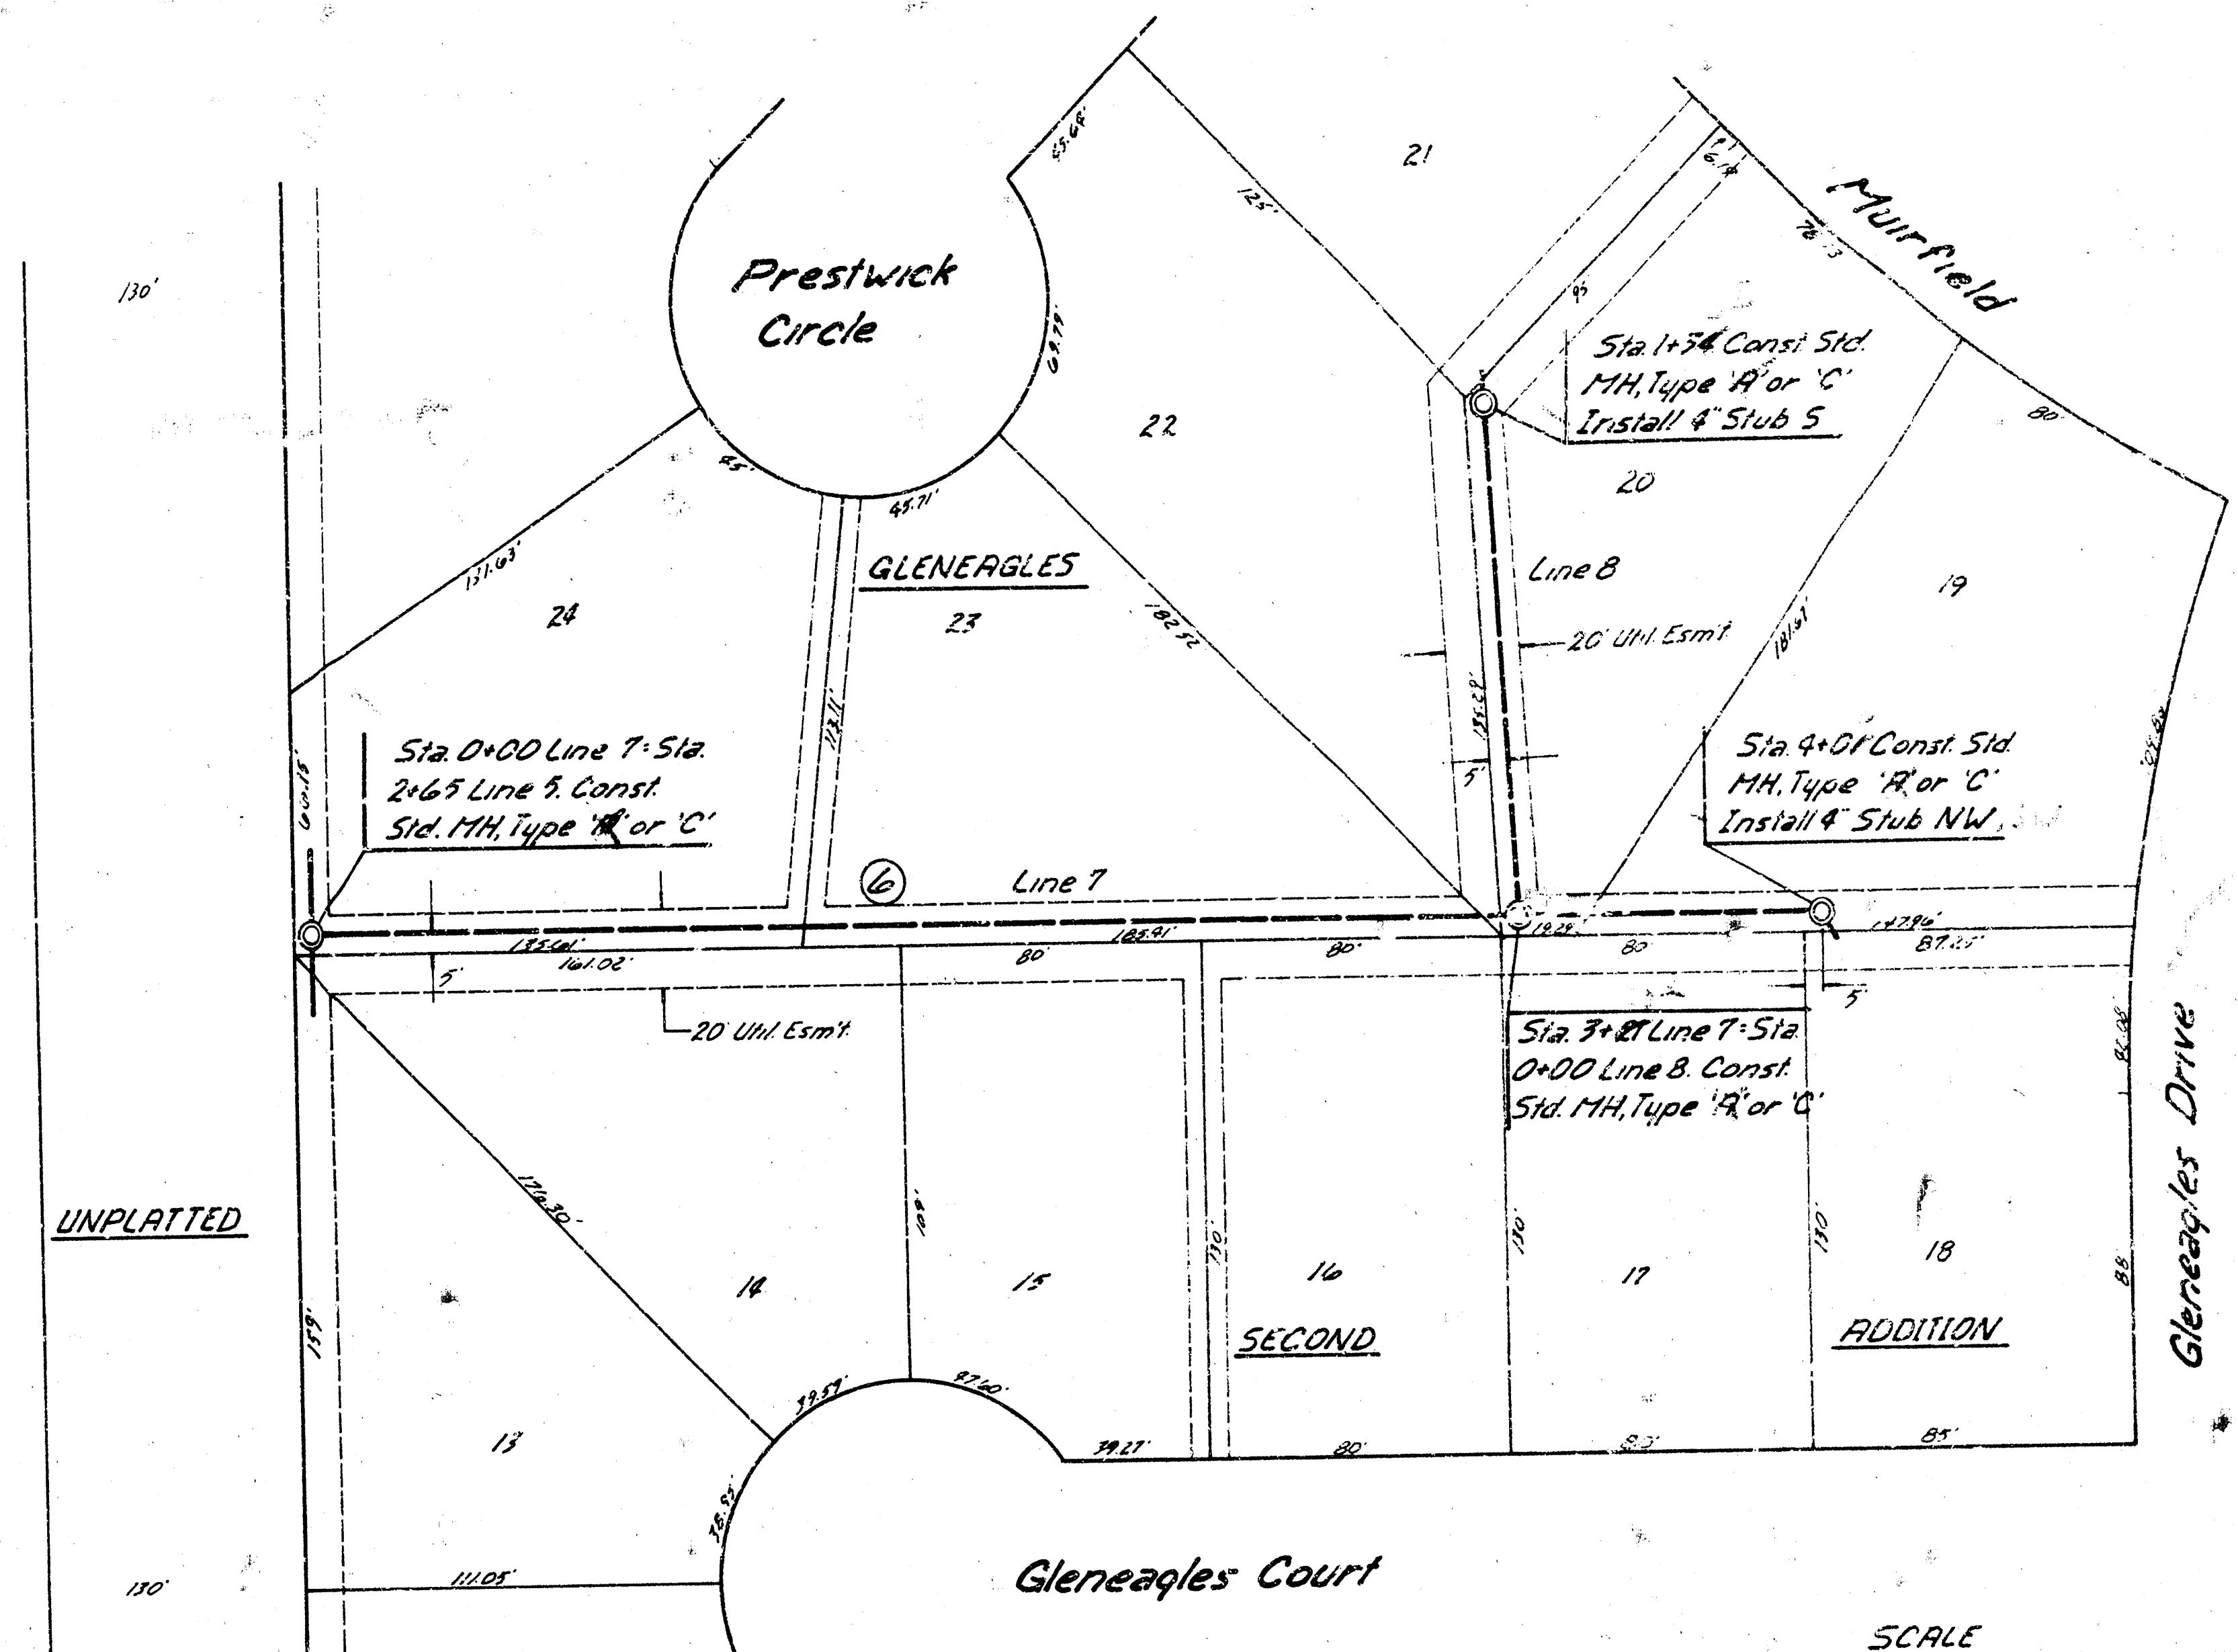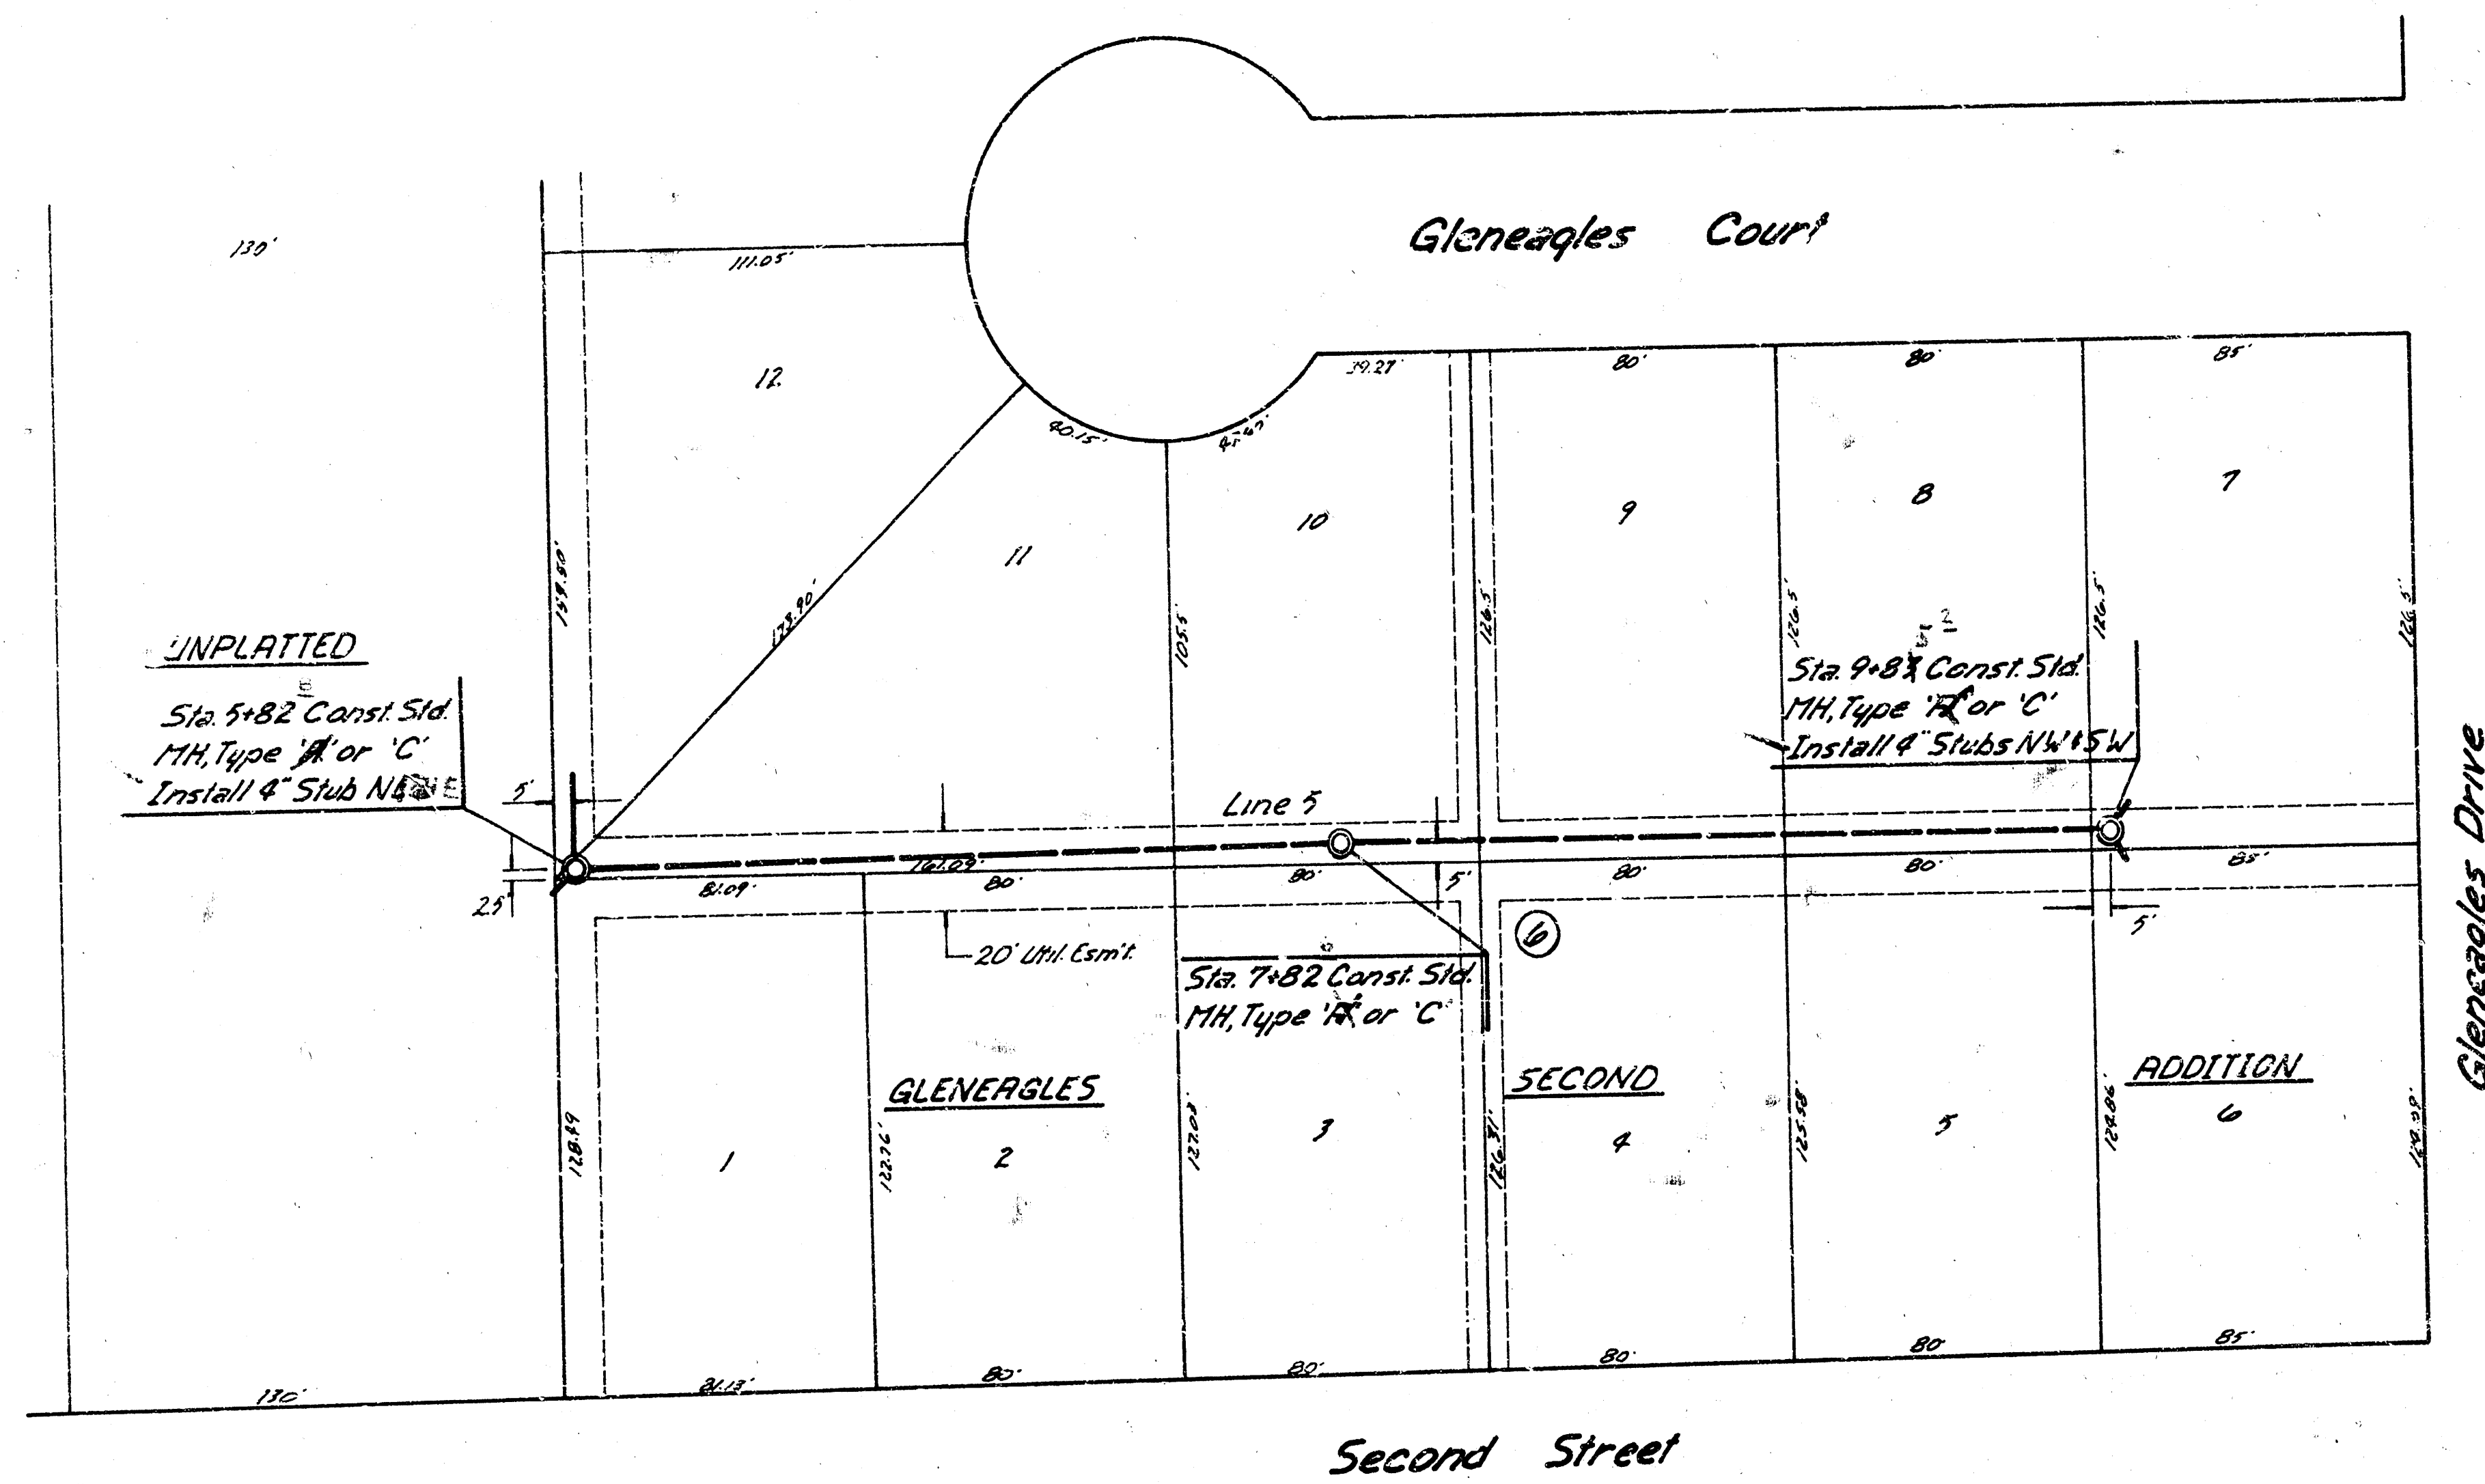

SCALE
Plan 1"=40'
Profile Vert. 1"=5'

Lines 5, 7 & 8
Lateral 38, Main 4, 5 & 1