



BM143.45 Chiseled "a" in light pole base at South R/W line of Maple St. 8 68 Ft.
East of East R/W line of Woodchuck.
BM138.73 Chiseled "D" on 2'x6" Concrete Headwall at north side of drive at 517 Topaz

TURQUOISE

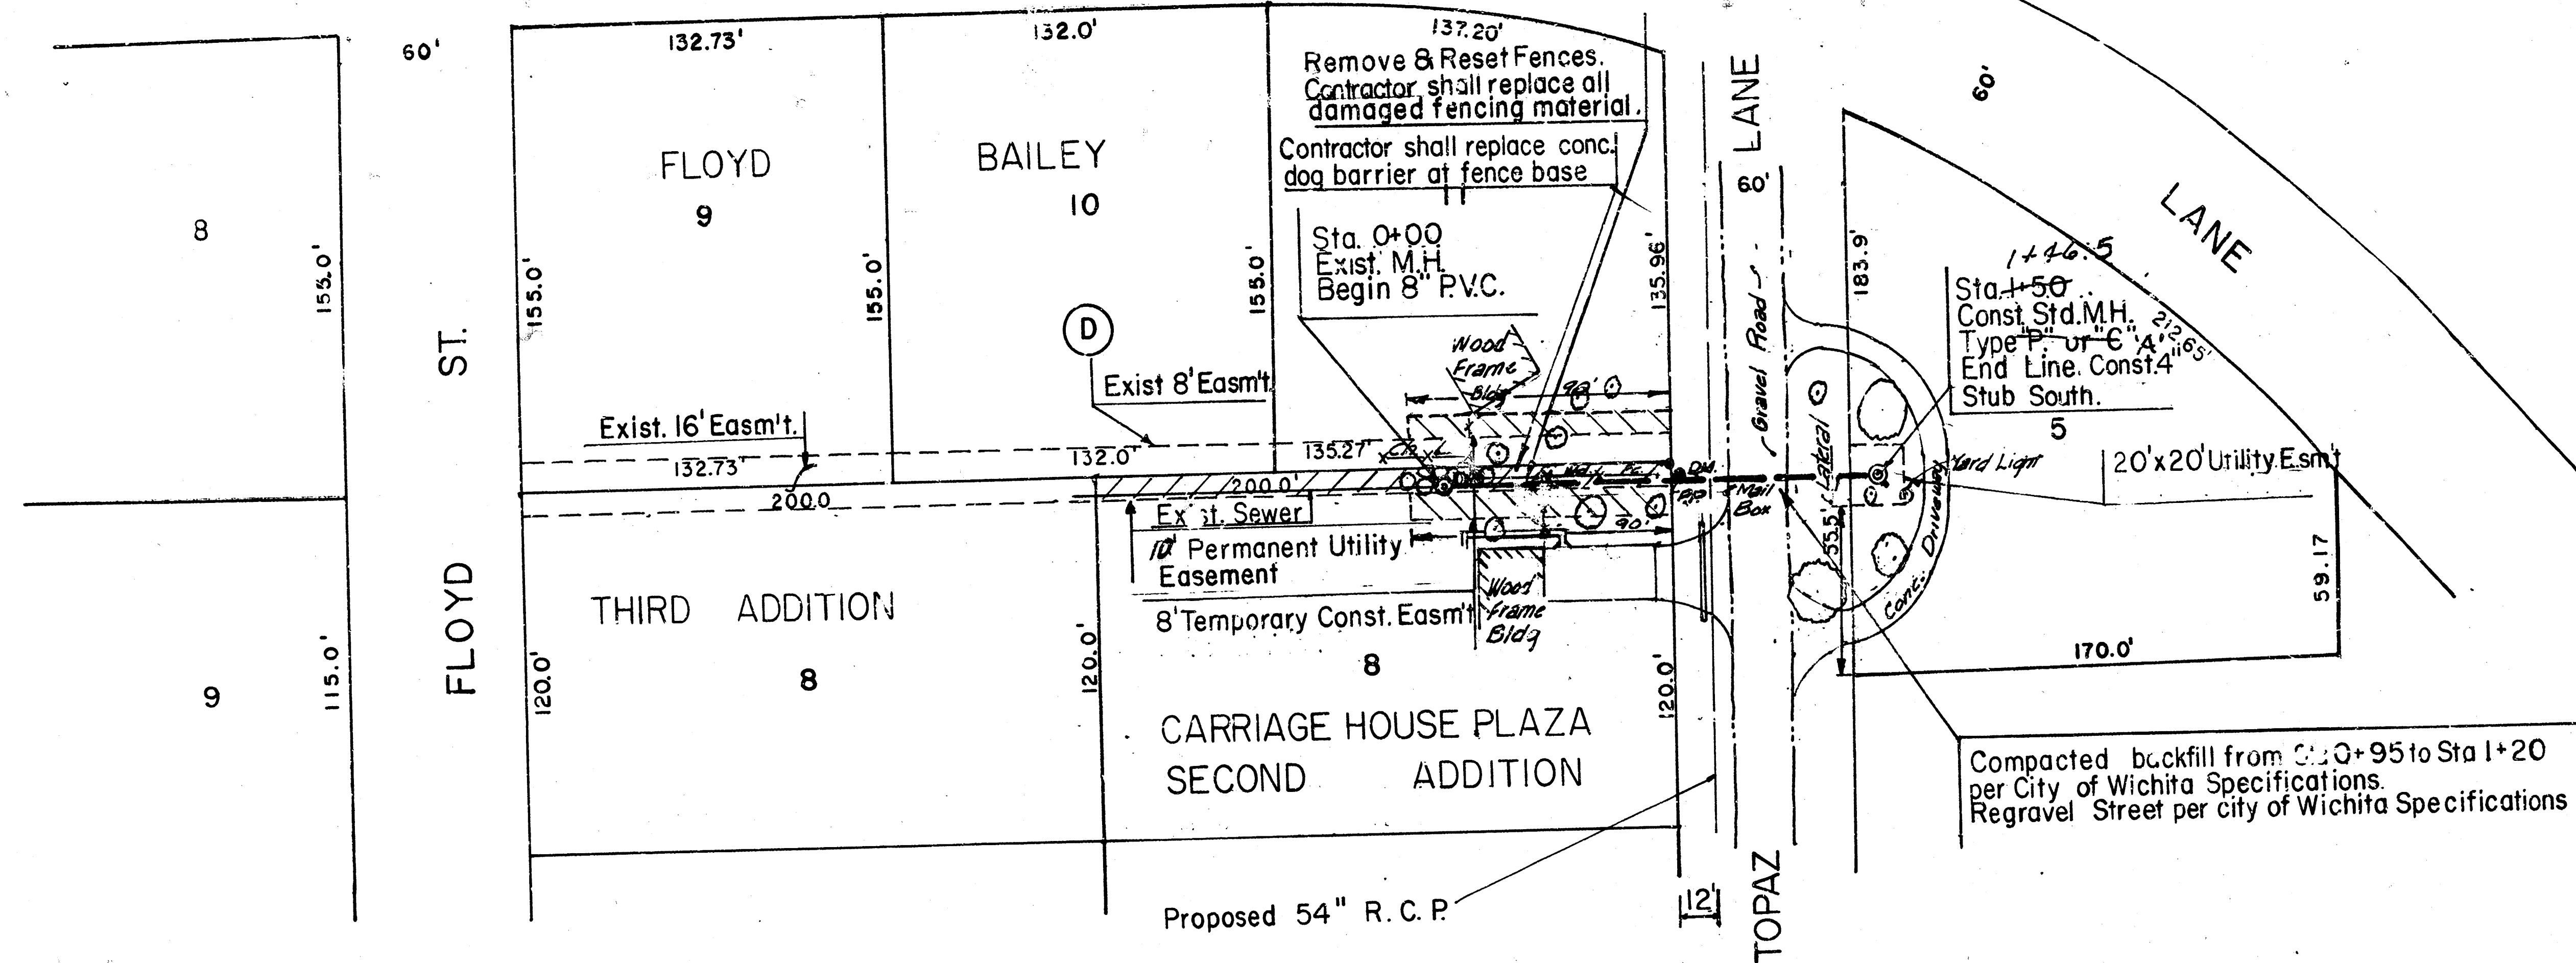

Plan Scale 1" = 40'
Profile Scale 1" = 40' Horiz.
1" = 5' Vert.

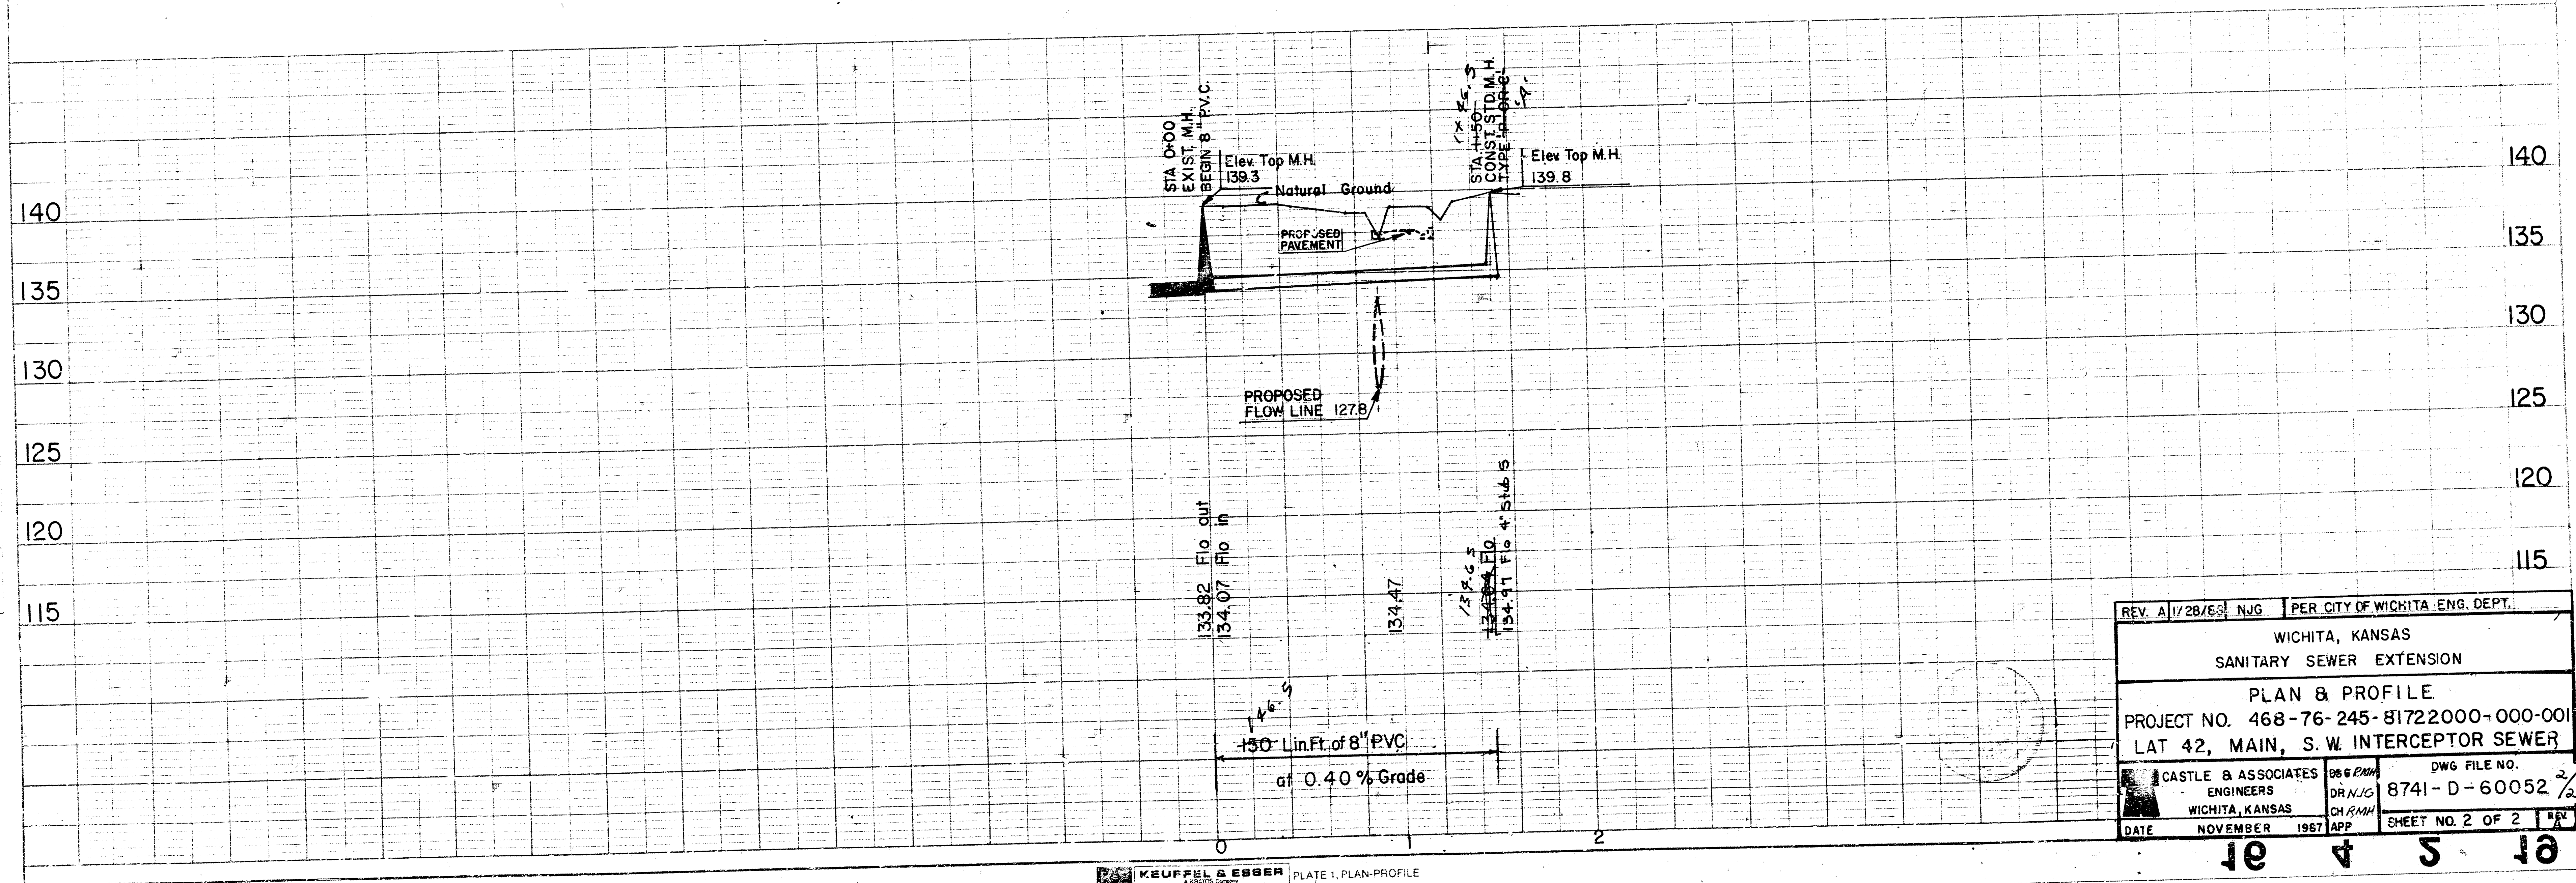

REV. A 11/28/83 NJG		PER CITY OF WICHITA ENG. DEPT.	
WICHITA, KANSAS			
SANITARY SEWER EXTENSION			
PLAN & PROFILE			
PROJECT NO. 468-76-245-81722000-000-001			
LAT 42, MAIN, S. W. INTERCEPTOR SEWER			
CASTLE & ASSOCIATES ENGINEERS WICHITA, KANSAS	DR. NJG CH. RMM APP	DWG FILE NO. 8741-D-60052	2/2
DATE NOVEMBER 1987	SHEET NO. 2 OF 2		