






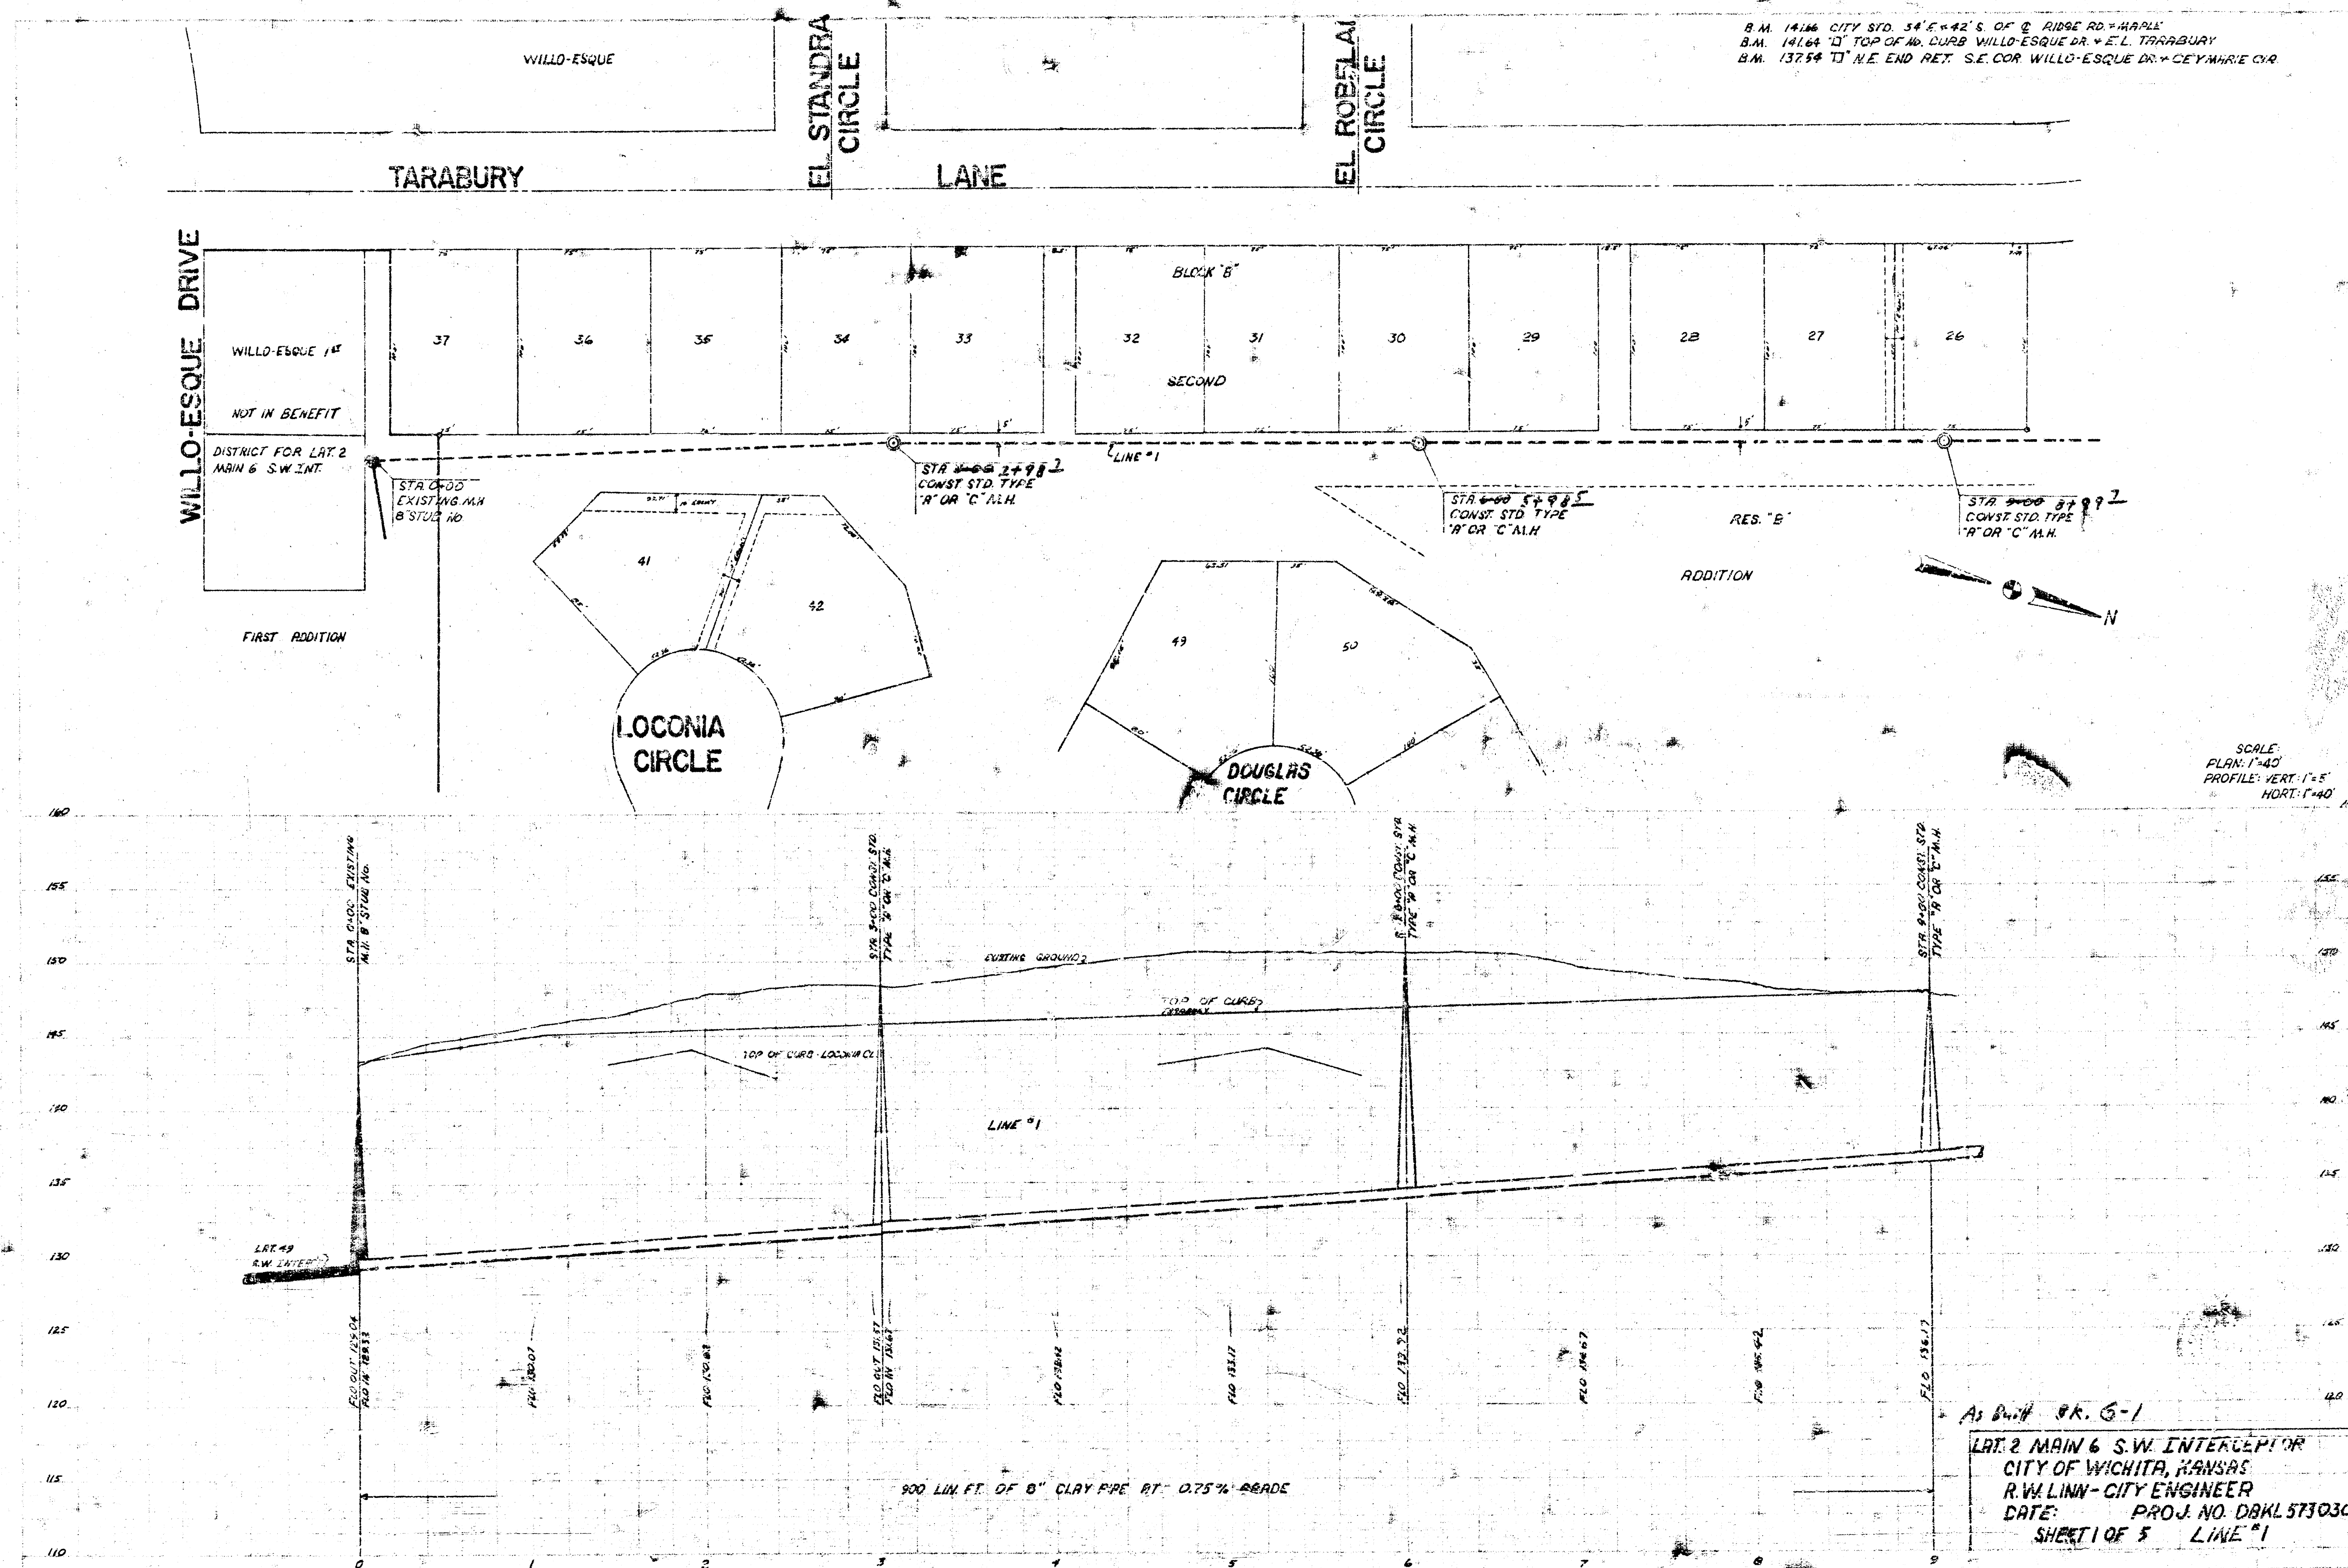

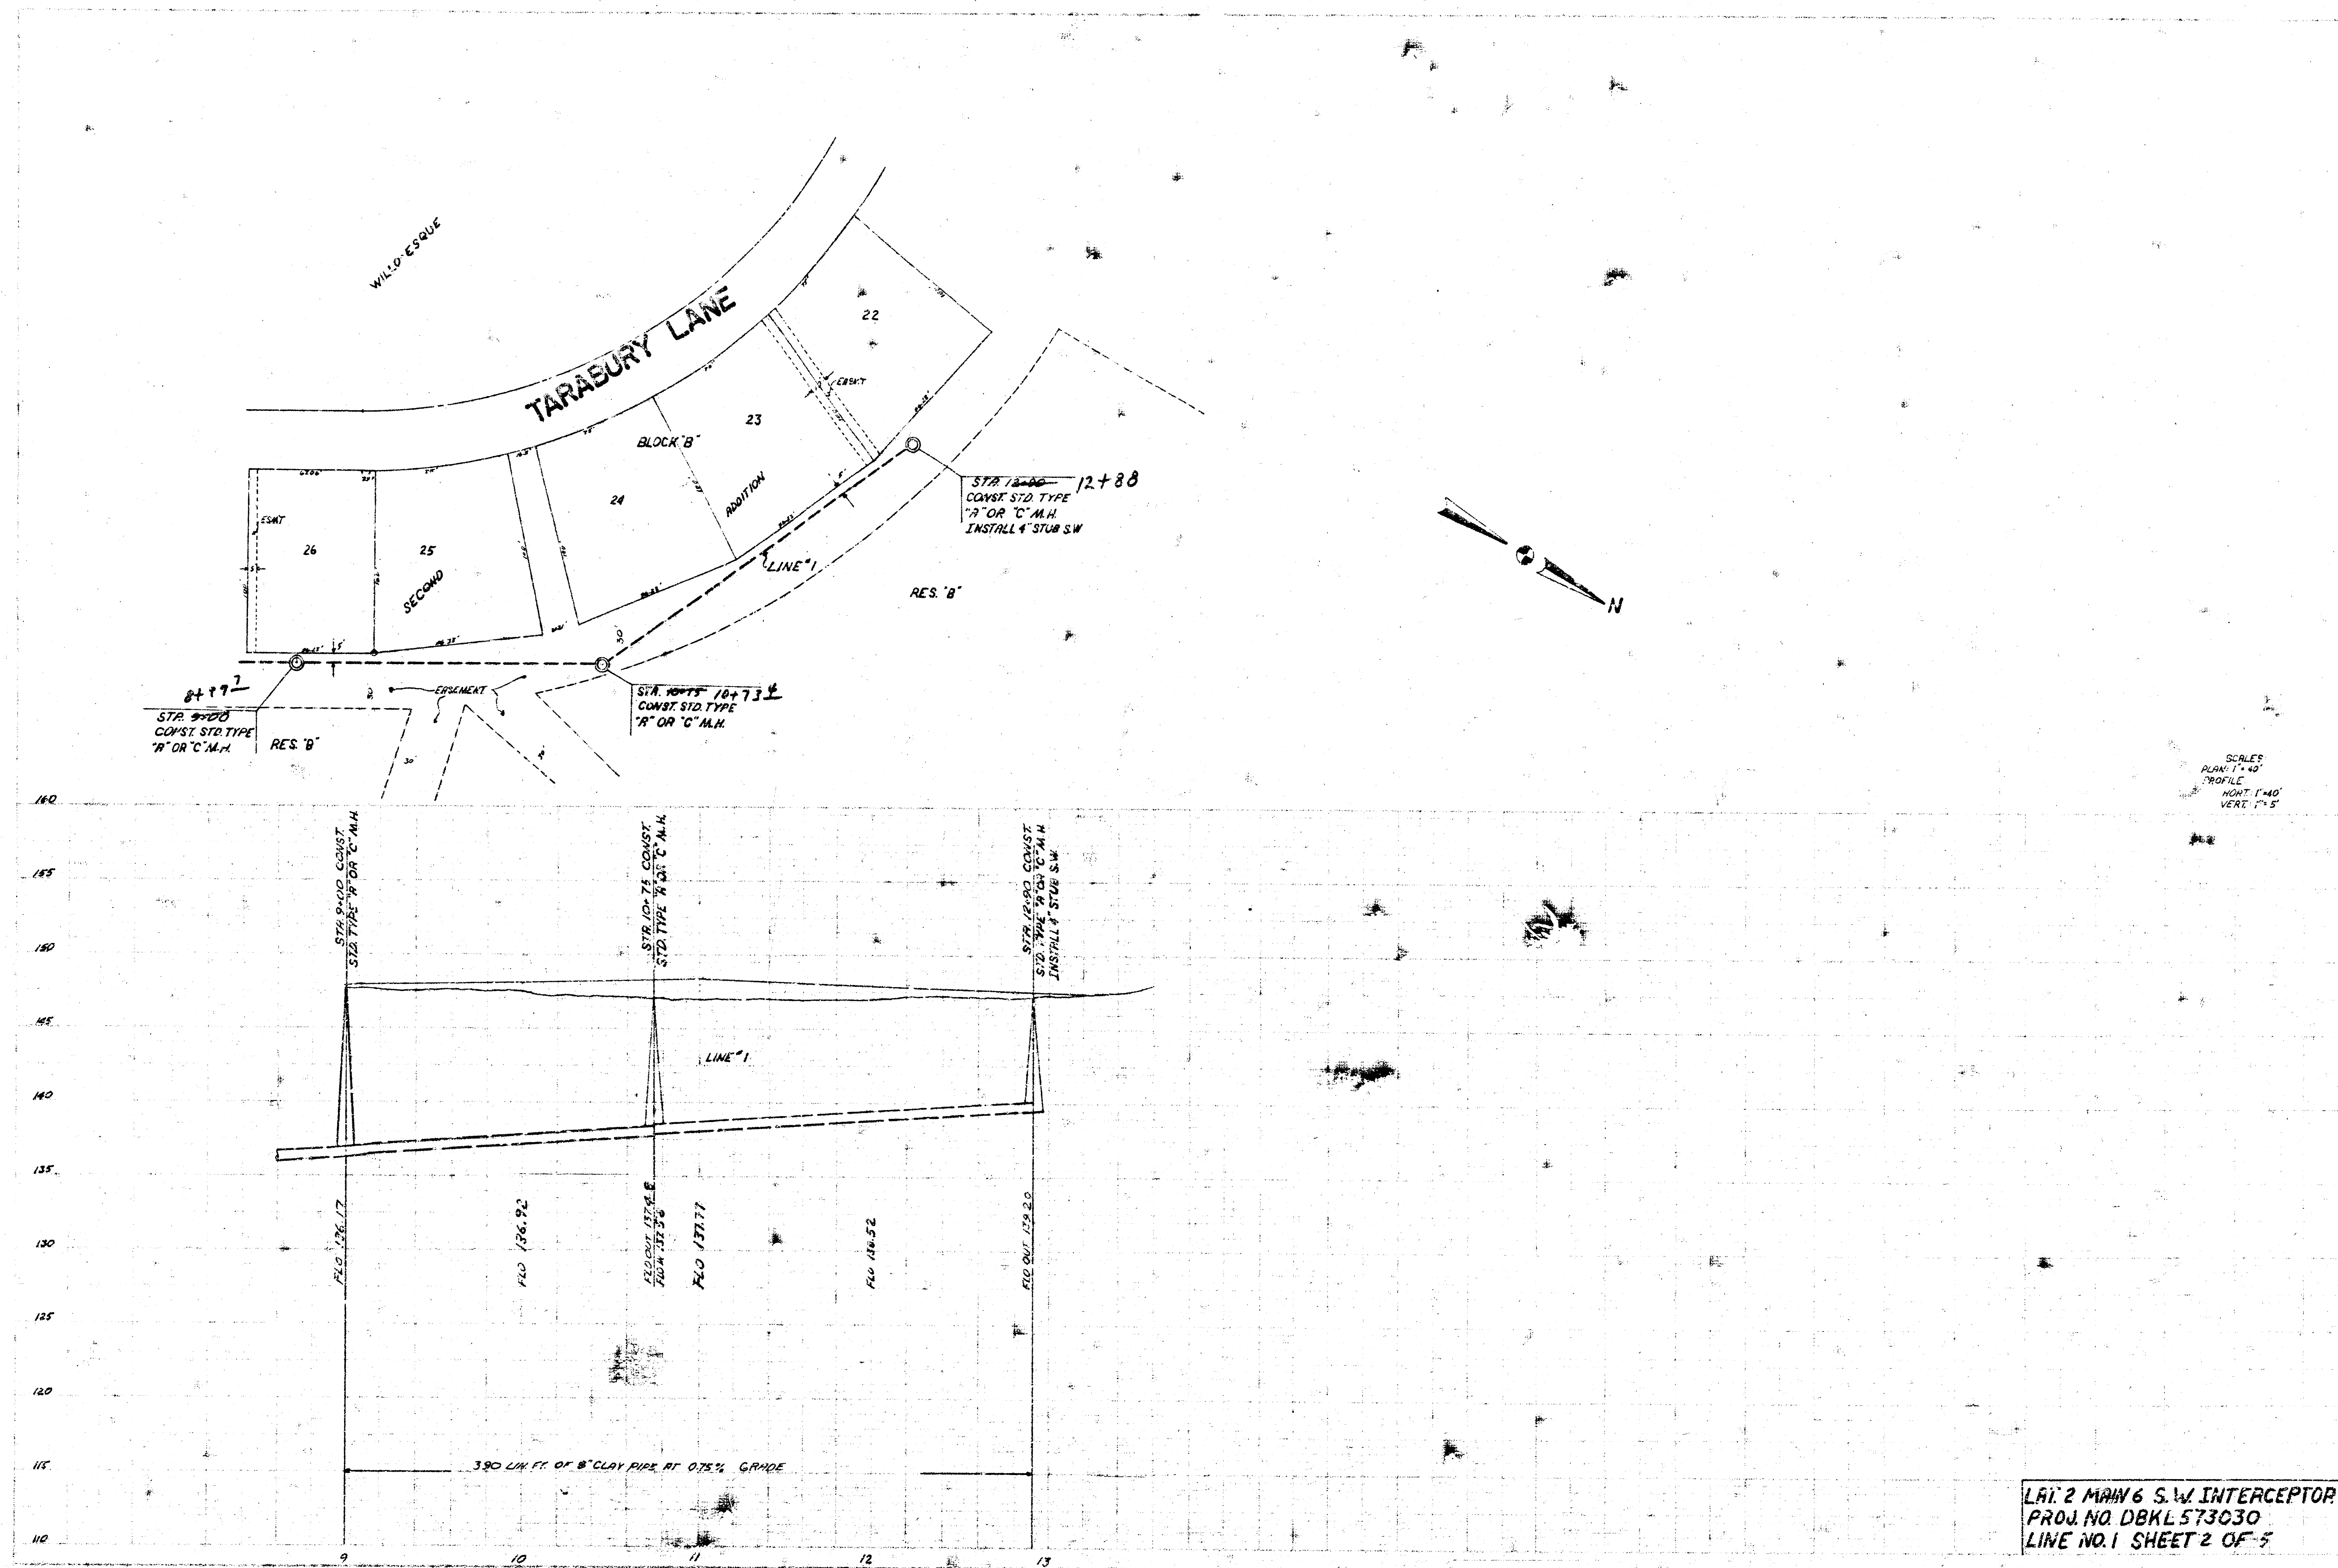

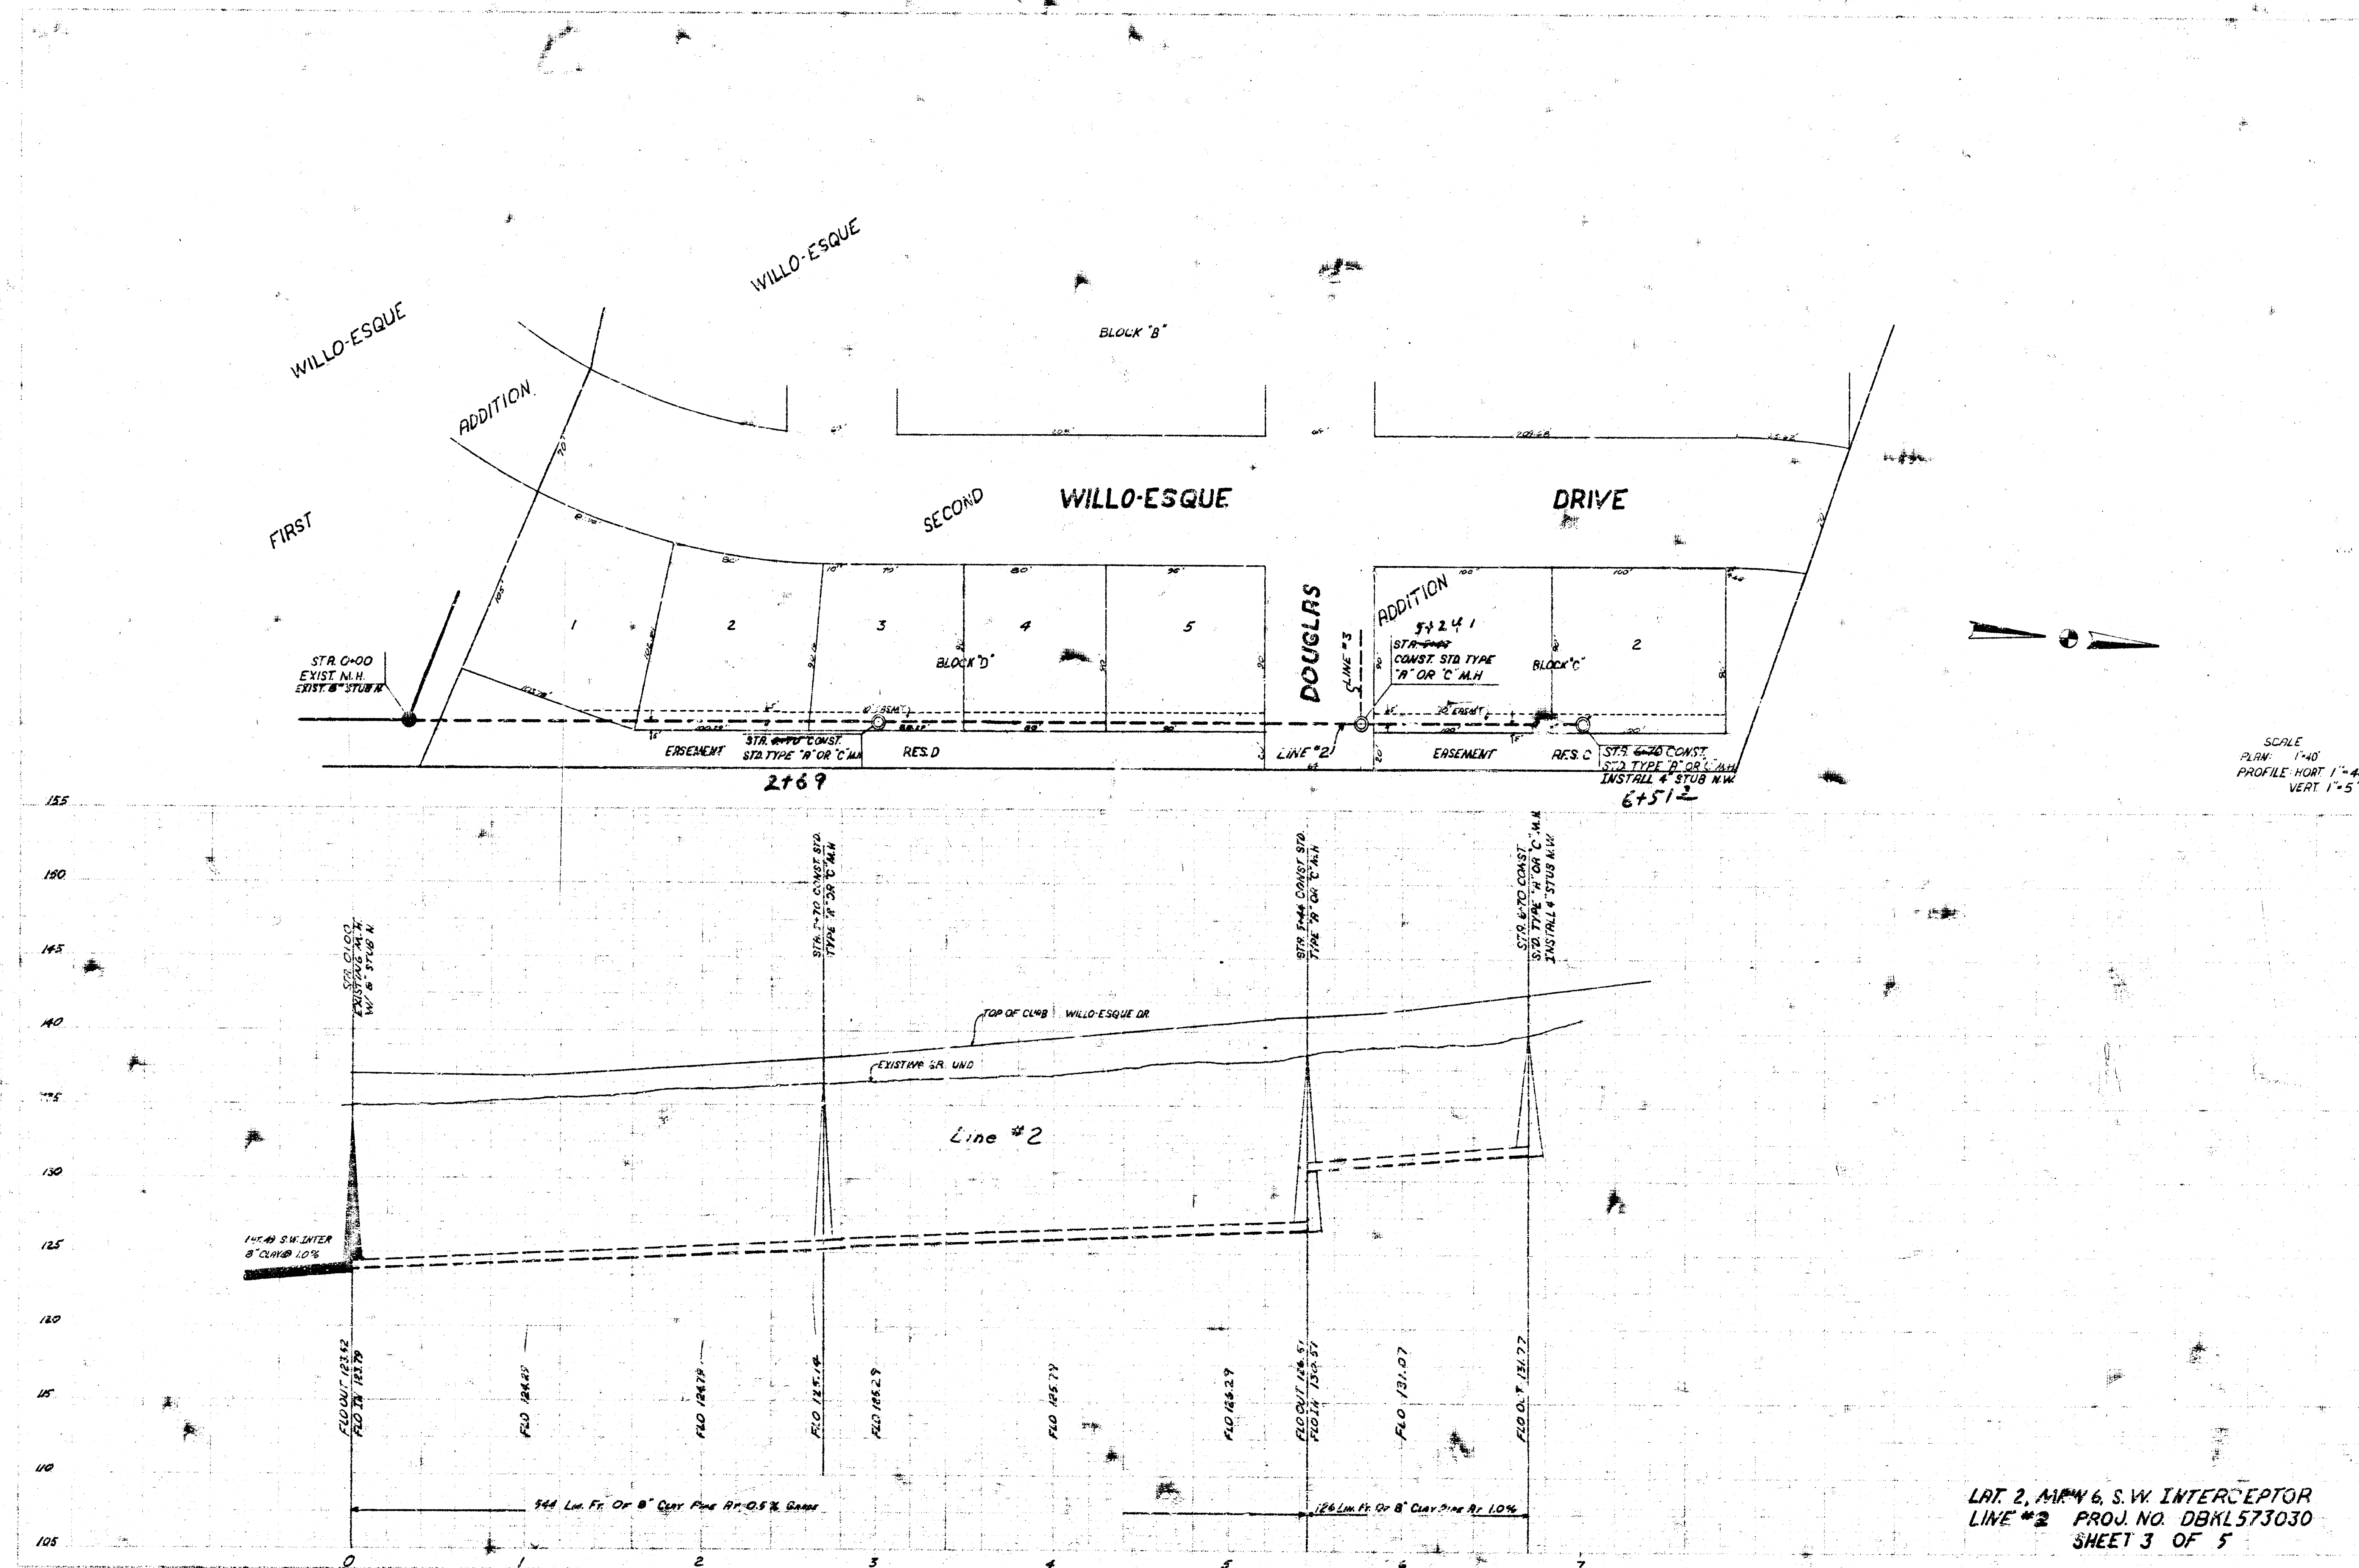

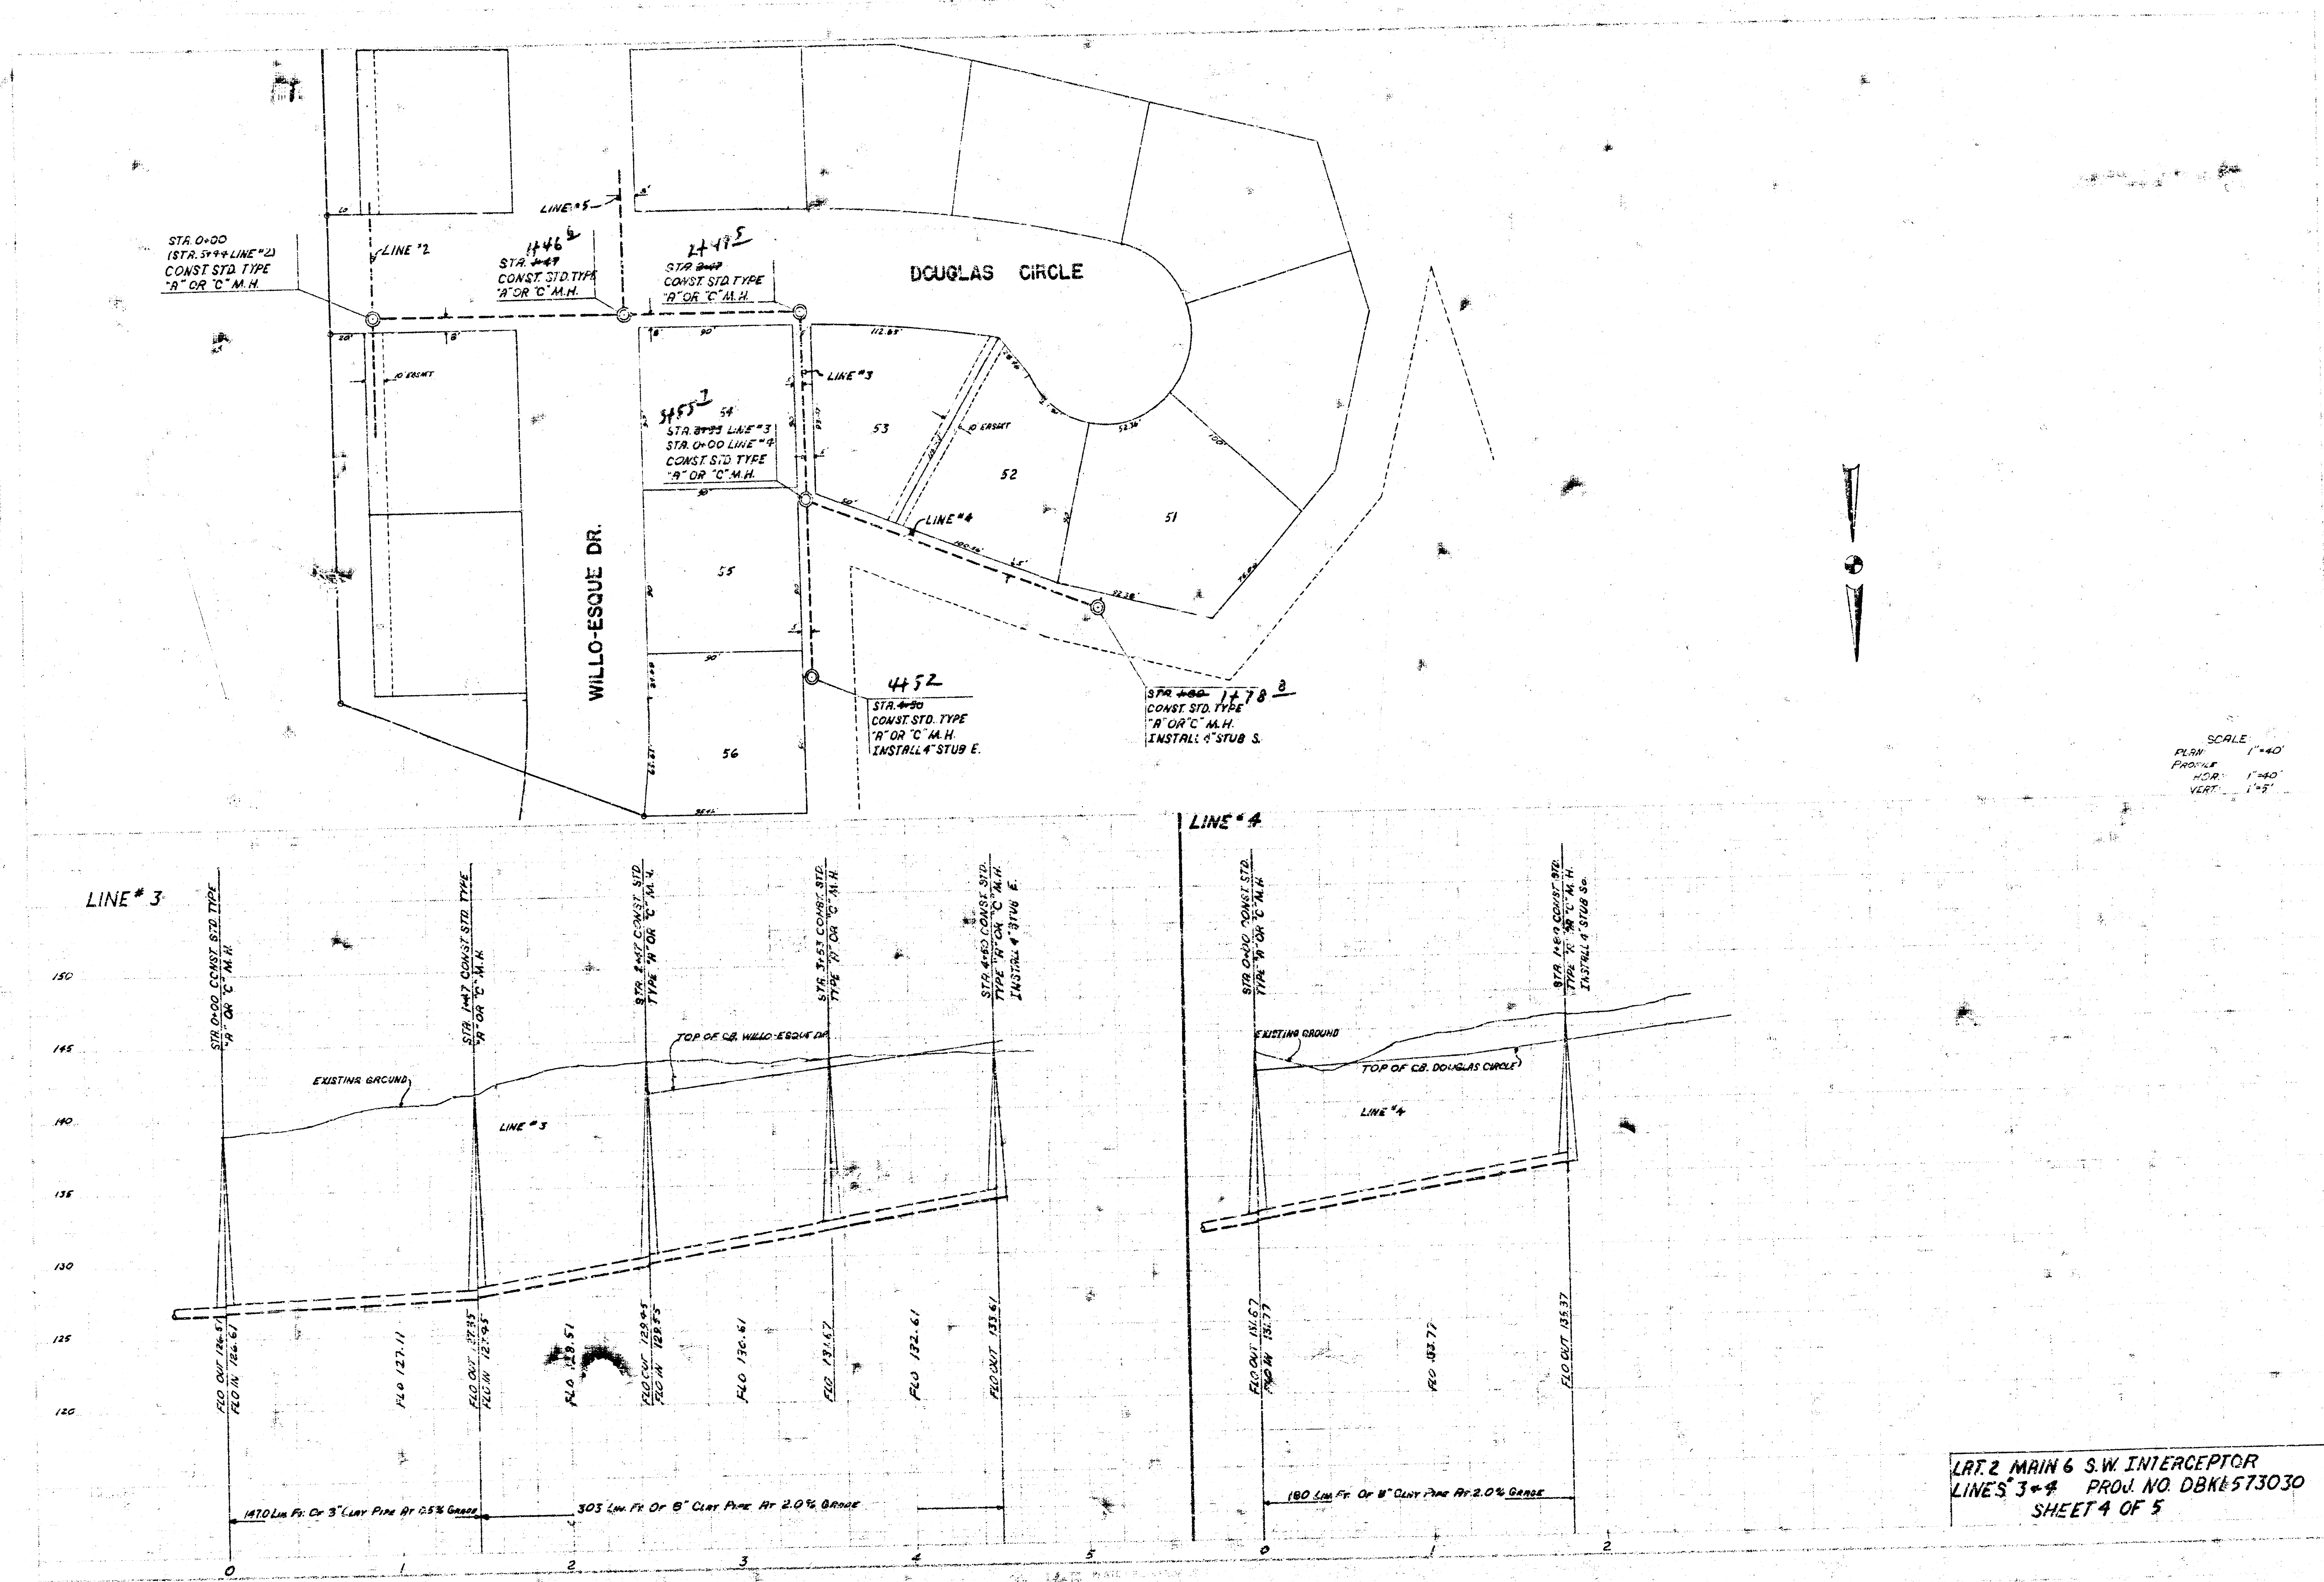

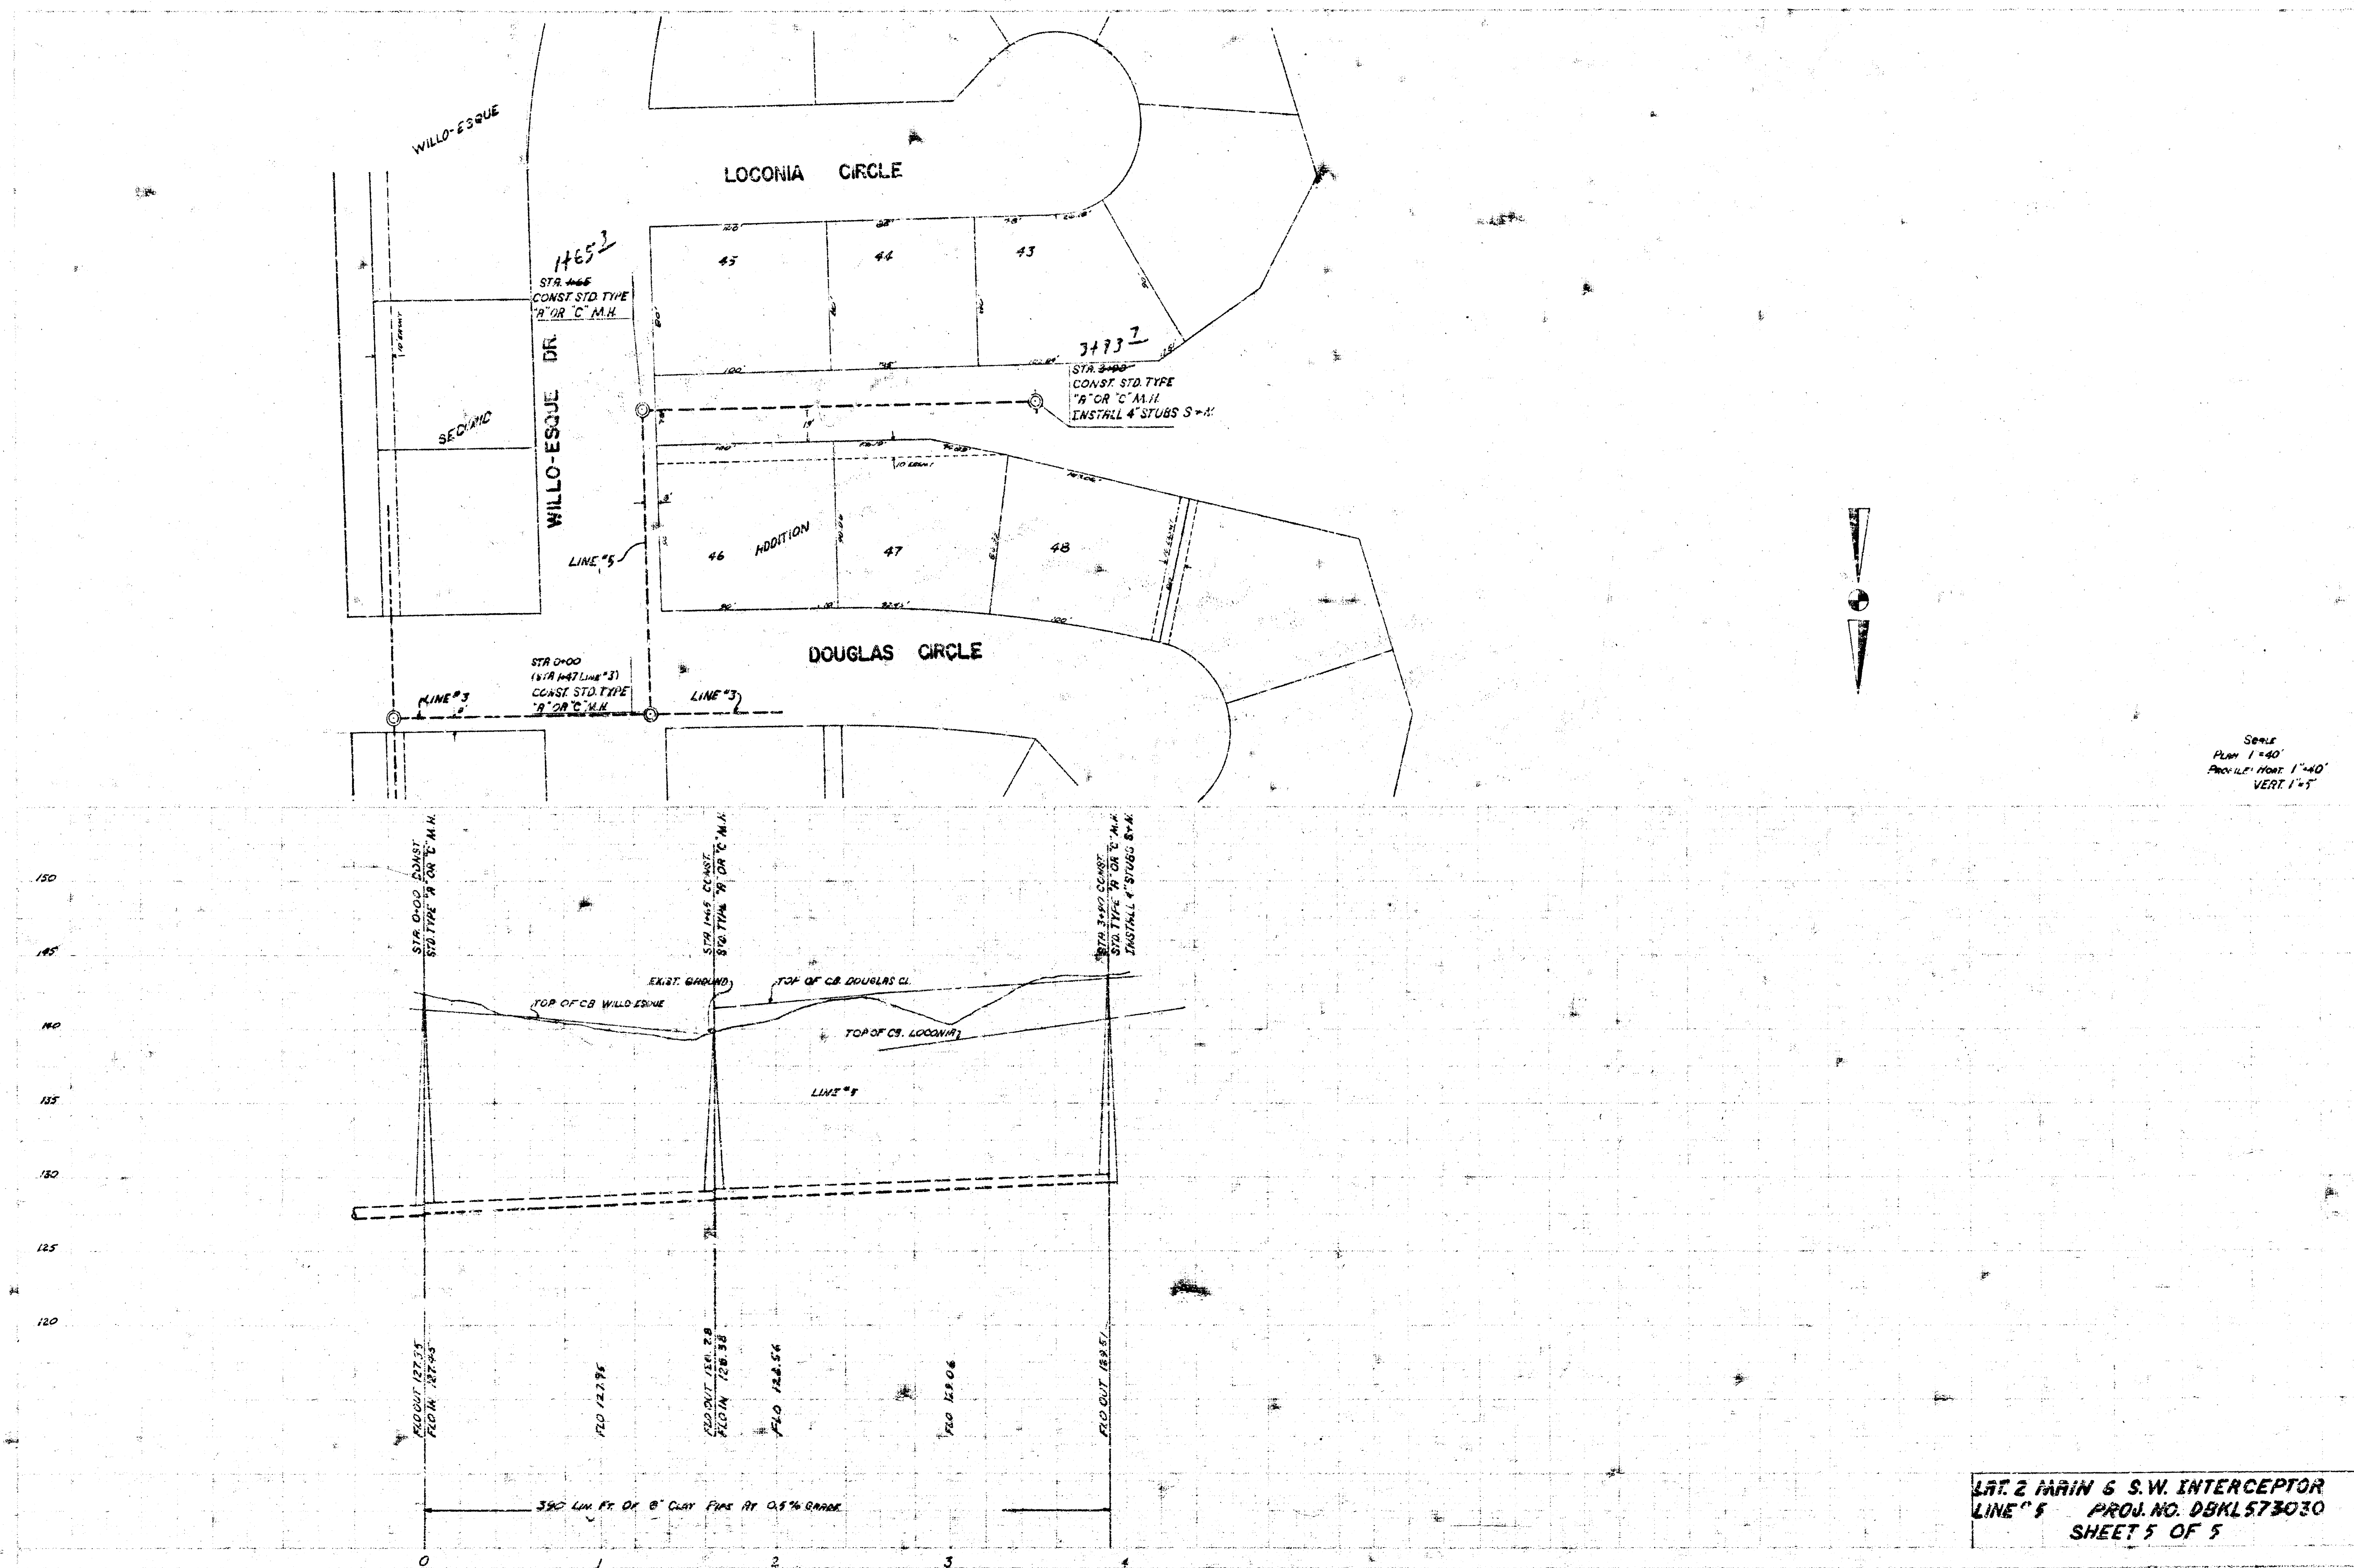

LAT. 2 MAIN & S.W. INTERCEPTOR
 LINE 5
 PROJ. NO. DBN1573030
 SHEET 5 OF 5