





LATERAL 1, MAIN 7A SOUTHWEST INTERCEPTOR

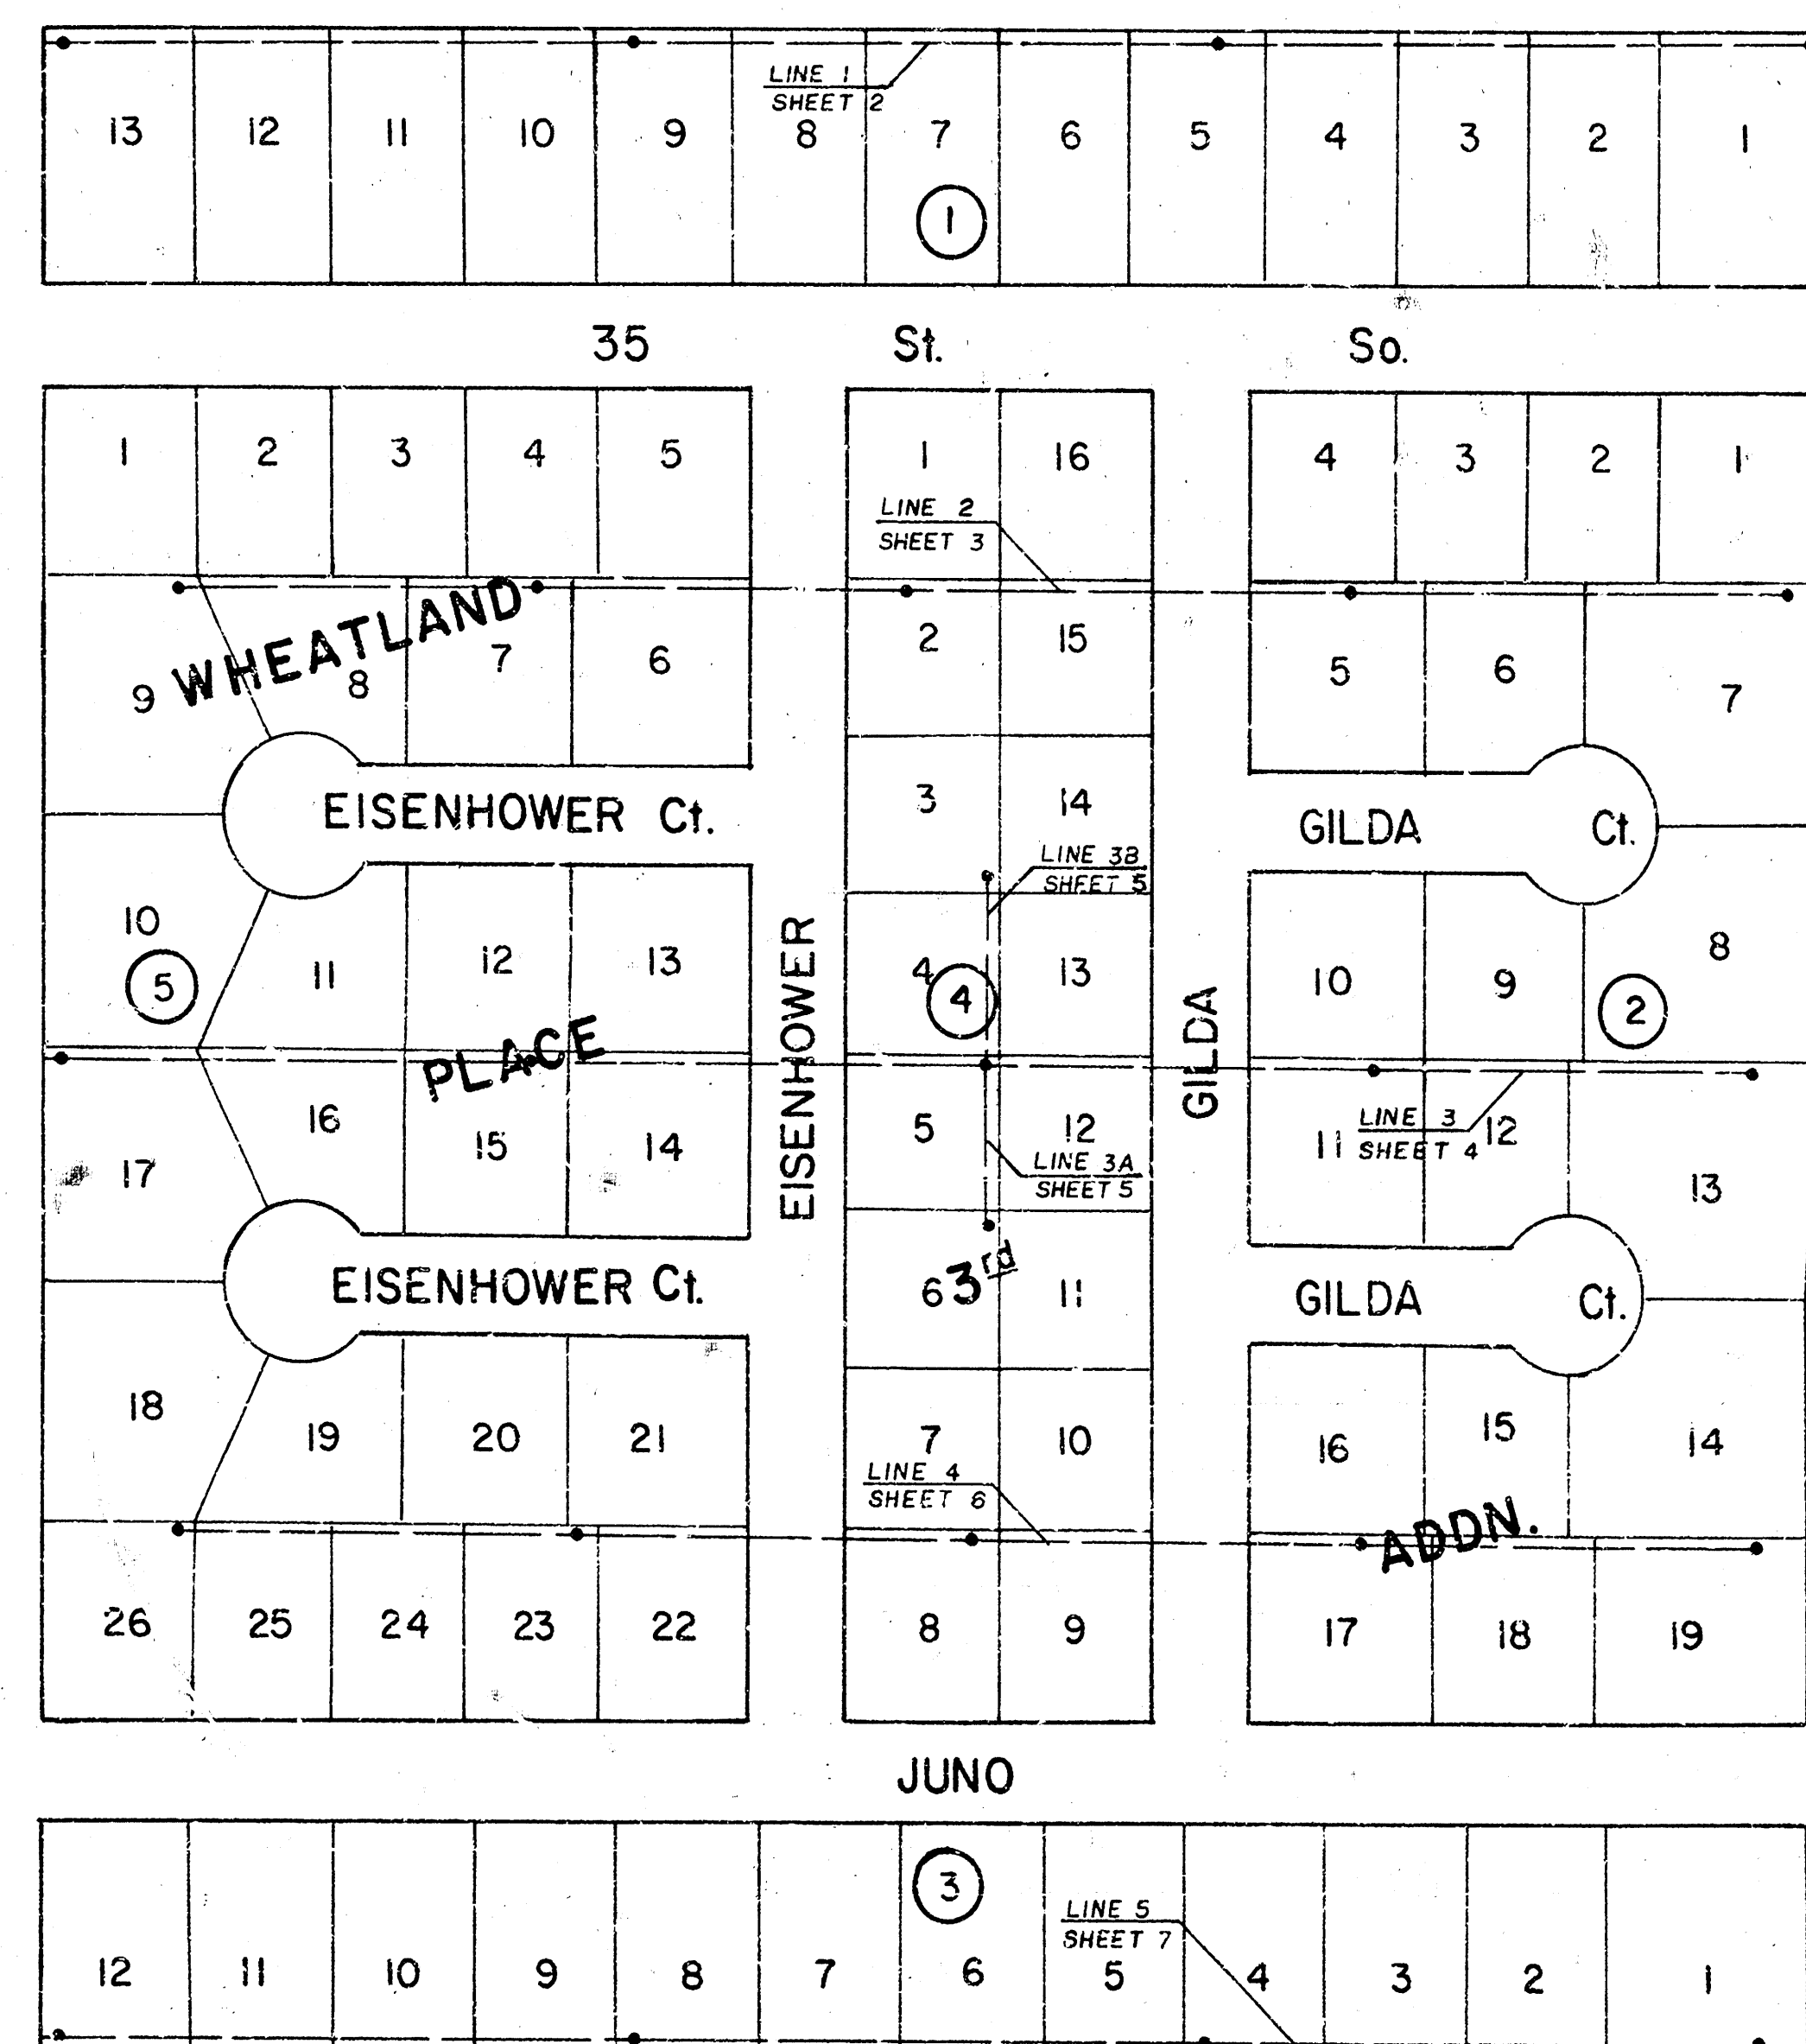


City of WICHITA, KANSAS
 DEAN SELLERS - Acting City Engineer
 Proj. No. : 468-76-245-80944-000-000-001
 Date: _____


As. Built
 9-4-80
 E282

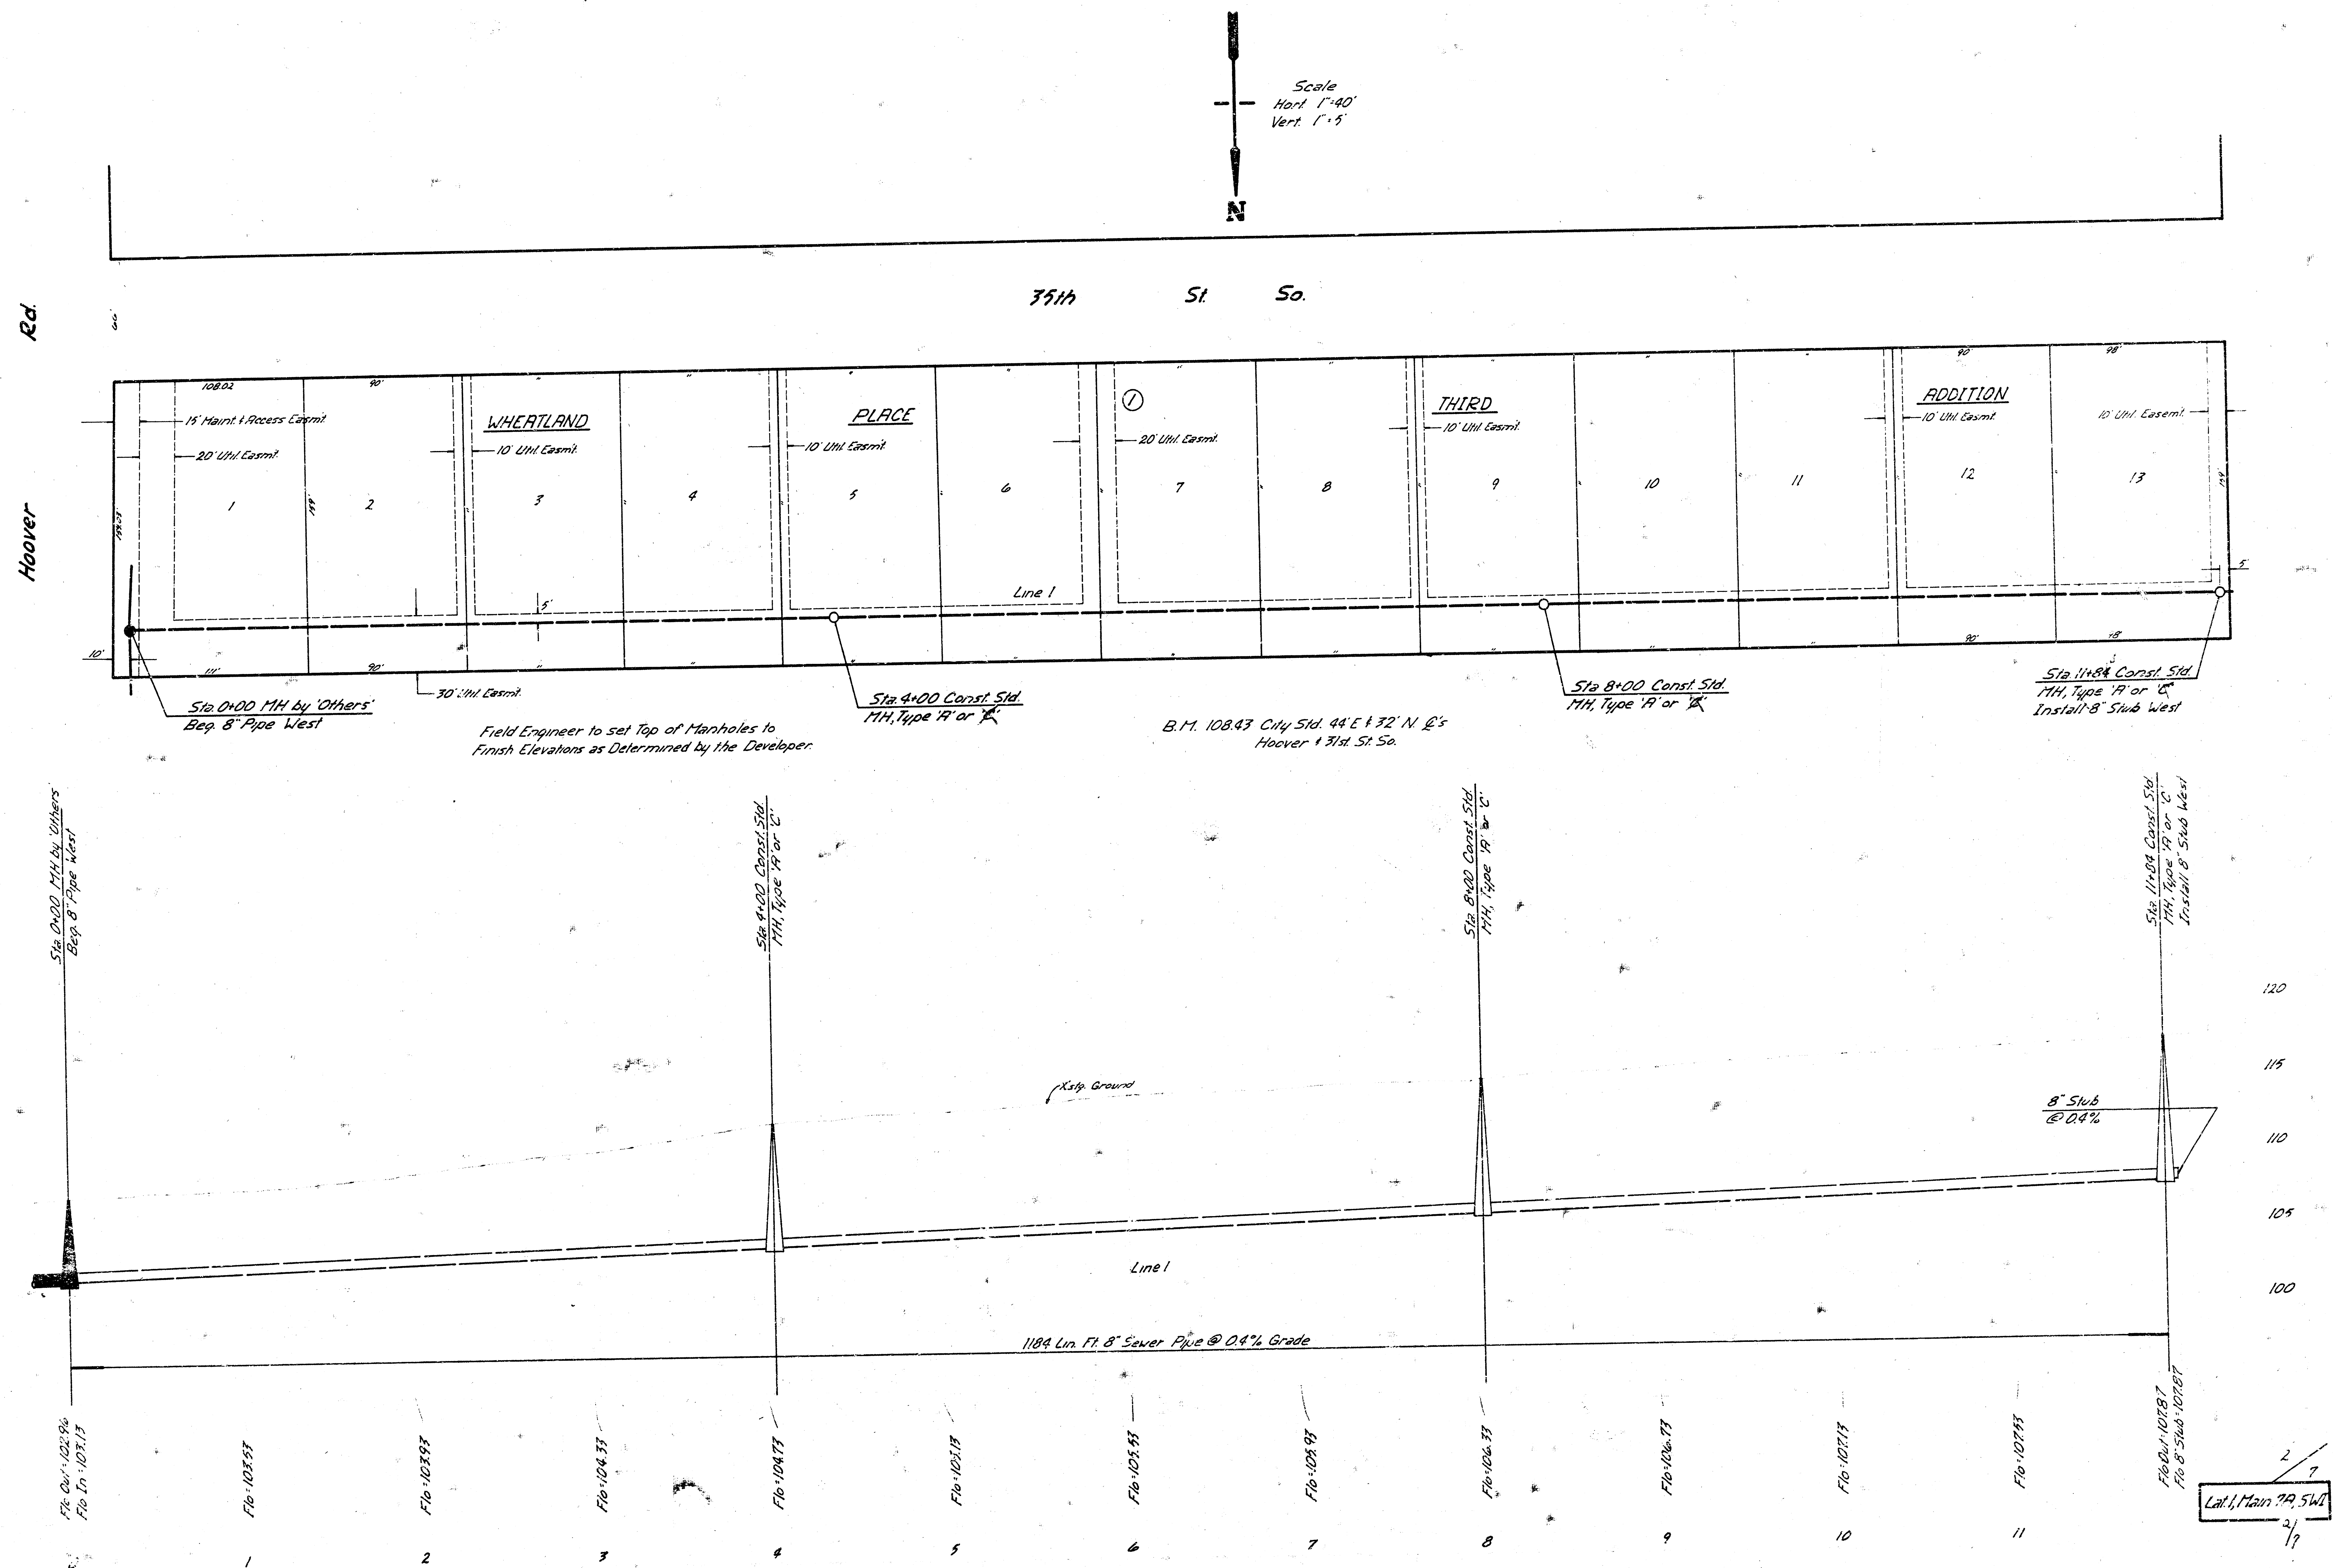



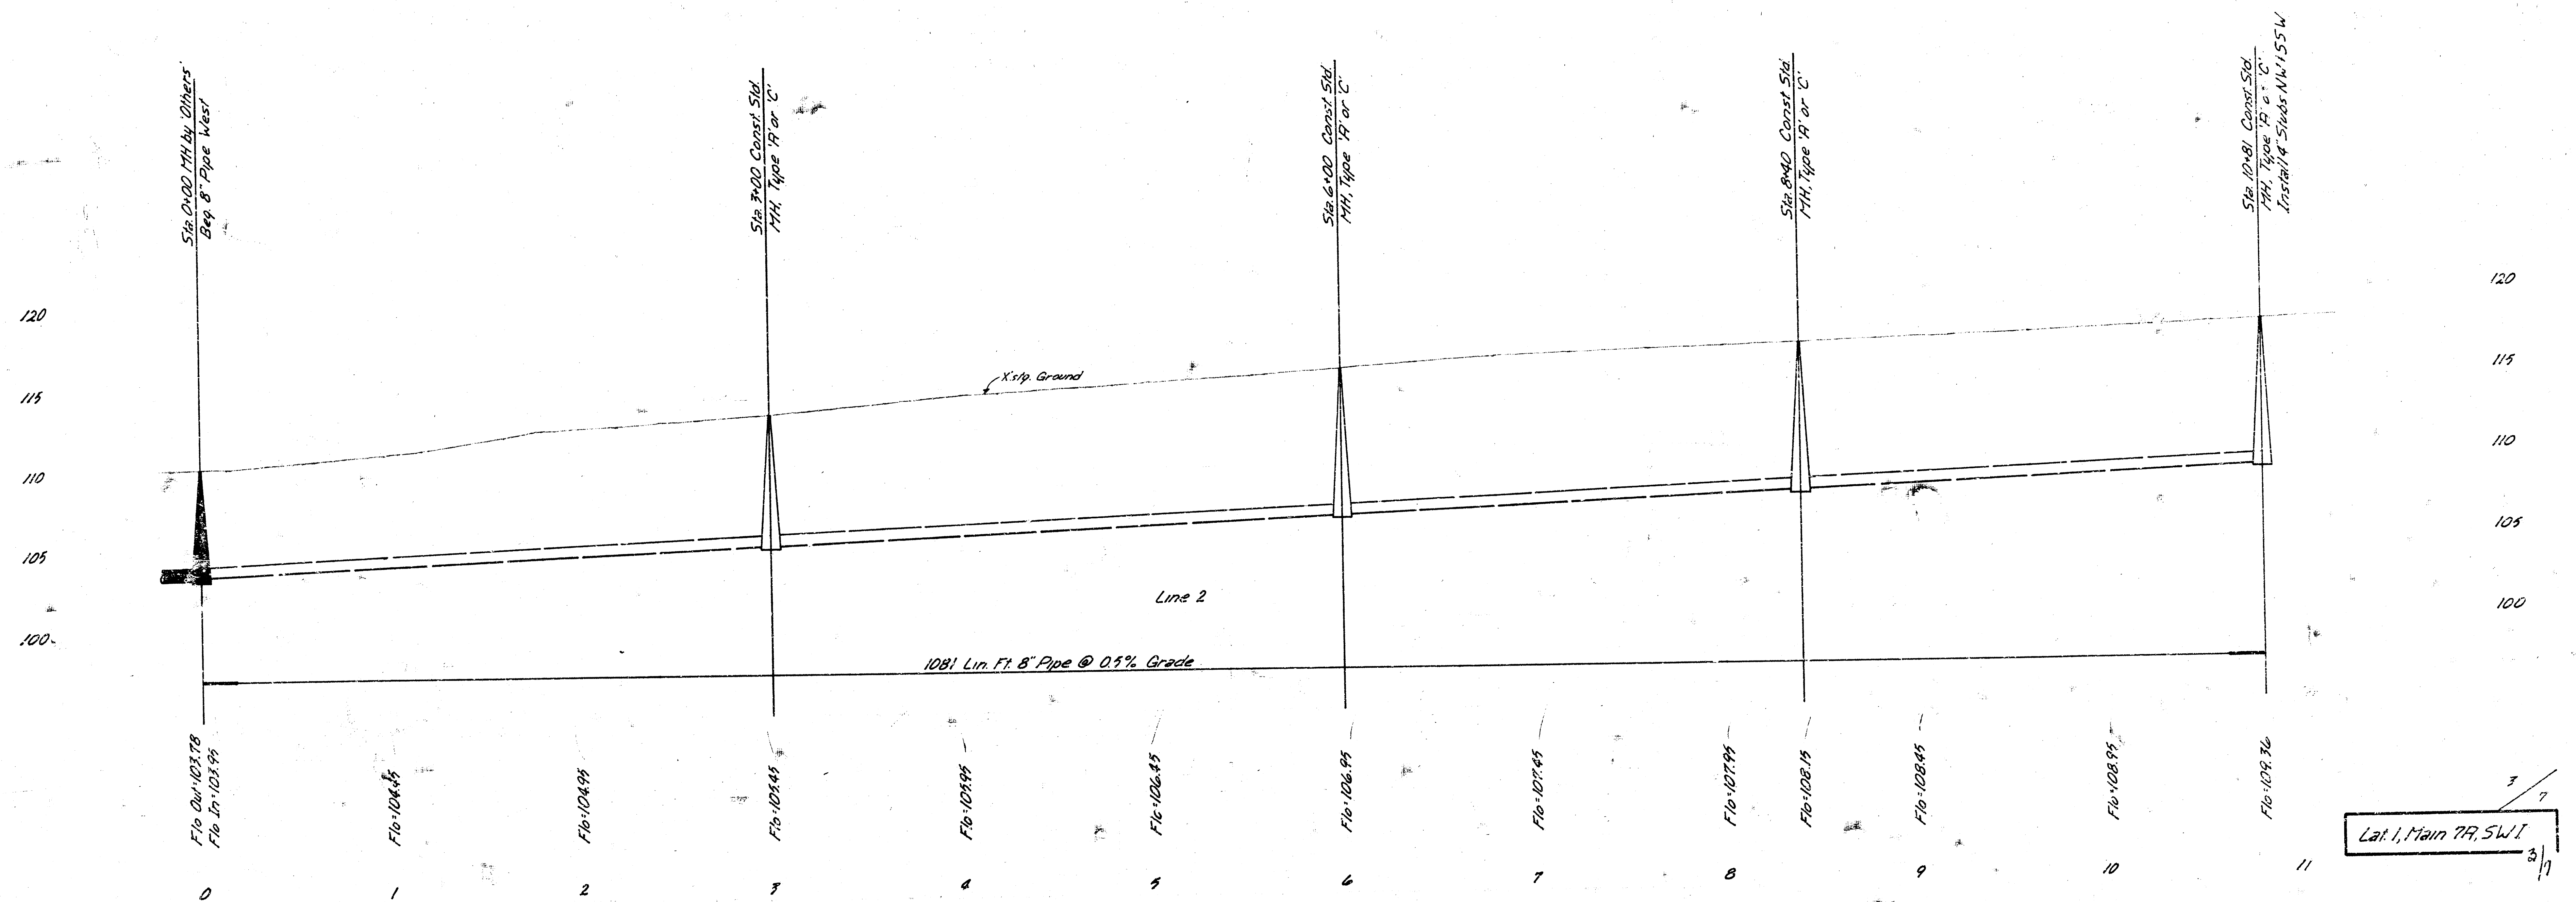
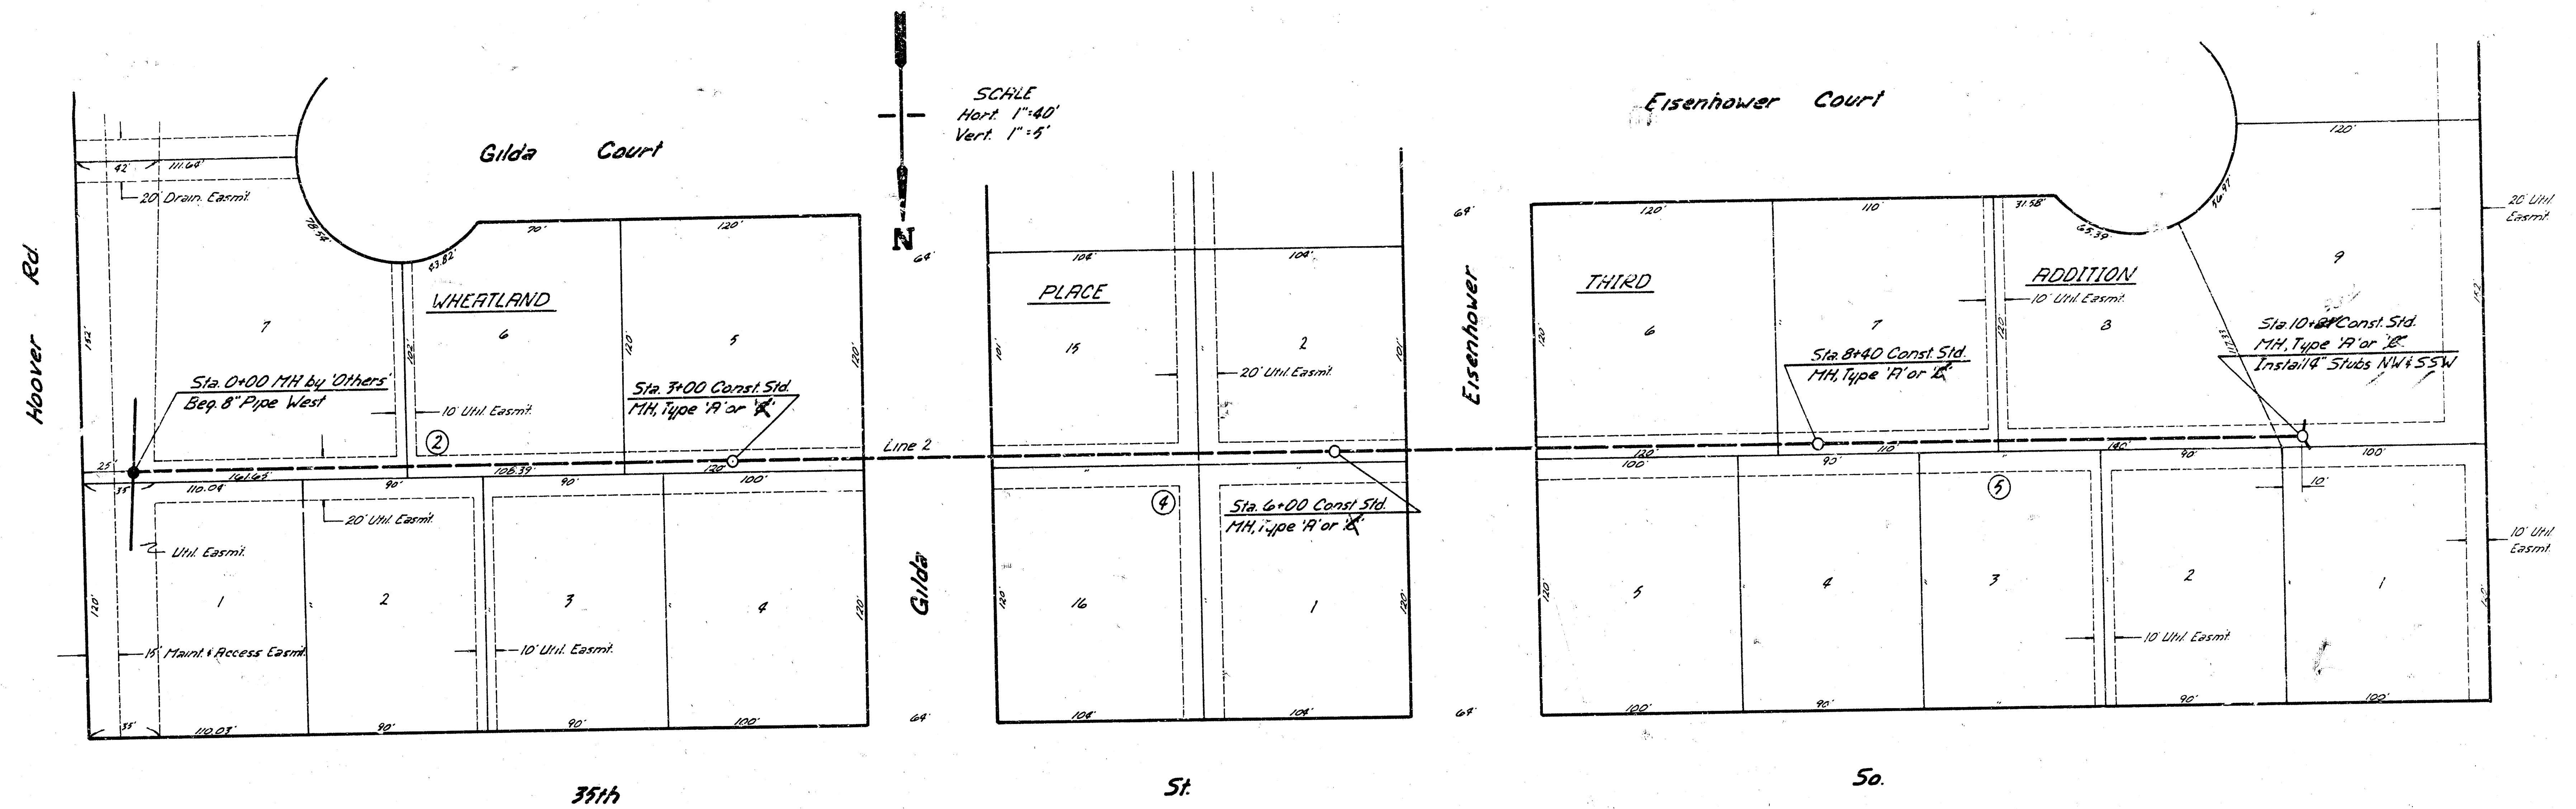


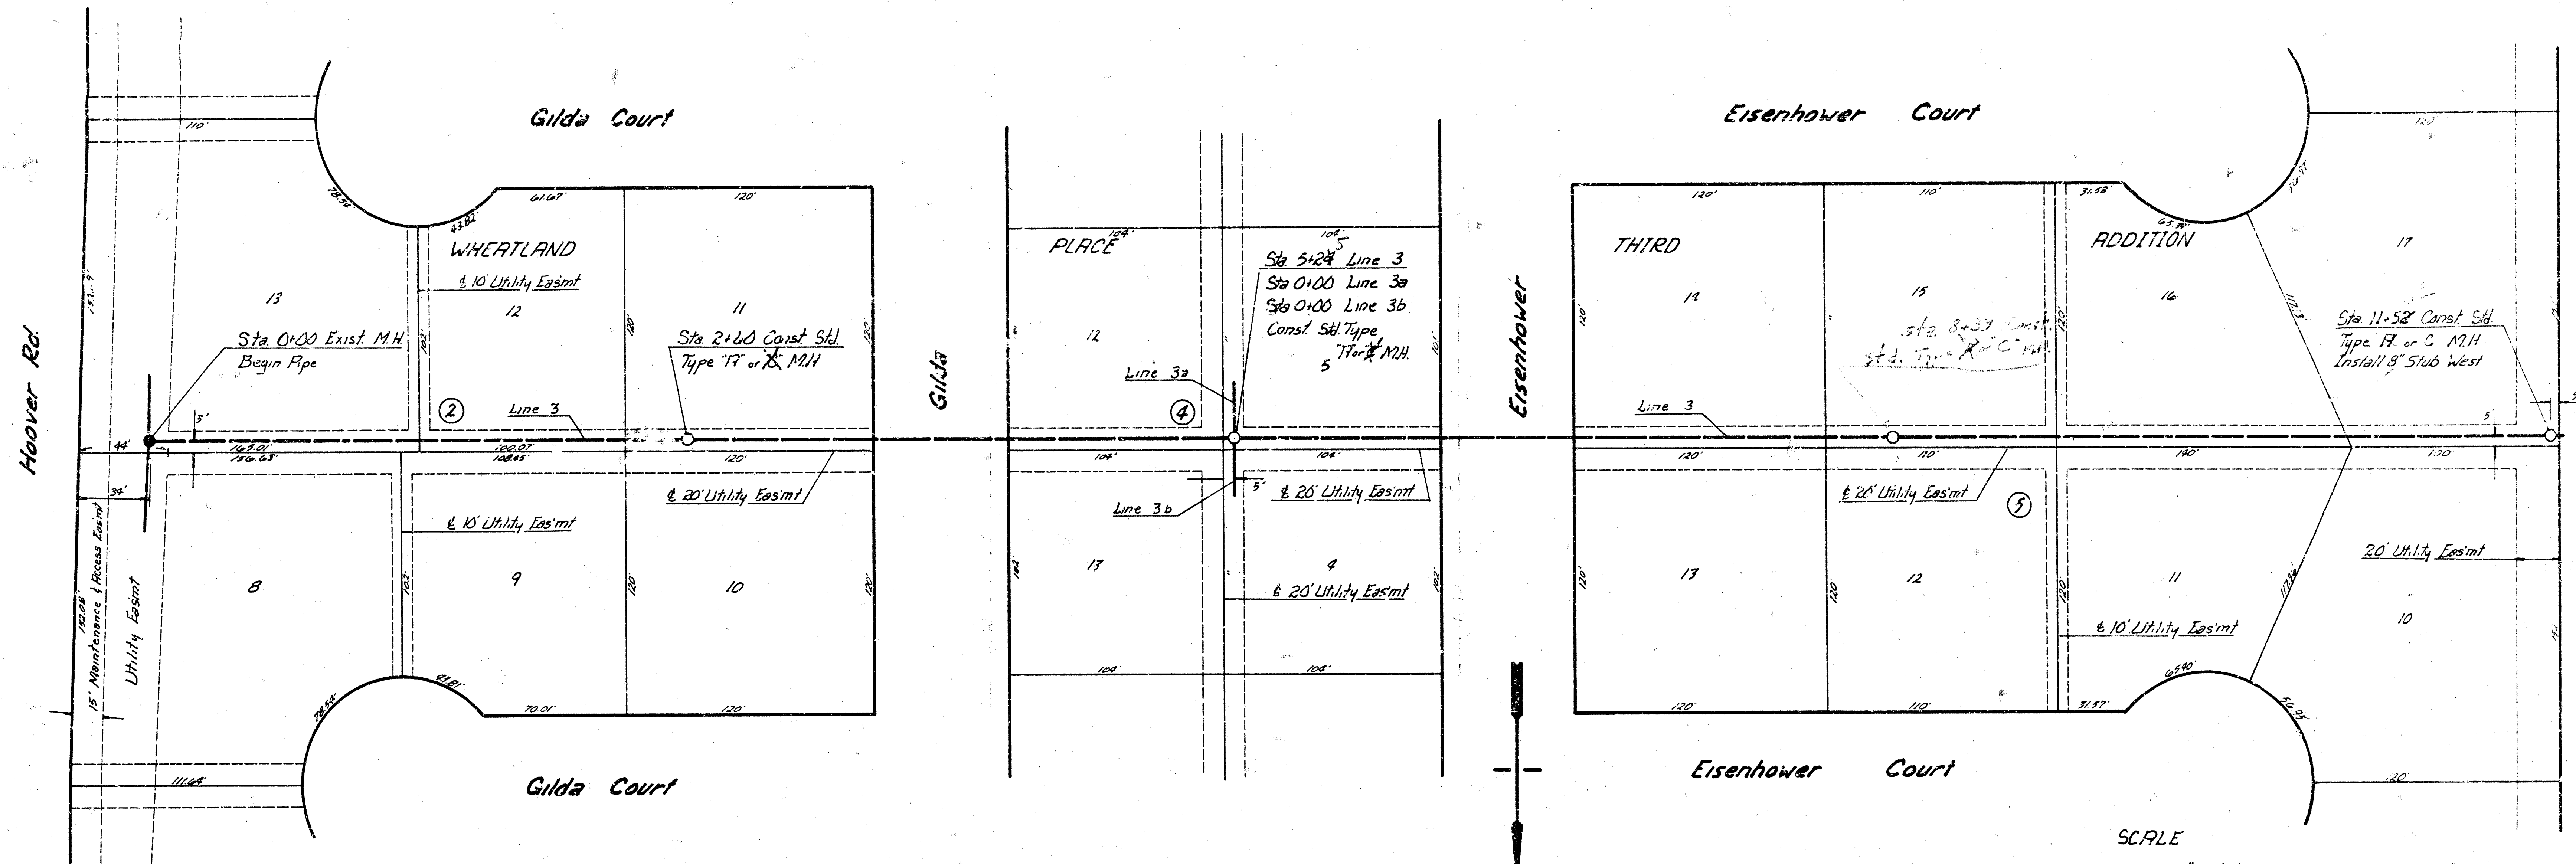

SCALE
 Horz. 1" = 40'
 Vert. 1" = 5'


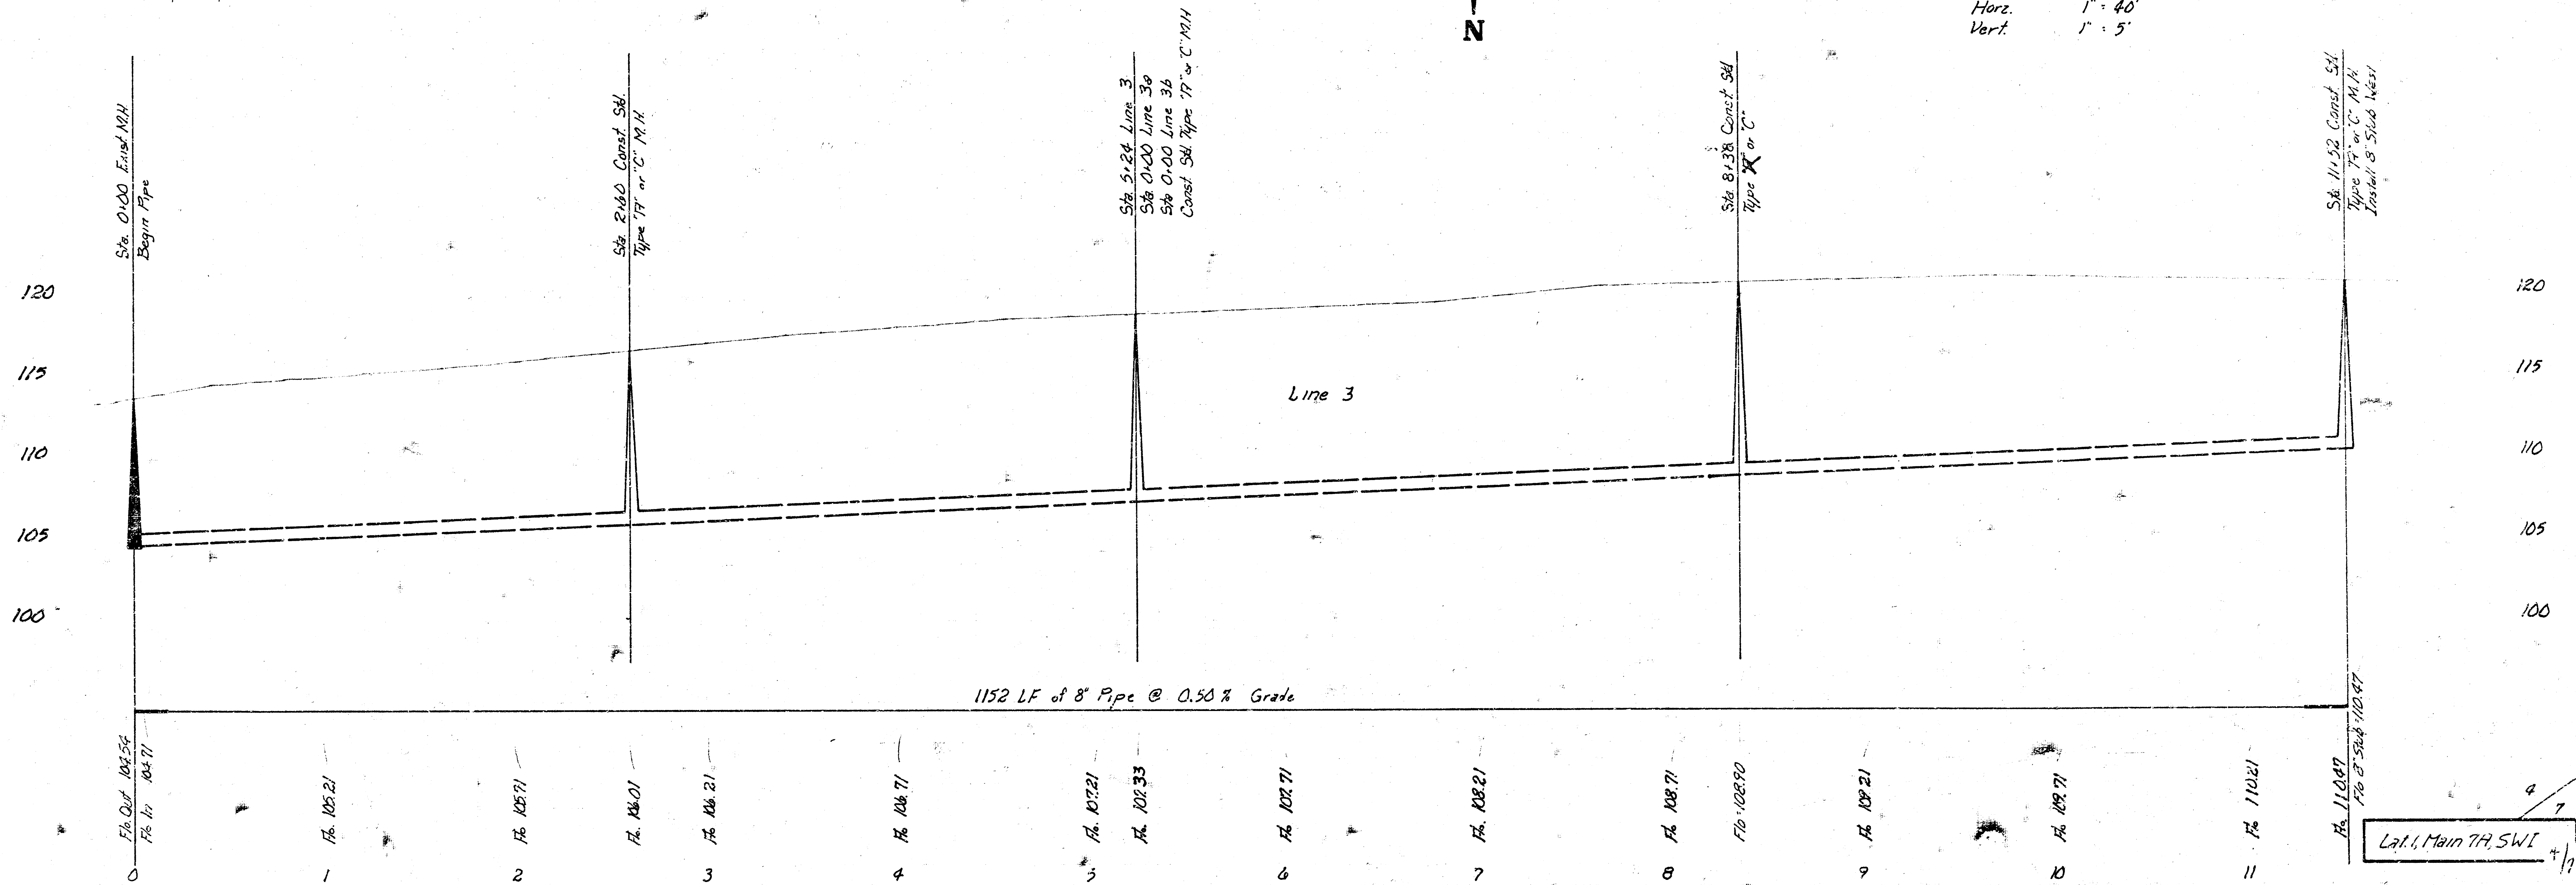


Lat. 1, Main TH SWI

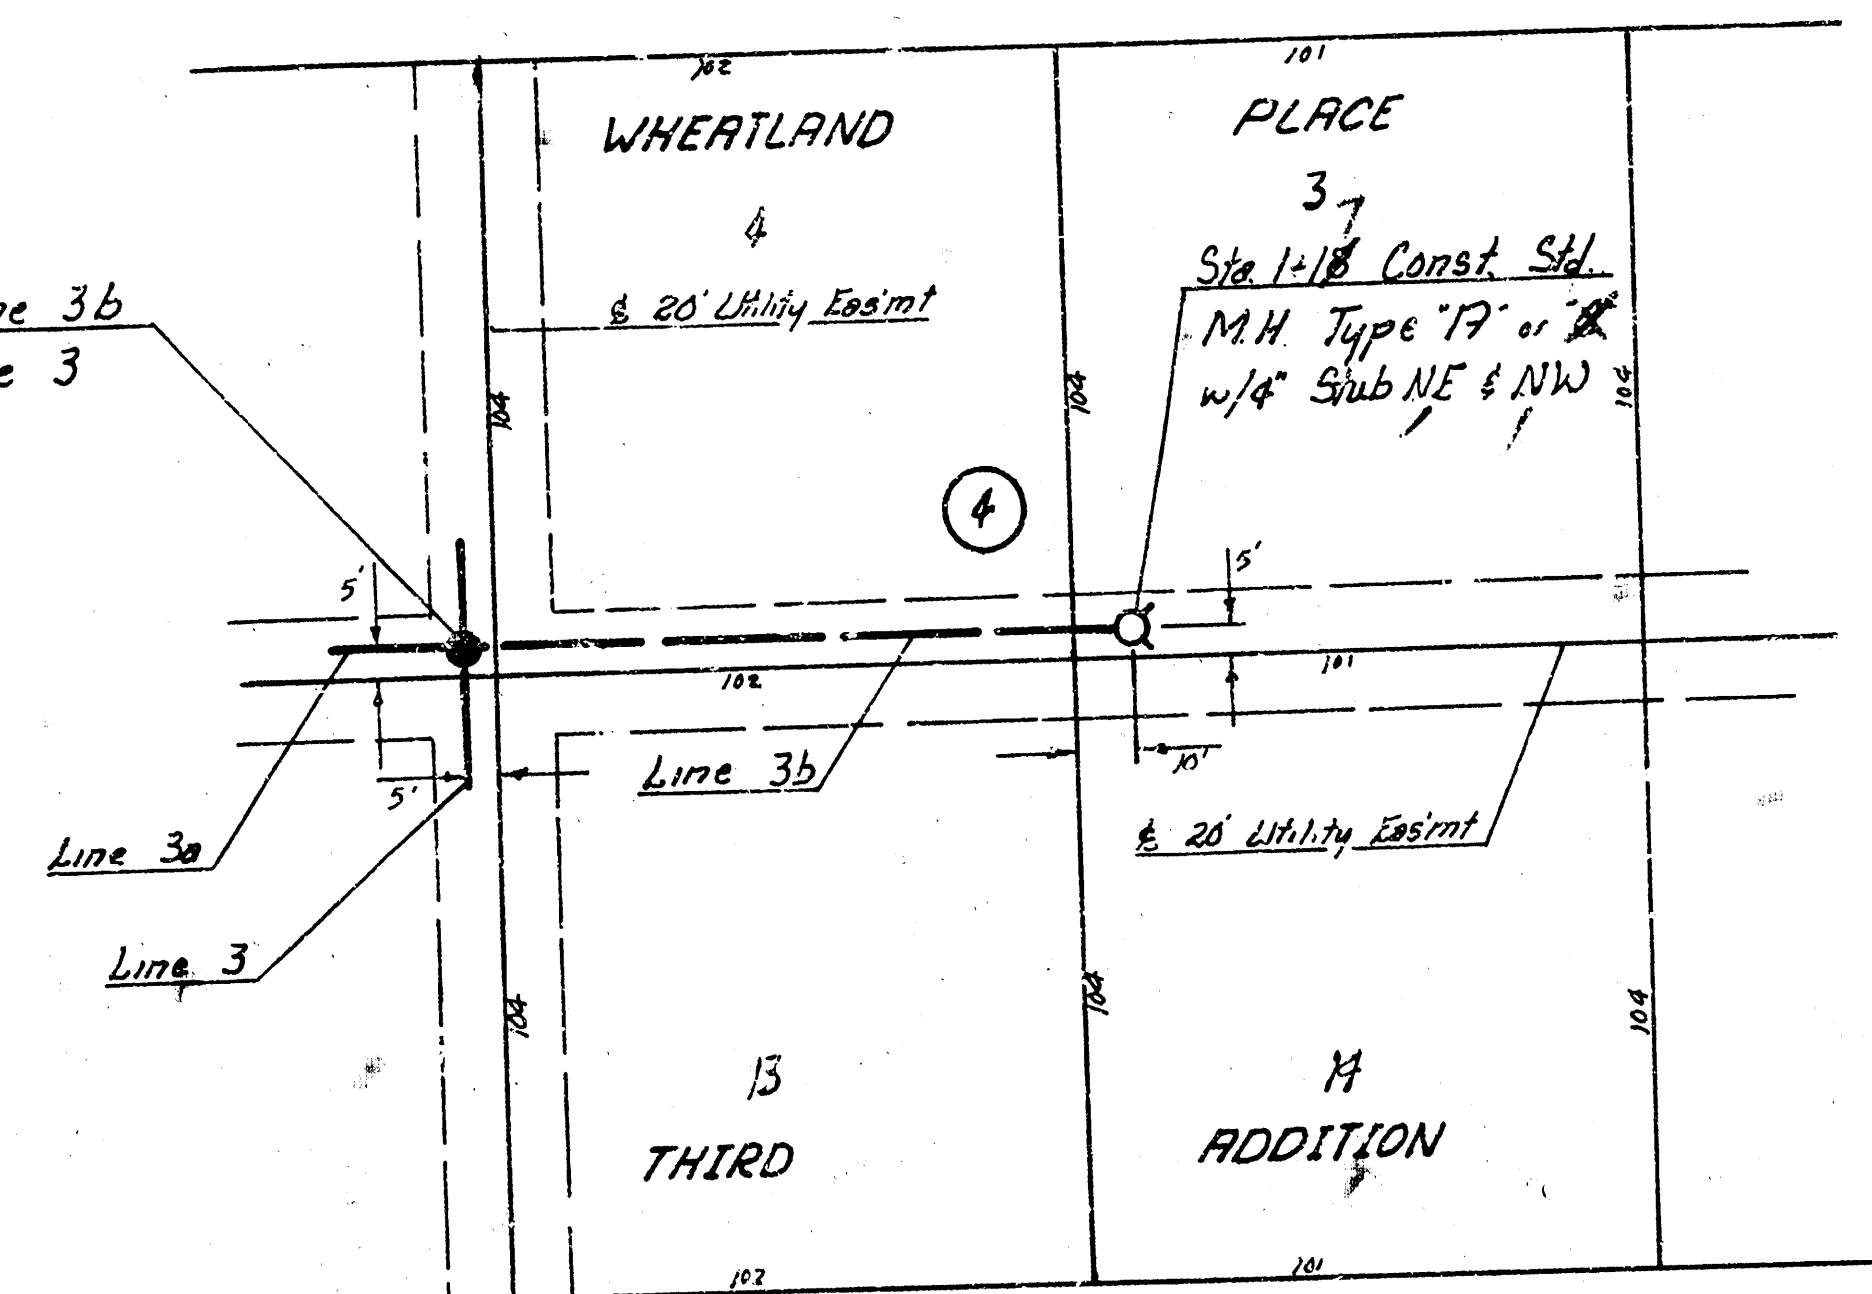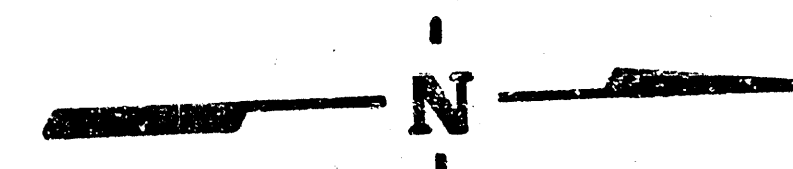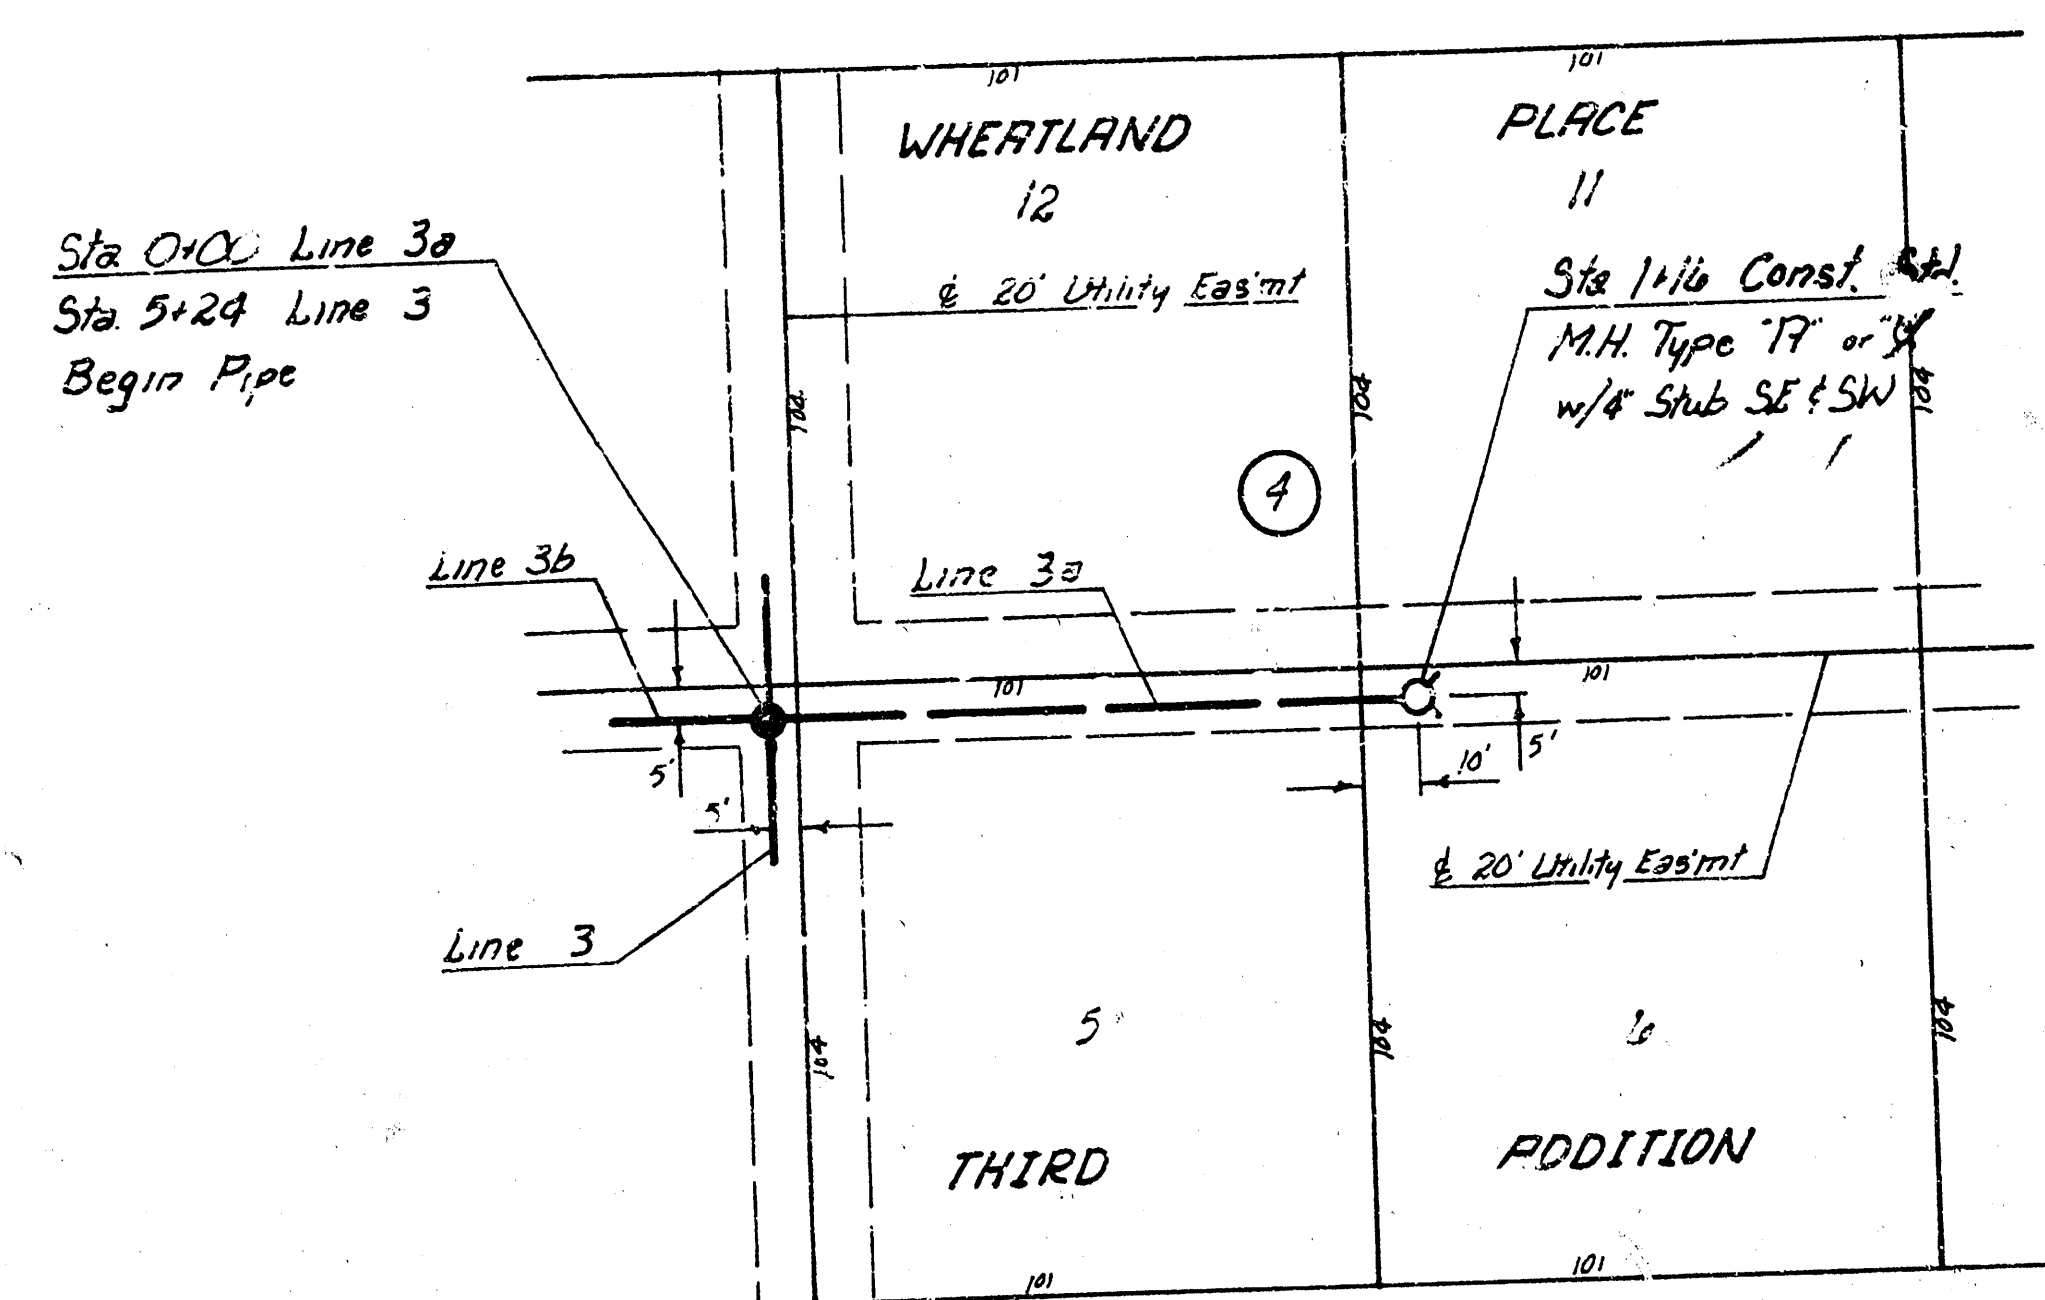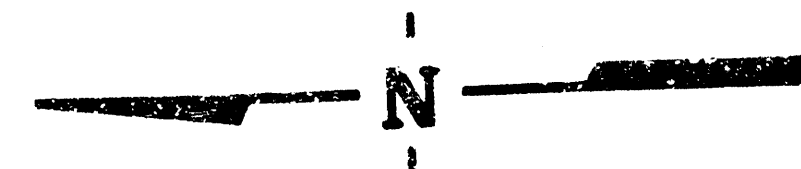


SCALE
Horz 1" = 40'
Vert 1" = 5'

120
115
110
105

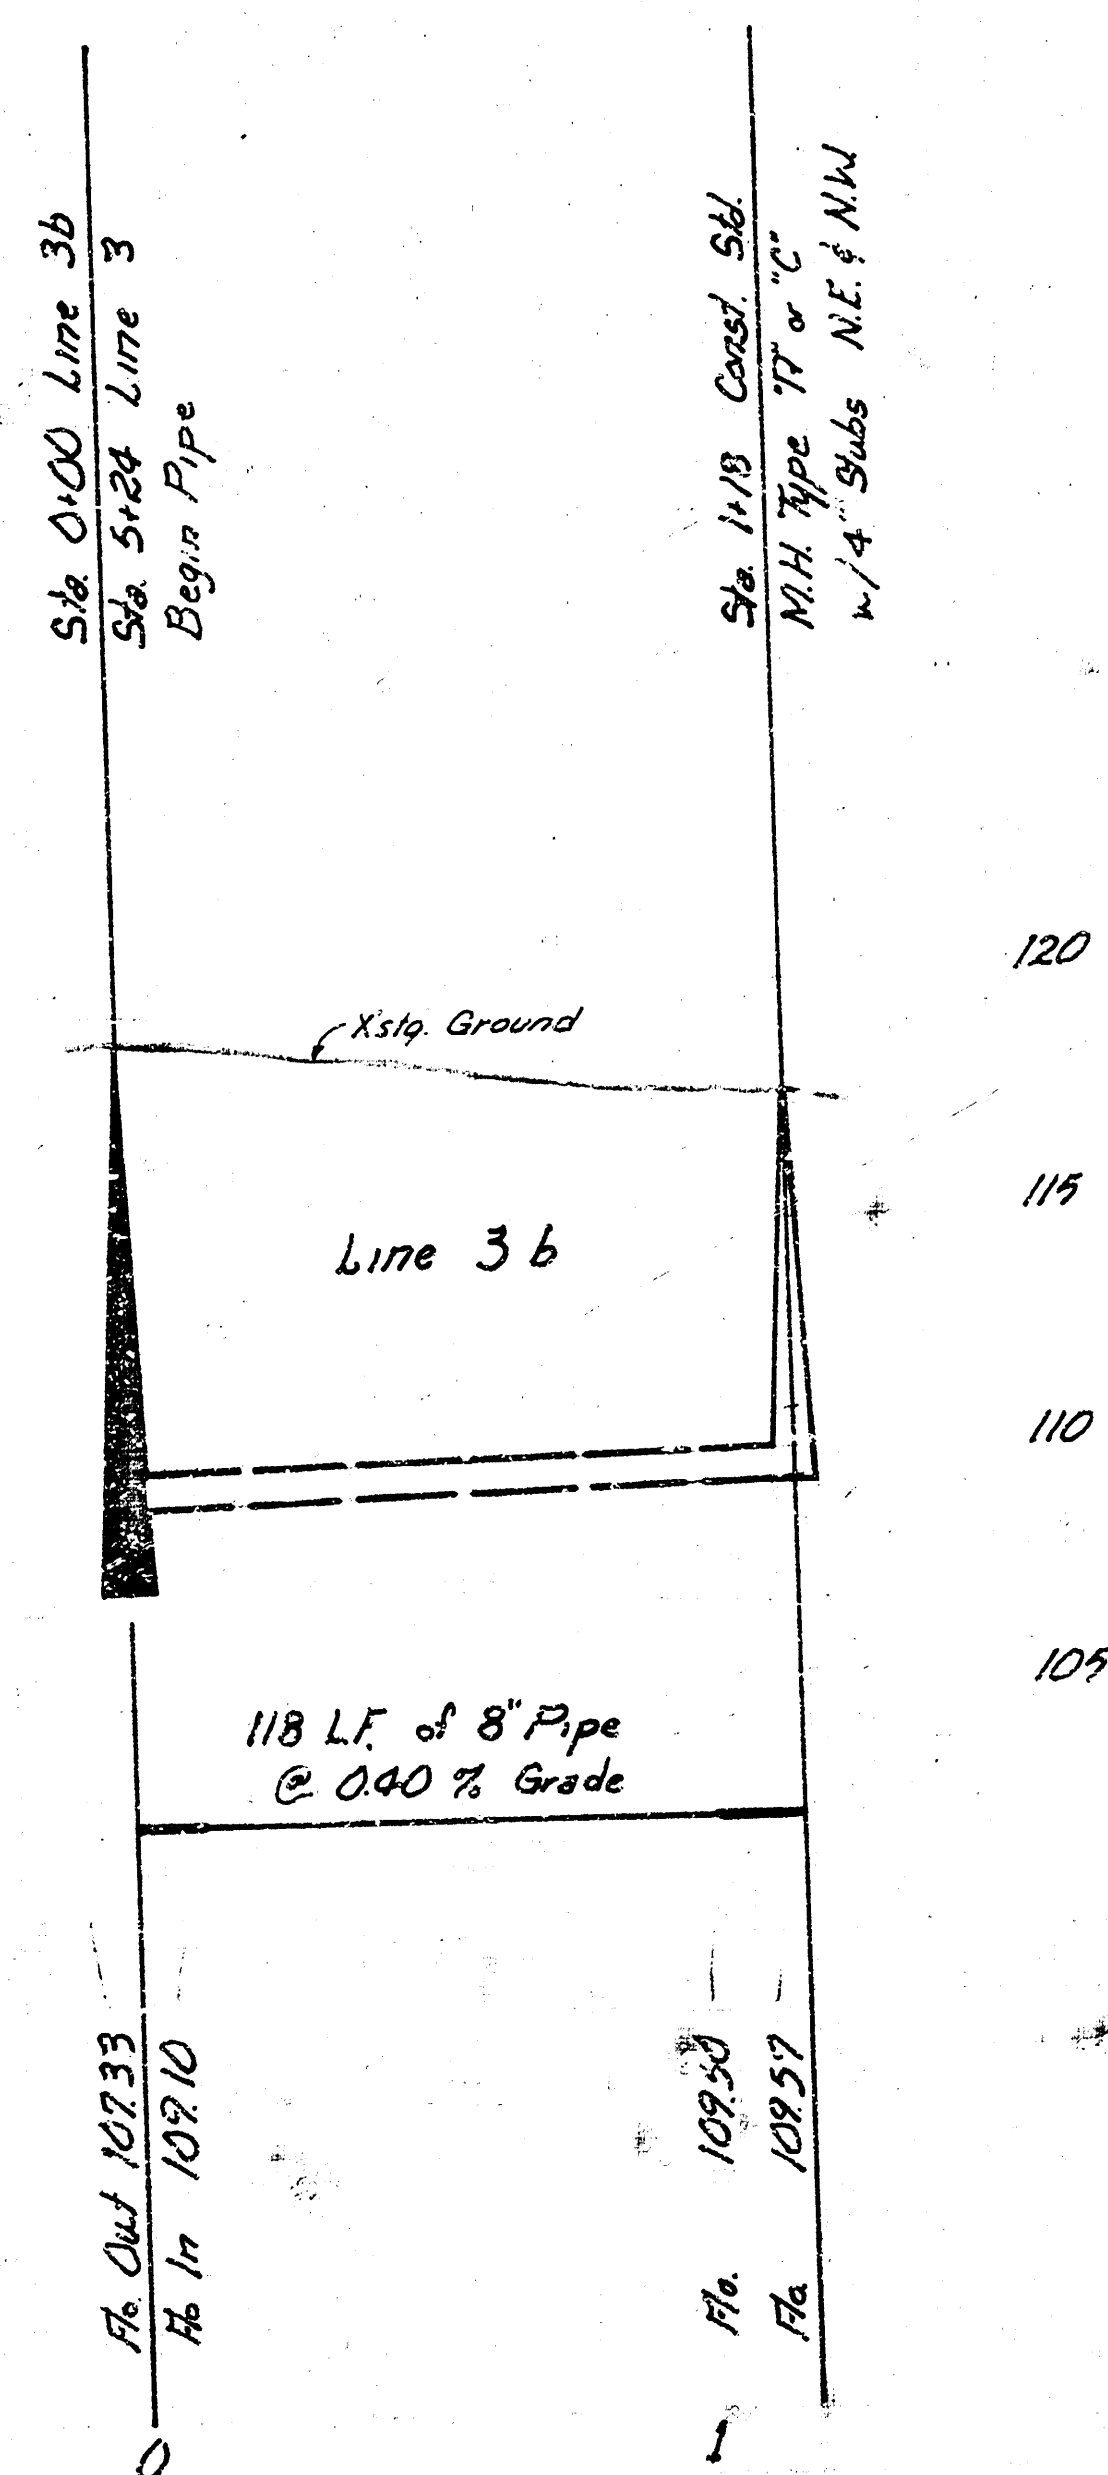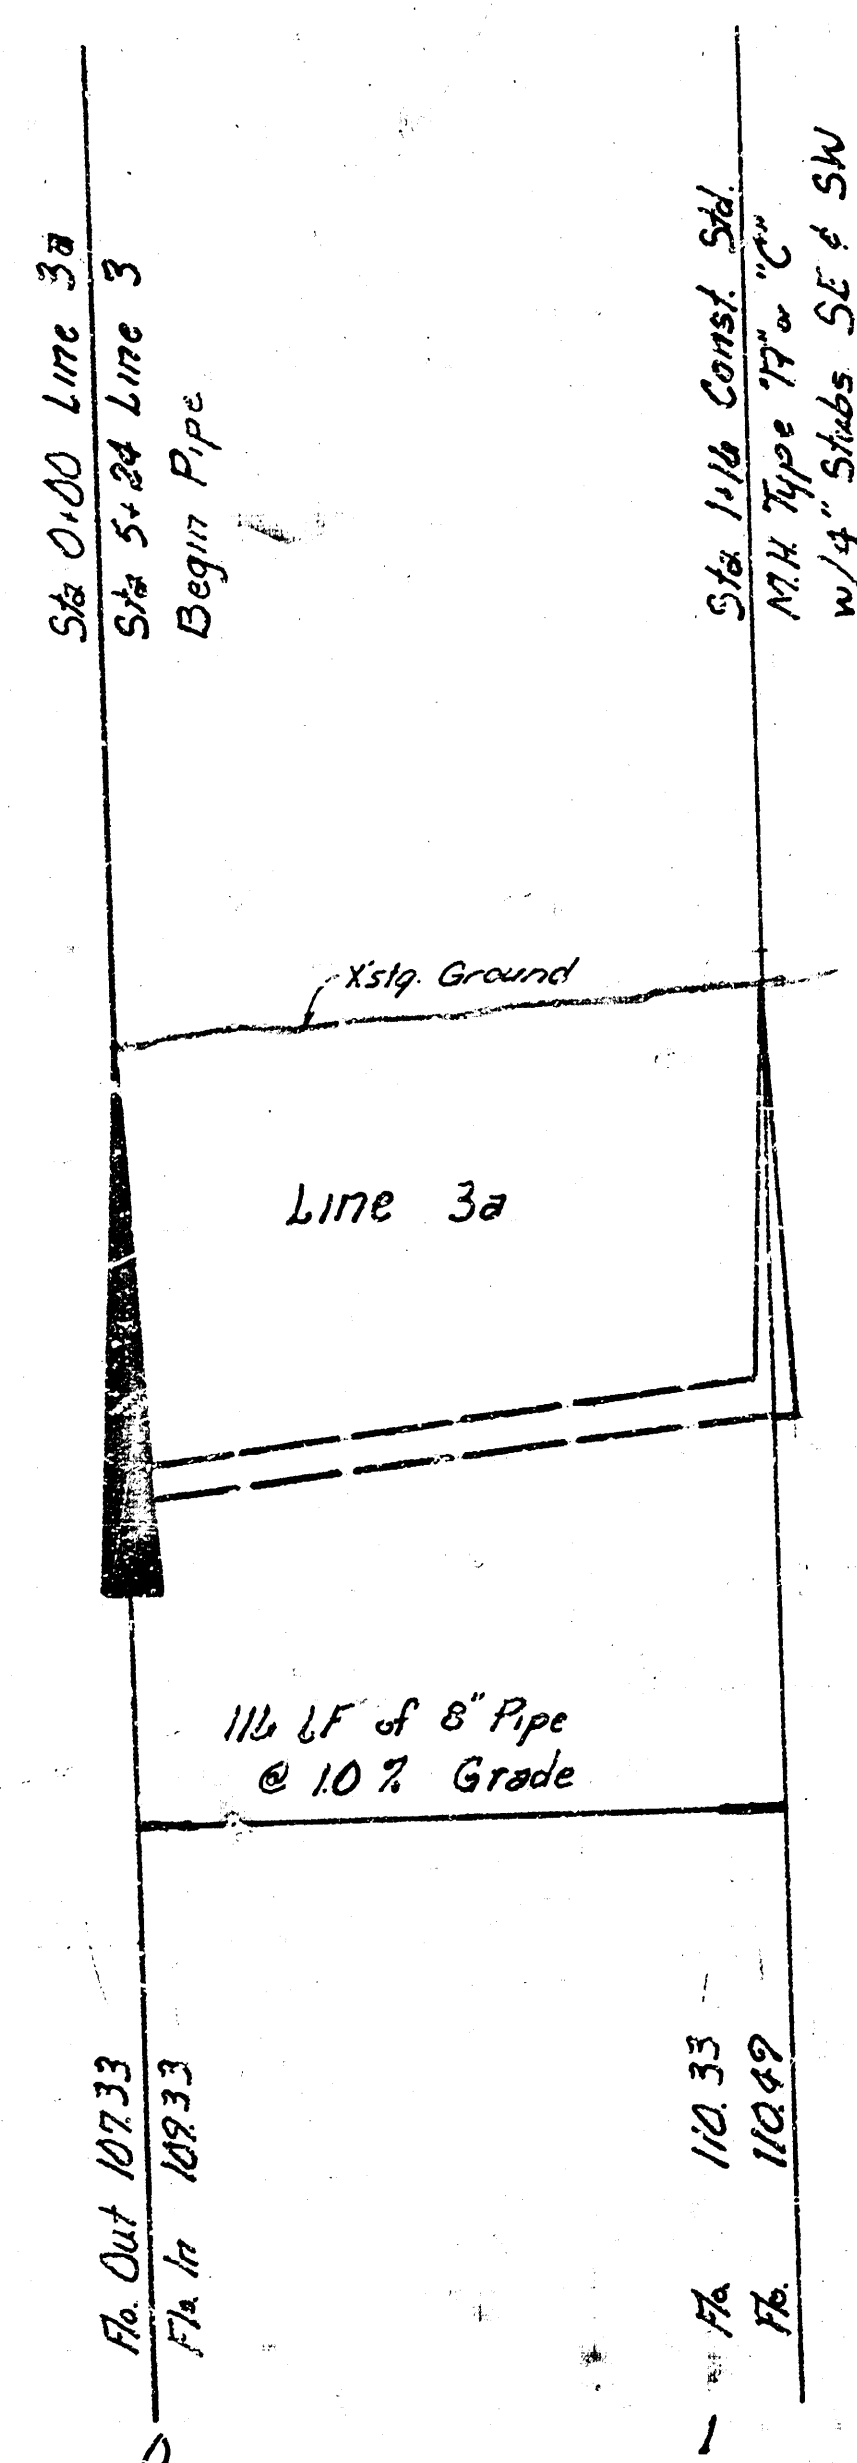

Lat 1, Main 7A SW 1/4



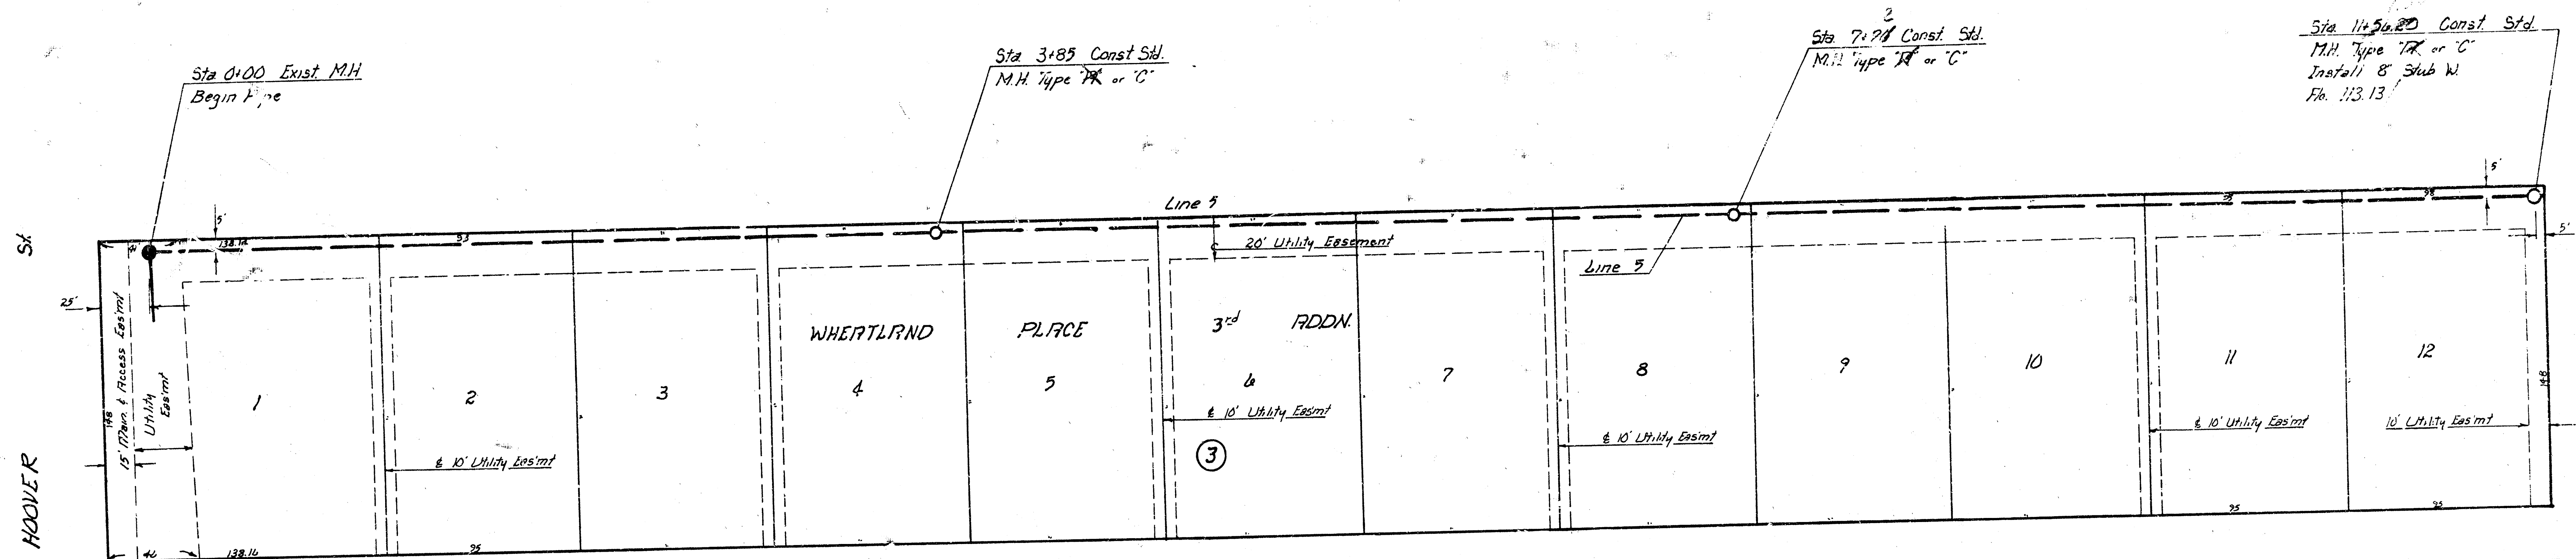

JLIND

SCALE
 Horiz. 1" = 40'
 Vert. 1" = 5'

