

Lateral 2, Main 9, SOUTHWEST INTERCEPTOR


City of WICHITA, KANSAS

R.W. LINN

Project No. : 468-76-245-80640-000-000-001

Date: _____



City Engineer

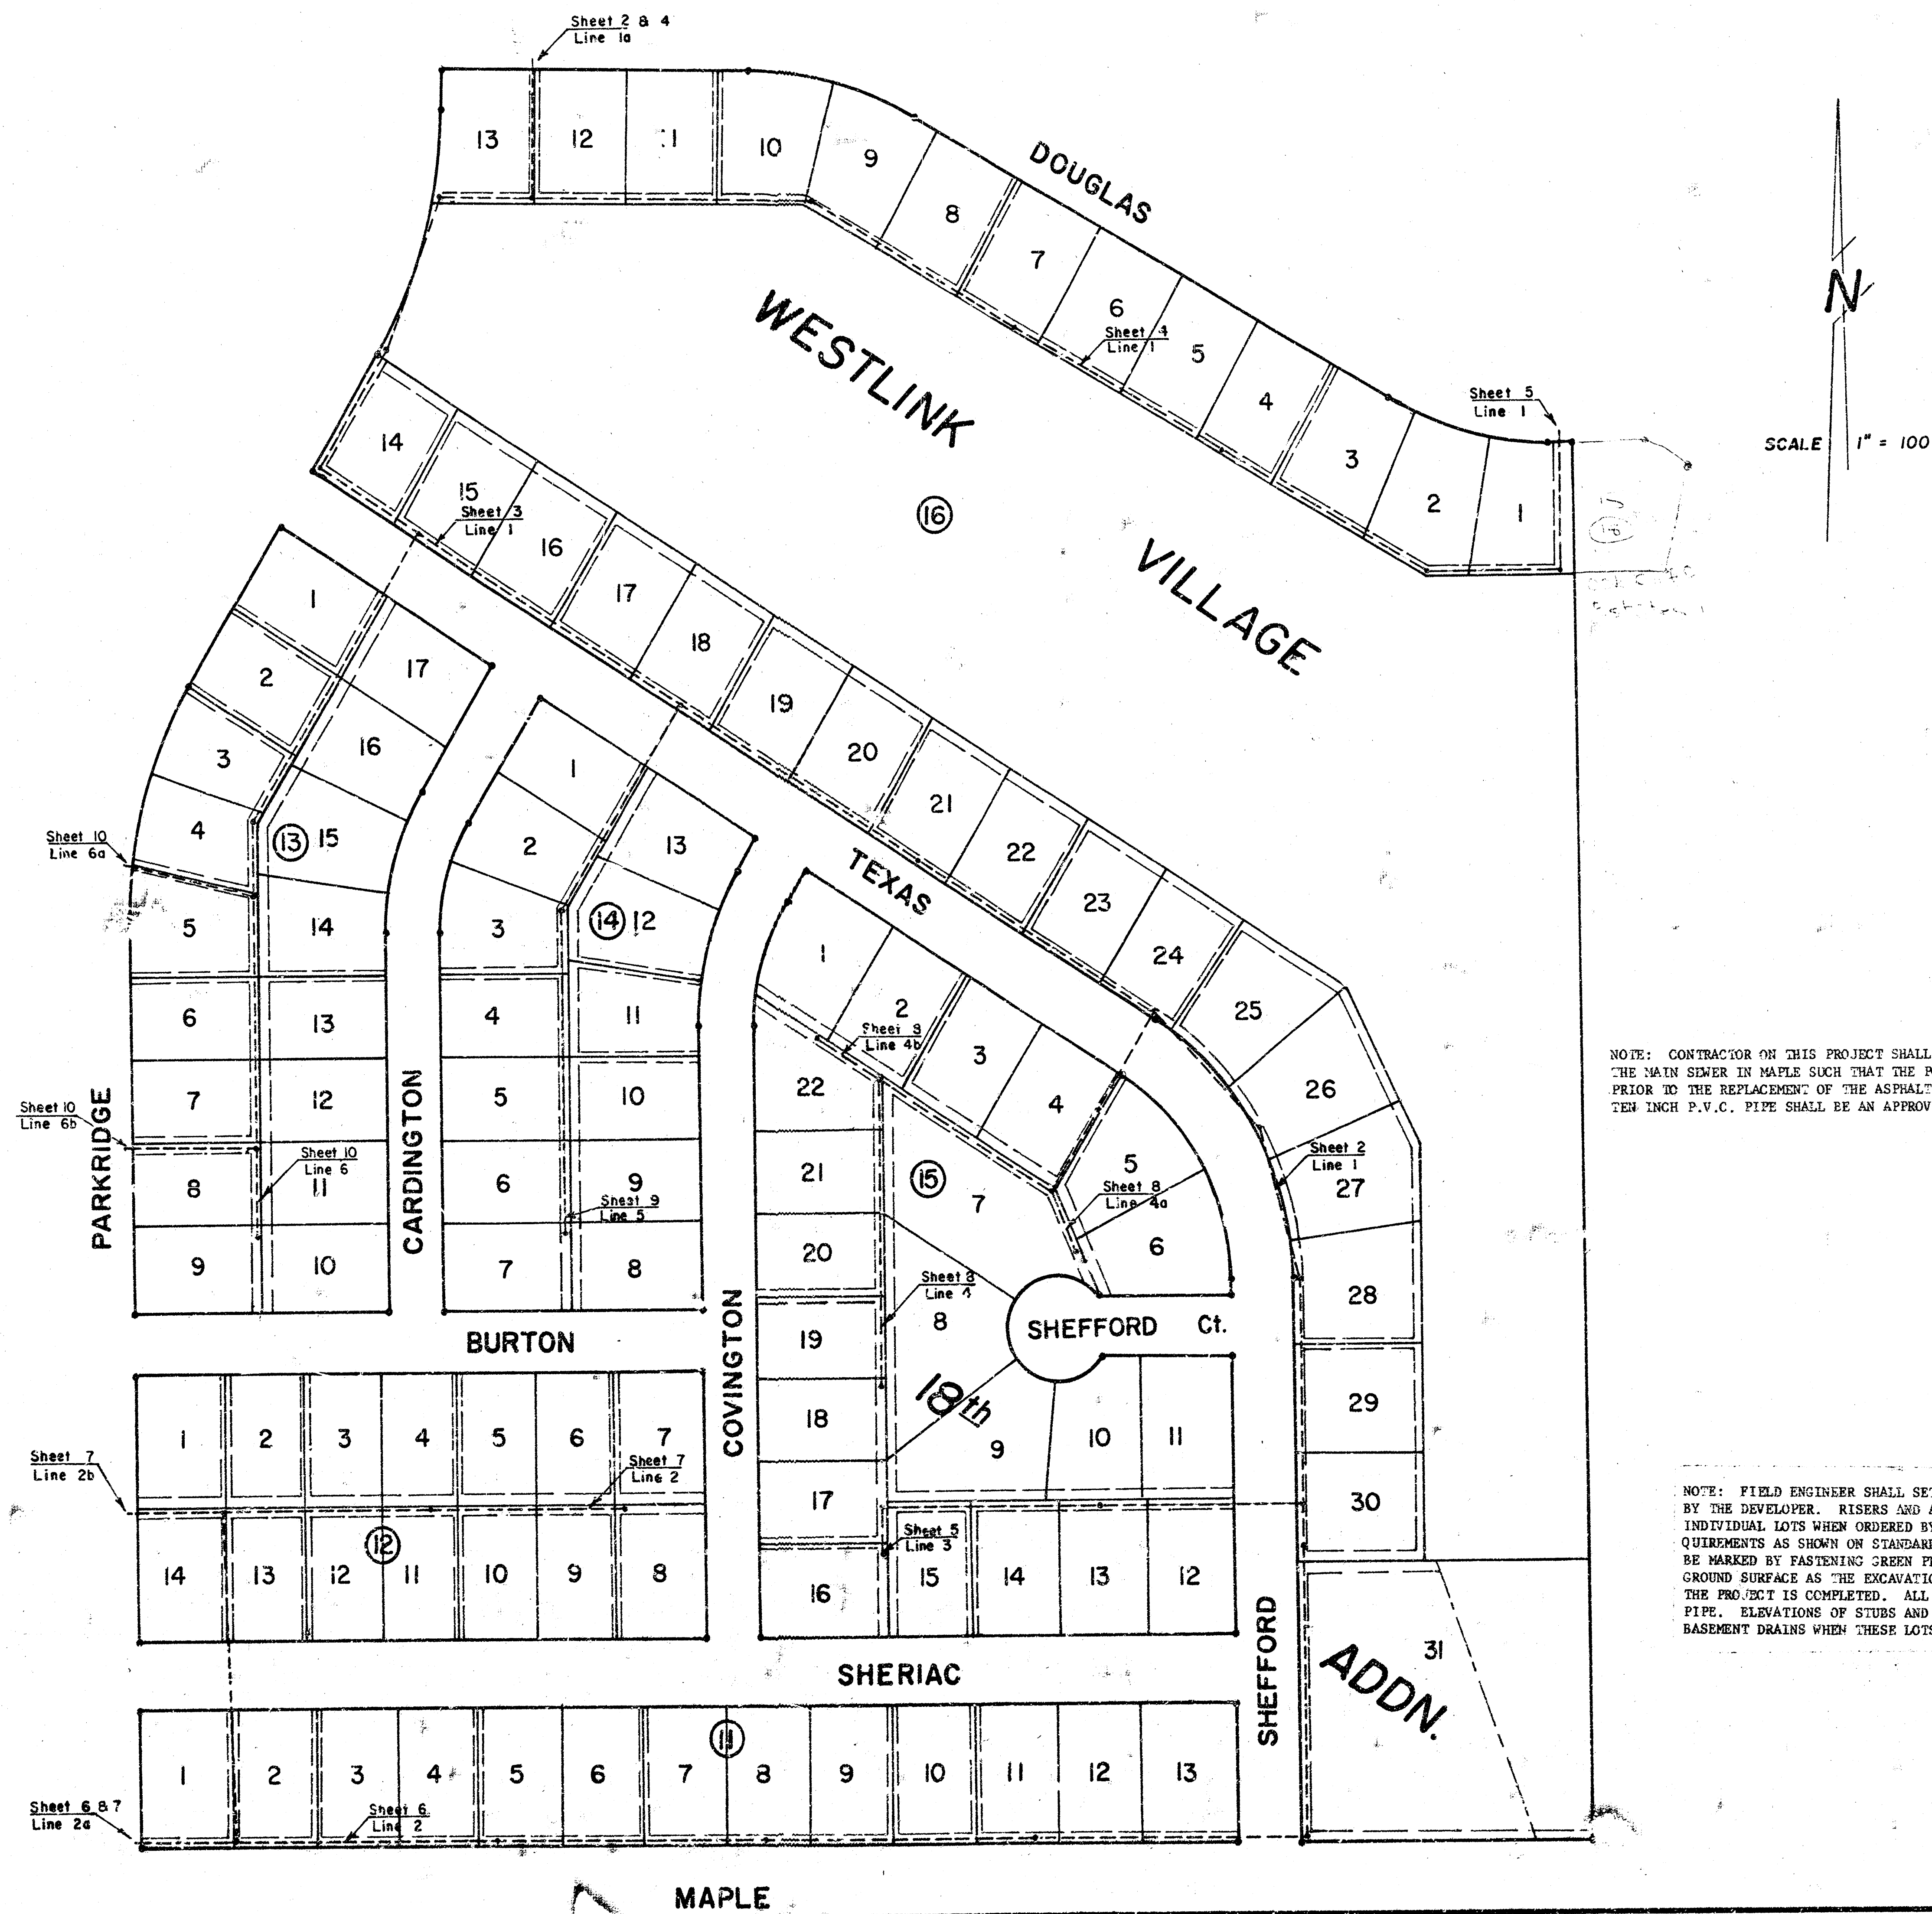


NOTE: CONTRACTOR ON THIS PROJECT SHALL COORDINATE THE WORK ON THIS PROJECT WITH THE CONTRACTOR WHO WILL BE INSTALLING THE MAIN SEWER IN MAPLE SUCH THAT THE PORTION OF THIS PROJECT TO BE CONSTRUCTED IN MAPLE EIGHT-OF-AY WILL BE COMPLETED PRIOR TO THE REPLACEMENT OF THE ASPHALT PAVEMENT BY THE CONTRACTOR FOR CONSTRUCTION OF THE MAIN SEWER. EIGHT INCH AND TEN INCH P.V.C. PIPE SHALL BE AN APPROVED ALTERNATE PIPE MATERIAL ON THIS PROJECT.

NOTE: FIELD ENGINEER SHALL SET TOPS OF MANHOLES TO MATCH PROPOSED FINISHED GRADE AS DETERMINED BY THE DEVELOPER. RISERS AND ADDITIONAL STUBS SHALL BE INSTALLED ON THIS PROJECT TO SERVE INDIVIDUAL LOTS WHEN ORDERED BY THE FIELD ENGINEER. RISER CONSTRUCTION SHALL CONFORM TO THE REQUIREMENTS AS SHOWN ON STANDARD RISER DETAIL SHEET. LOCATIONS OF THE ENDS OF THE RISERS SHALL BE MARKED BY FASTENING GREEN PLASTIC COLORED TAPE TO THE END OF THE RISER AND BROUGHT TO THE SURFACE OF THE STUBS. THE STUBS SHALL BE BUILT TO THE ELEVATION OF THE RISER. THE COLOR OF THE TAPE SHALL BE THE SAME AS THE COLOR OF THE RISER. WHEN THE PROJECT IS COMPLETED, ALL RISERS SHALL BE CONSTRUCTED USING 12" OR 24" A.B.S. OR P.V.C. PIPE. ELEVATIONS OF STUBS AND TOPS OF RISERS SHALL BE SUCH THAT WILL FACILITATE CONNECTION OF BASEMENT DRAINS WHEN THESE LOTS ARE DEVELOPED.

Scale
 Plan 1" = 40'
 Profile
 Horiz. 1" = 40'
 Vert. 1" = 5'

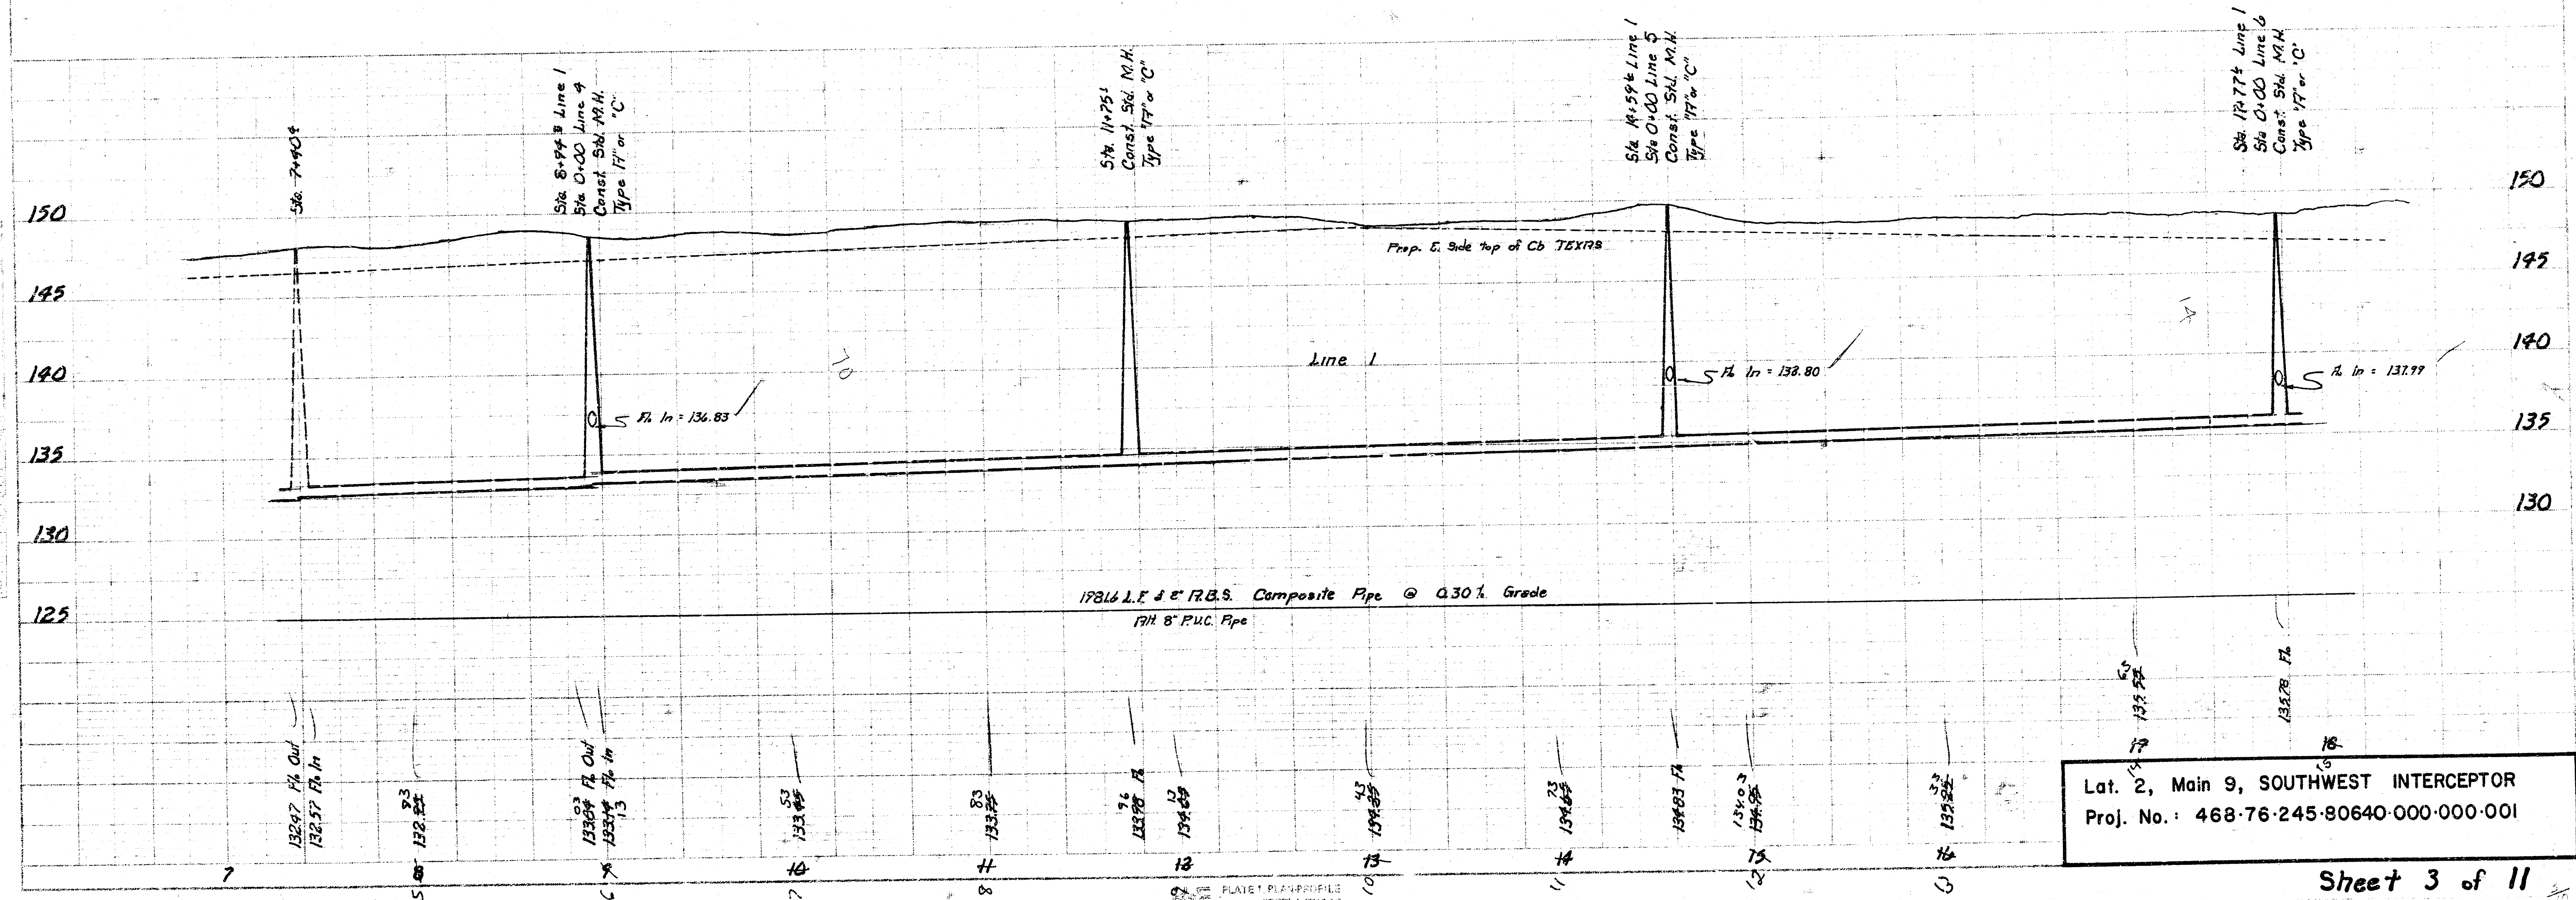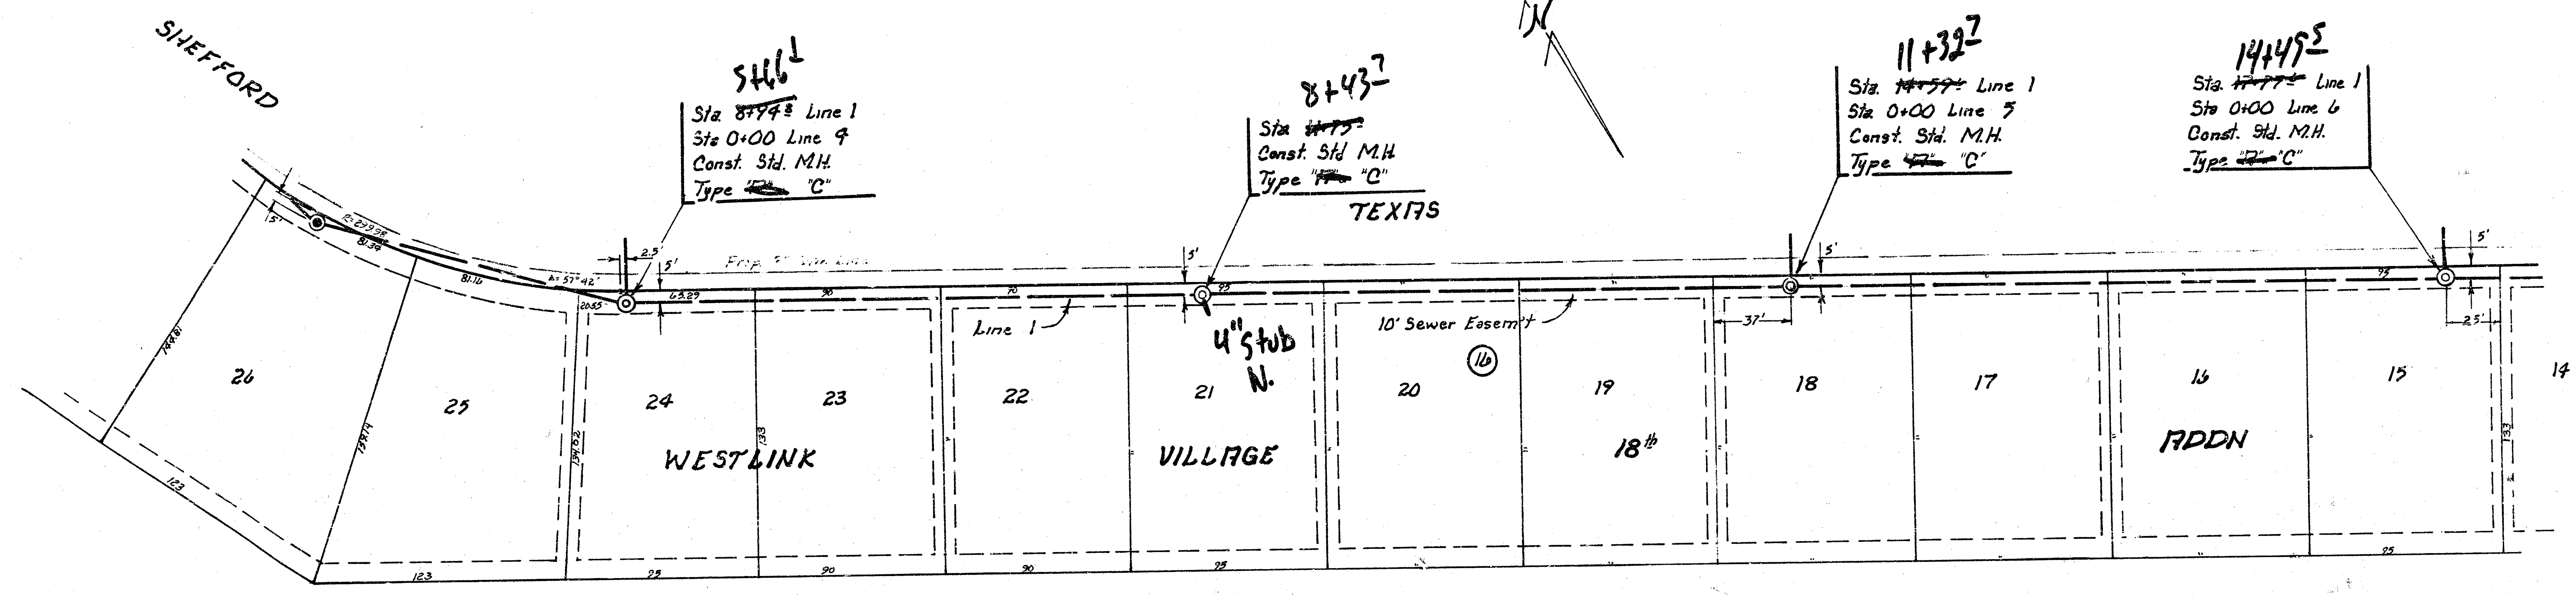


Lat. 2, Main 9, SOUTHWEST INTERCEPTOR
 Proj. No.: 468-76-245-80640-000-000-001

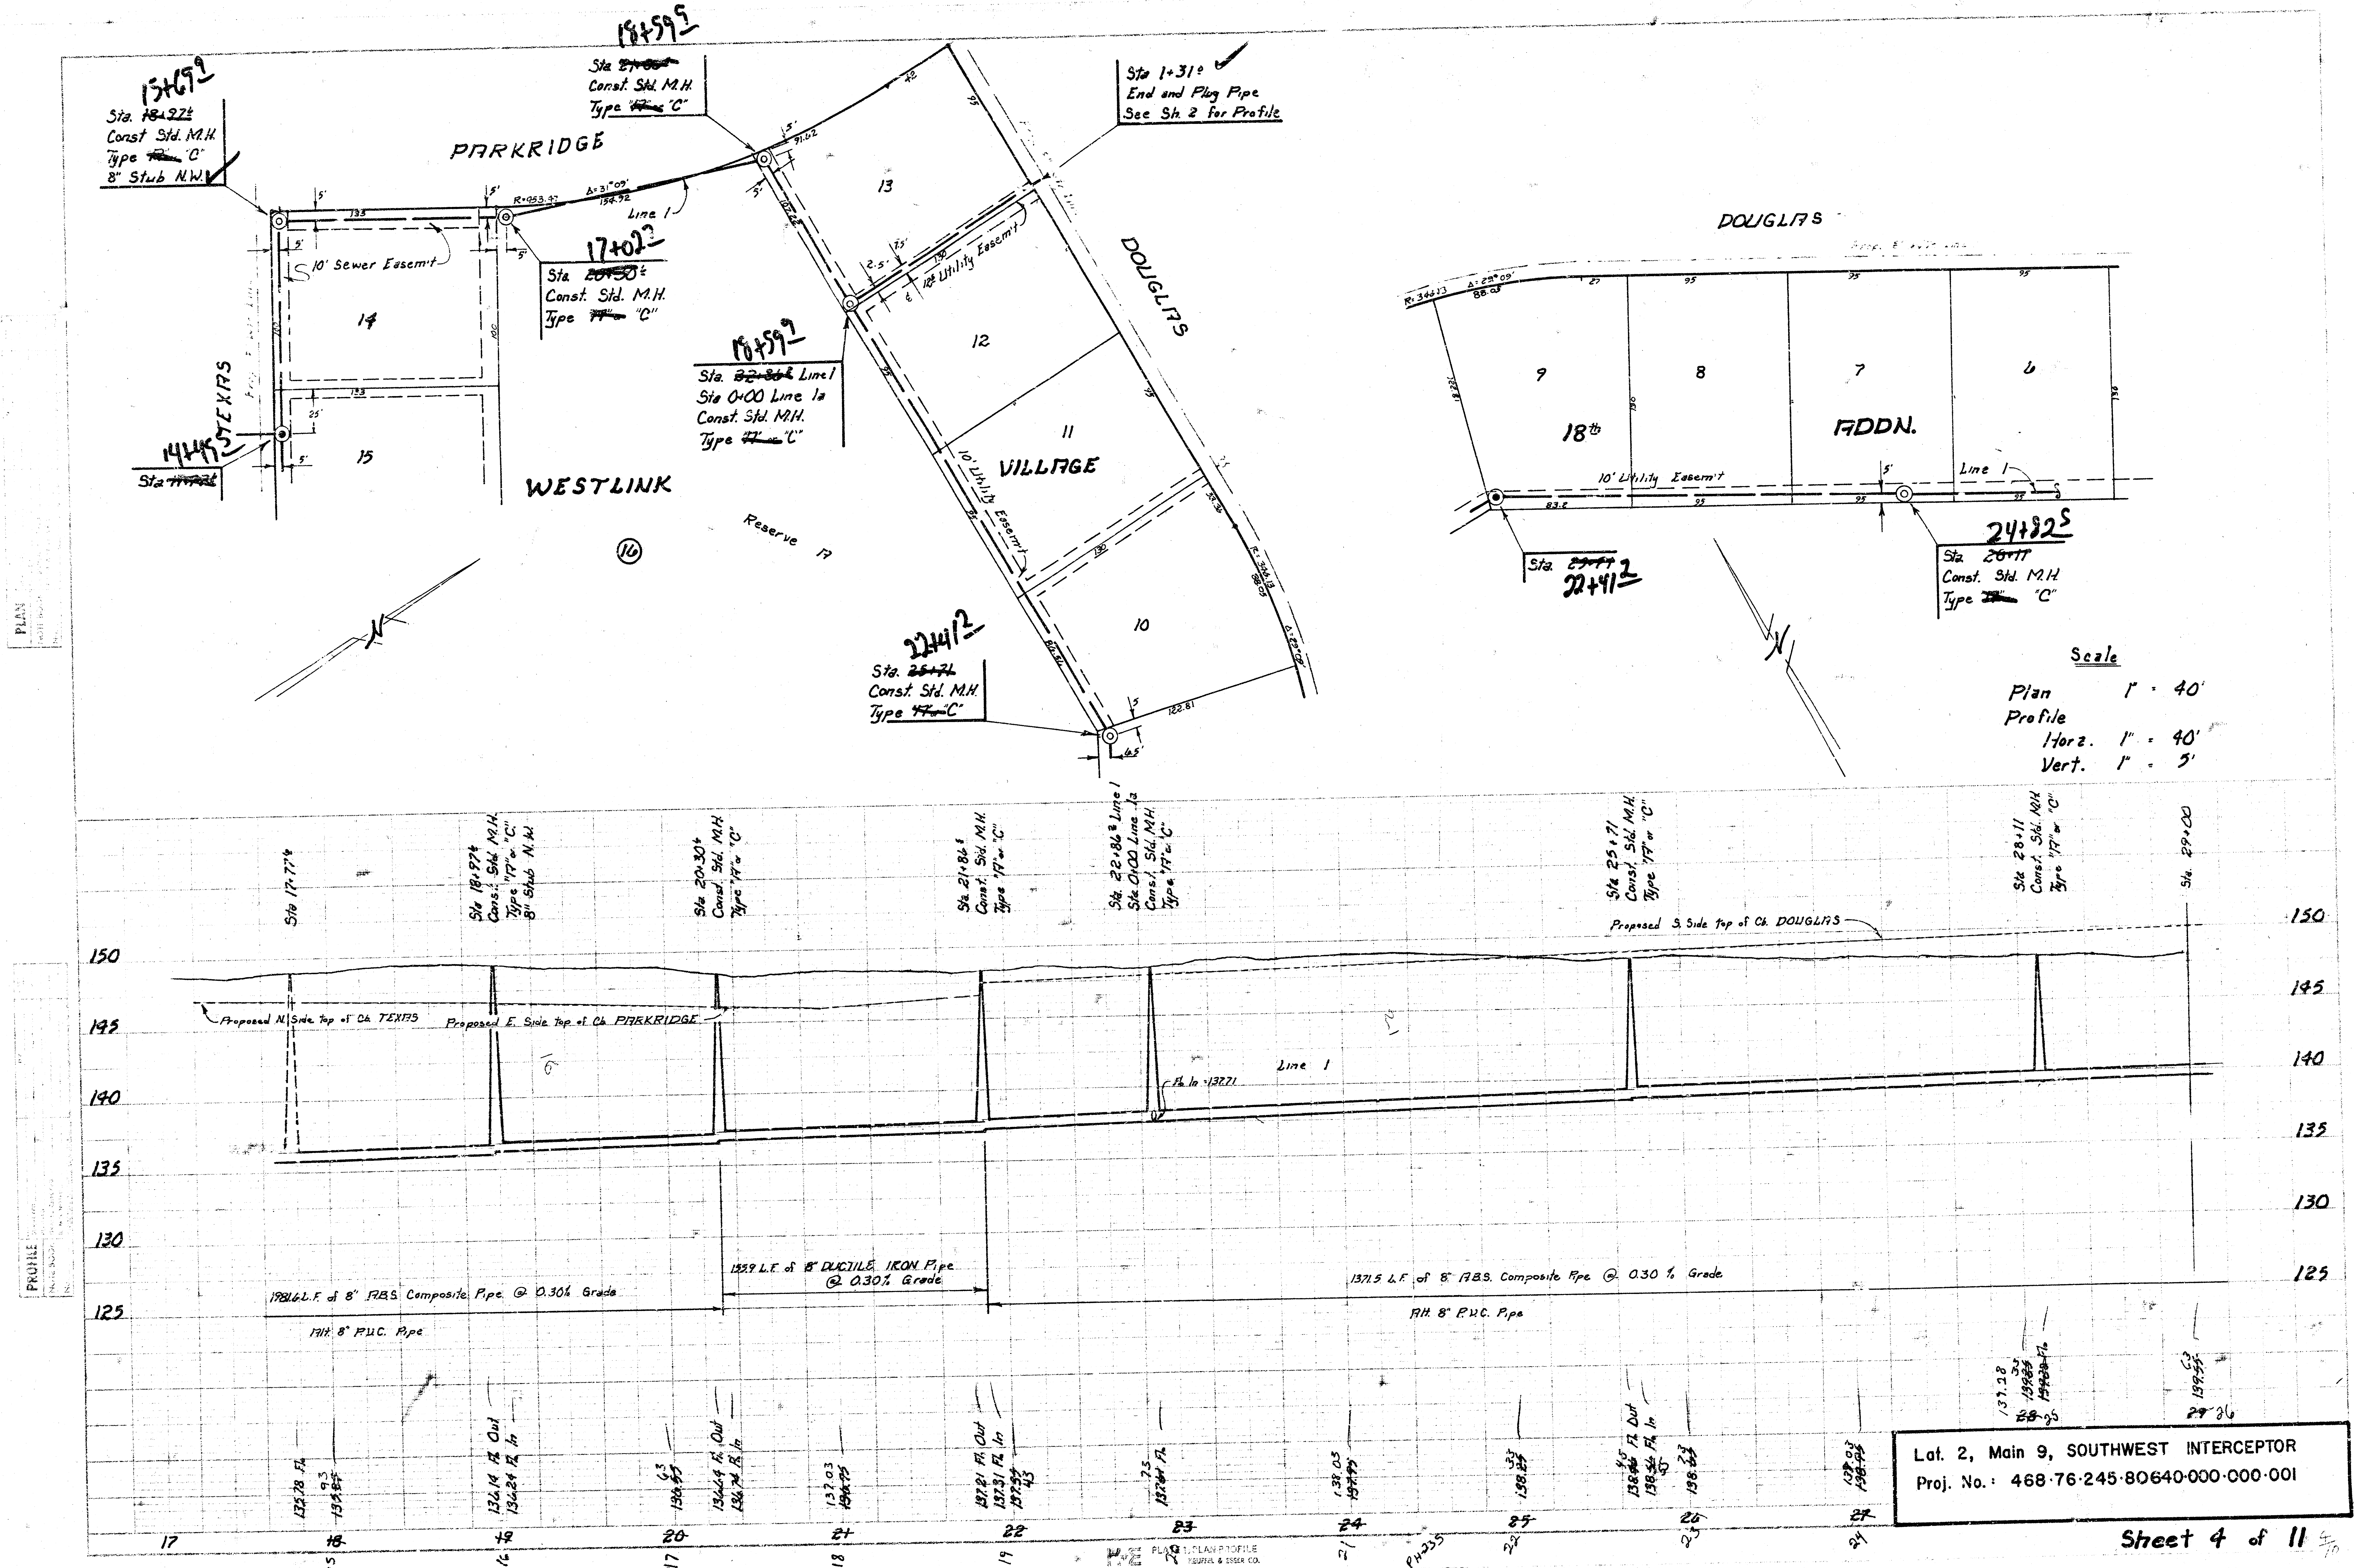


PLAN

PROFILE

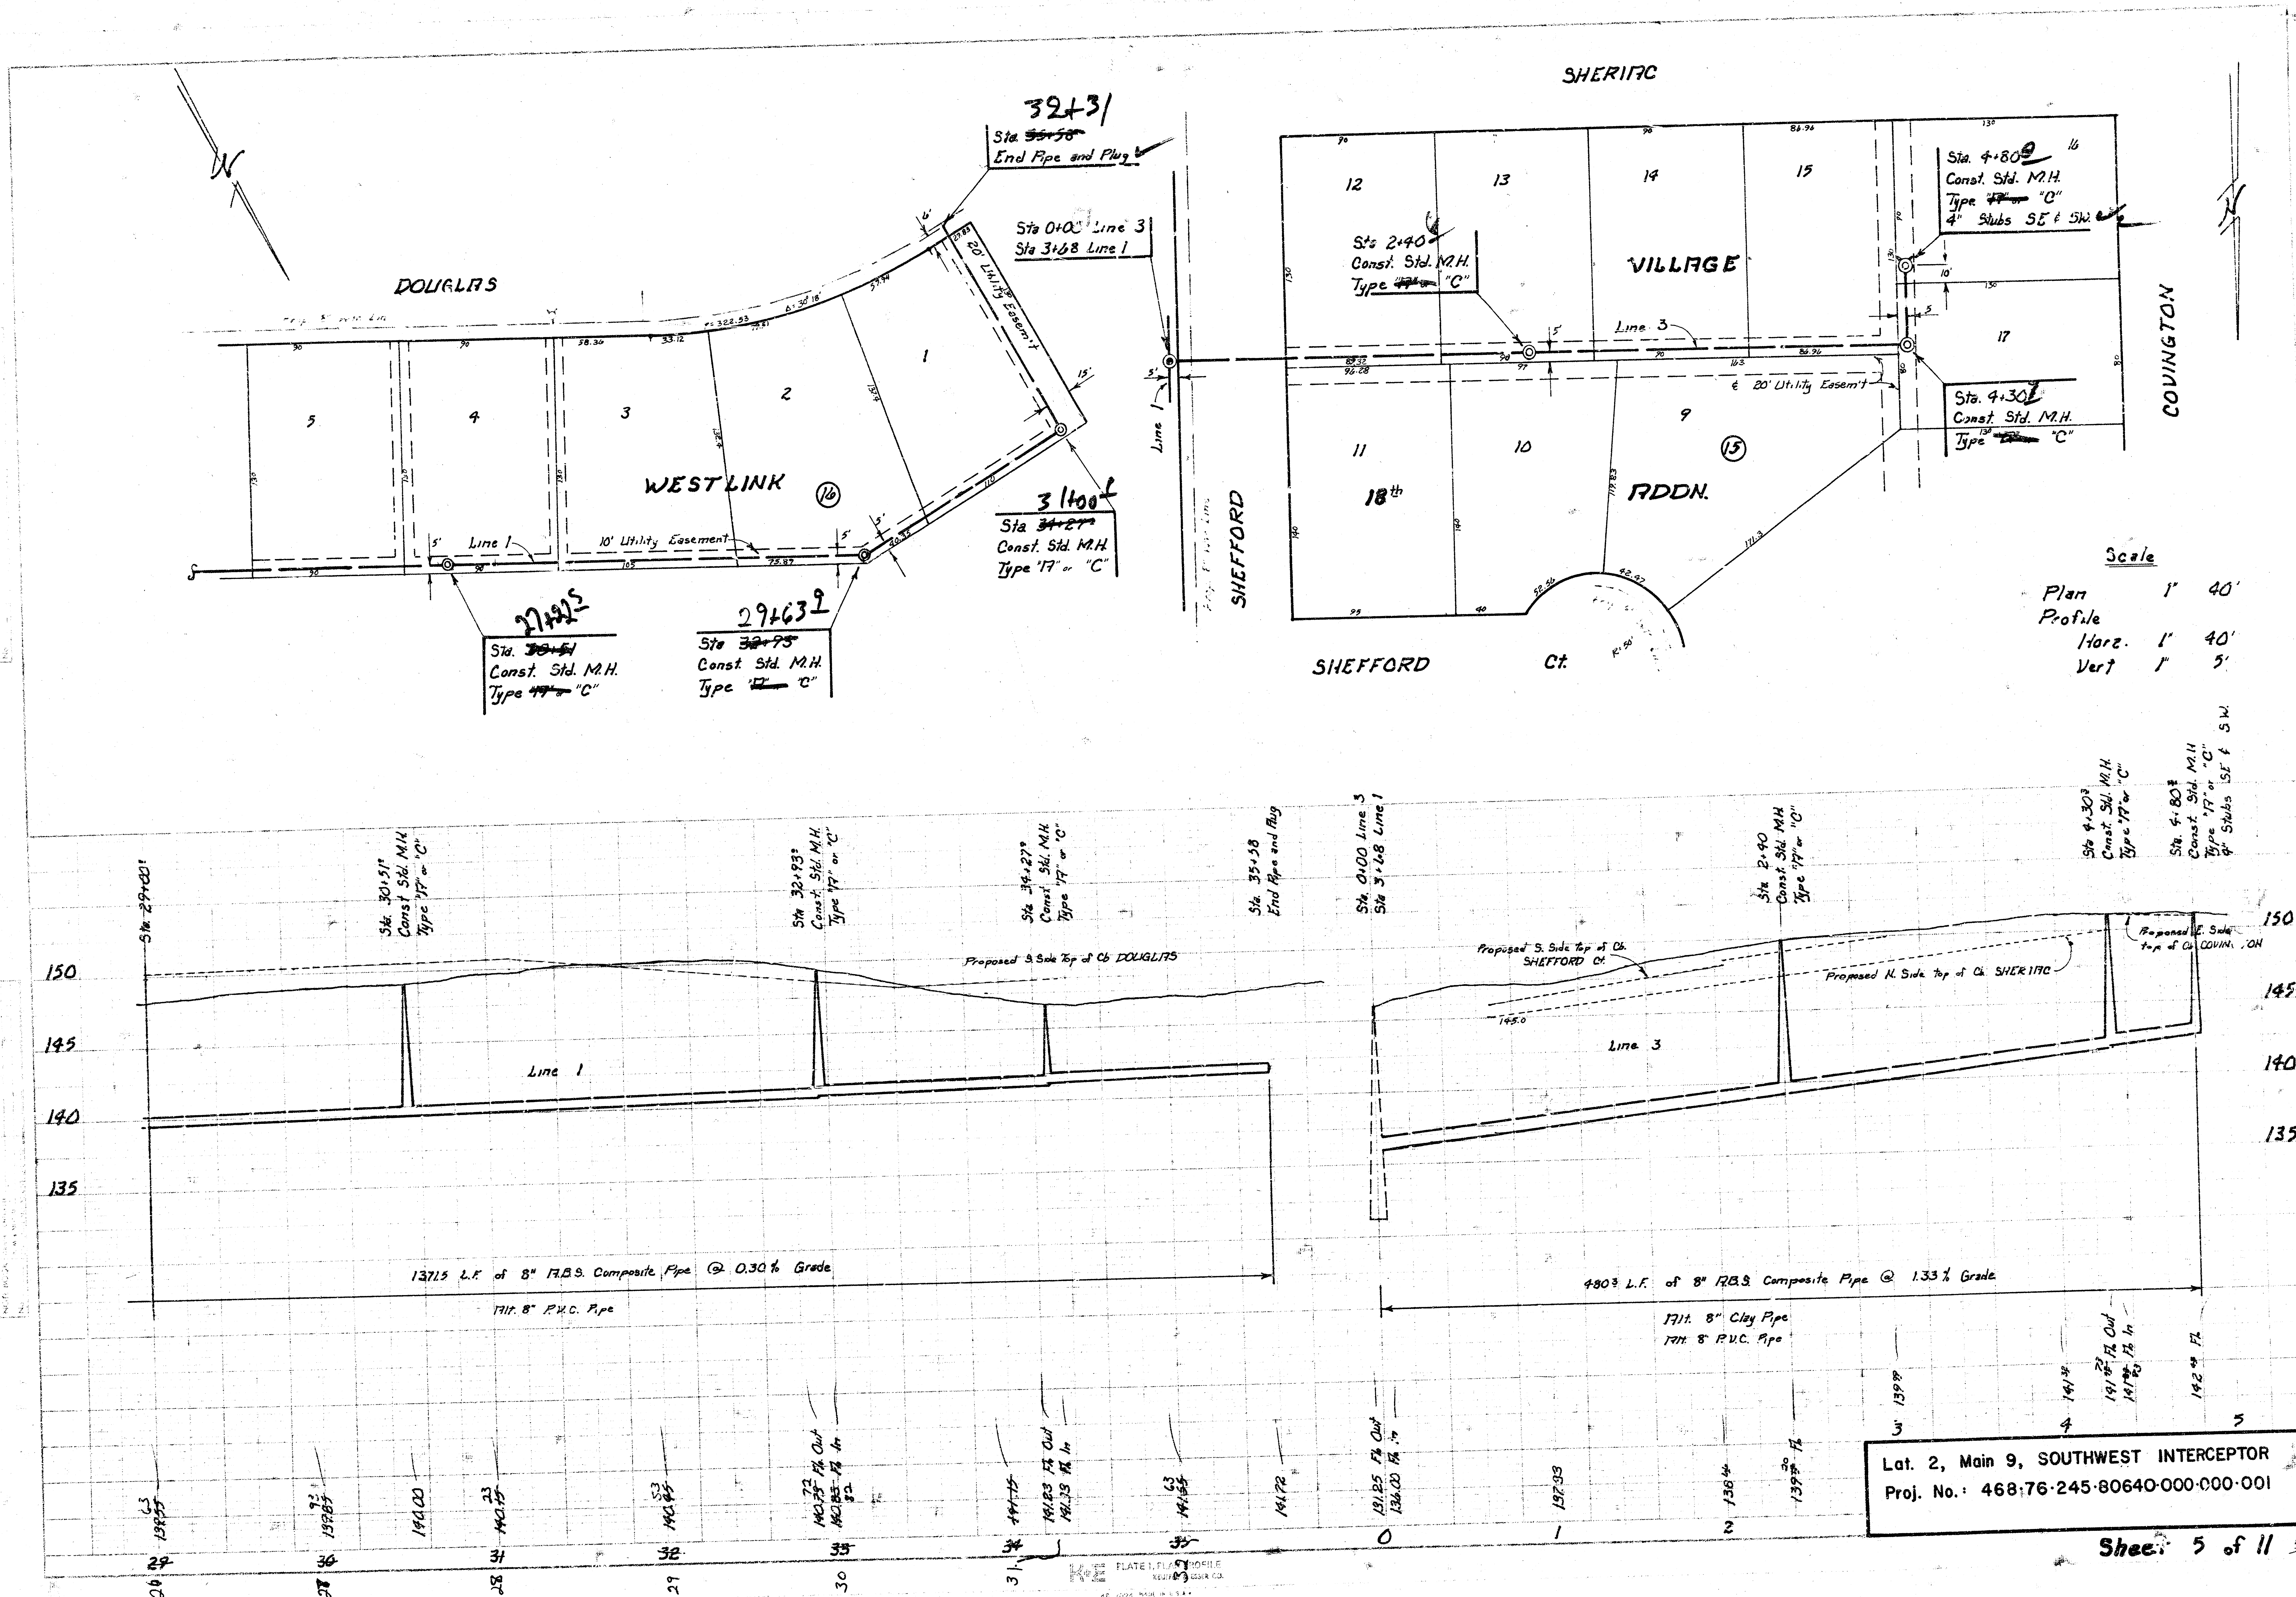


PLAN

PROFILE

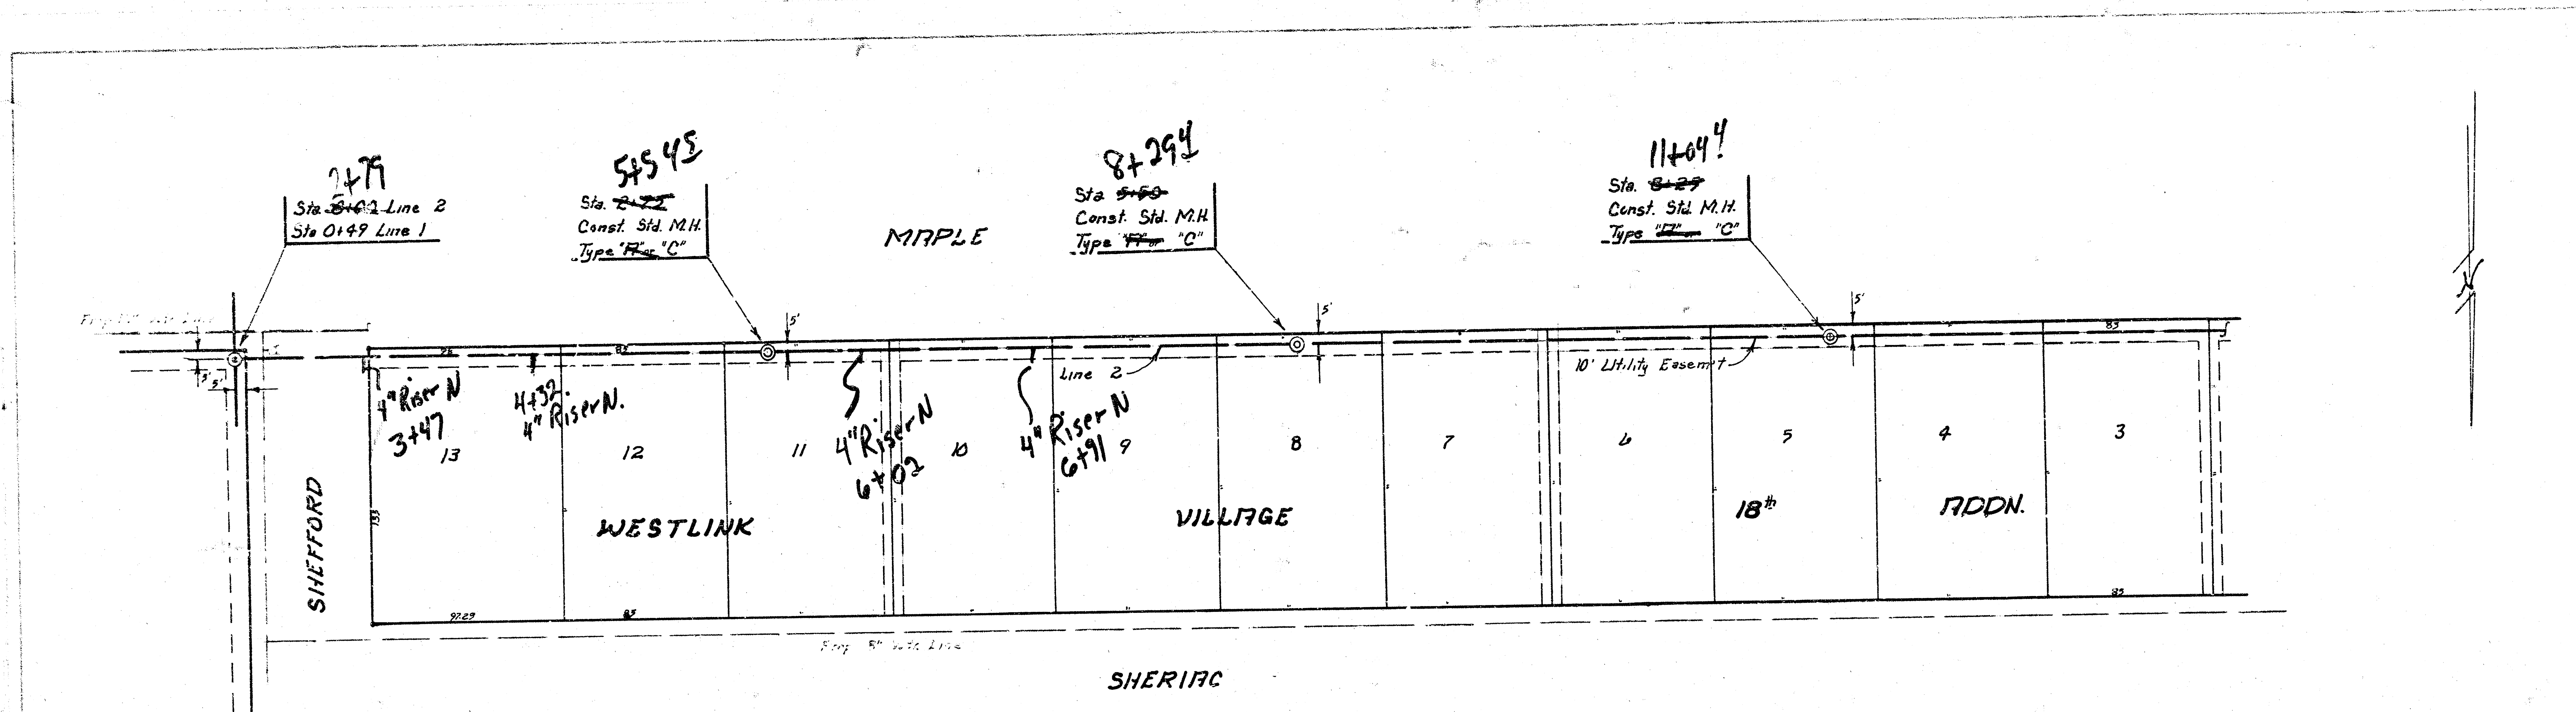



Scale
Plan 1" = 40'
Profile
Horz. 1" = 40'
Vert. 1" = 5'

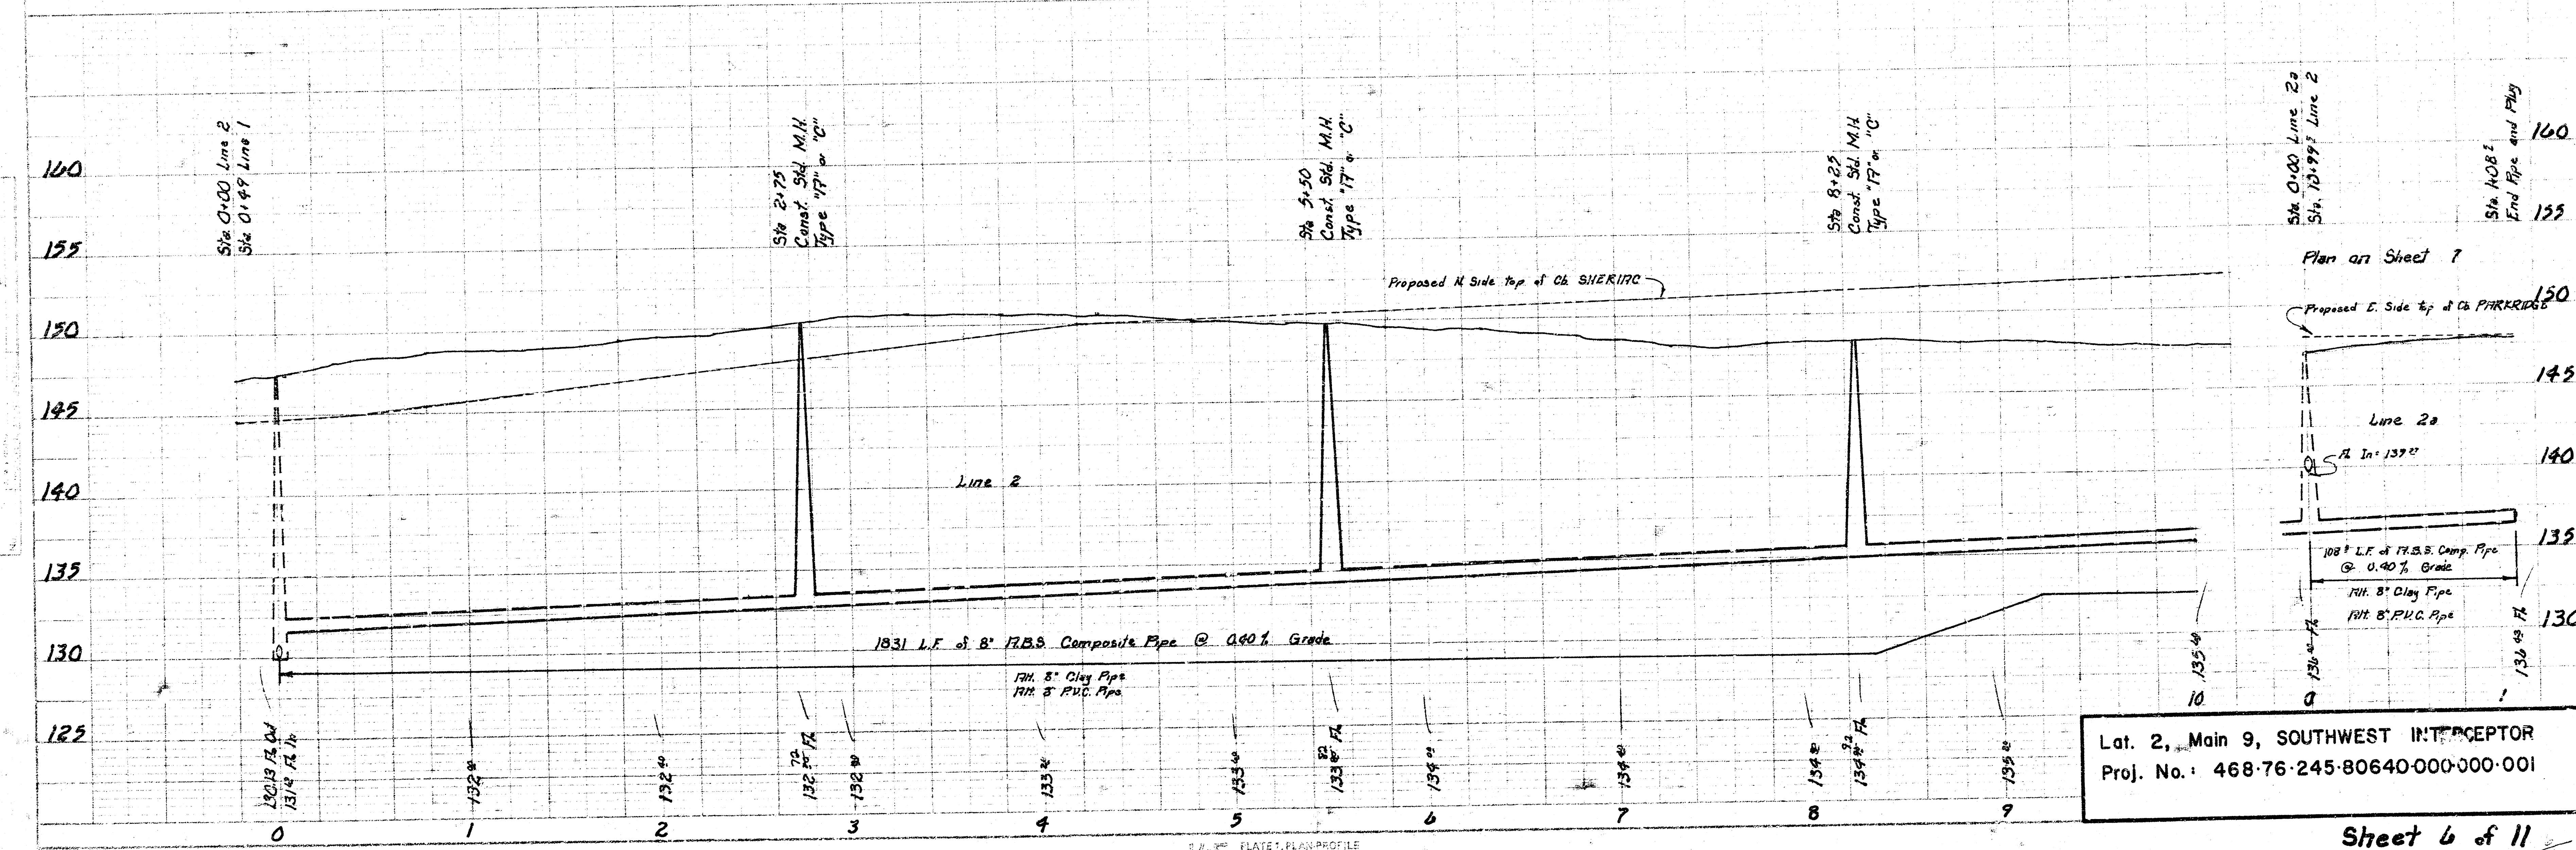


Lat. 2, Main 9, SOUTHWEST INTERCEPTOR
Proj. No.: 468-76-245-80640-000-000-001

Sheet 6 of 11



KE PLATE 1, PLAN/PROFILE
KUTRIL & GIER CO.
2014 MADE IN U.S.A.

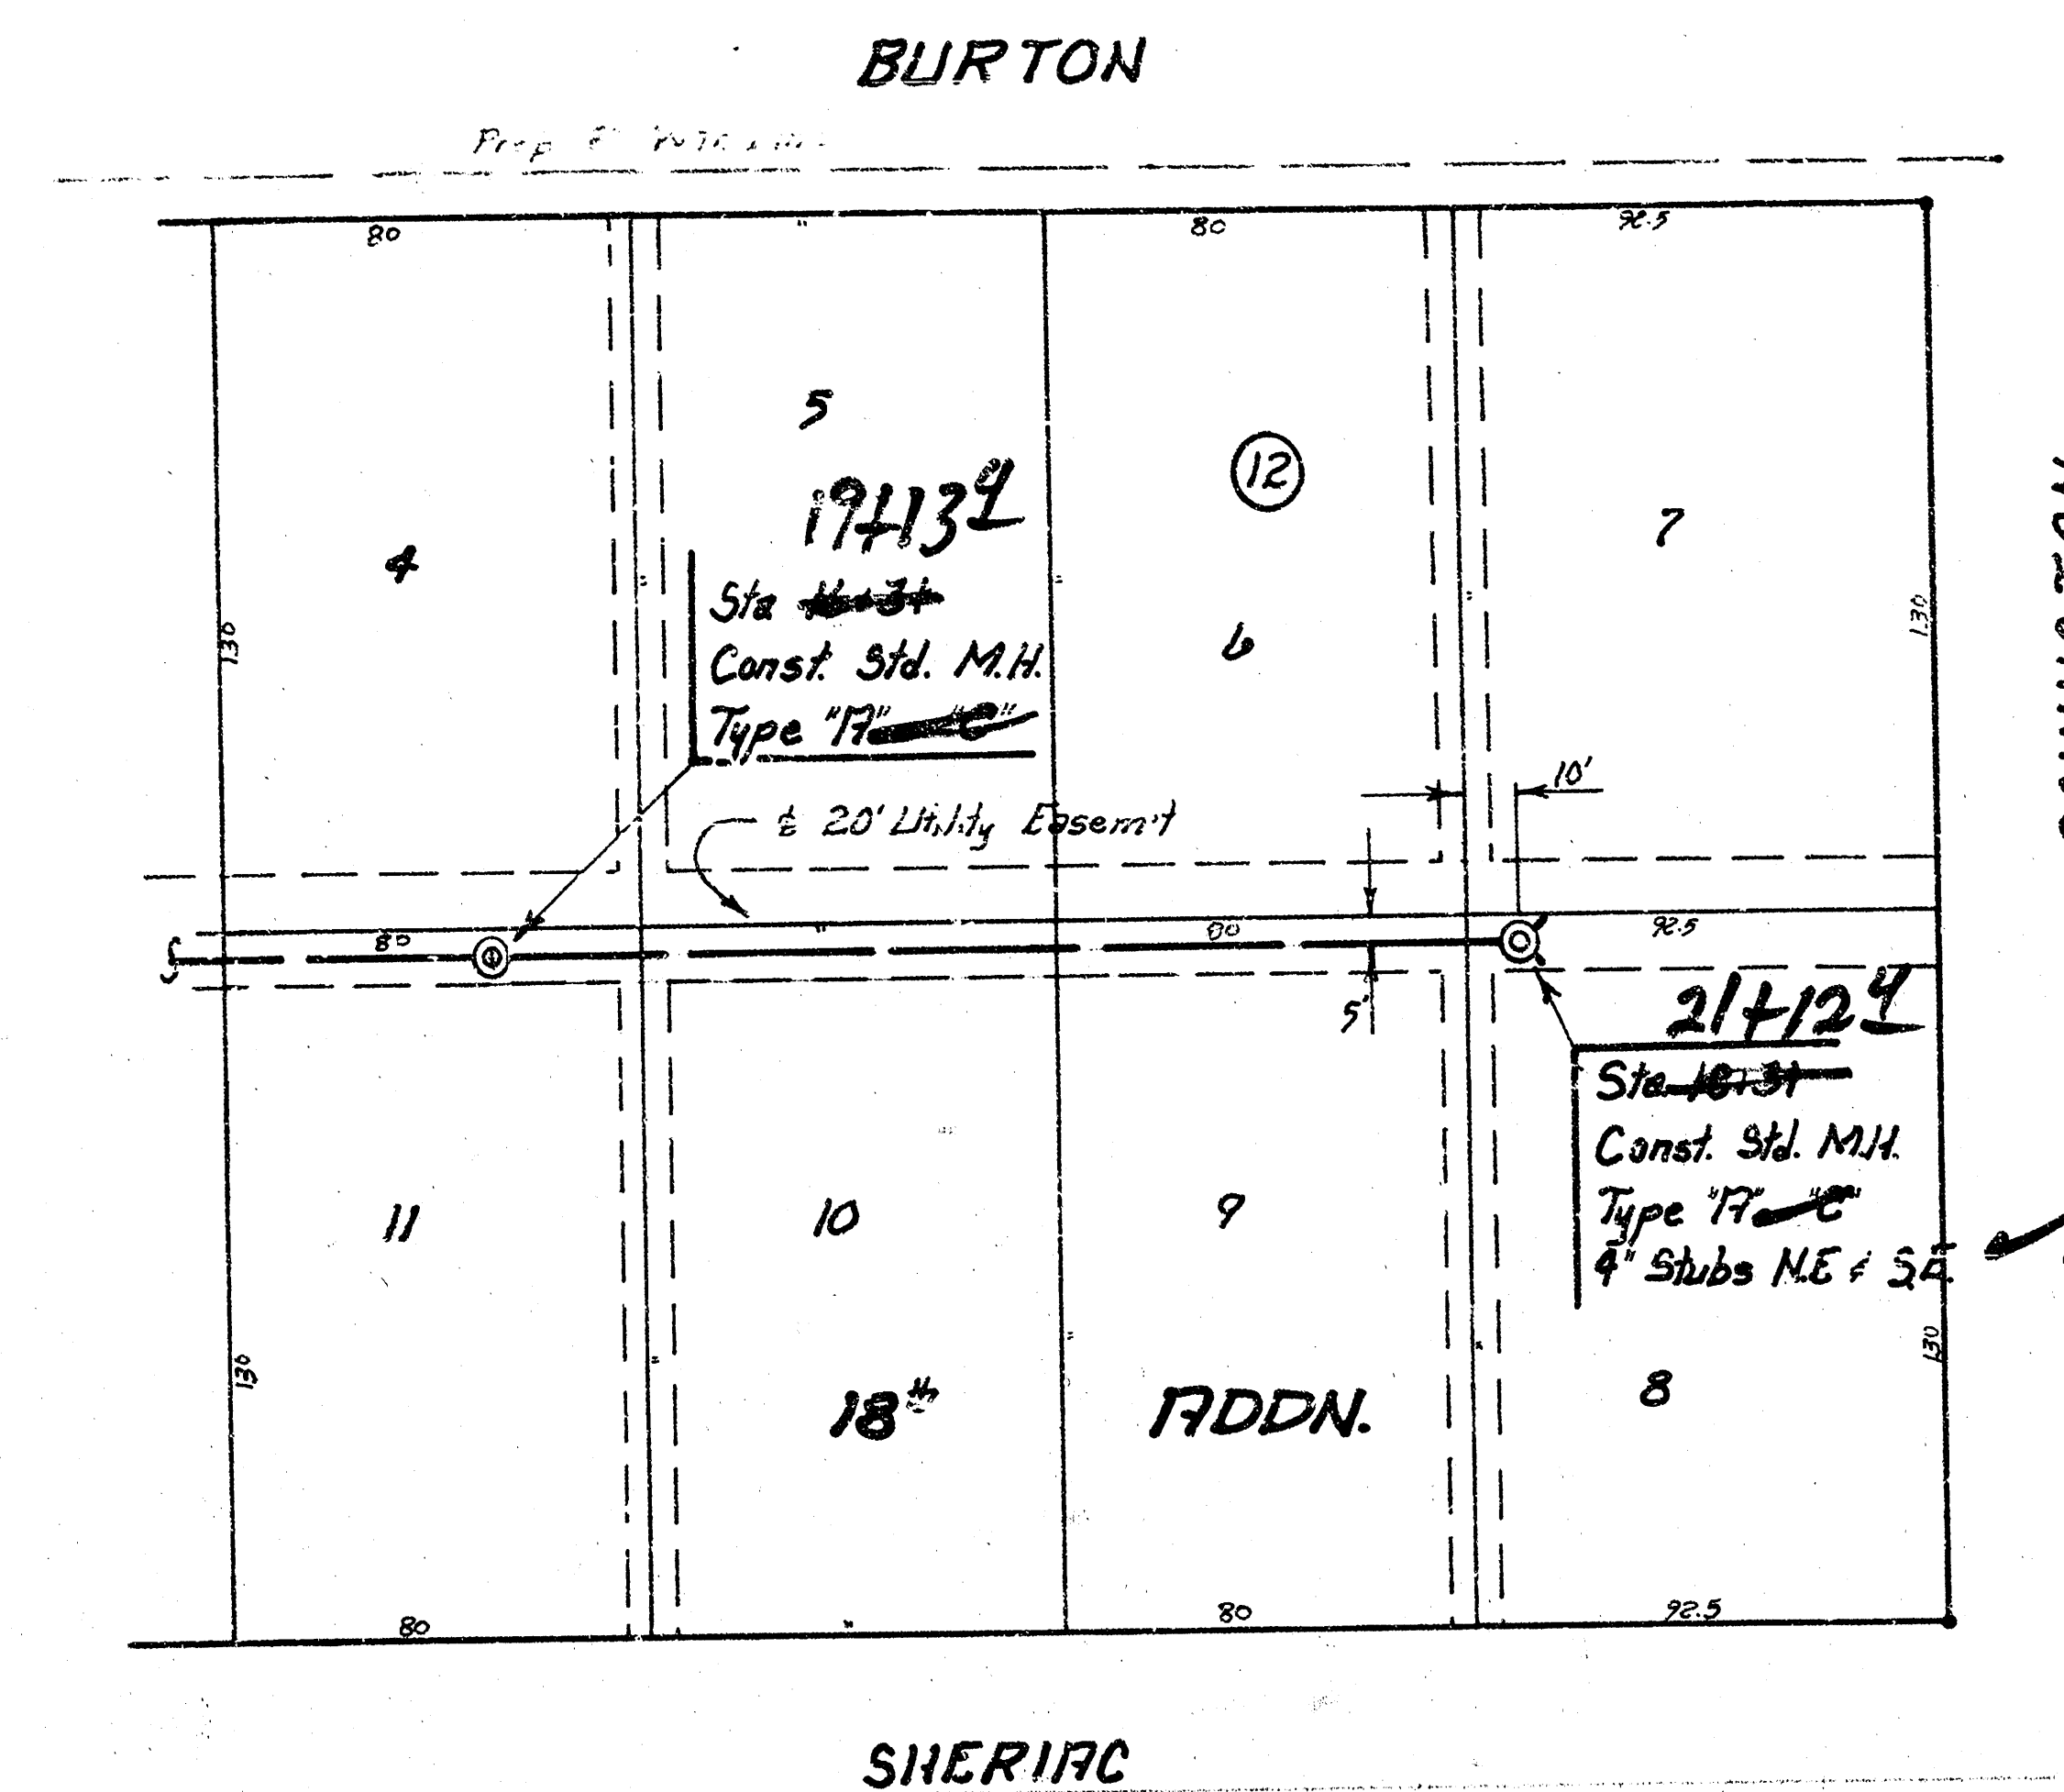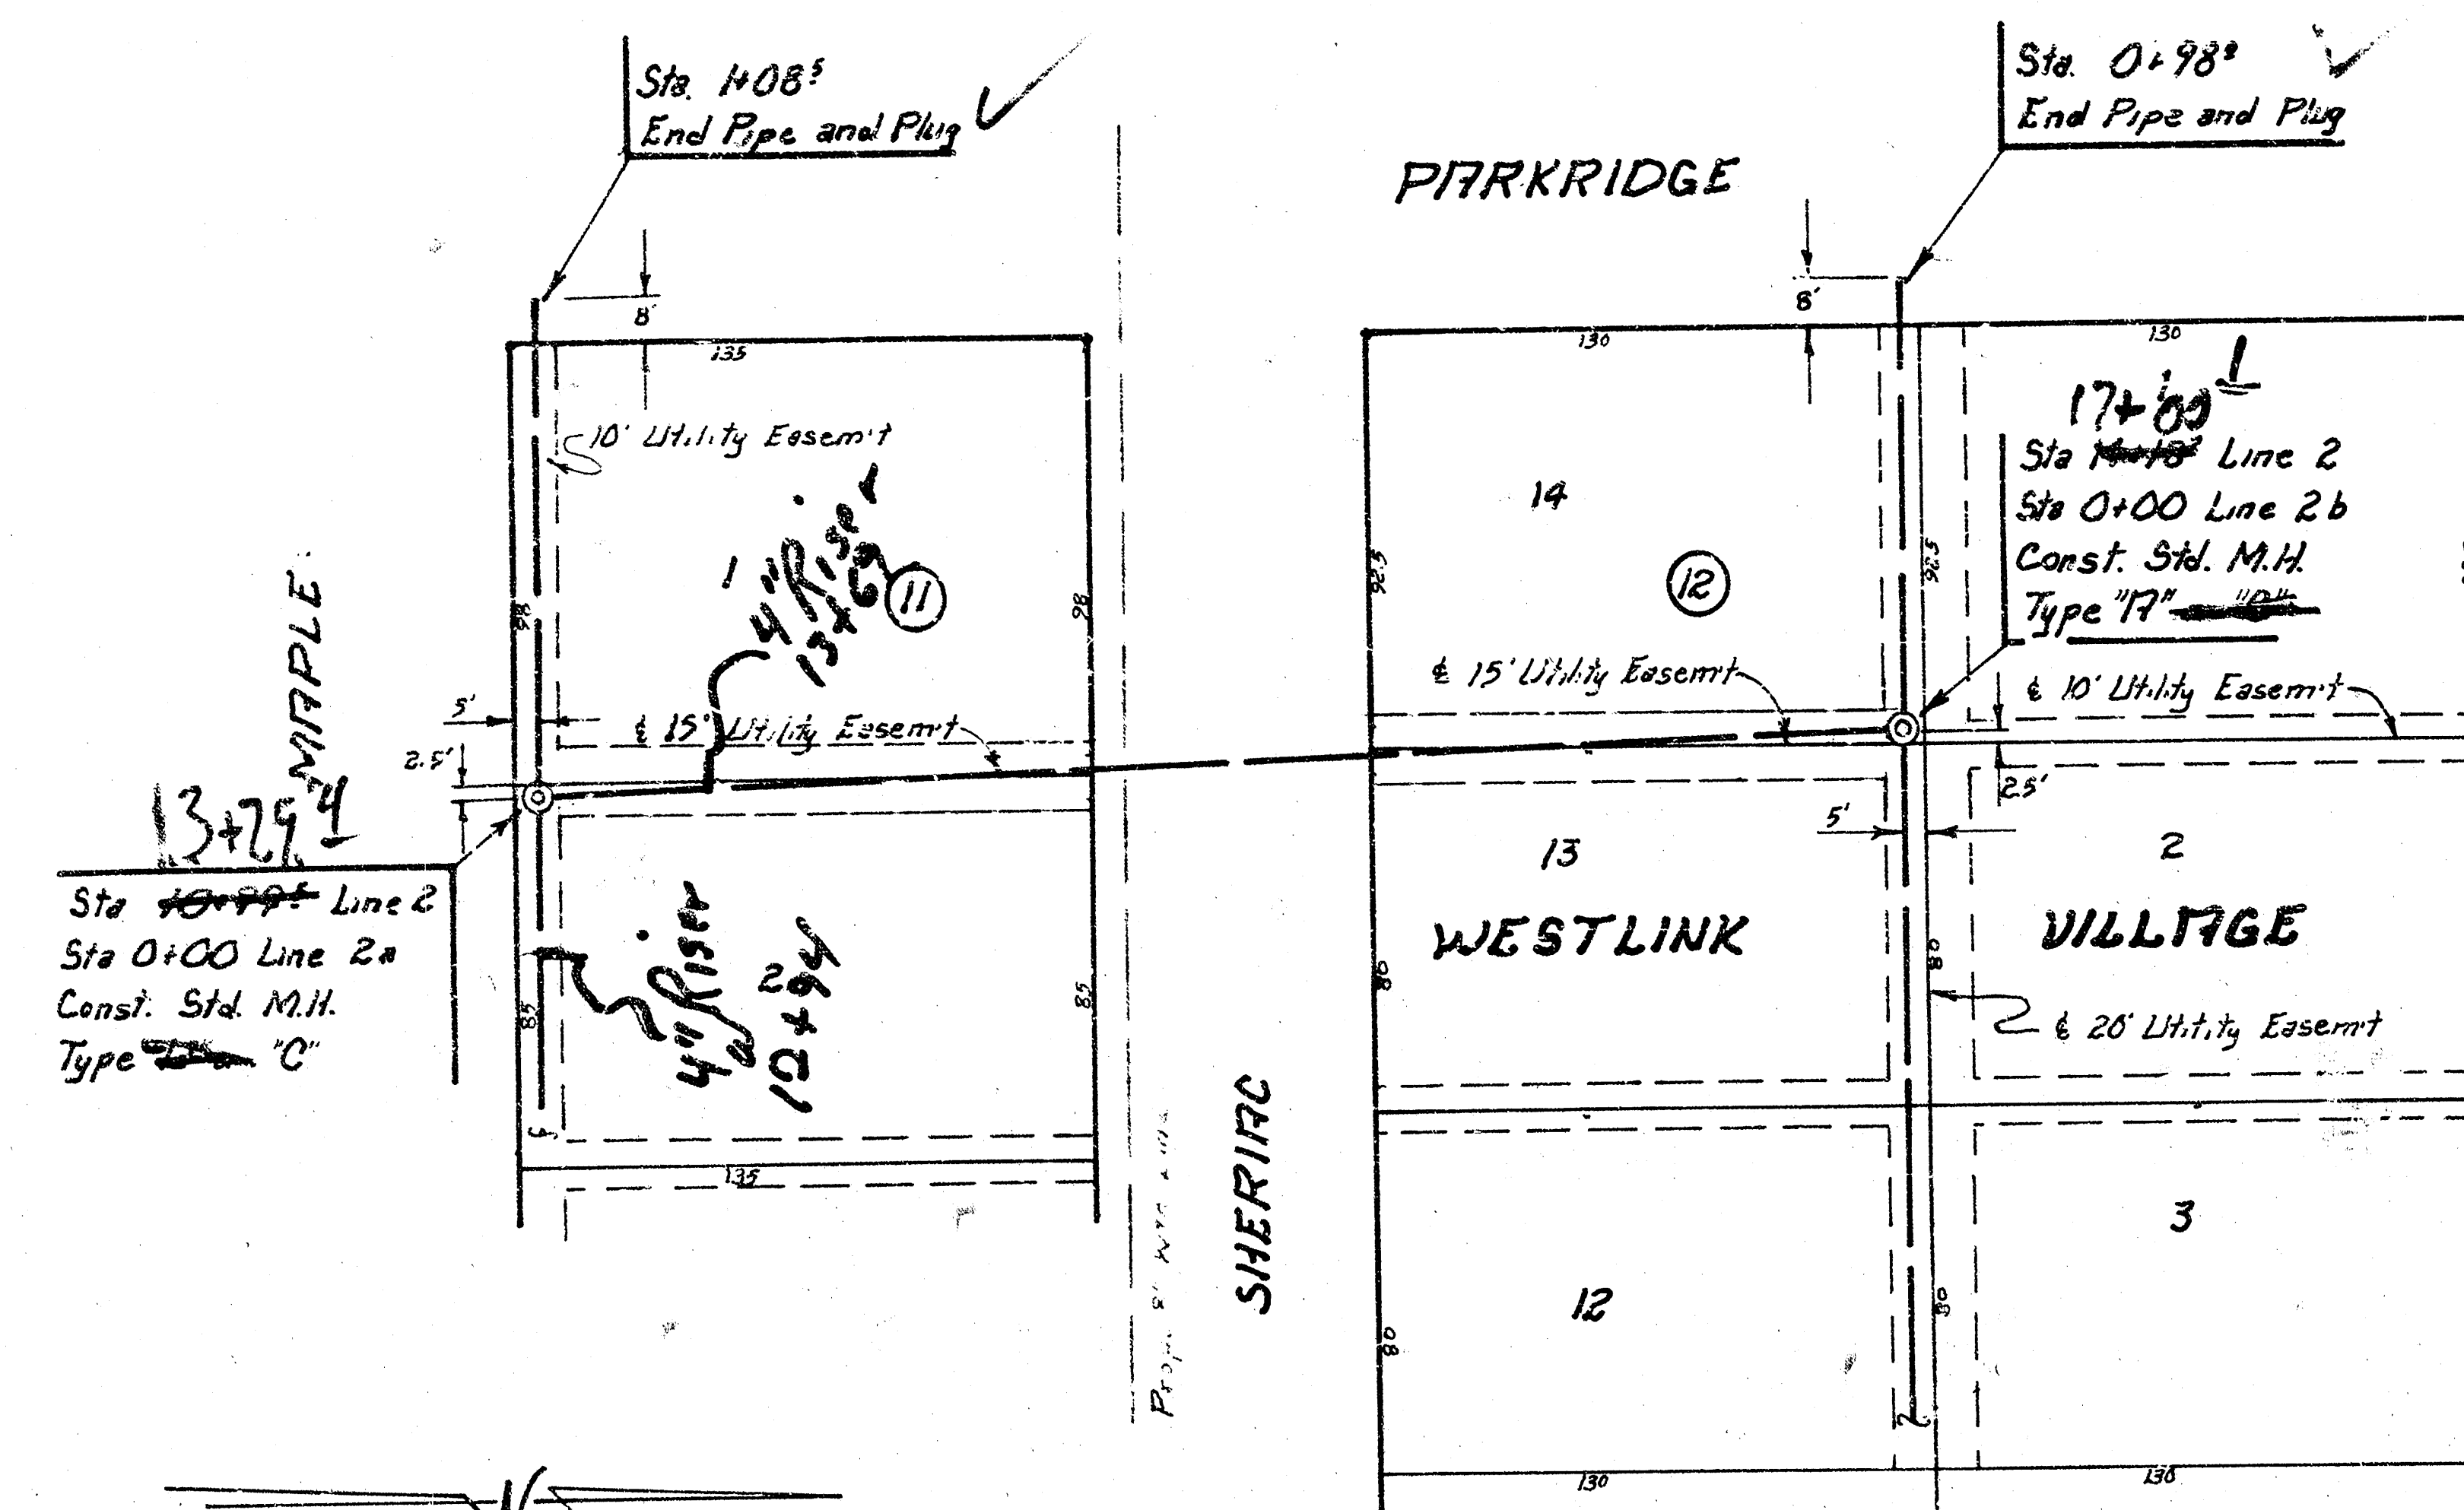


Scale
 Plan 1" = 40'
 Profile 1" = 40'
 Vert 1" = 5'

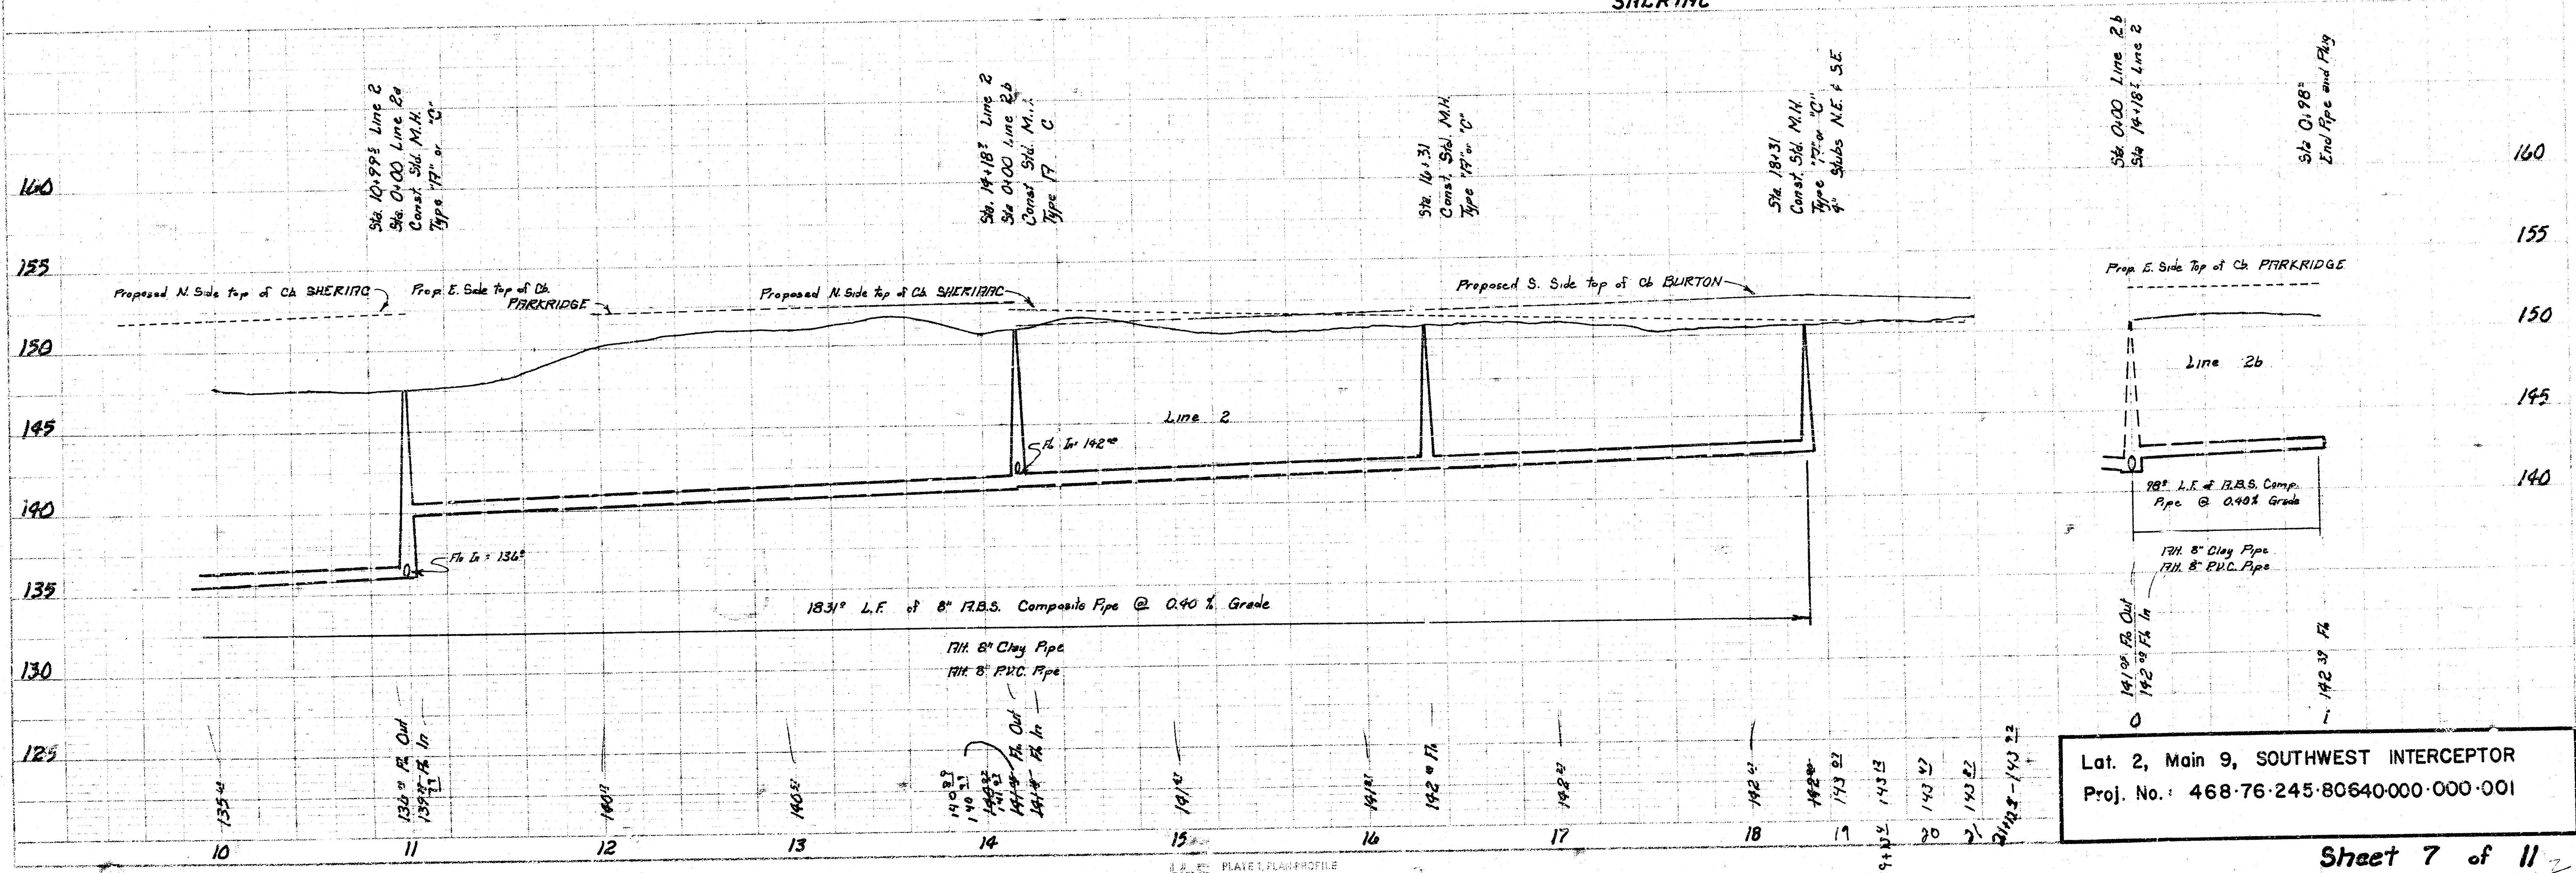


Lat. 2, Main 9, SOUTHWEST INTERCEPTOR
 Proj. No.: 468-76-245-80640-000-000-001

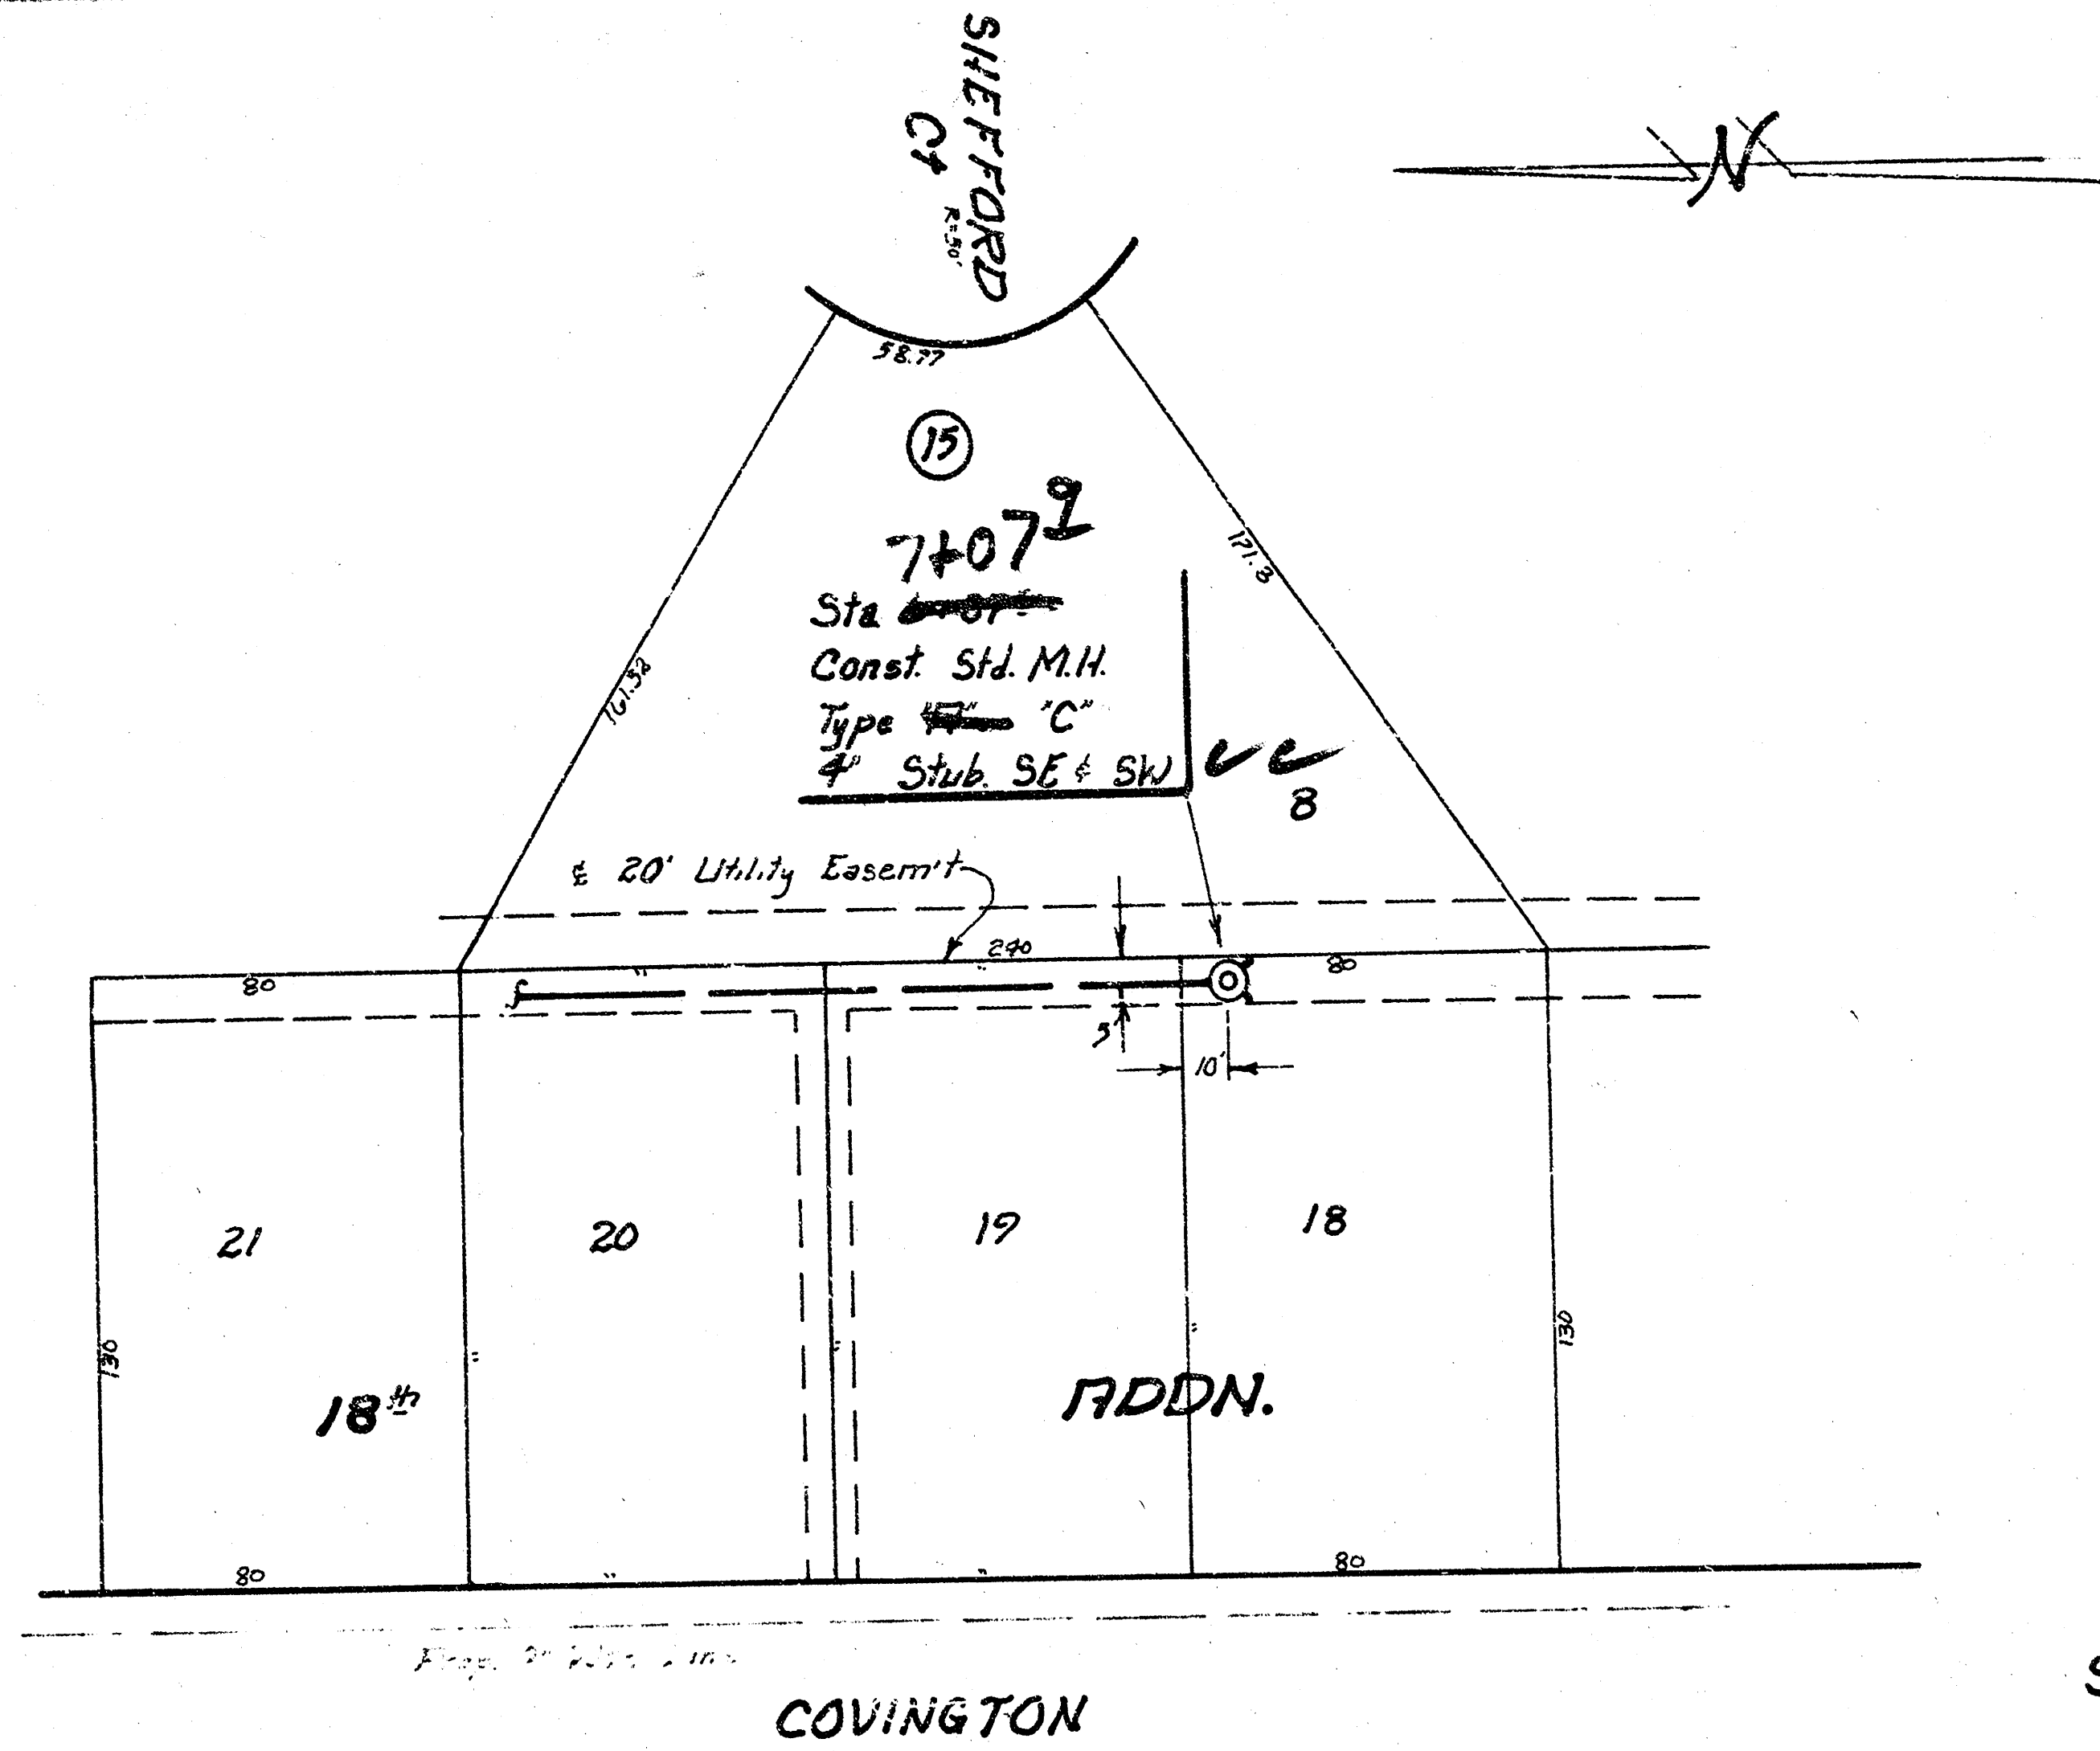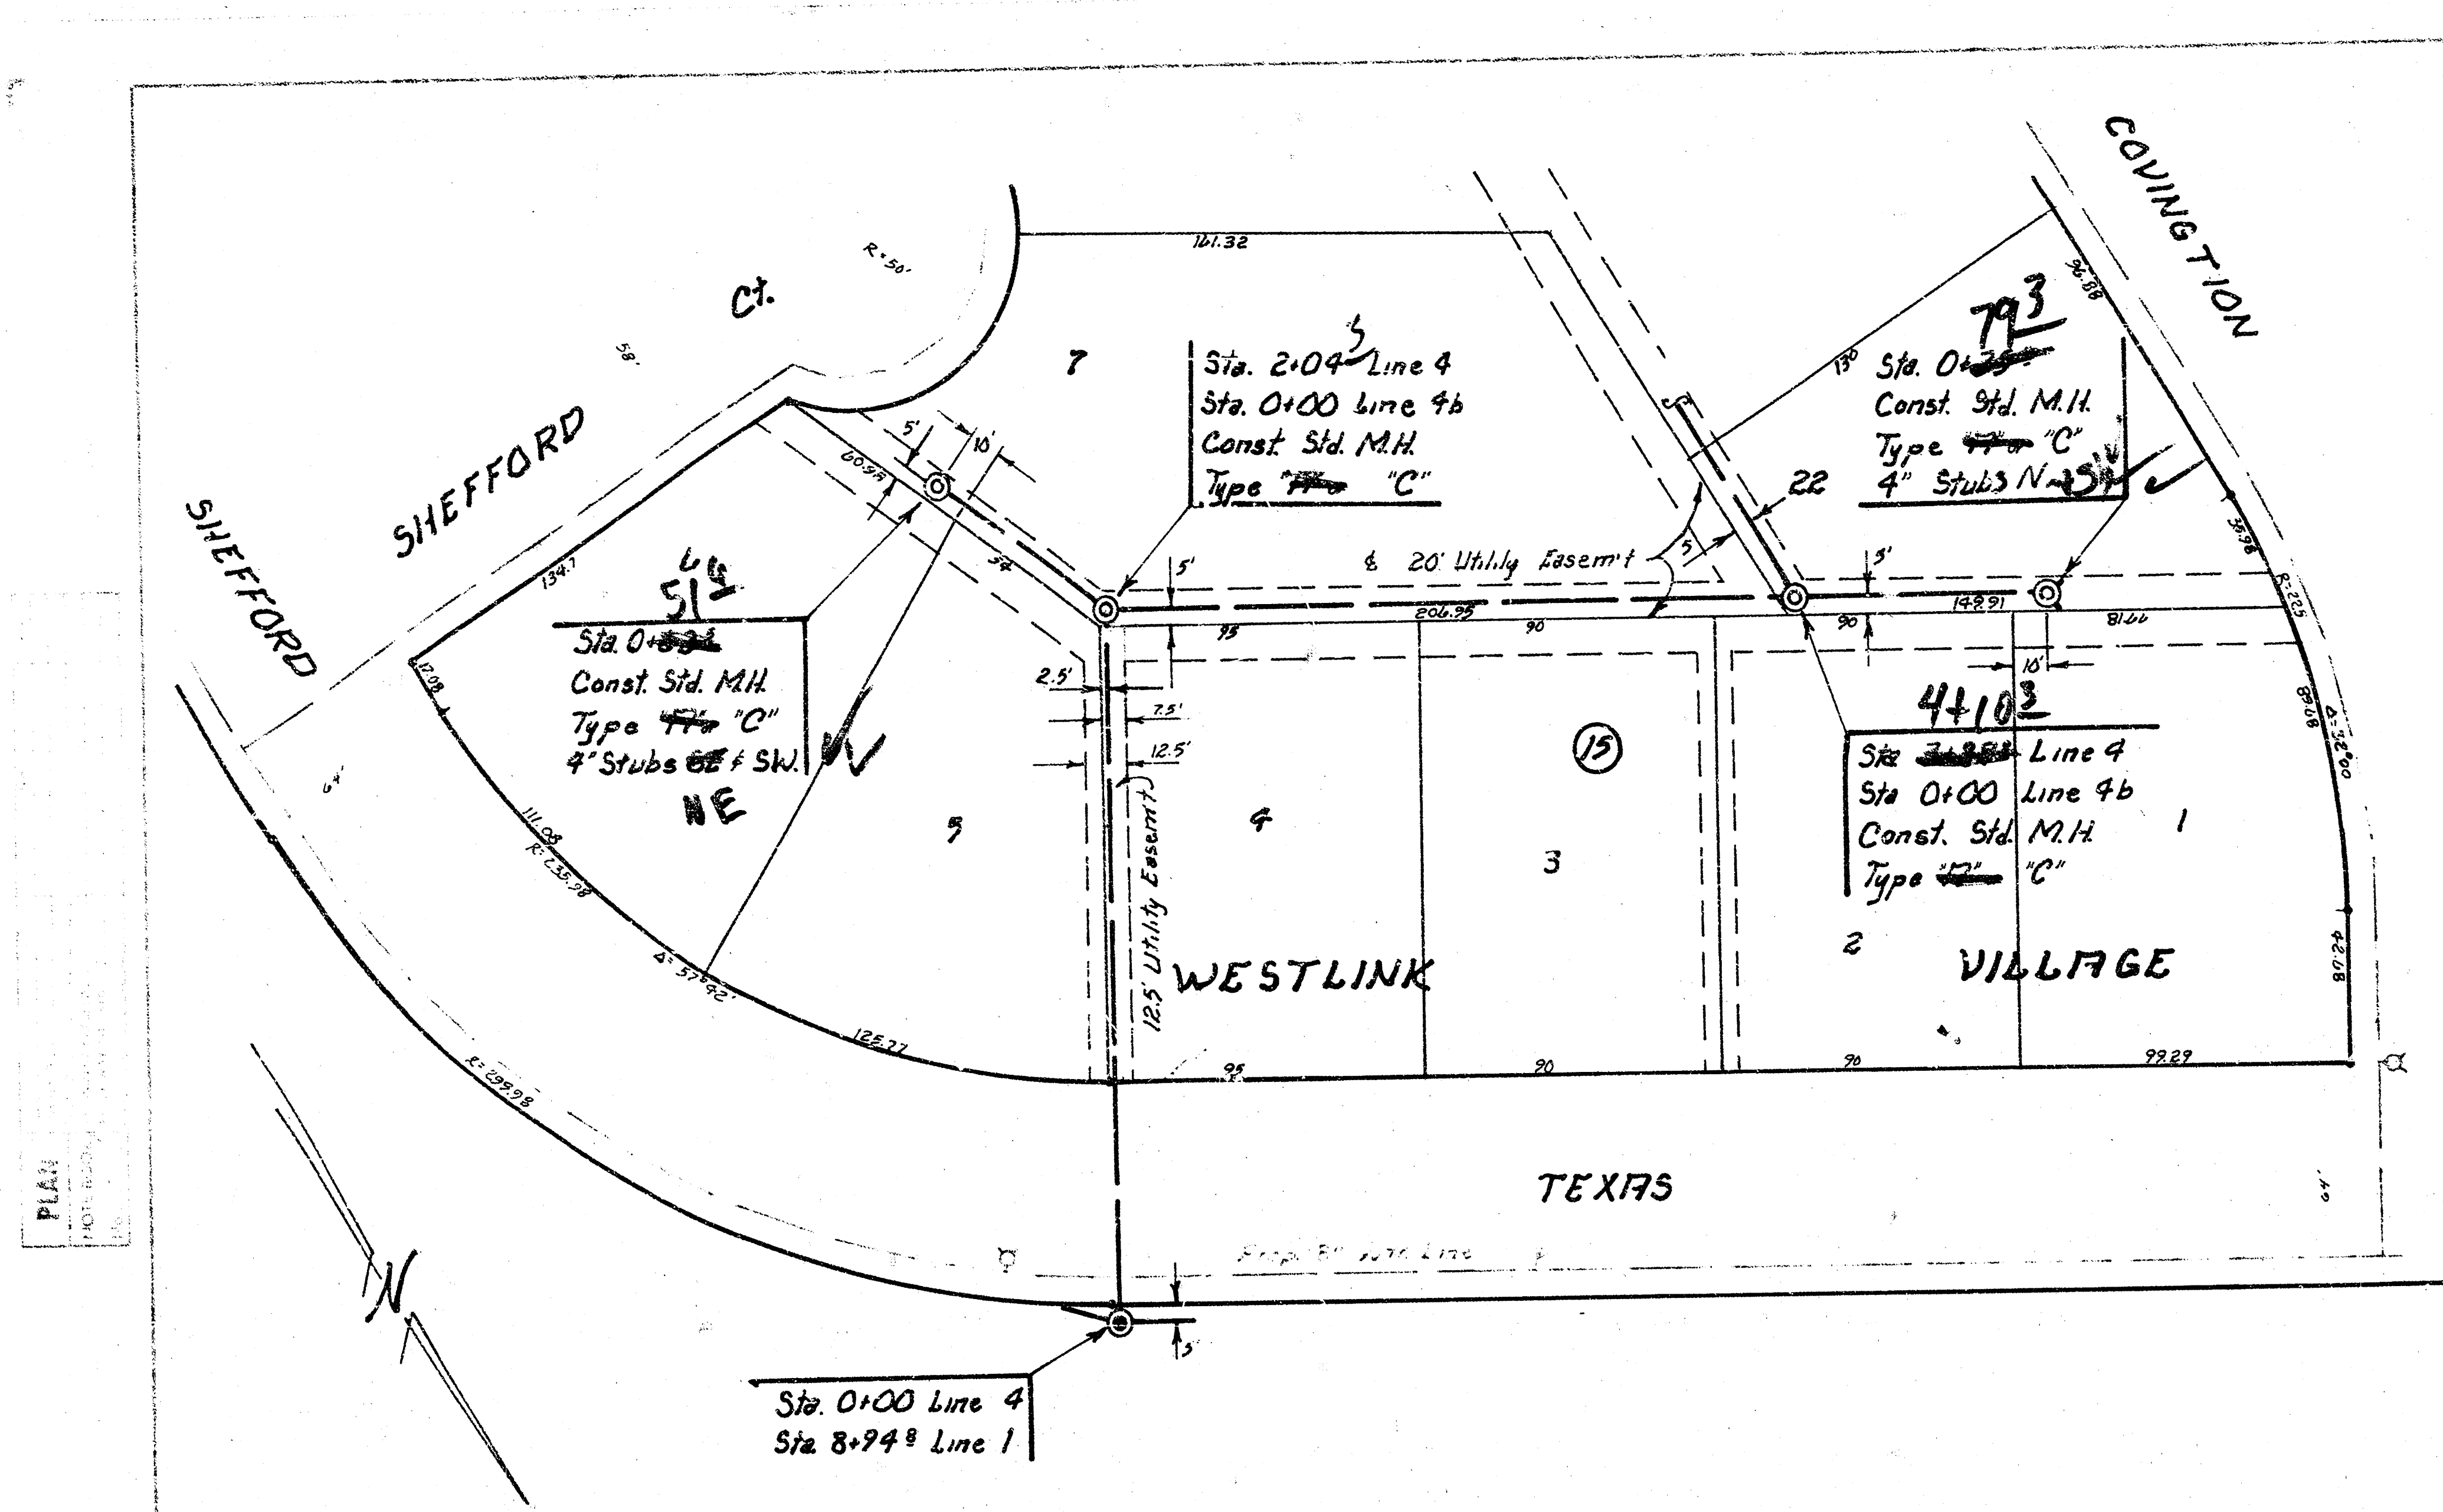



Scale
 Plan 1" = 40'
 Profile 1" = 40'
 Horiz. 1" = 40'
 Vert. 1" = 5'

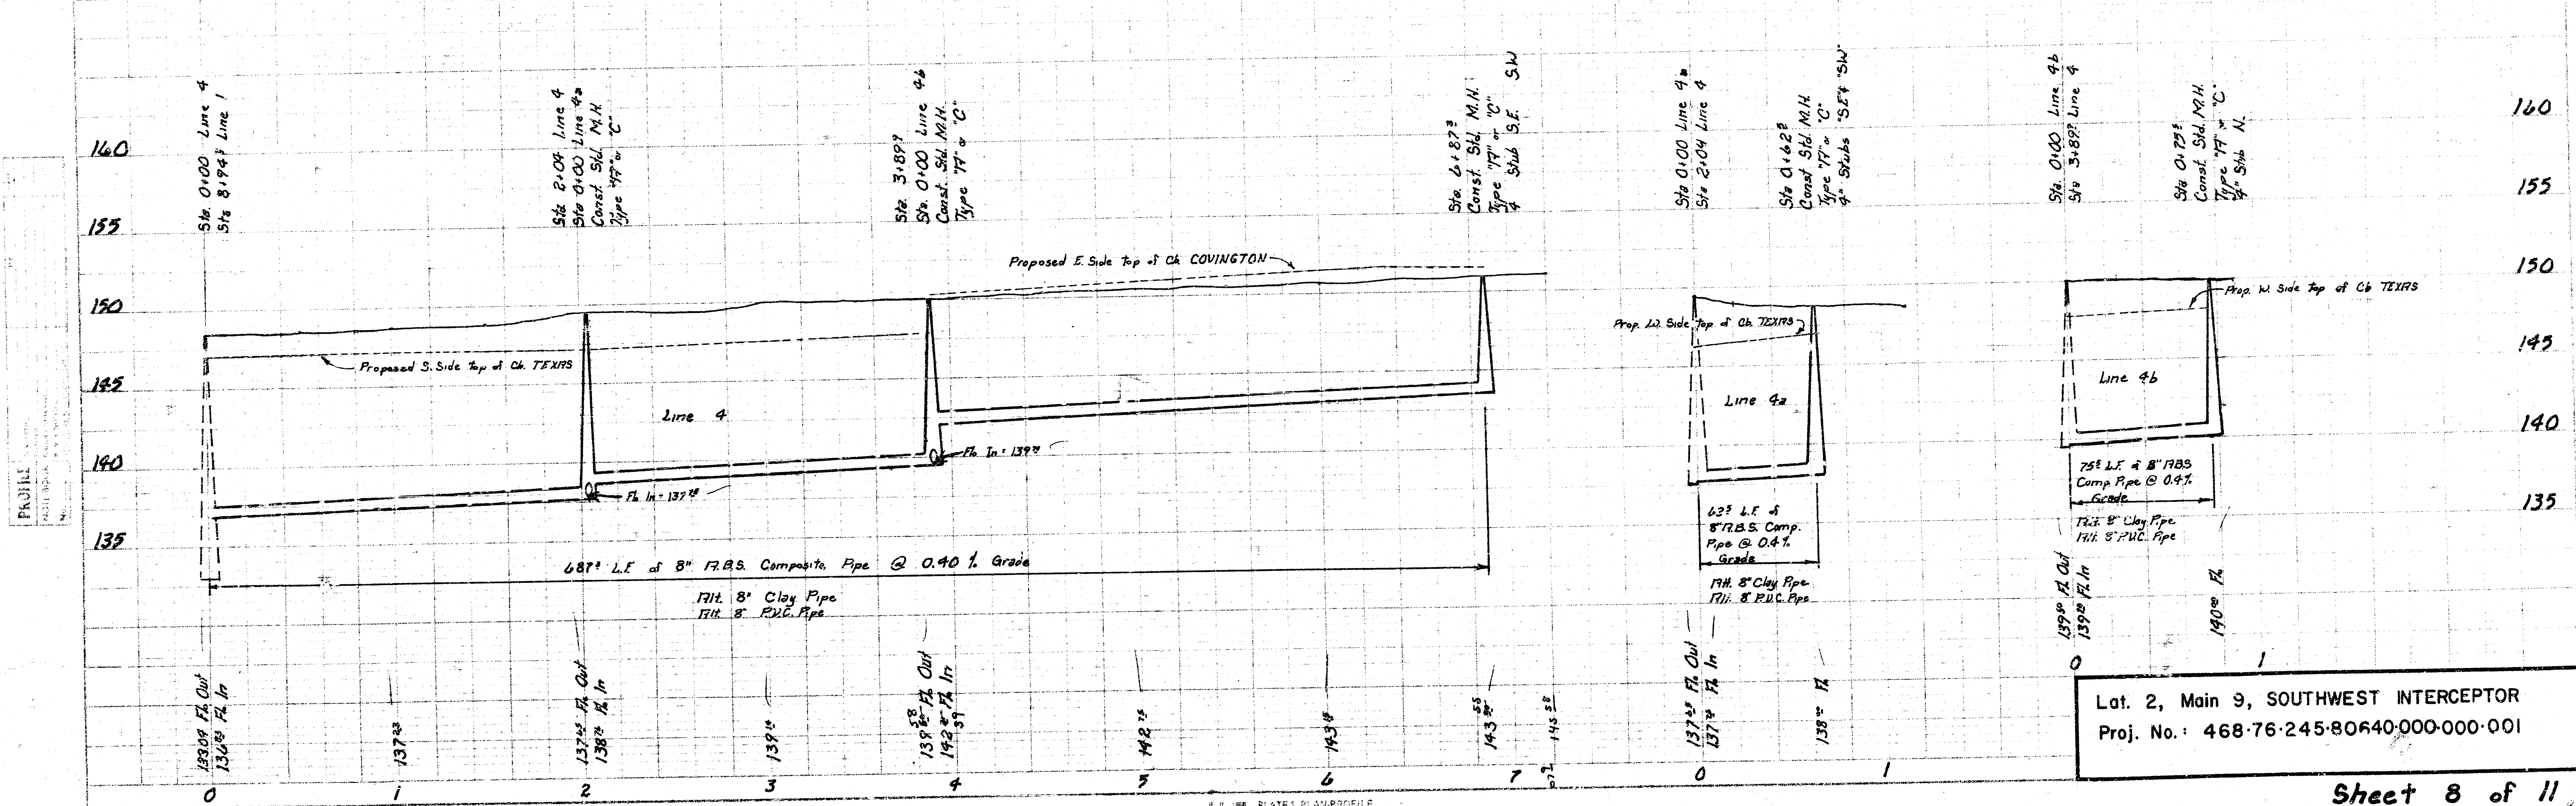

Lat. 2, Main 9, SOUTHWEST INTERCEPTOR
 Proj. No.: 468-76-245-80640-000-000-001

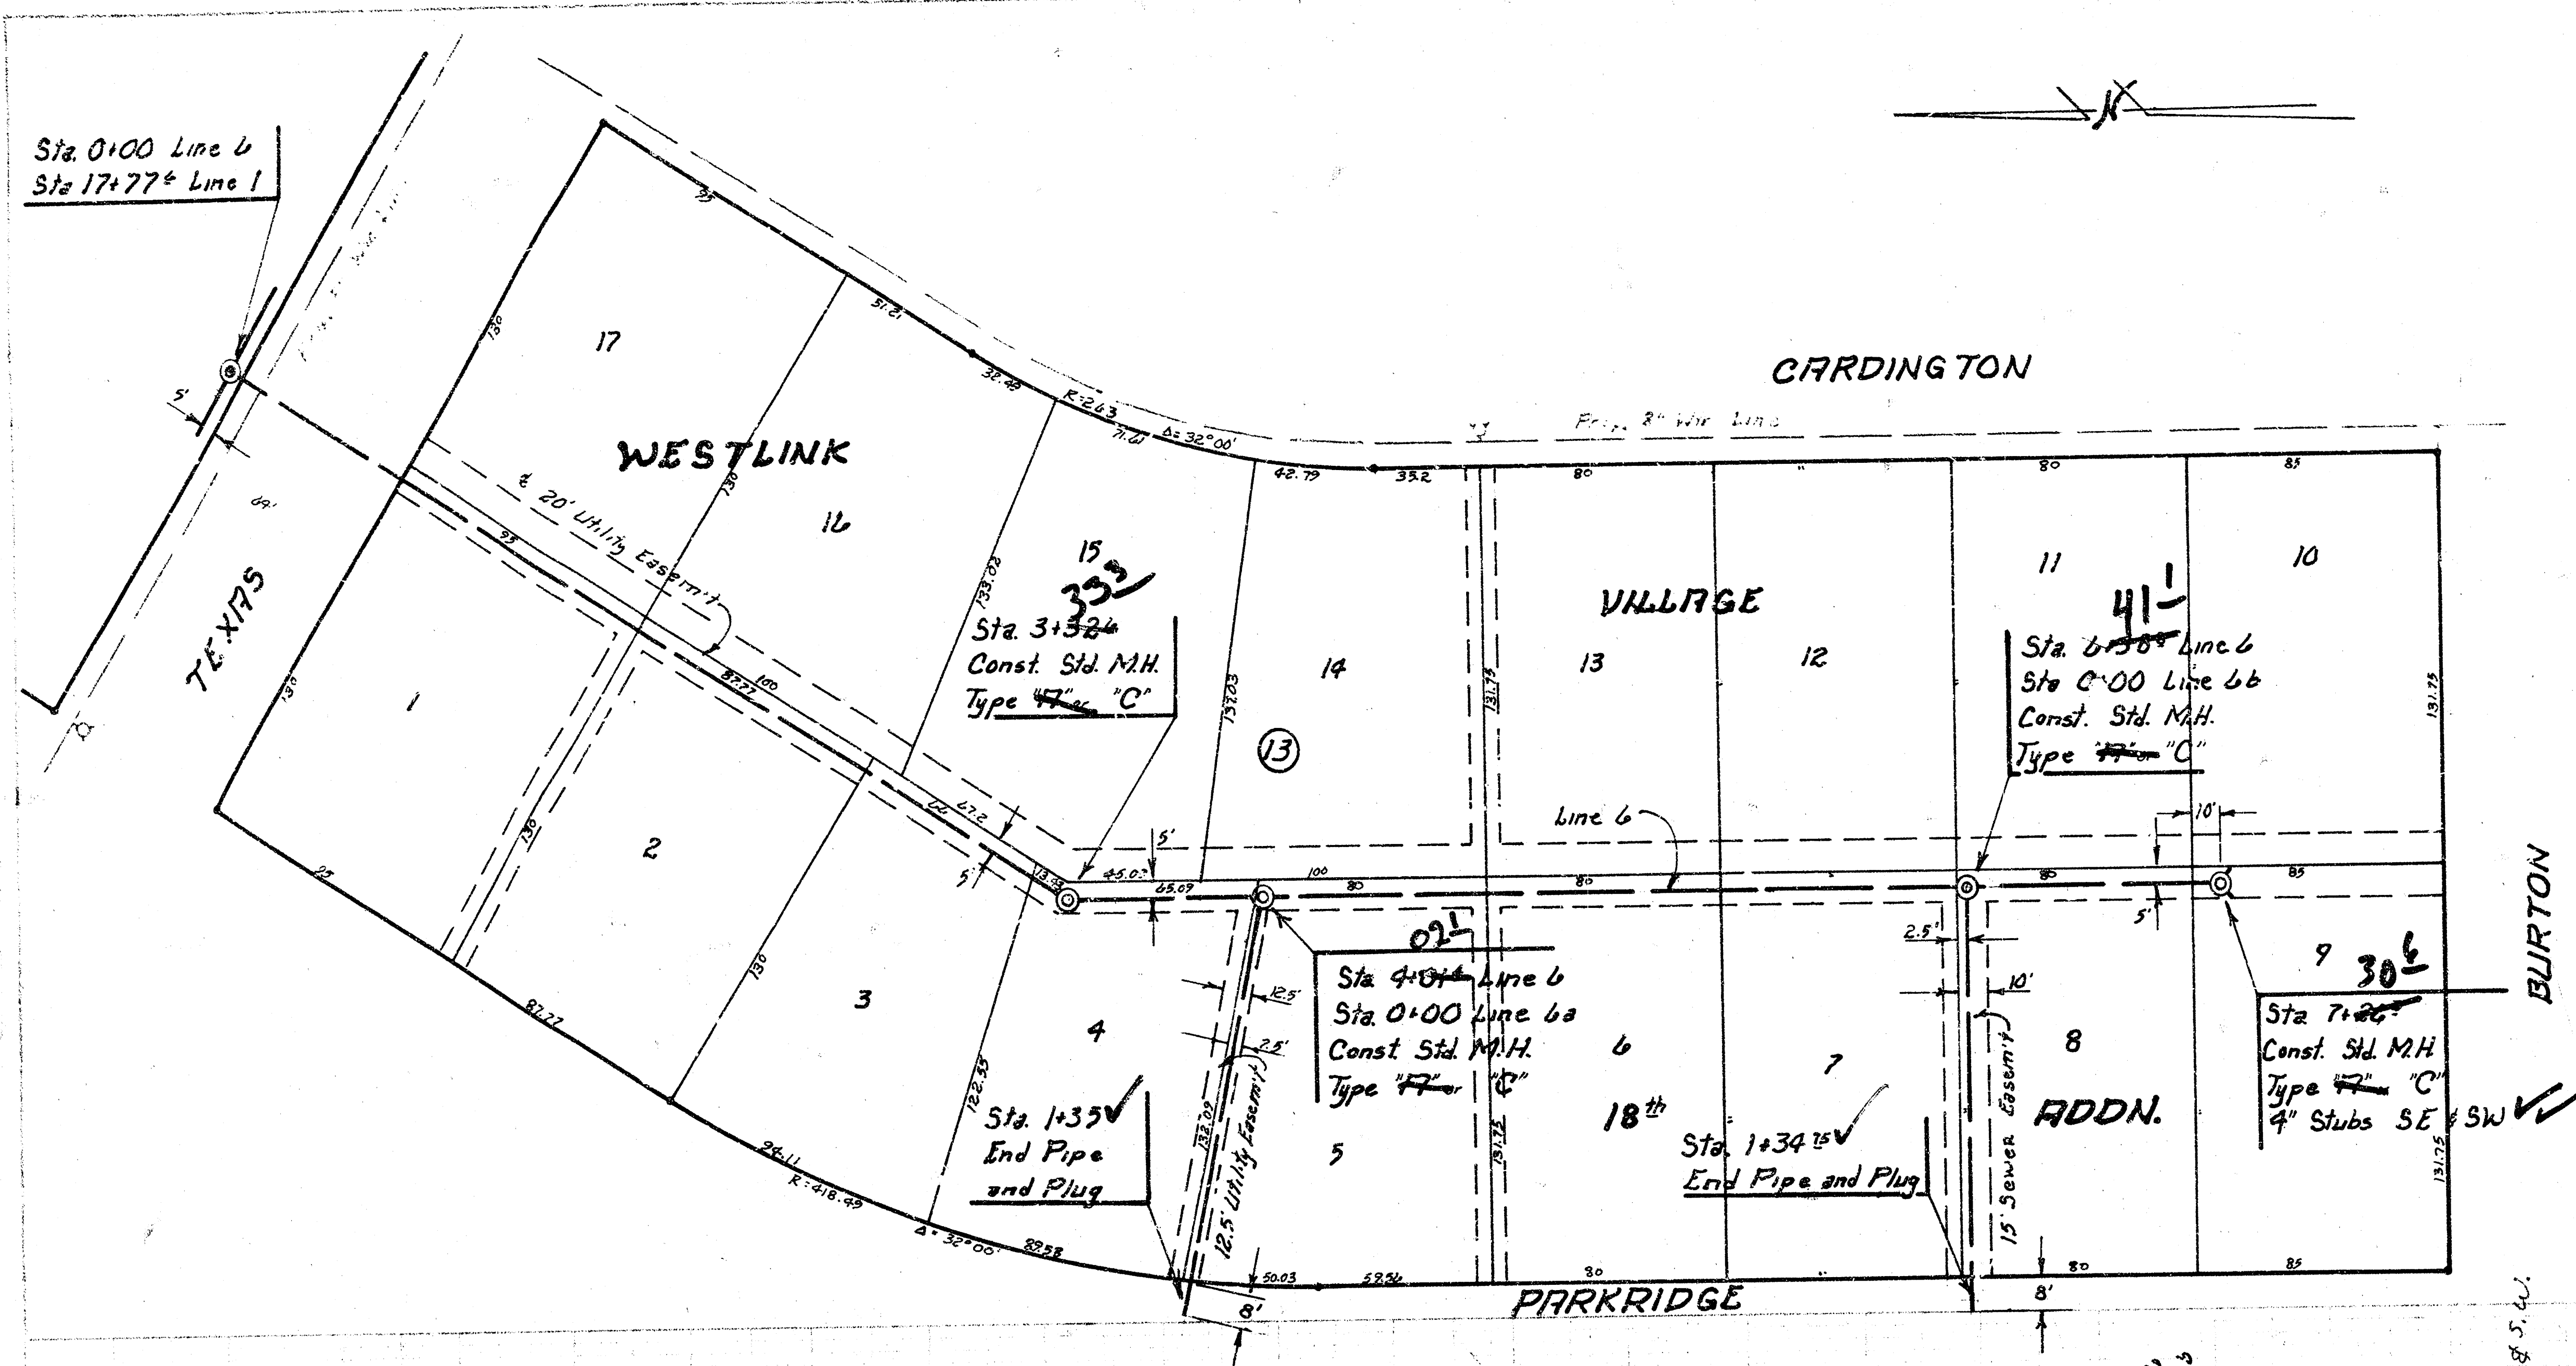

Scale
 Plan 1" = 40'
 Profile
 Horiz. 1" = 90'
 Vert. 1" = 5'

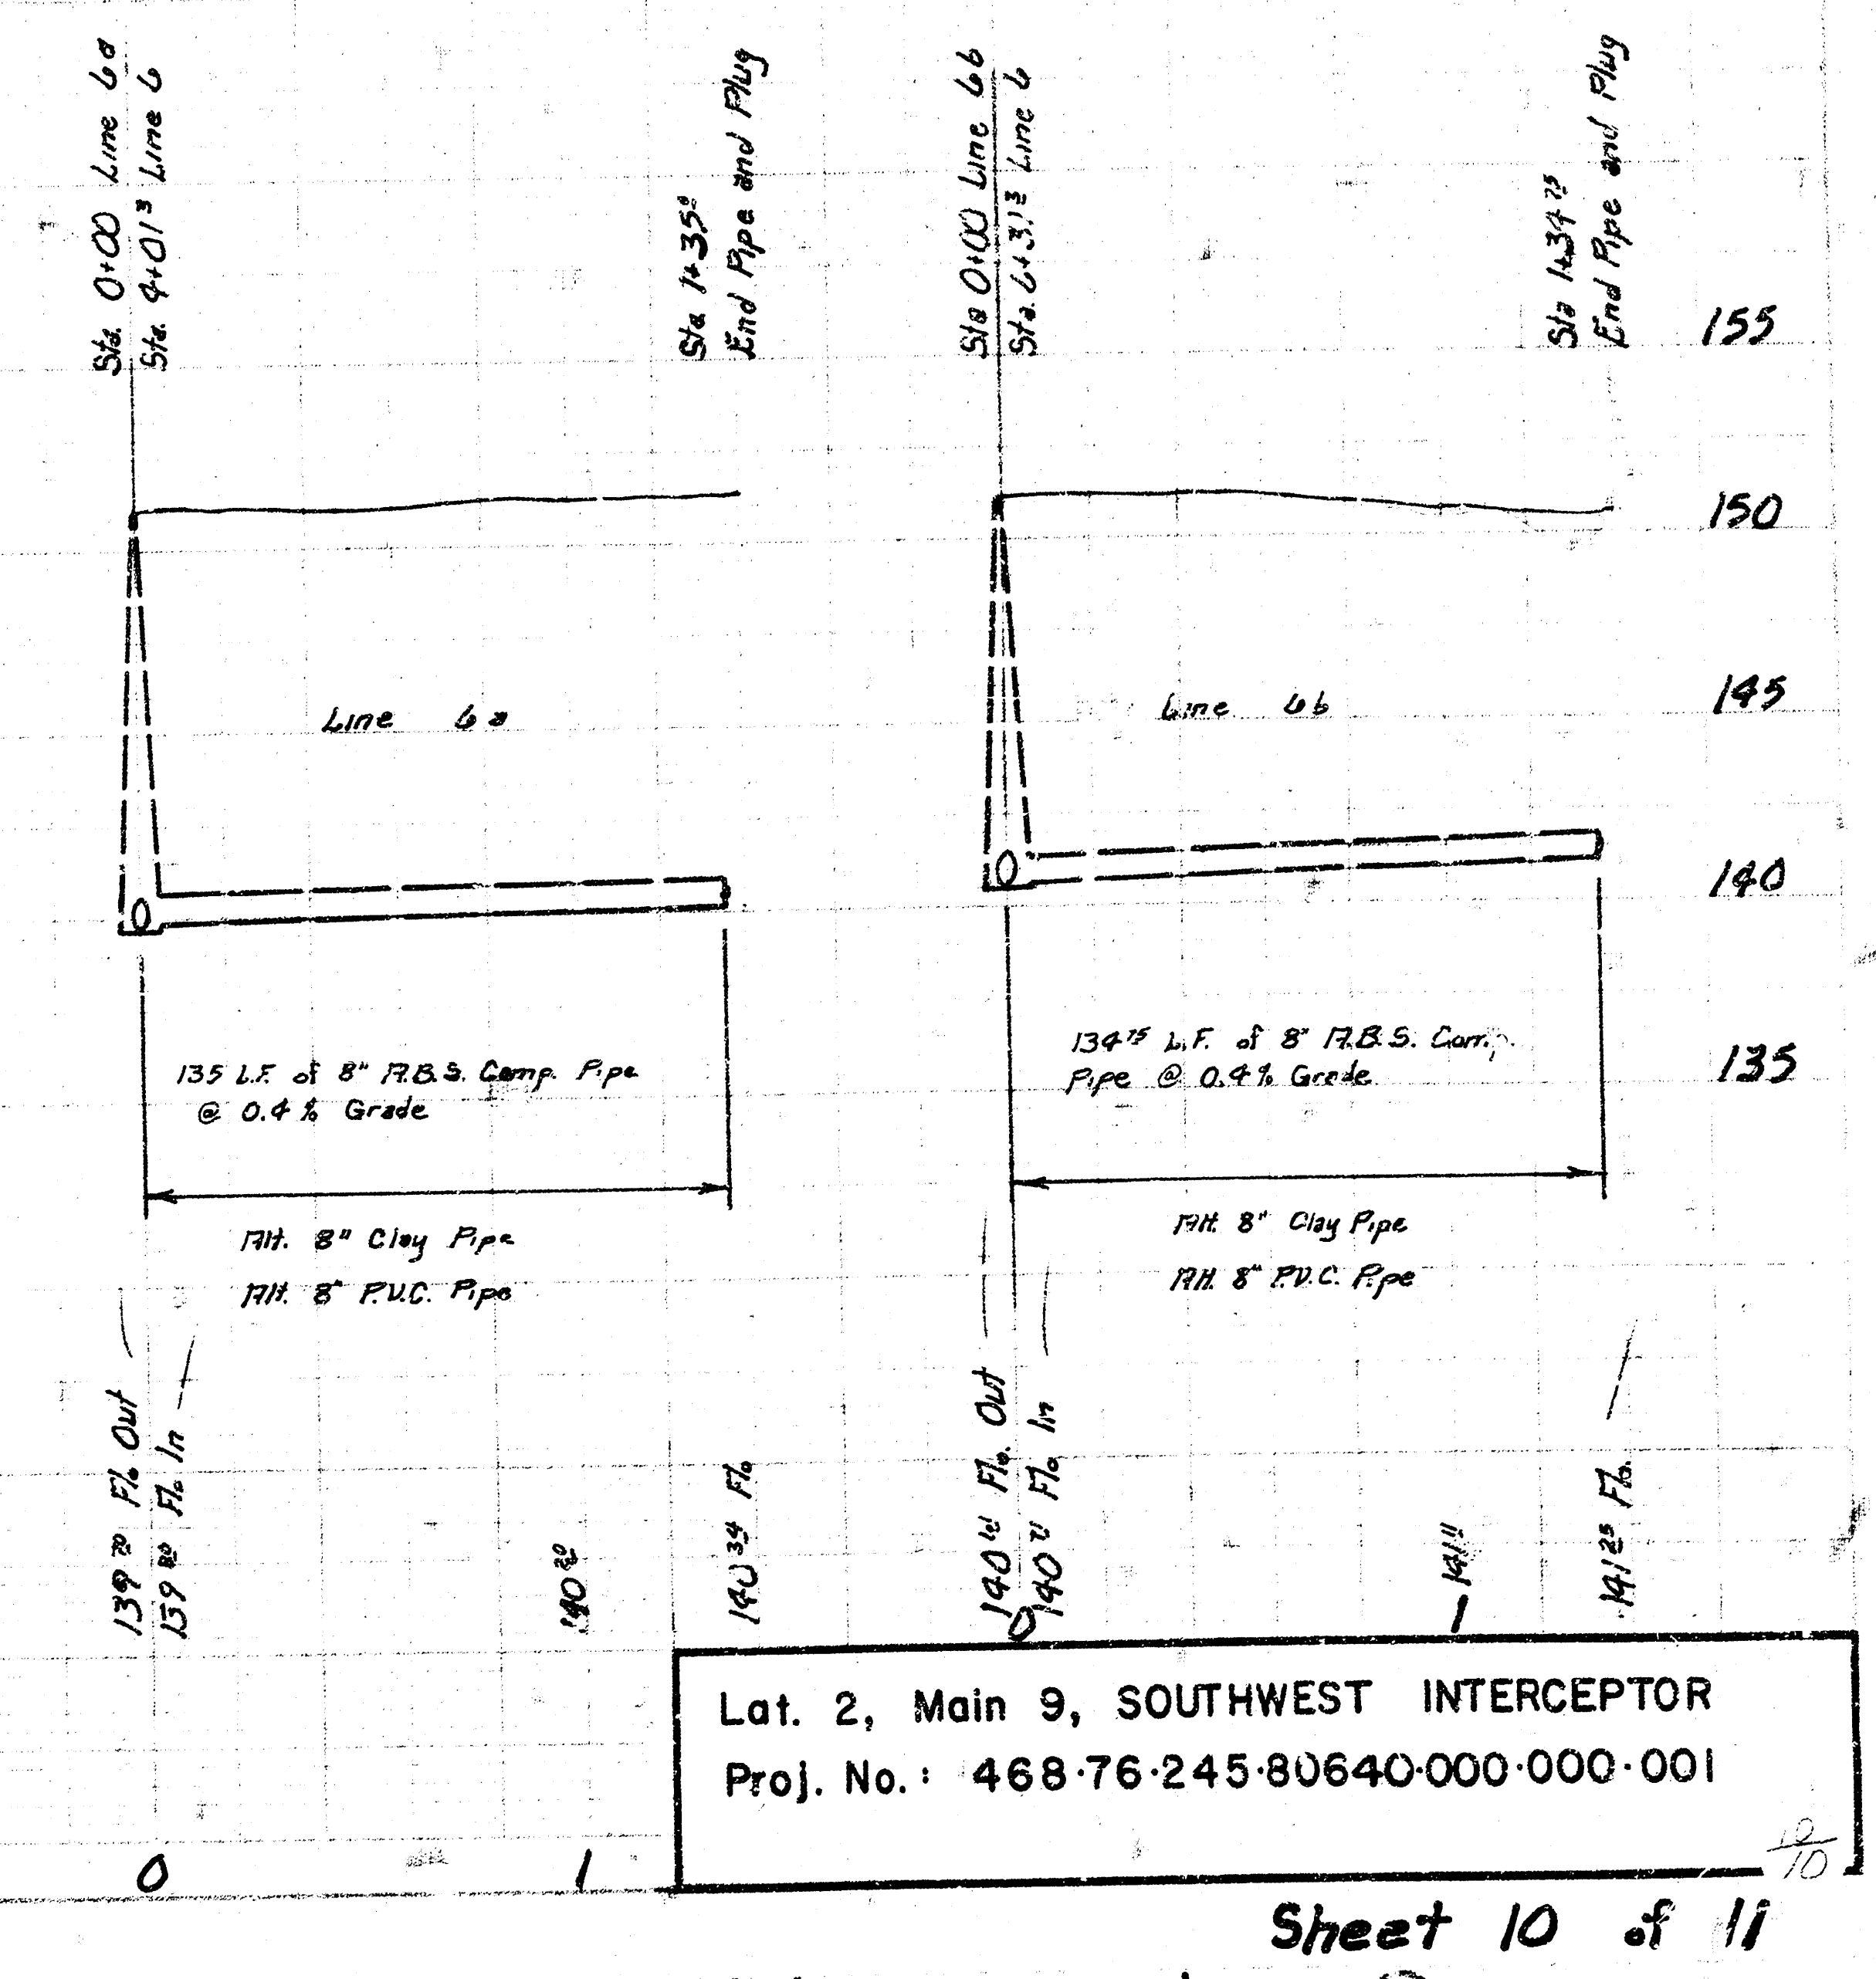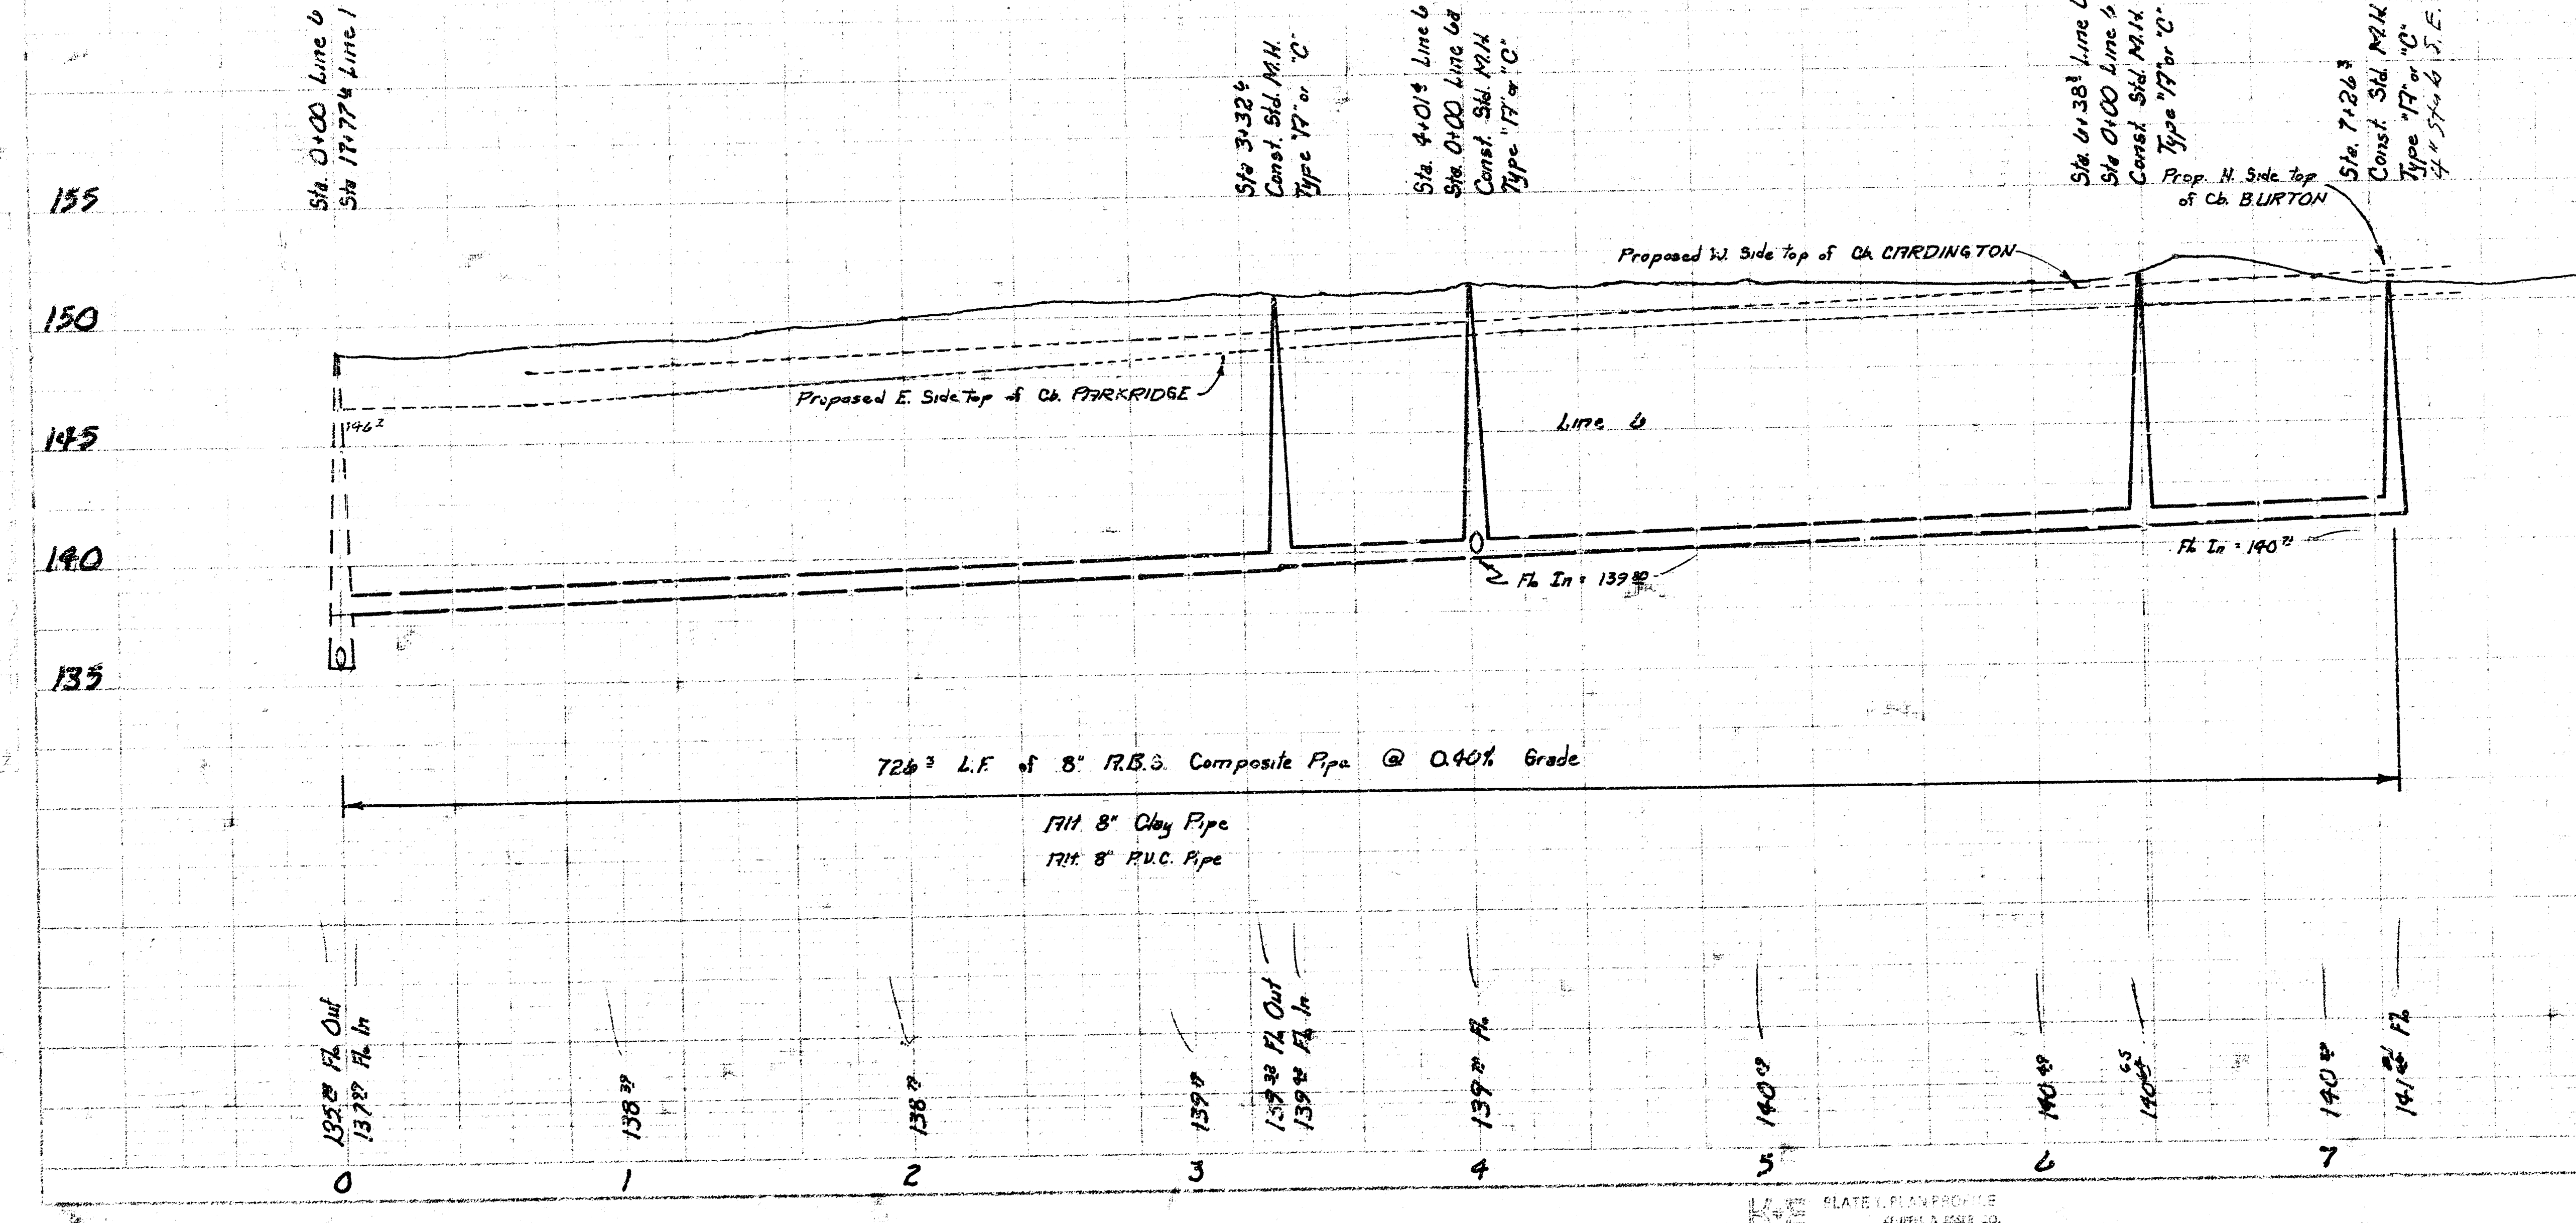

Lat. 2, Main 9, SOUTHWEST INTERCEPTOR
 Proj. No.: 468-76-245-80640-000-000-001