


K. Whitcomb
Loomis

AN-2



Scale Plan 1" = 40'
 Profile 1" = 40' Horz.
 1" = 5' Vert.

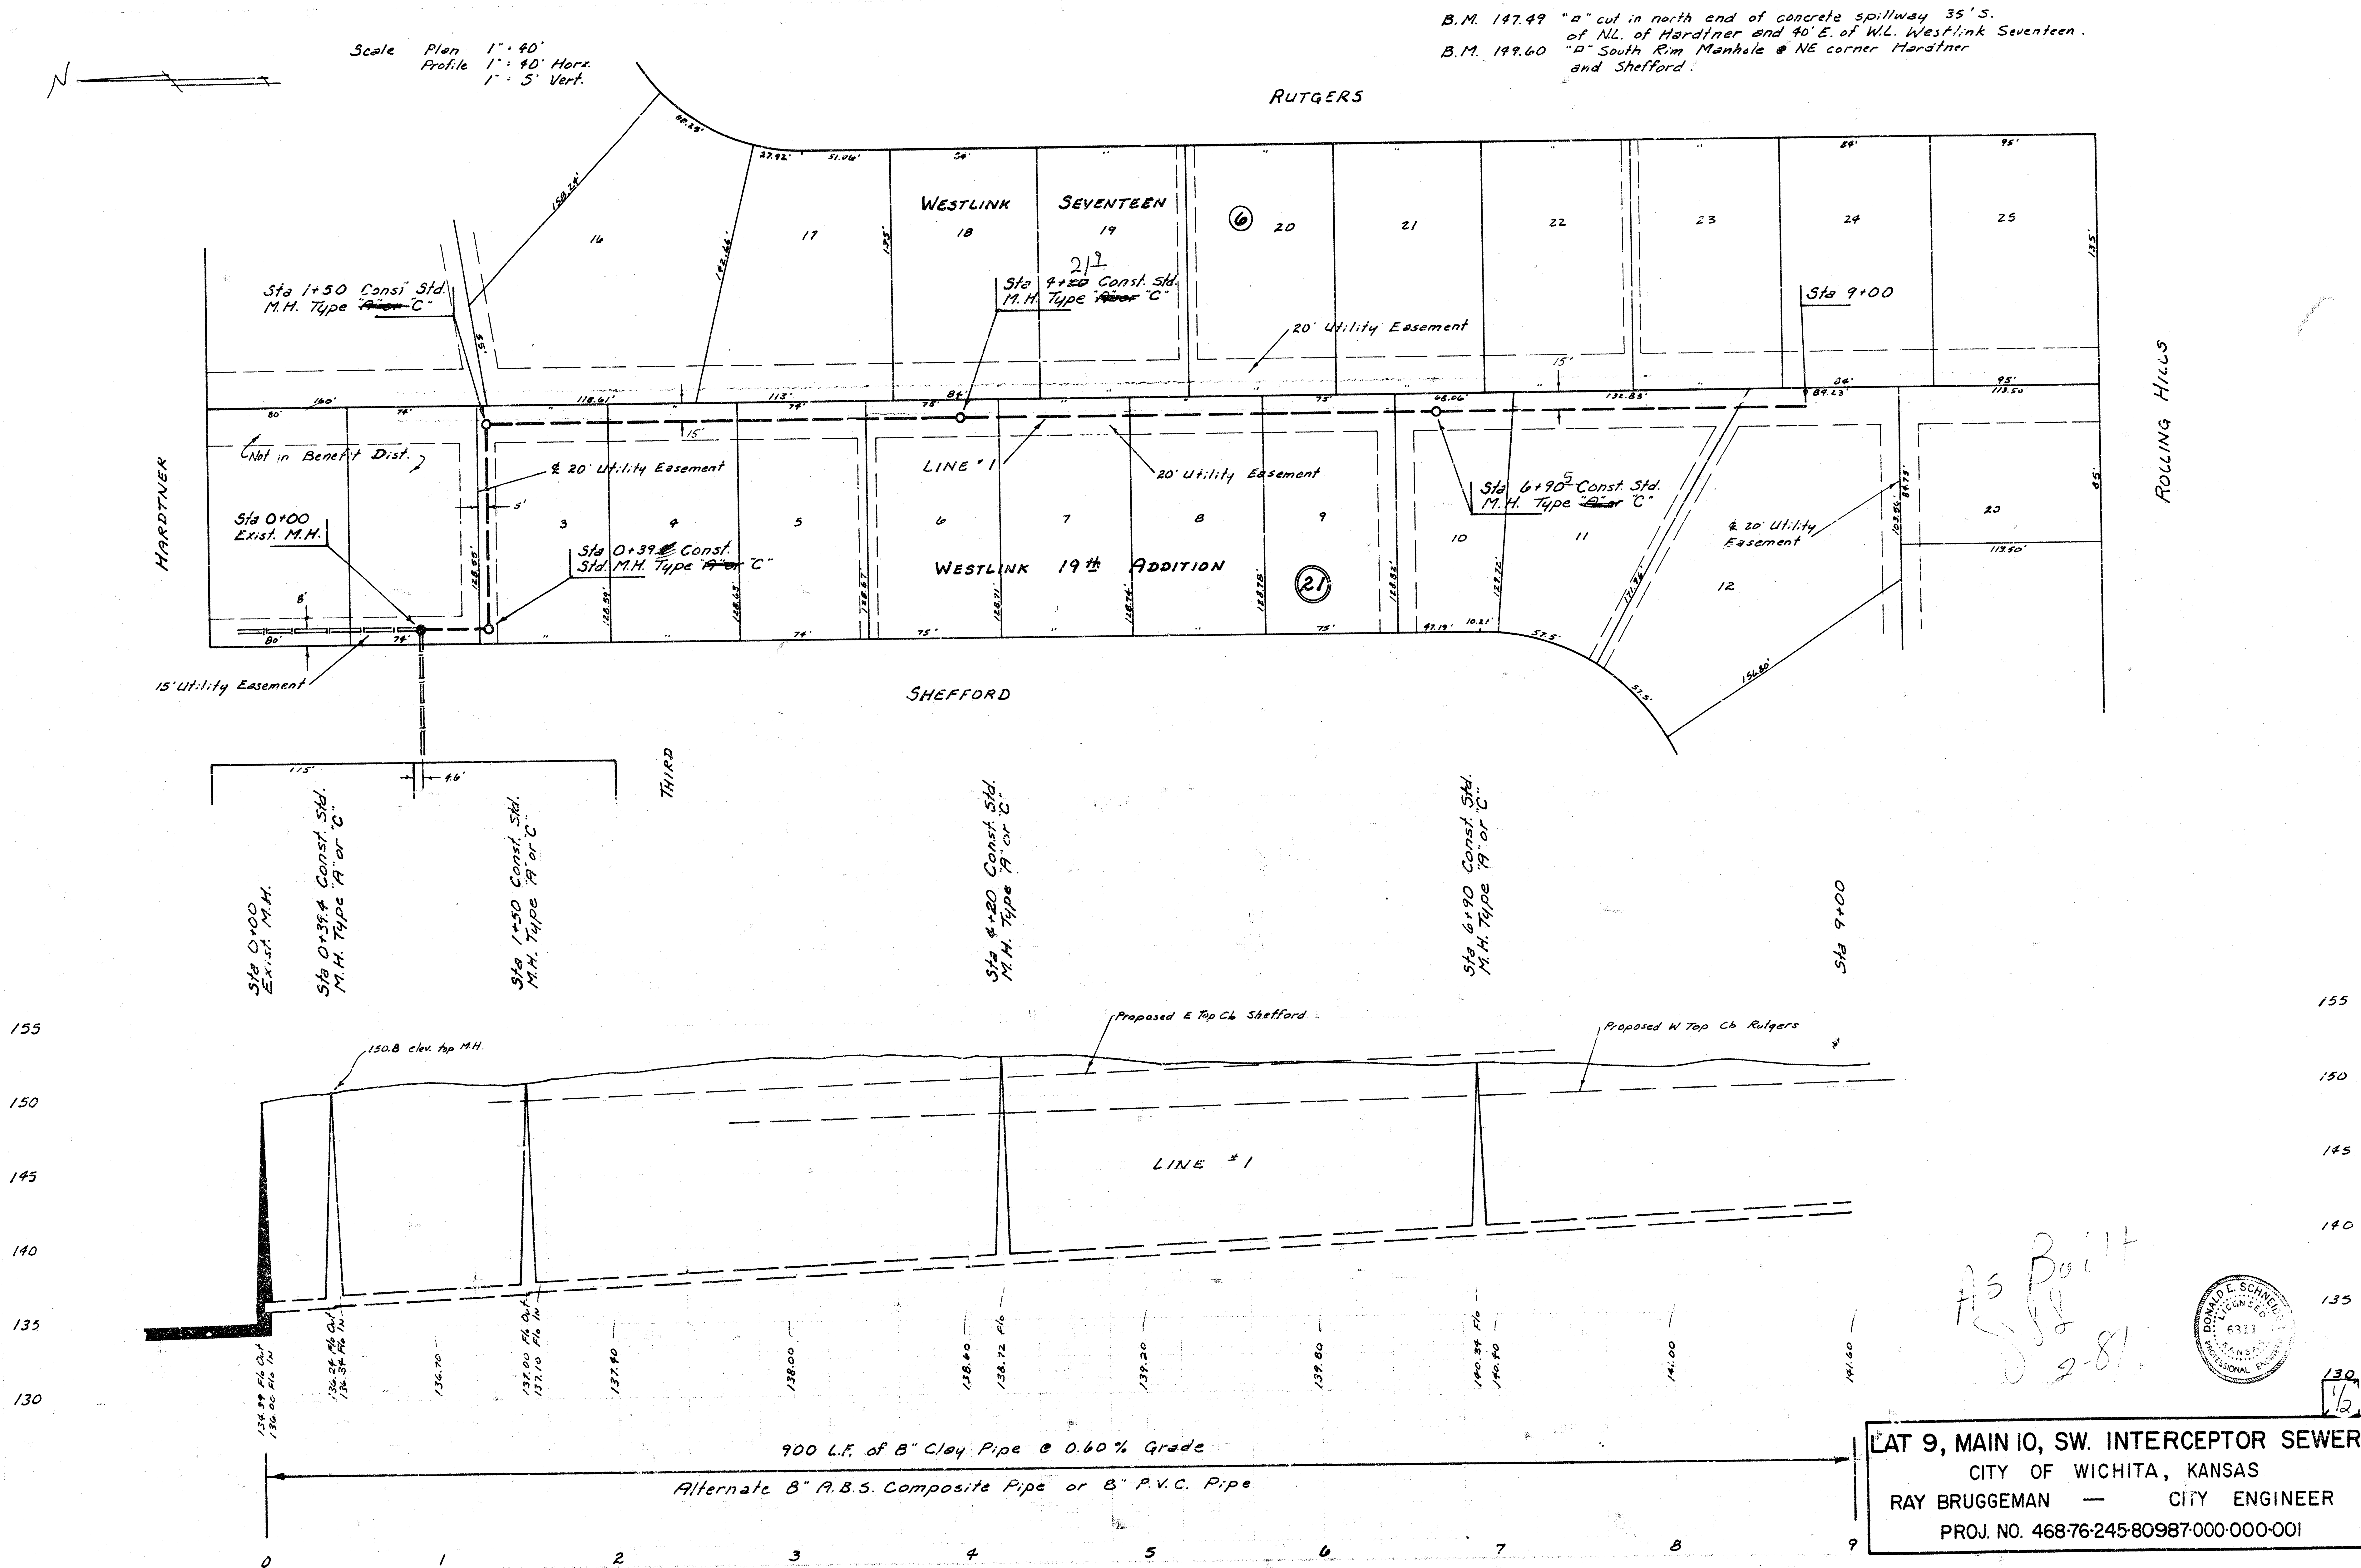