

SANITARY SEWER EXTENSION
TO SERVE
PRAIRIE PARK 2ND ADDITION

Lateral 5, Main 11, S.W.I. Sewer
Project Number

468-76-245-81107-000-000-001

CITY OF WICHITA


MICHAEL E. LINDEBAK CITY ENGINEER

Index Code

741785

General Notes

1. Underground utility service lines and overhead utility pole lines are to be adjusted as necessary by others prior to construction unless the plans specifically call for their adjustment by the Contractor or unless the plans specifically identify a utility to be adjusted by its owner during construction. Existing utilities and their location, as shown on the plans, represent the best information obtainable for design. The Contractor will be required to work around existing utilities within the right-of-way which do not conflict with proposed construction.
2. The Contractor shall be responsible for preserving property irons. The Contractor will be required to re-establish any property irons which are damaged or destroyed by his construction operations. Such irons shall be re-established by a licensed land surveyor in accordance with state laws.
3. All disturbed areas shall be seeded with rye-grass per city specs.
4. Contractor shall grade the sanitary sewer alignment to the profile and elevations shown on the easement grading plan. All costs for grading shall be subsidiary to the project.

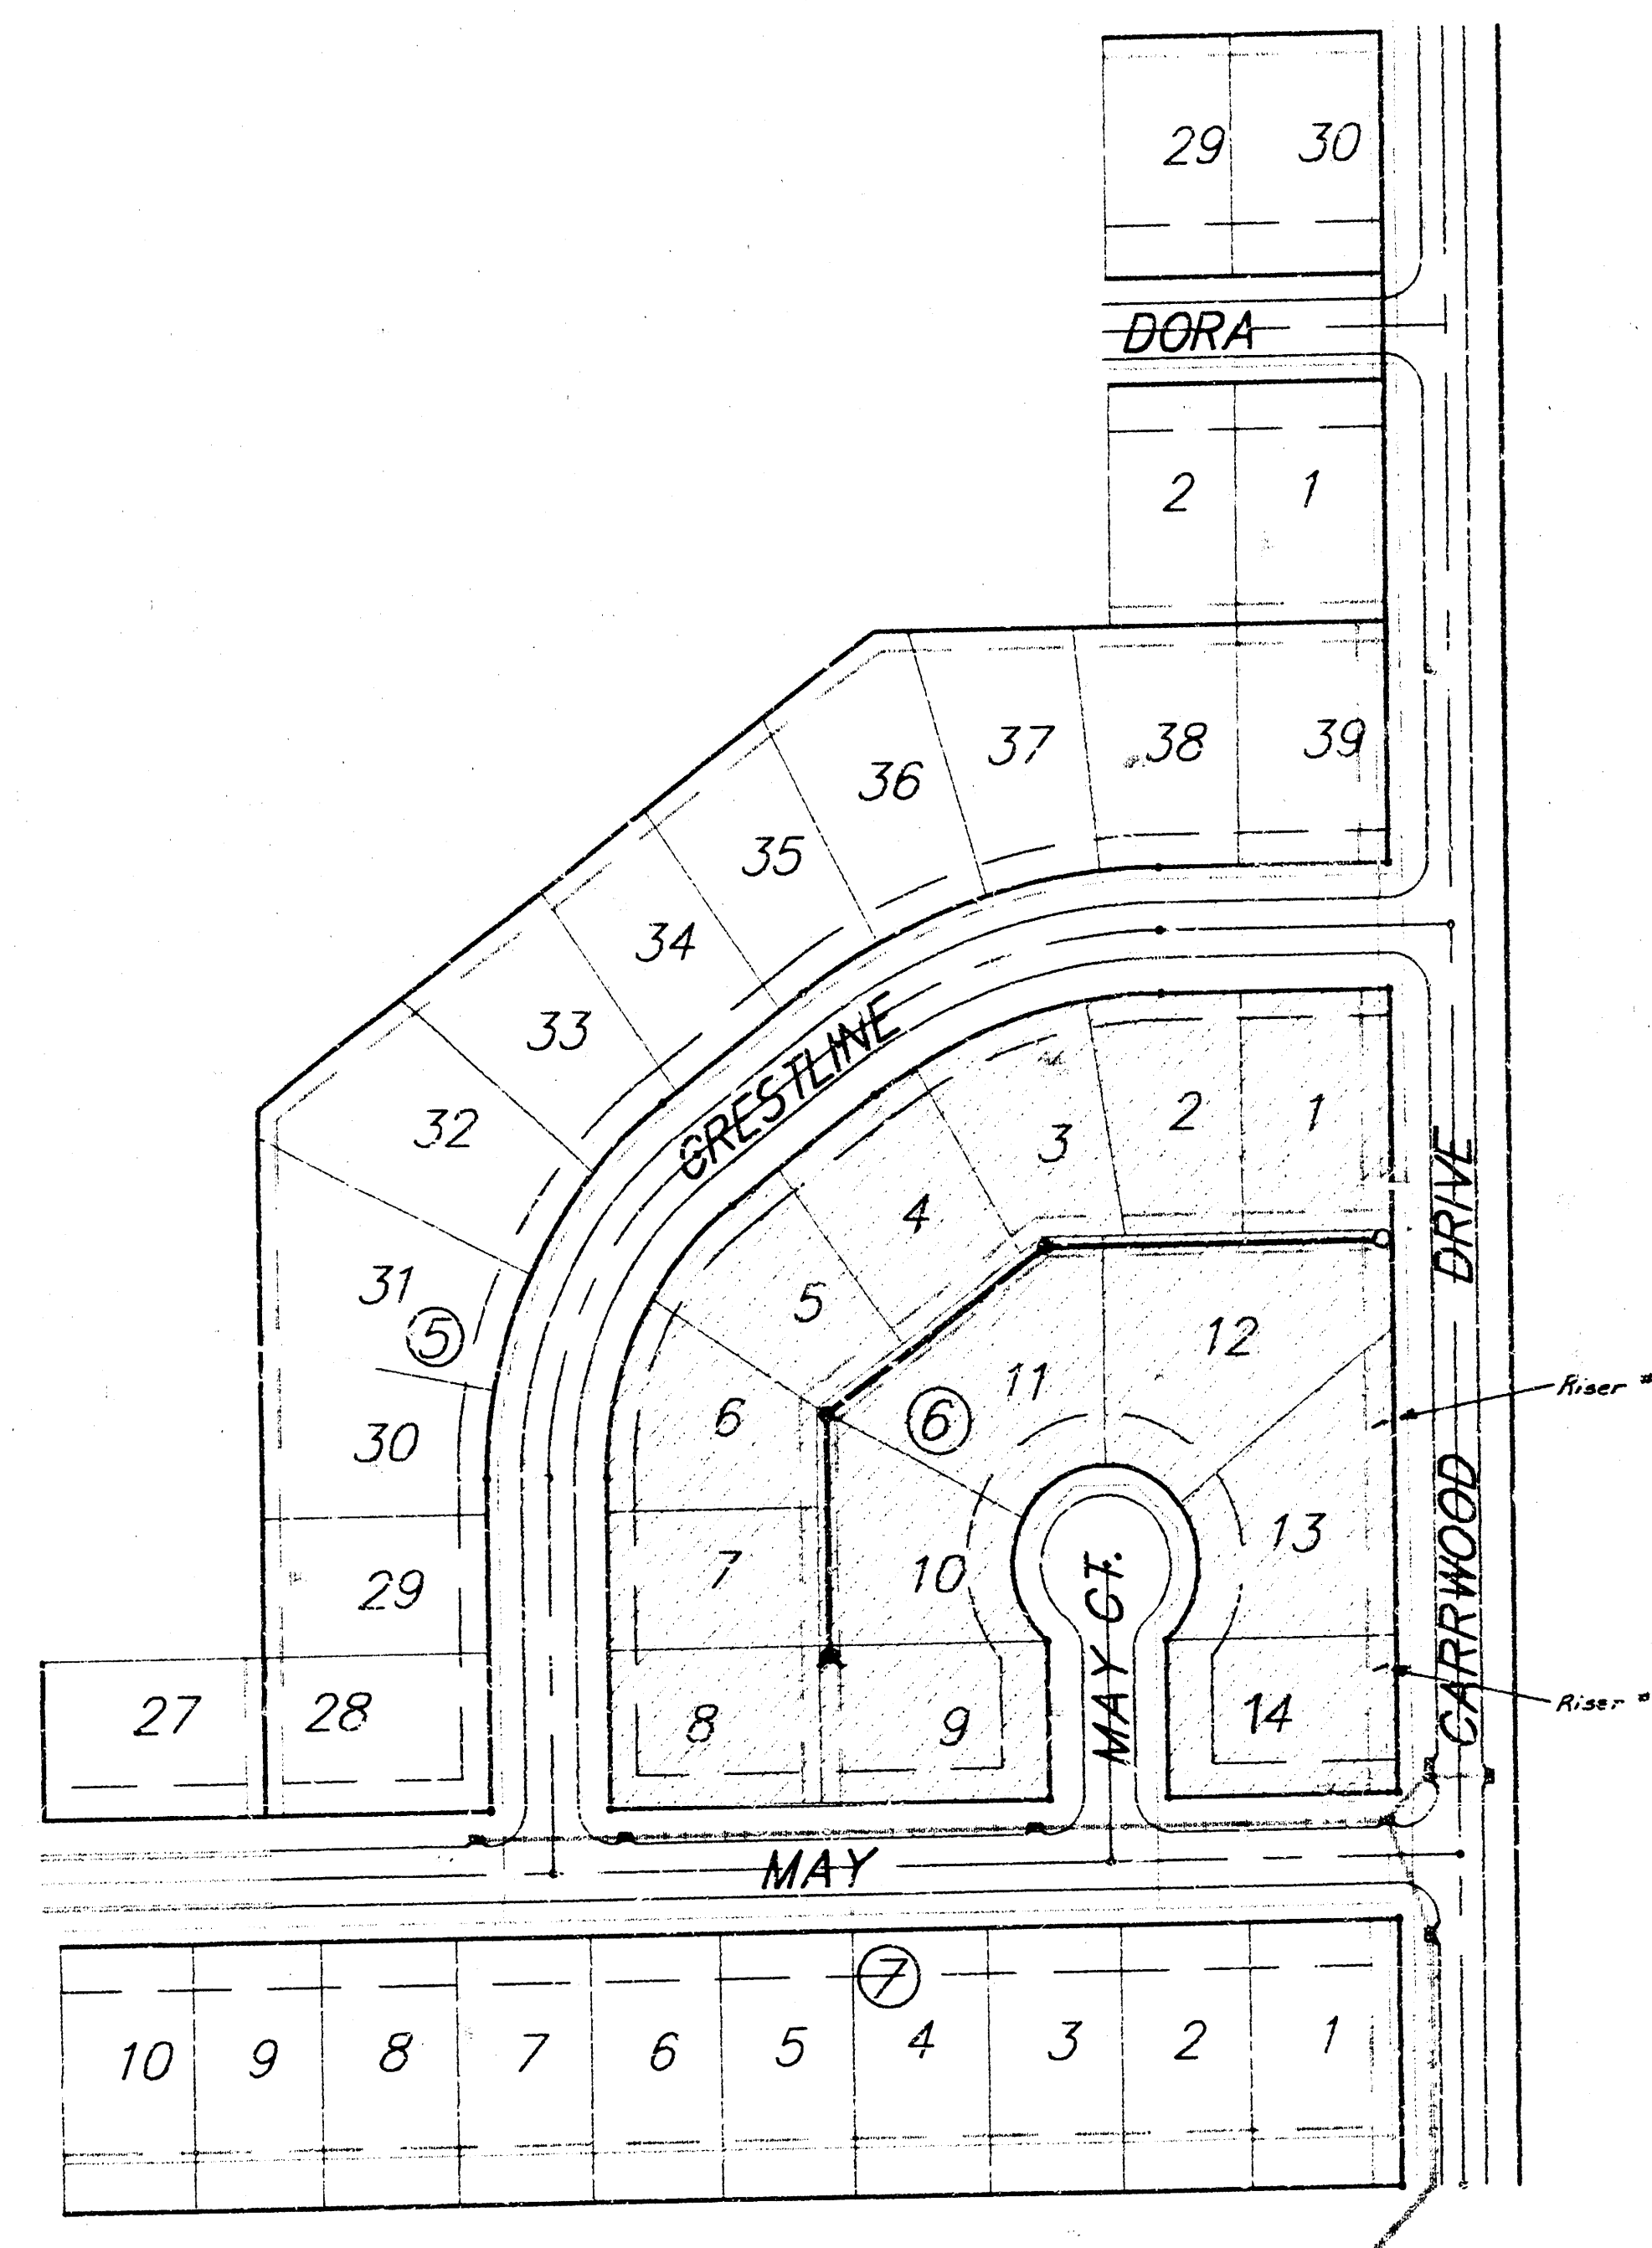

Benchmarks:

- BM#1. " " Cut on top of curb approx.
10' W and 15' S of SW corner of
Lot 28, Blk 5, Prairie Park 2nd Addition.
Elev. = 131.24 City Datum
- BM#2. " " Cut on top of curb approx.
10' N and 15' E of the NE corner of
Lot 39, Blk 5, Prairie Park 2nd Addition.
Elev. = 131.62 City Datum

Index of Sheets


Title Sheet	1
Plan/Profile	2
Typical Details	3
Plat of Prairie Park 2nd Addition	4

Booked 9-1-94
CKB
As Per Plan





Benefit District -

BAUGHMAN COMPANY P. A.
ENGINEERING & SURVEYING
316/262-7271 • 315 ELLIS • WICHITA, KANSAS 67211

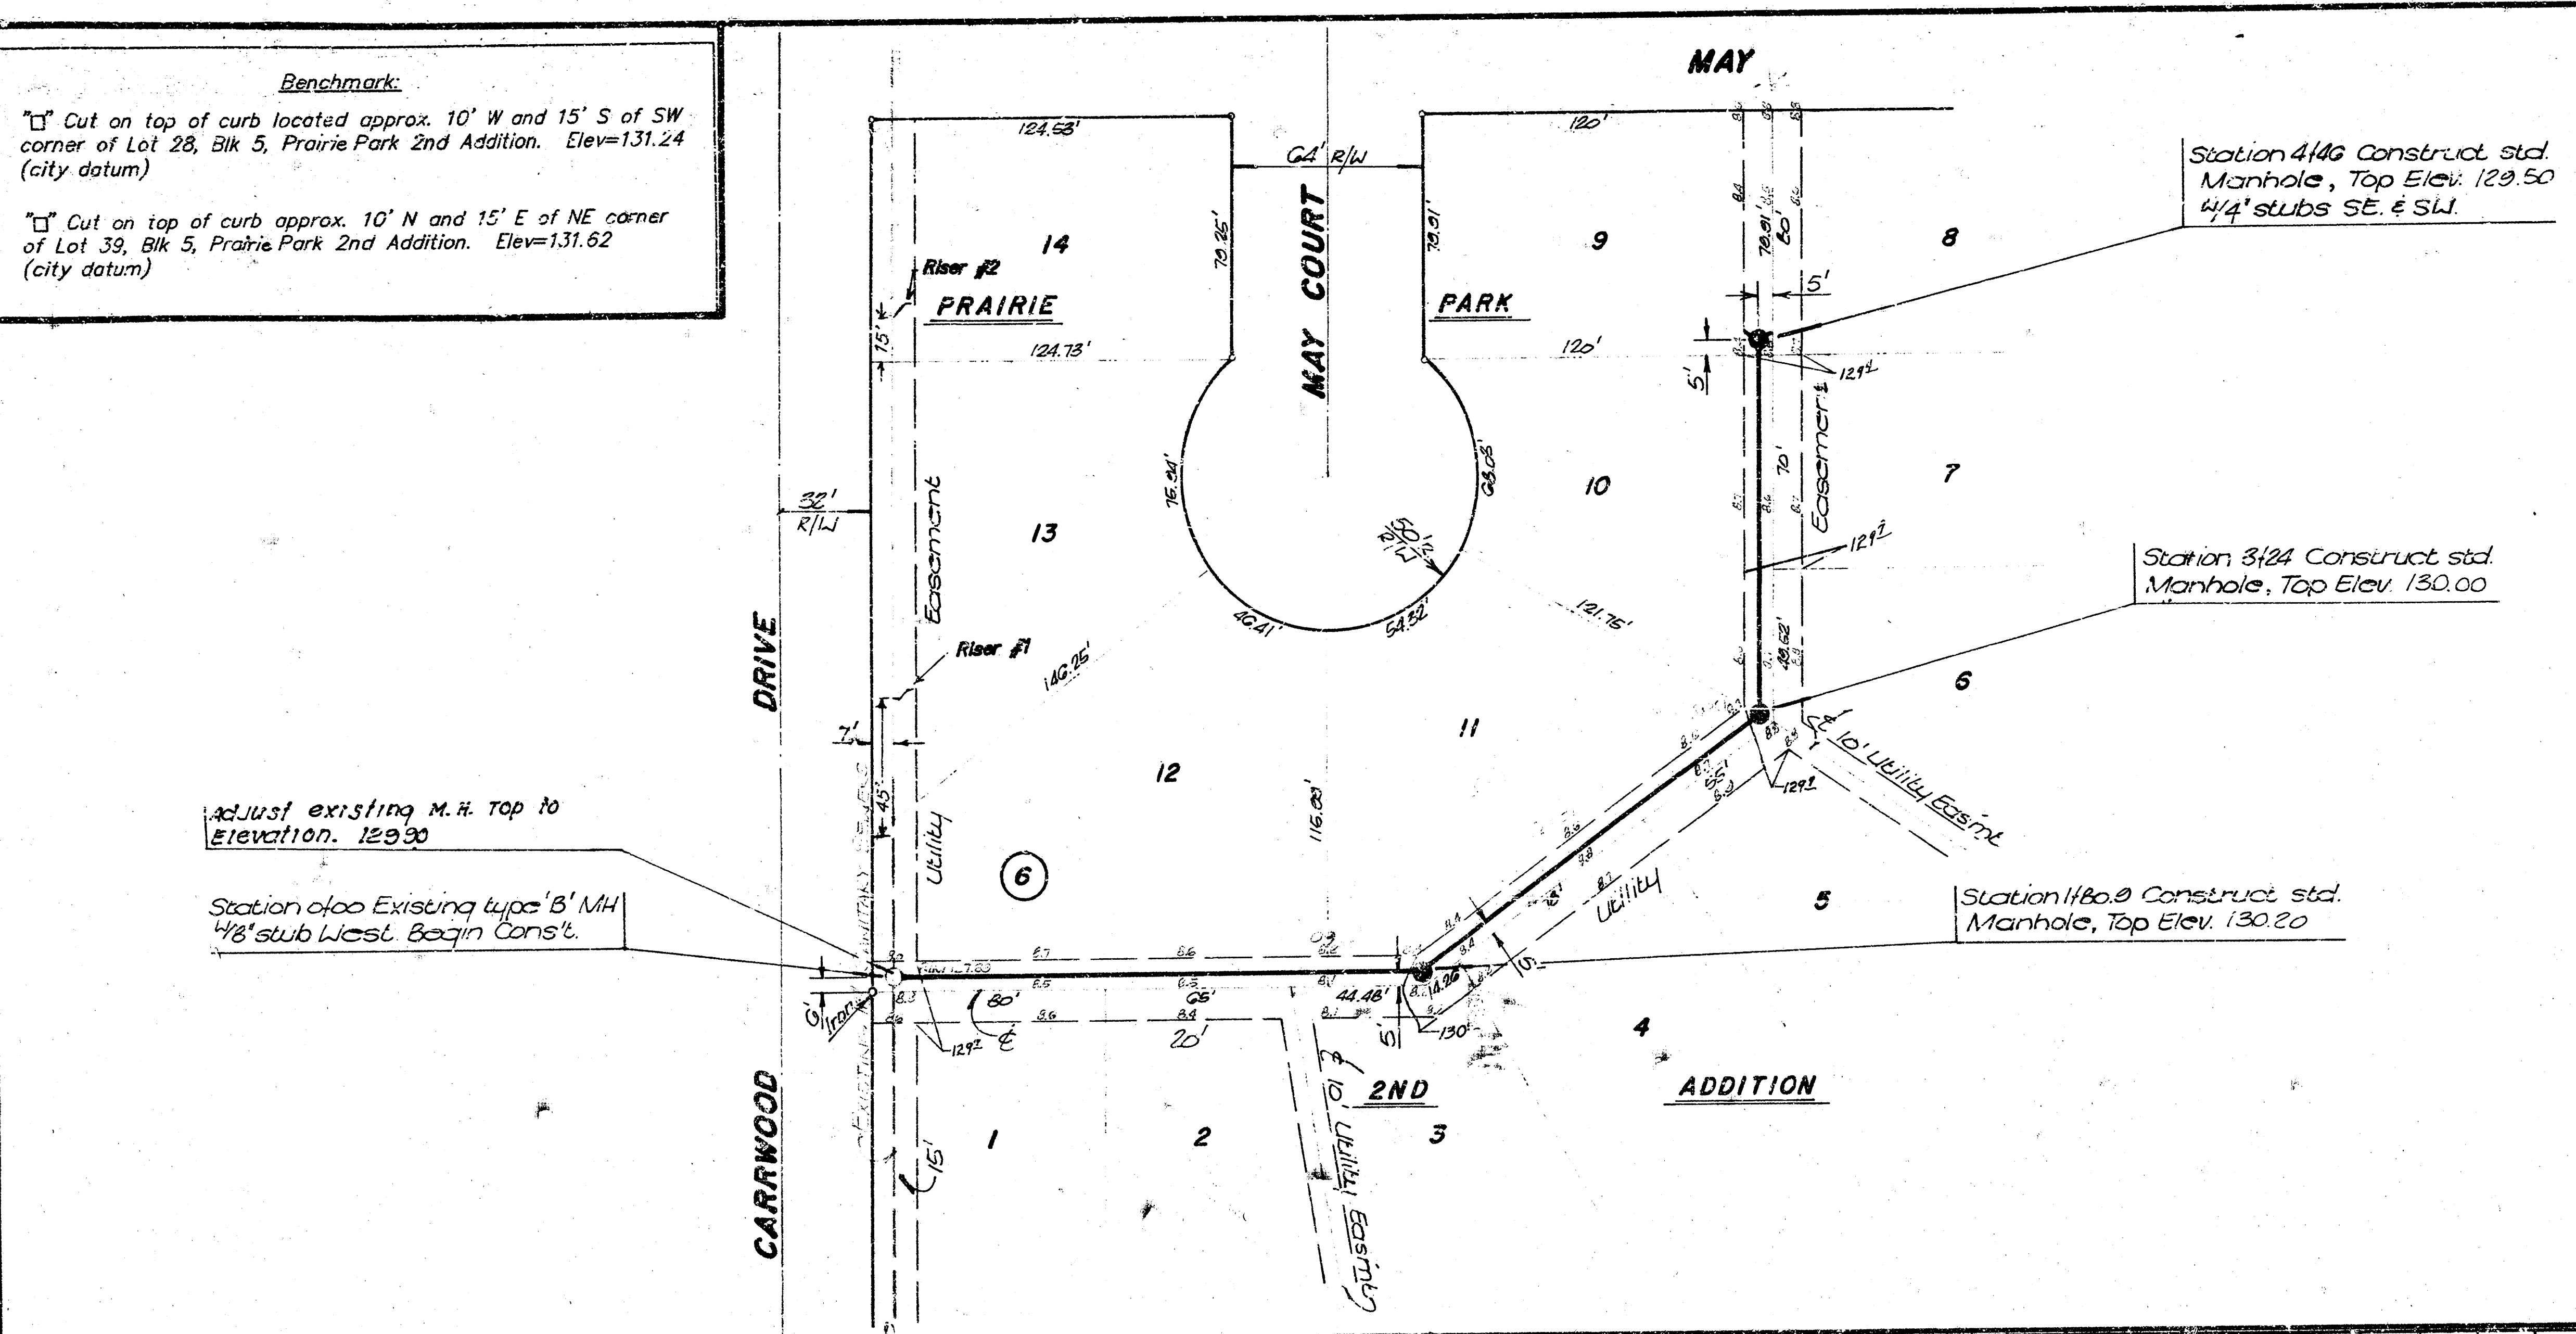

RISER LOCATION TABLE

NUMBER	LOT	DIRECTION	L.F. 4" RISER	TOP ELEV.
1	13	WEST	10.5'	121.9
2	14	WEST	10.0'	121.5

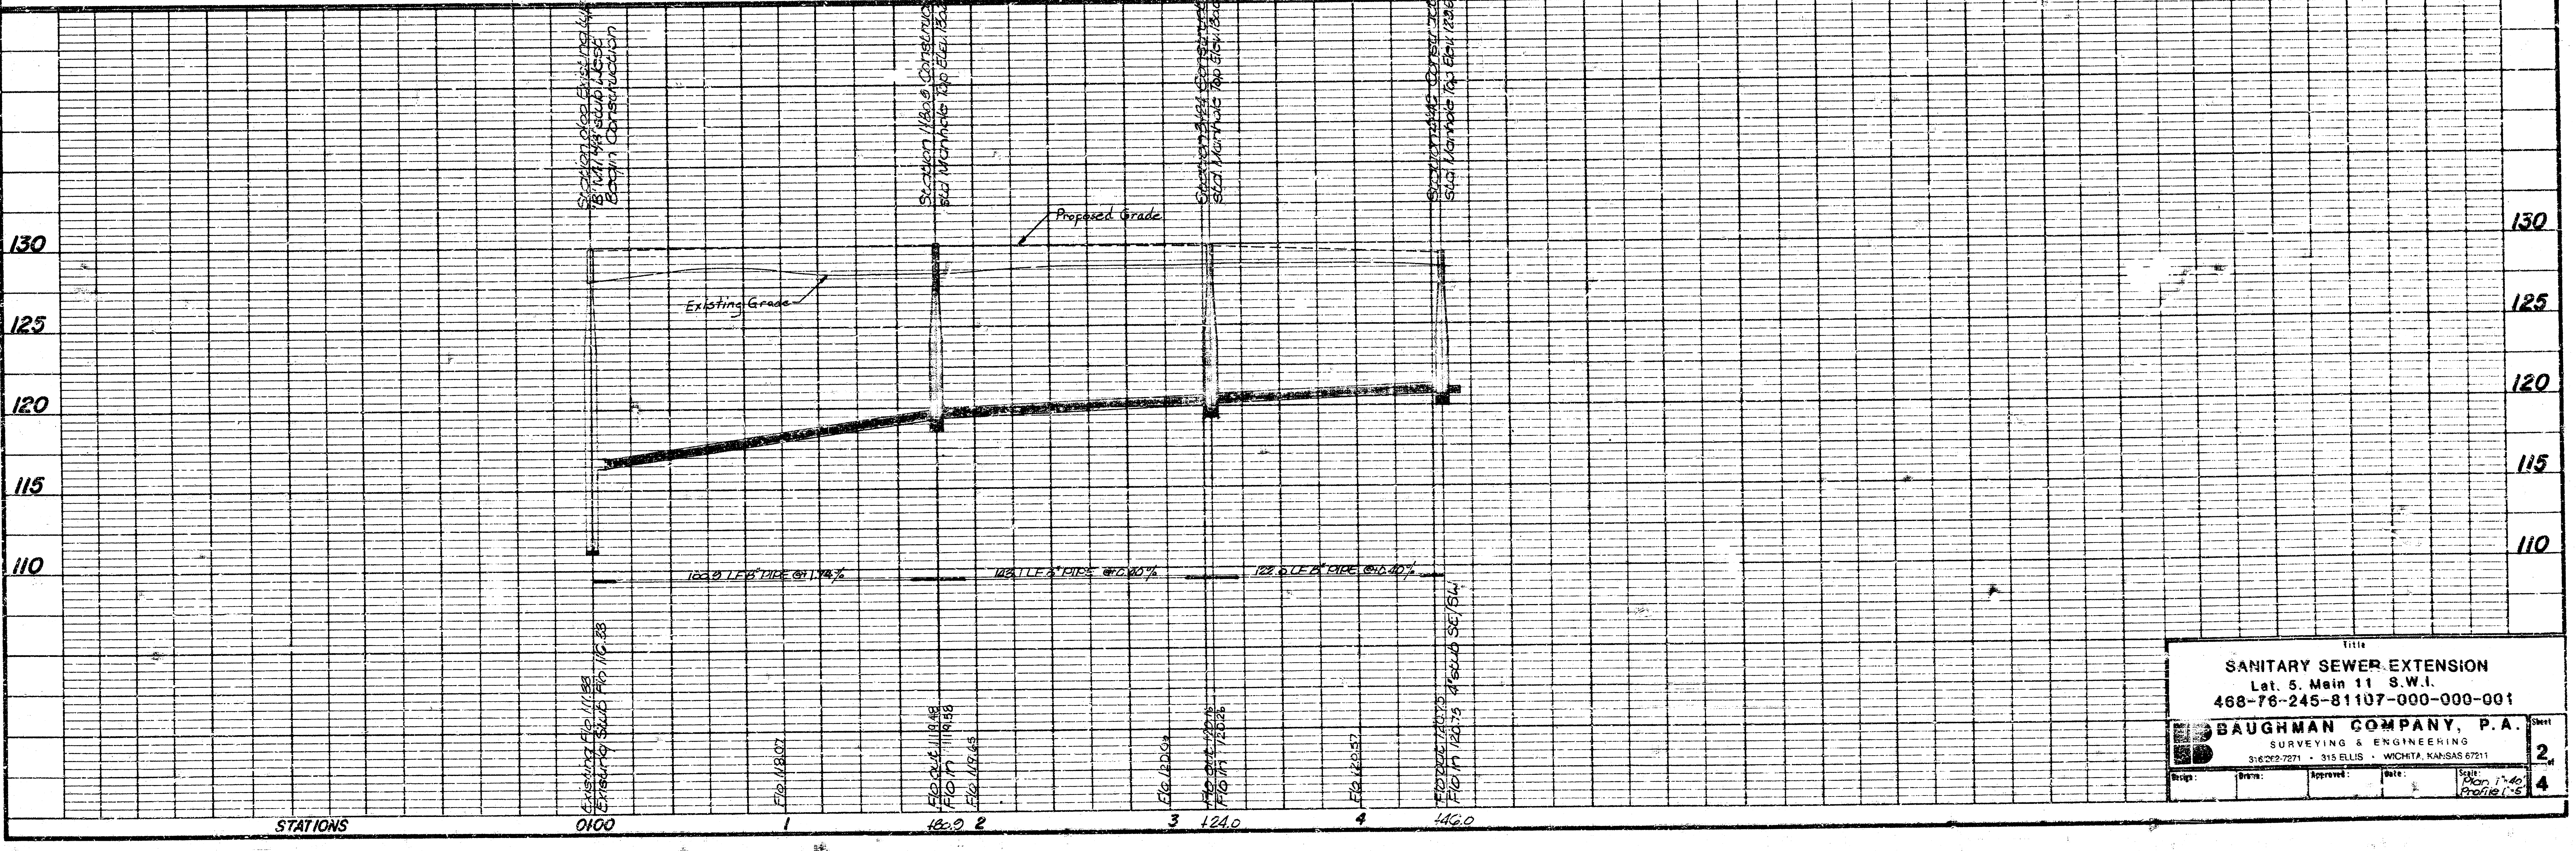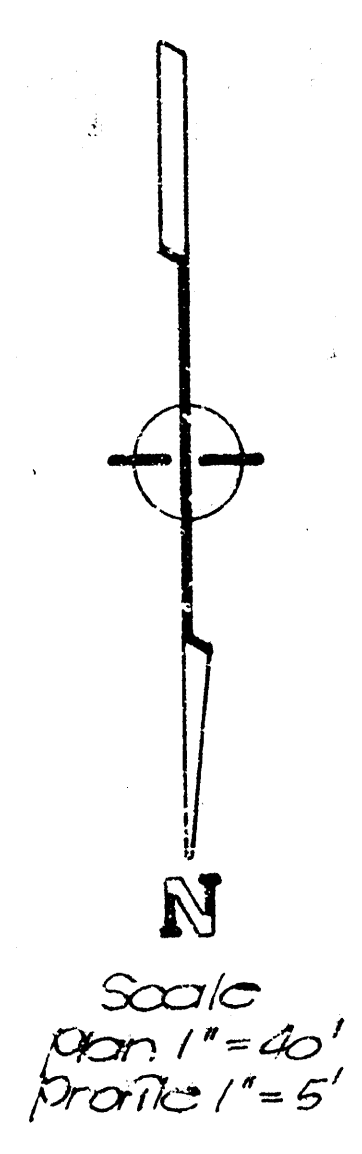

SANITARY SEWER EXTENSION
 Lot. 5, Main 11 S.W.1.
 468-76-245-81107-000-001


BAUGHMAN COMPANY, P.A.
 SURVEYING & ENGINEERING
 316029-7271 • 315 ELLIS • WICHITA, KANSAS 67211

Sheets: 2, 4

DATE: 8/27/14
 BY: [Signature]
 CHECKED: [Signature]
 SURVEYED: [Signature]
 NOTE BOOK: [Signature]
 NO. 281/02 THROUGH SOLUTIONS CHECKS



SEWER APPURTENANCES DETAILS

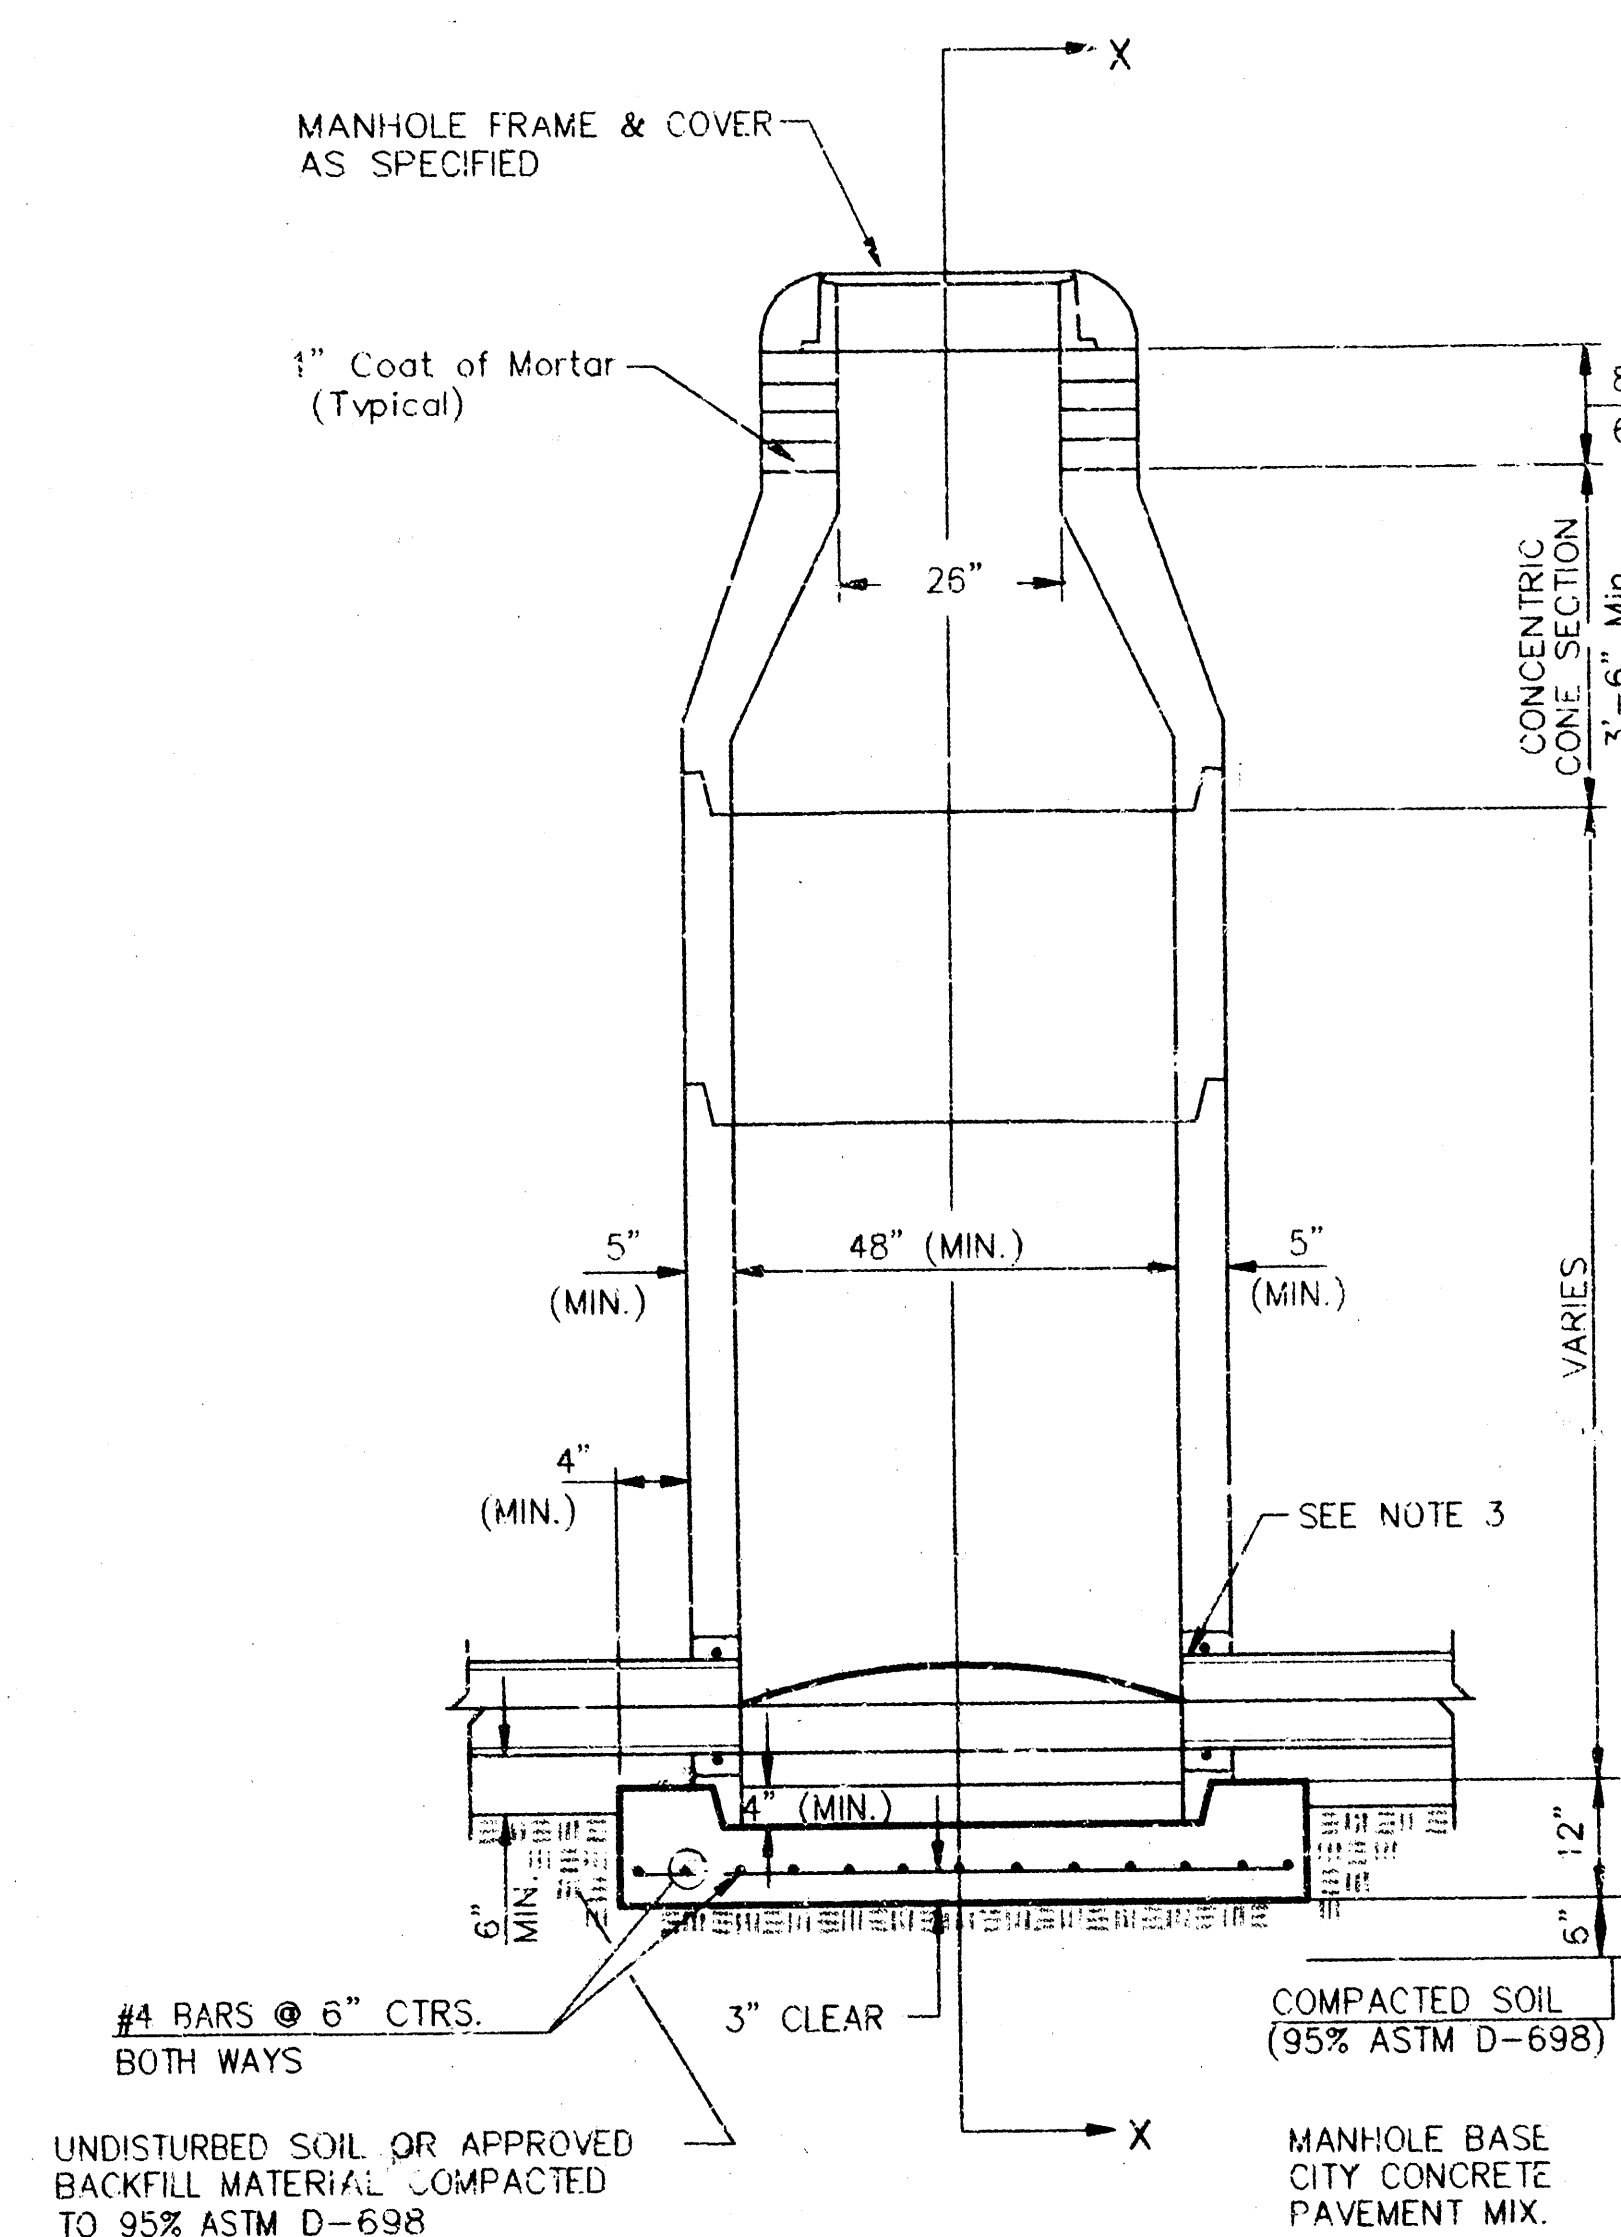

**TYPE P
STANDARD MANHOLE**


GENERAL NOTES PRECAST MANHOLE NOTES

- ALL PRECAST CONCRETE MANHOLE SECTIONS SHALL CONFORM TO THE LATEST REVISIONS OF A.S.T.M. C478 AS MODIFIED BY THE SPECIFICATIONS.
- NON-SHRINK GROUT SHALL BE NON-METALLIC TYPE.
- APPROVED FLEXIBLE WATERSTOP GASKETS SHALL BE INSTALLED TO JOIN THE SEWER TO THE MANHOLE WALL WHEN A.B.S. COMPOSITE PIPE OR P.V.C. PIPE IS USED. FOR OTHER TYPES OF PIPE THE SEWER PIPE SHALL BE GROUDED IN PLACE WITH NON-SHRINK GROUT. THE SEWER PIPE SHALL BE SUPPORTED WITH CONCRETE ENCASUREMENT A MINIMUM OF 3 FEET FROM THE MANHOLE WALL AND TO THE FIRST JOINT FOR V.C.P. SUCH THAT THE JOINT REMAINS FLEXIBLE.
- ALL INSIDE SURFACES OF THE CONCRETE MANHOLE WHICH WOULD BE EXPOSED TO SEWER GAS SHALL BE COATED WITH 2 COATS TENECS SERIES 66 HI-BUILD EPOXYLINE, DRY THICKNESS OF 3 MILS (MIN.).
- EXTERIOR MANHOLE WALLS SHALL BE COATED WITH 1 COAT MOBILARMA 633 BITUMINOUS COATING.
- JOINT SEALING COMPOUND SHALL BE KENT SEAL NO. 2 OR APPROVED EQUAL.
- PRECAST MANHOLES SHALL BE SET AT LEAST 4 INCHES INTO THE MANHOLE BASE.
- TOP OF MANHOLE FLOOR SLAB SHALL BE AT LEAST 3 INCHES BELOW THE FLOW LINE OF THE OUTLET PIPE TO INSURE SUFFICIENT MINIMUM THICKNESS OF SHAPED INVERT.
- LIFTING HOLES SHALL BE FILLED WITH NON-SHRINK GROUT AND THE INTERIOR SURFACE COATED AS SPECIFIED.
- MORTAR USED IN MASONRY CONSTRUCTION SHALL CONTAIN 8 SACKS OF CEMENT PER CUBIC YARD. CONCRETE USED IN MANHOLE BASES SHALL CONFORM TO THE REQUIREMENTS OF CONCRETE FOR CONCRETE PAVEMENT CONSTRUCTION AS SPECIFIED IN THE CITY STANDARD PAVING SPECIFICATIONS USING CITY CONCRETE PAVEMENT MIX WITHOUT AIR ENTRAINING ADMIXTURE. MORTAR SHALL BE PLACED AROUND THE MANHOLE RING AS SHOWN ON THE DRAWINGS WHEN MANHOLES ARE CONSTRUCTED IN UNPAVED AREAS. MANHOLES CONSTRUCTED WHERE PIPE SIZES ARE SMALLER THAN 24" SHALL HAVE AN INSIDE DIAMETER OF 4". MANHOLES CONSTRUCTED WHERE PIPE SIZES ARE 24" OR LARGER SHALL HAVE AN INSIDE DIAMETER OF 5". COMPLETED MANHOLE SHALL BE WITHOUT LEAKS AND WATER TIGHT.

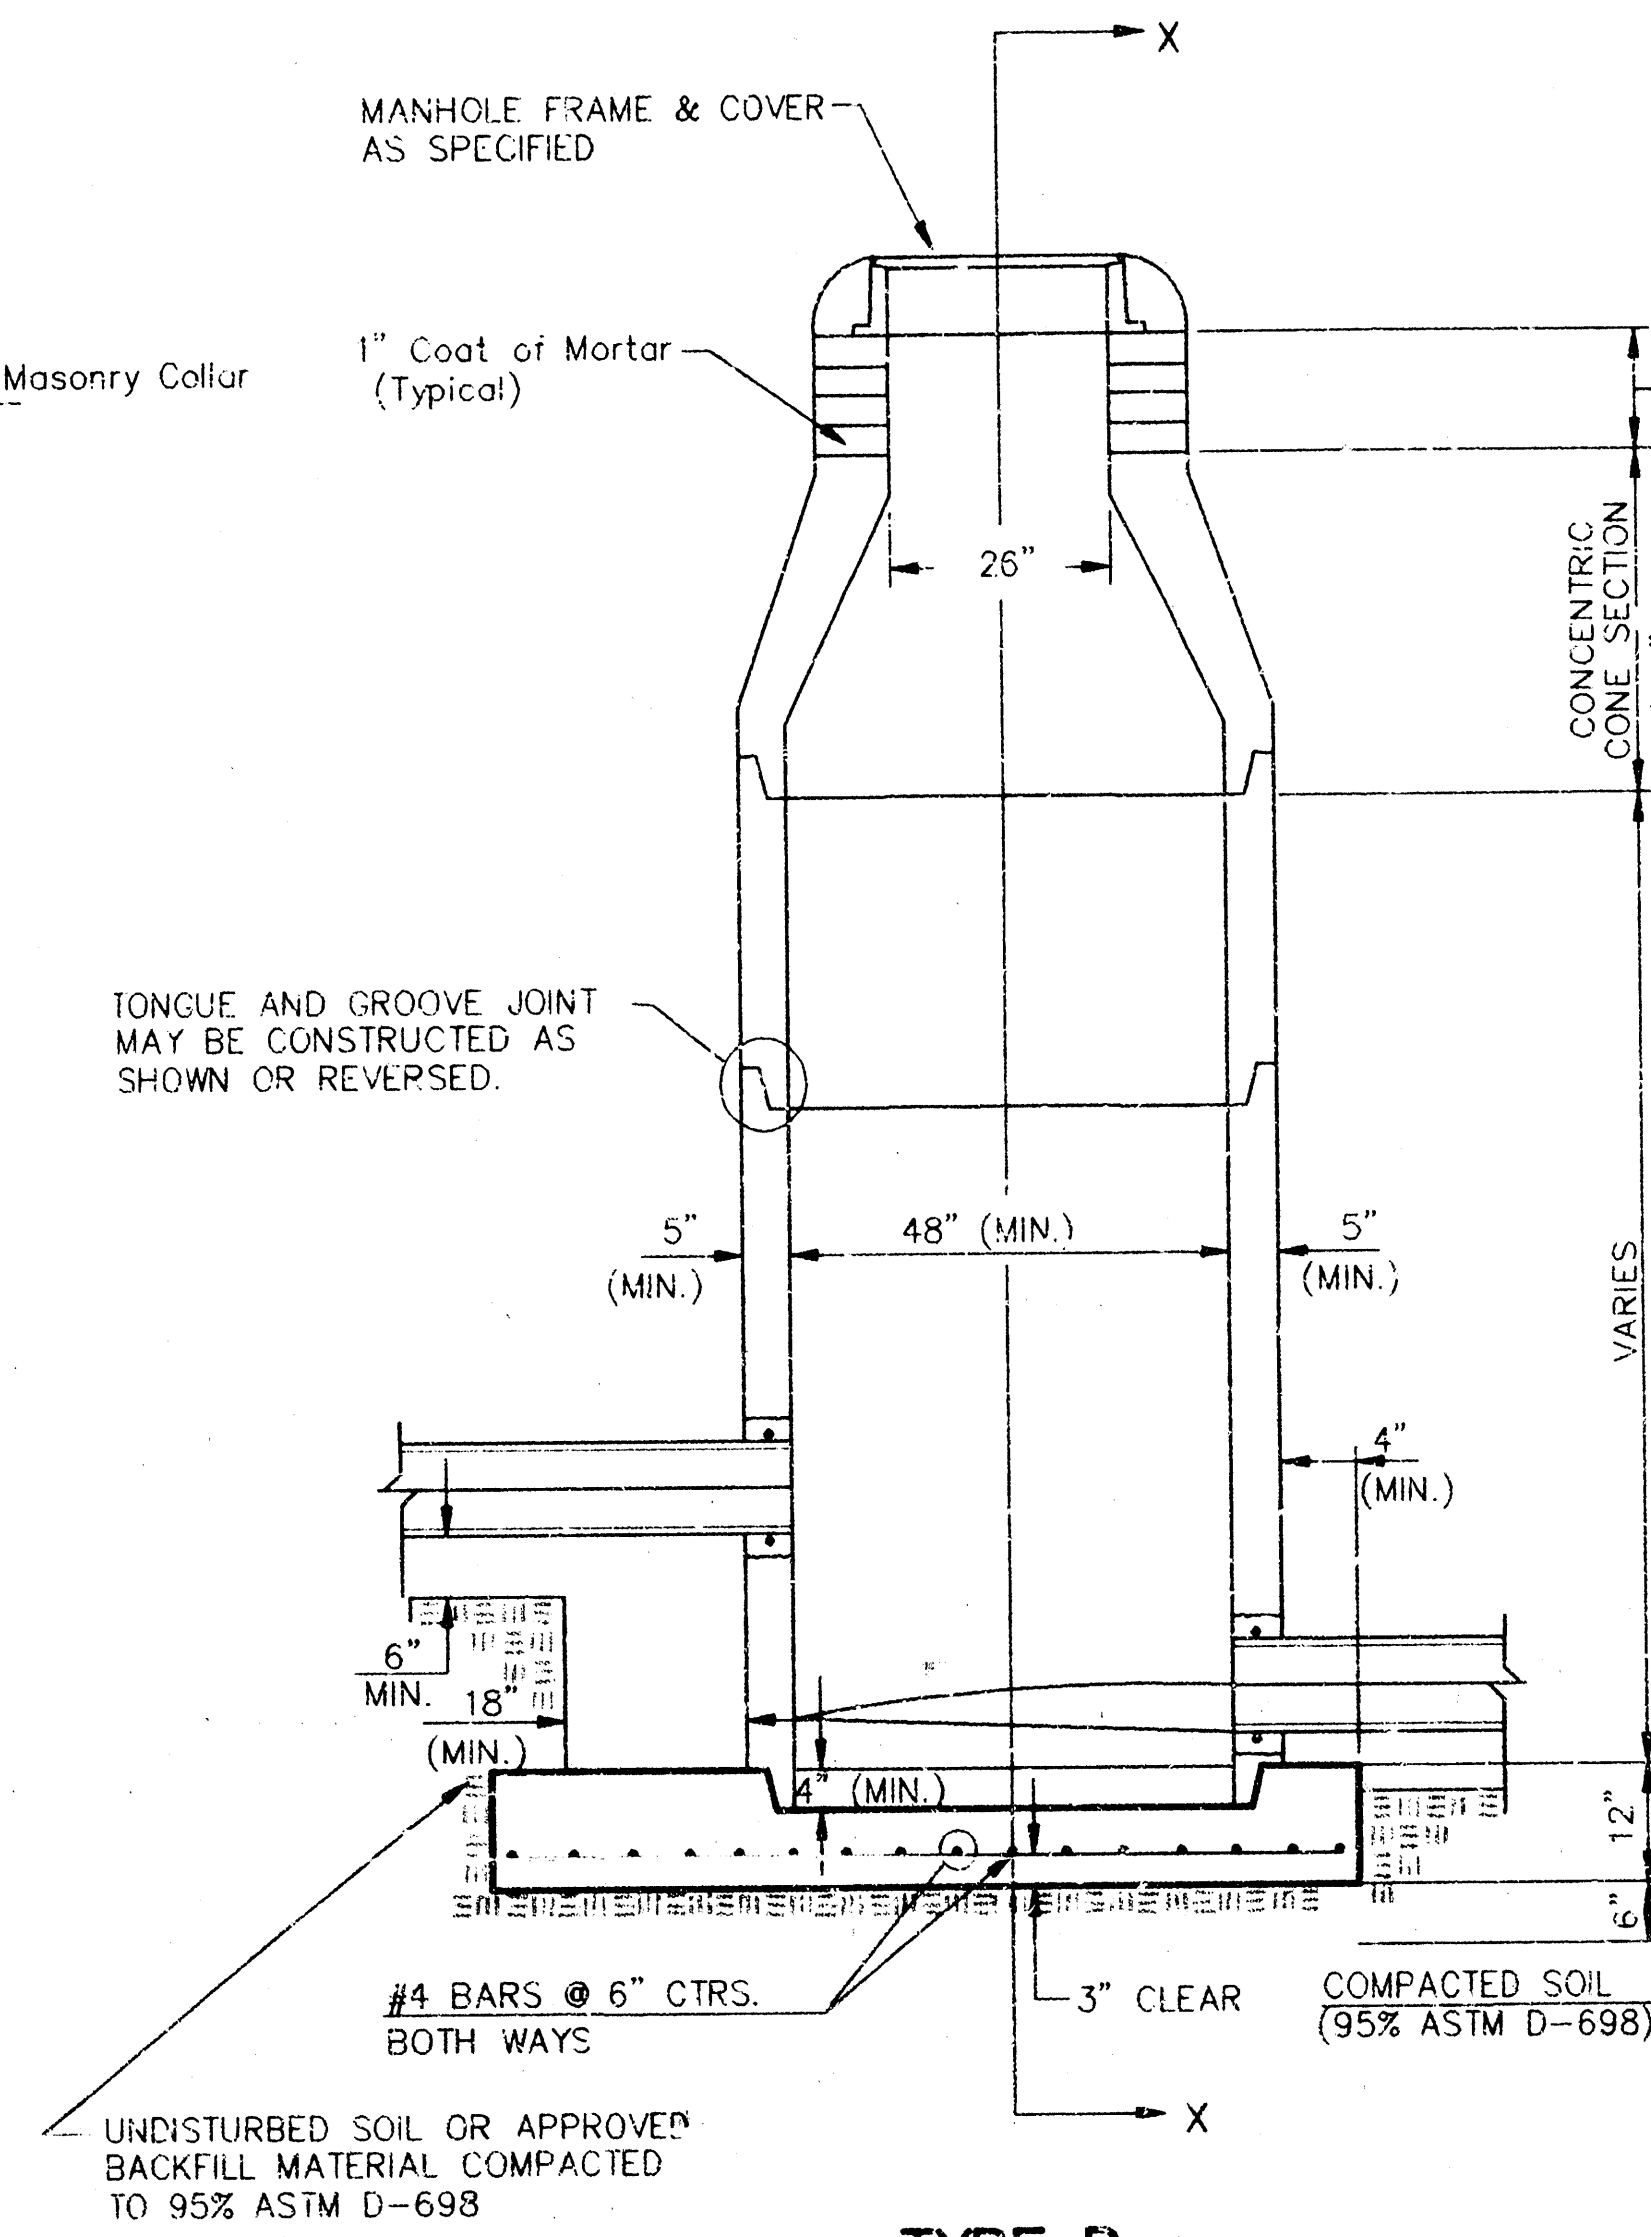


**TYPE P
INSIDE DROP MANHOLE**

- REINFORCING STEEL SHALL BE INSTALLED IN THE MANHOLE BASES AND SHALL CONSIST OF NO. 4 BARS PLACED ON 6" CENTERS IN BOTH DIRECTIONS. THE MANHOLE BASE REINFORCEMENT SHALL BE PLACED AT LEAST 3" ABOVE THE BOTTOM OF THE MANHOLE BASE. ALL COSTS FOR FURNISHING AND INSTALLING REINFORCING STEEL SHALL BE INCLUDED IN THE UNIT PRICE BID FOR THE MANHOLE.
- OPENINGS SHALL BE CUT INTO THE MANHOLE WALL WHEN OUTSIDE DROPS ARE CONSTRUCTED ON EXISTING MANHOLES. SUCH OPENINGS CUT INTO EXISTING MANHOLES SHALL BE AS SMALL AS PRACTICAL TO FACILITATE INSTALLING AND GROUDED THE NEW PIPE IN PLACE. WATERSTOP GASKETS SHALL BE USED WITH P.V.C. AND A.B.S. COMPOSITE PIPE. THE NEW PIPE SHALL BE GROUDED INTO THE OPENING USING AN APPROVED NONSHRINK GROUT FOR THE FULL MANHOLE WALL THICKNESS. THE EXTERIOR OF THE COMPLETED CONNECTION SHALL BE SEALED WITH AN APPROVED BITUMINOUS COATING SUCH THAT THE CONNECTION WILL BE WATER TIGHT. FLOOR OF MANHOLE SHALL BE MODIFIED TO FORM NEW FLOW CHANNEL FOR THE NEW CONNECTION AS INDICATED BY THE DRAWING. THIS WORK, INCLUDING MODIFICATION OF MANHOLE FLOOR, SHALL BE PAID FOR AT THE UNIT PRICE BID FOR OUTSIDE DROP STACK CONSTRUCTION ON EXISTING MANHOLE.
- THE FLOORS OF ALL MANHOLES SHALL BE SHAPED WITH FLOW CHANNELS SUCH THAT THE MANHOLES WILL BE SELF CLEANING AND FREE OF AREAS WHERE SOLIDS COULD BE DEPOSITED AS SEWAGE FLOWS THROUGH THE MANHOLE FROM ALL INLET PIPES TO THE OUTLET PIPE. FLOW CHANNELS SHALL BE FORMED TO MATCH THE BOTTOM HALVES OF THE INFLOWING PIPES AND THE OUTFLOWING PIPE AS SHOWN BY THE DRAWINGS EXCEPT FOR INSIDE DROP MANHOLES. FLOW CHANNELS FOR INSIDE DROP MANHOLES SHALL BE CONSTRUCTED AS INDICATED BY THE DRAWING. MANHOLE FLOORS SHALL HAVE SLOPES OF 3 INCHES PER FOOT (1") THE AREAS OUTSIDE OF THE FLOW CHANNELS SLOPED TOWARD THE FLOW CHANNELS. PIPES LAID THROUGH MANHOLES SHALL HAVE THE TOP HALF REMOVED TO NEAT LINES FOR THE FULL INSIDE DIAMETER OF THE MANHOLE. MANHOLE FLOORS SHALL THEN BE SHAPED AROUND THE BOTTOM HALF OF THE PIPE WHICH FORMS THE FLOW CHANNEL.
- PIPES INSTALLED WITHIN THE EXCAVATION MADE FOR THE MANHOLE SHALL BE CRADLED WITH CONCRETE TO THE LIMITS OF THE MANHOLE EXCAVATION. WHEN CLAY PIPE IS USED, THE CRADLE SHALL EXTEND TO THE FIRST JOINT OUTSIDE THE MANHOLE. THE CRADLE SHALL BE TERMINATED AT THE CLAY PIPE JOINT IN A MANNER WHICH WILL MAINTAIN THE FLEXIBILITY OF THE JOINT. COST OF CRADLE WITHIN MANHOLE EXCAVATION OR TO CLAY PIPE JOINTS ADJACENT TO MANHOLE SHALL BE INCLUDED IN THE UNIT PRICE BID FOR THE MANHOLE.

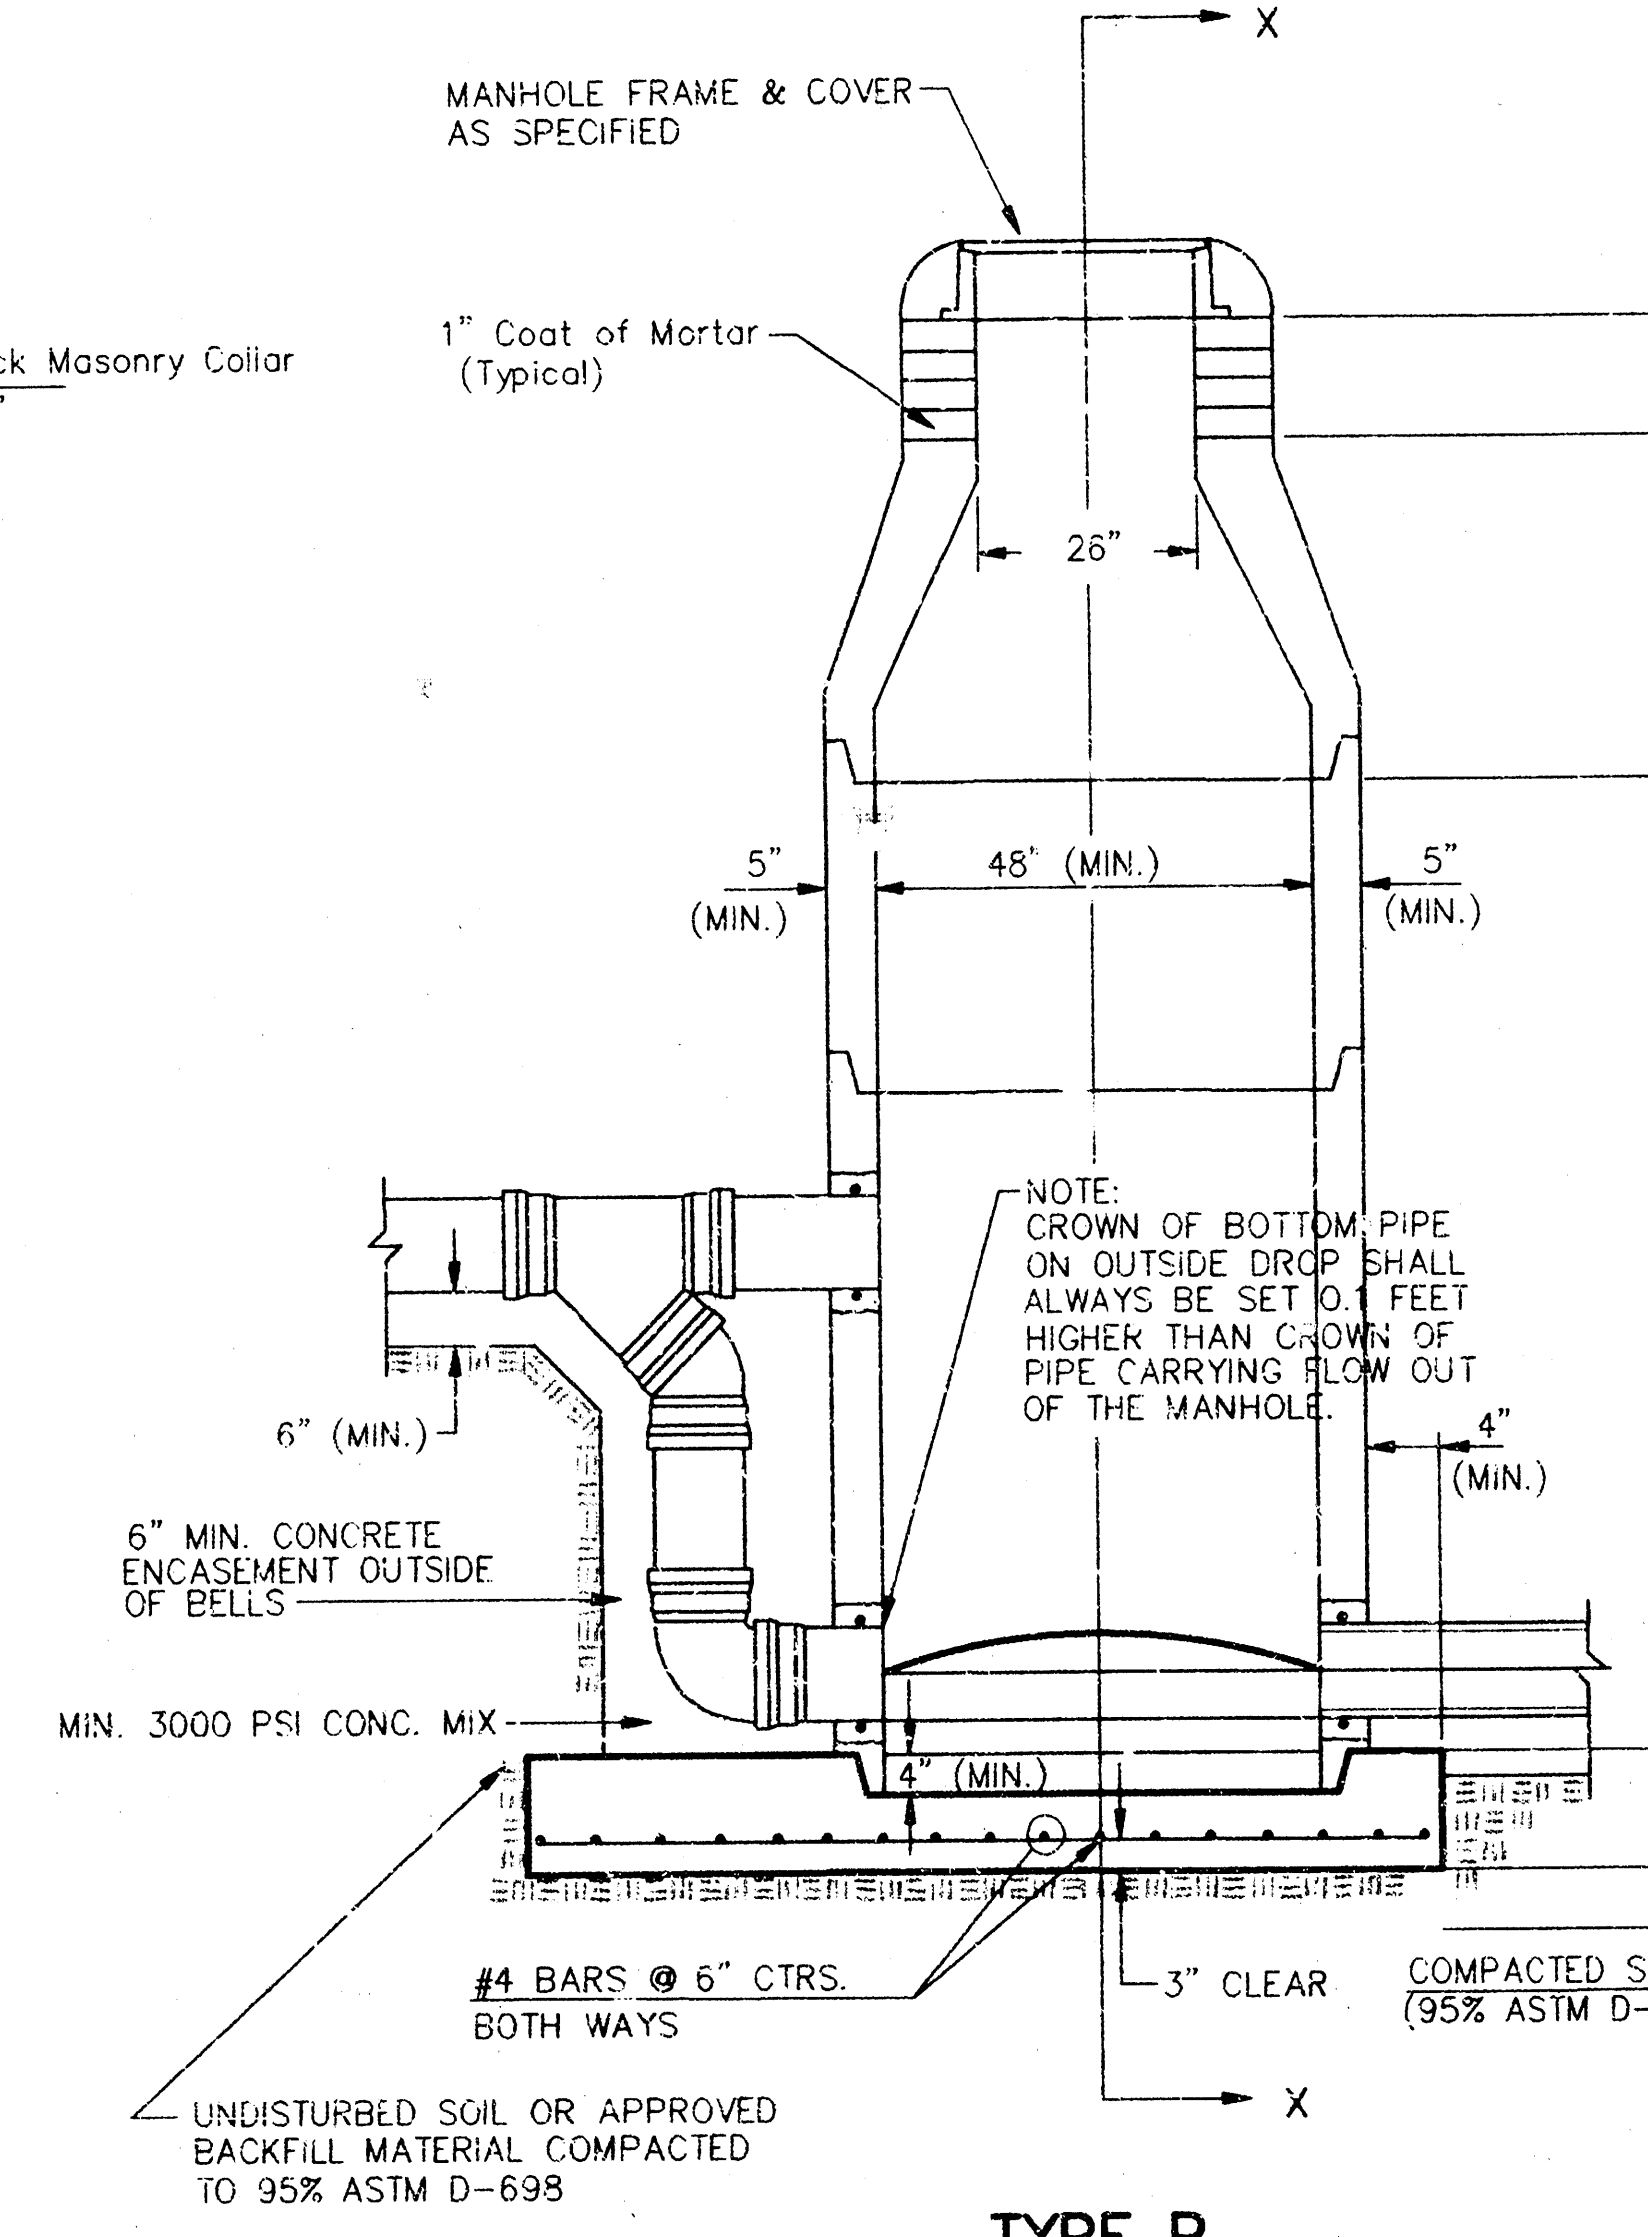


**TYPE P
OUTSIDE DROP MANHOLE**

- MANHOLE COVER CASTINGS AND MANHOLE FRAME CASTINGS SHALL CONFORM TO THE REQUIREMENTS AS INDICATED IN THE STANDARD SPECIFICATIONS AND AS SHOWN IN THE STANDARD DETAIL DRAWING.
- THE VERTICAL DROP IN INSIDE DROP MANHOLES SHALL NOT EXCEED 2' FOR INFLOWING PIPES SIZED 12" OR SMALLER AND 2' FOR INFLOWING PIPES LARGER THAN 12". THE CROWNS OF INFLOWING PIPES SHALL NEVER BE SET LOWER THAN THE CROWN OF THE OUTFLOWING PIPE.
- STANDARD MANHOLES AND STANDARD INSIDE DROP MANHOLES SHALL BE BID AS STANDARD MANHOLES FOR THE TYPE AND DIAMETER INDICATED. OUTSIDE DROP MANHOLES SHALL BE BID AS STANDARD OUTSIDE DROP MANHOLES FOR THE TYPE AND DIAMETER INDICATED. ALL MANHOLE DIAMETERS WILL BE 4' UNLESS INDICATED OTHERWISE.
- A BRICK MASONRY COLLAR SHALL BE INSTALLED BETWEEN THE CAST IRON FRAME AND THE CONCENTRIC CONE. THE COLLAR WILL HAVE 8" WALLS AND A VERTICAL HEIGHT OF 6" MINIMUM AND 18" MAXIMUM. A 1" COAT OF MORTAR WILL BE PLASTERED ON THE OUTSIDE OF THE COLLAR. THE USE OF PRE-CAST CONCRETE SPACERS FOR MANHOLE TOP ADJUSTMENT IS ALSO ALLOWED.

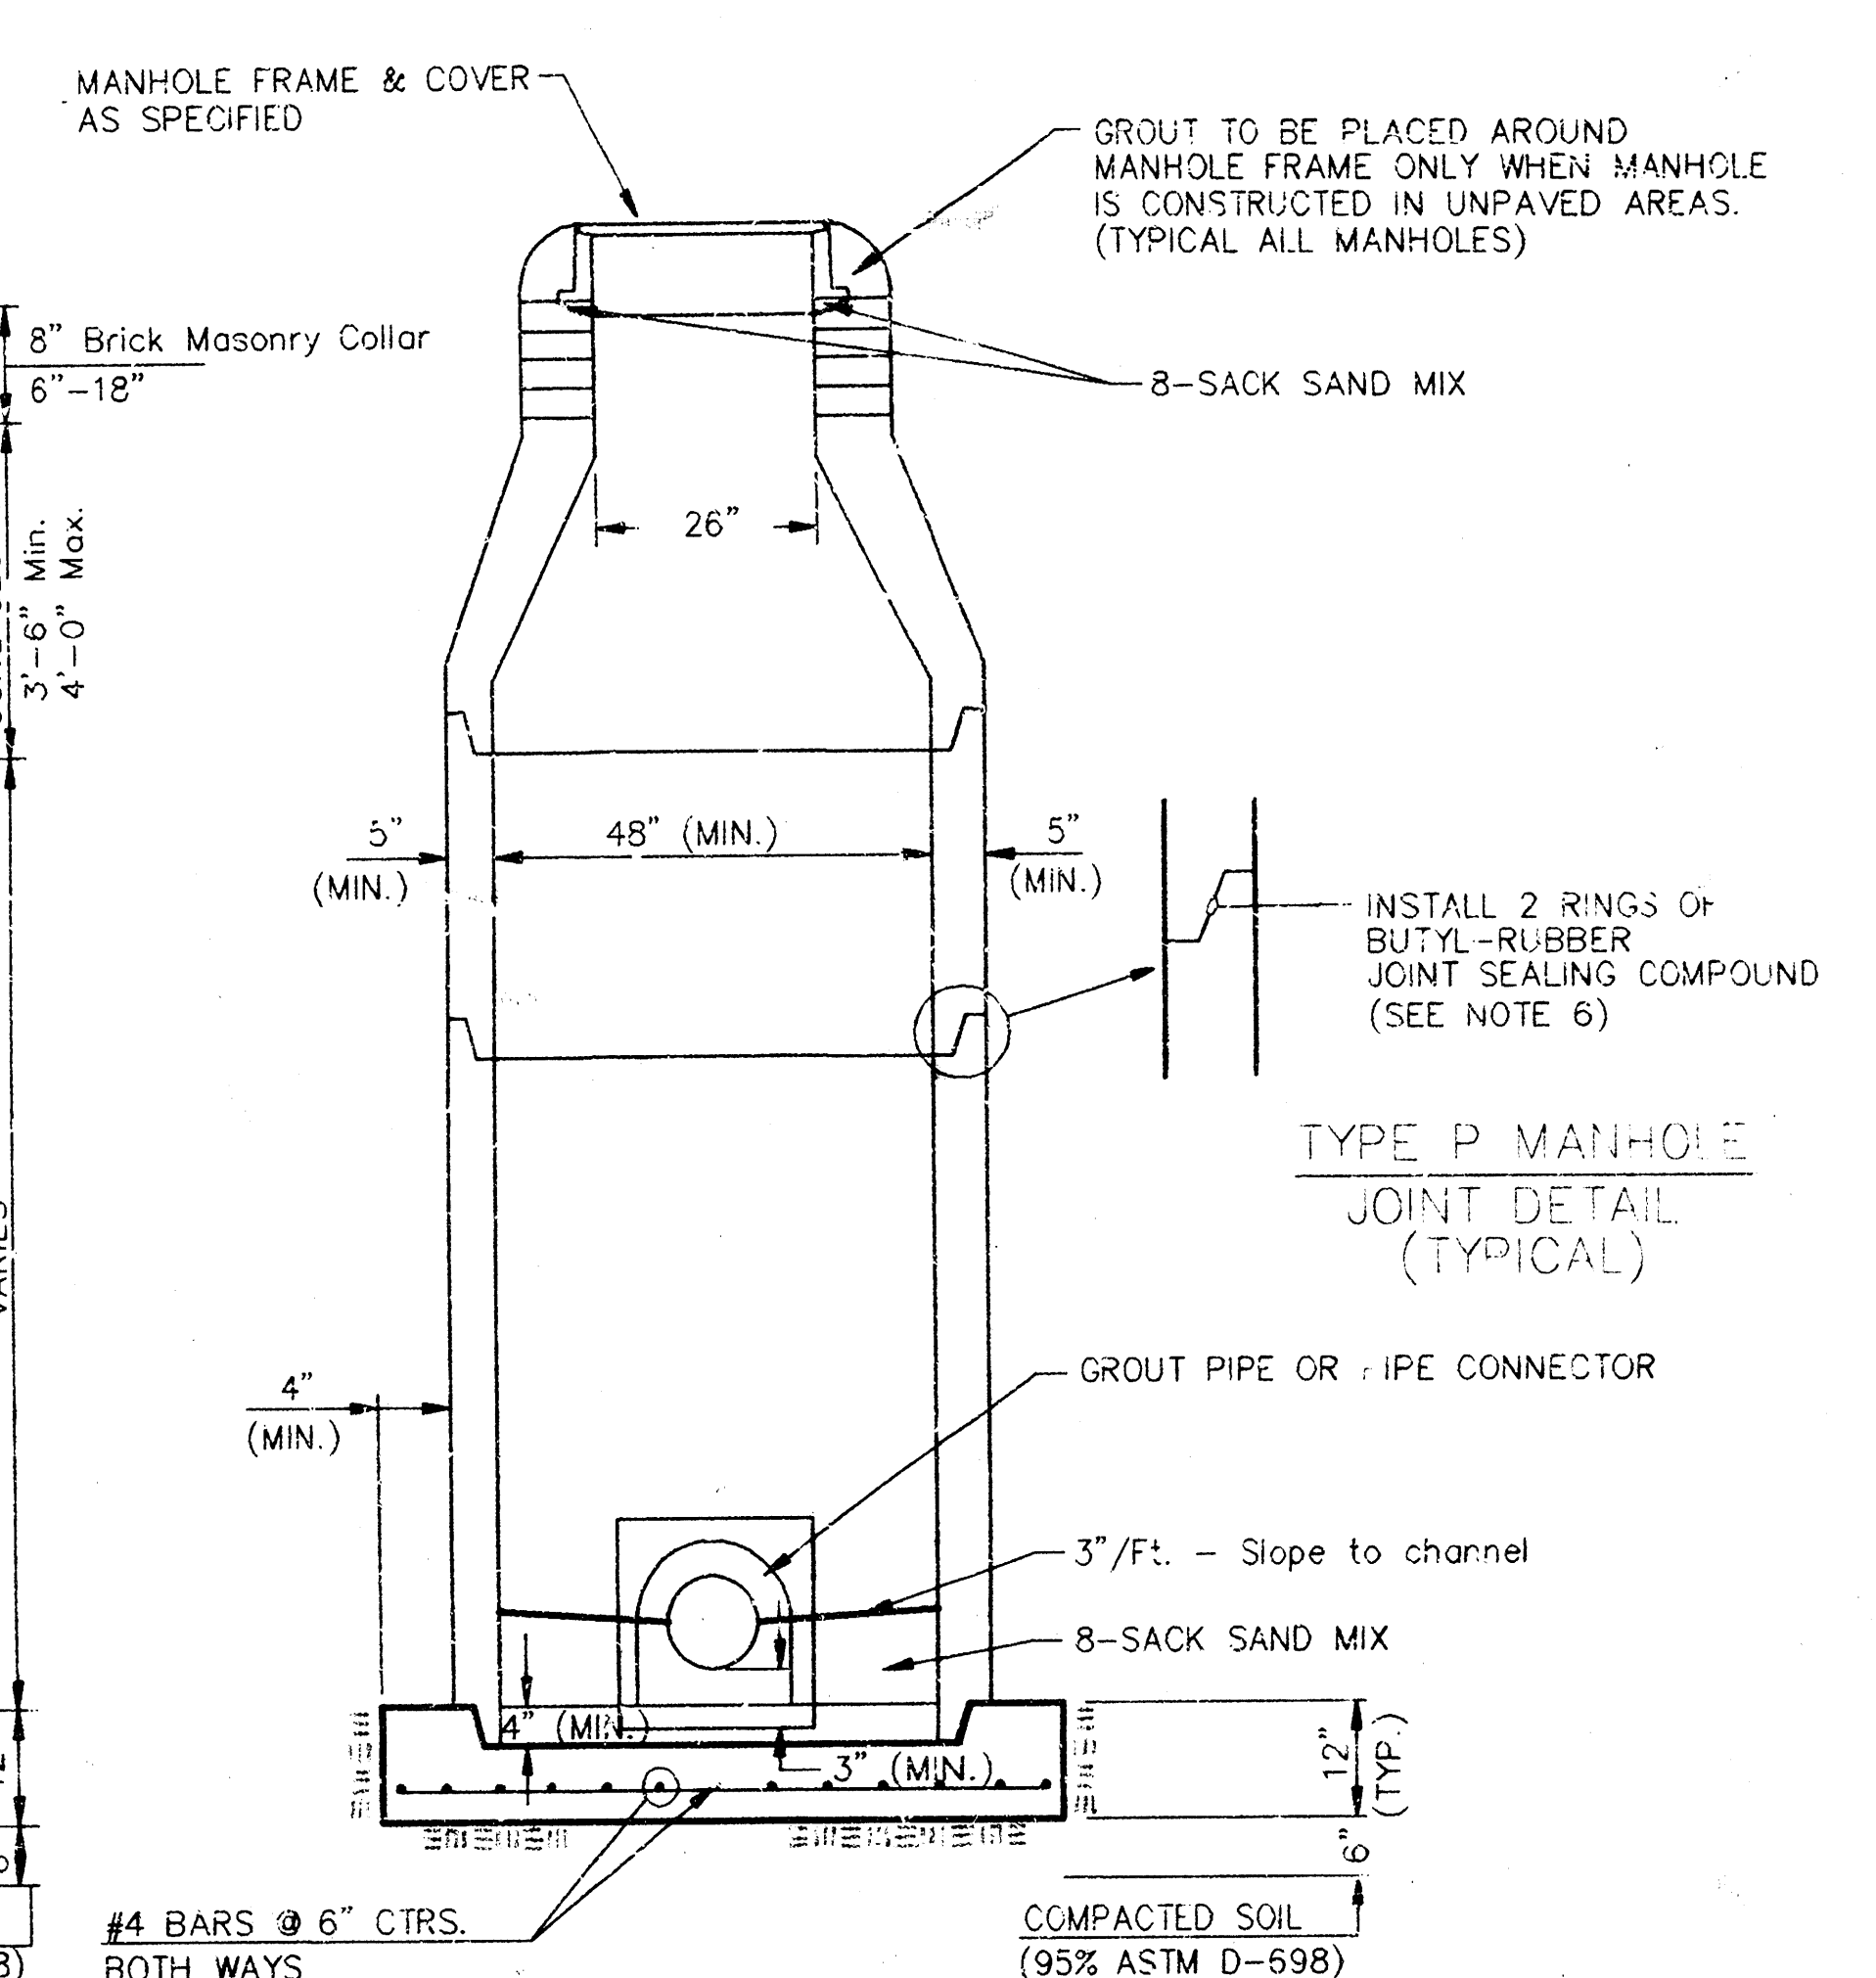


**SECTION X
(TYPICAL)**

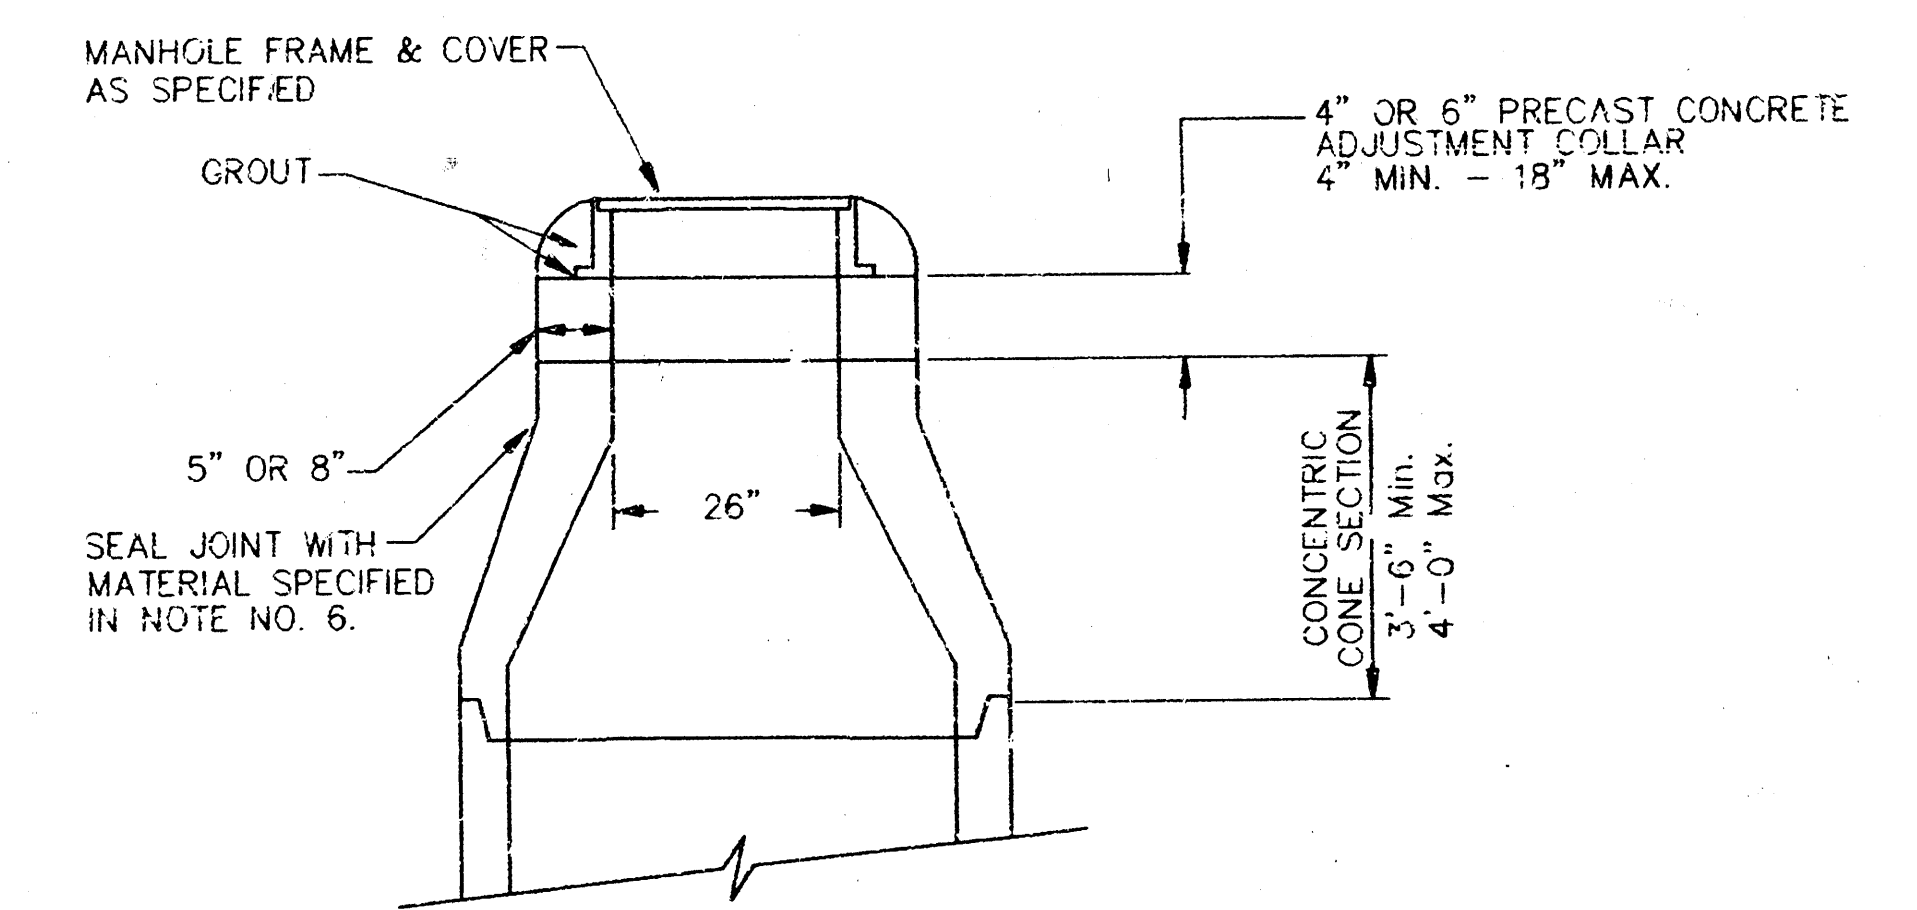

**ALTERNATE CONSTRUCTION
IN UNPAVED AREAS**

CITY OF WICHITA, KANSAS STANDARD MANHOLE DETAILS SEWER APPURTENANCES DETAILS

BAUGHMAN COMPANY P. A. ENGINEERING & SURVEYING 316/262-7271 • 315 ELUS • WICHITA, KANSAS 67211					REV. NOV. 1993
PROJECT NUMBER 468-78-245-81107-000-000-001					SHEET 3 OF 4
DESIGN	DRAWN	APPROVED	DATE	SCALE	

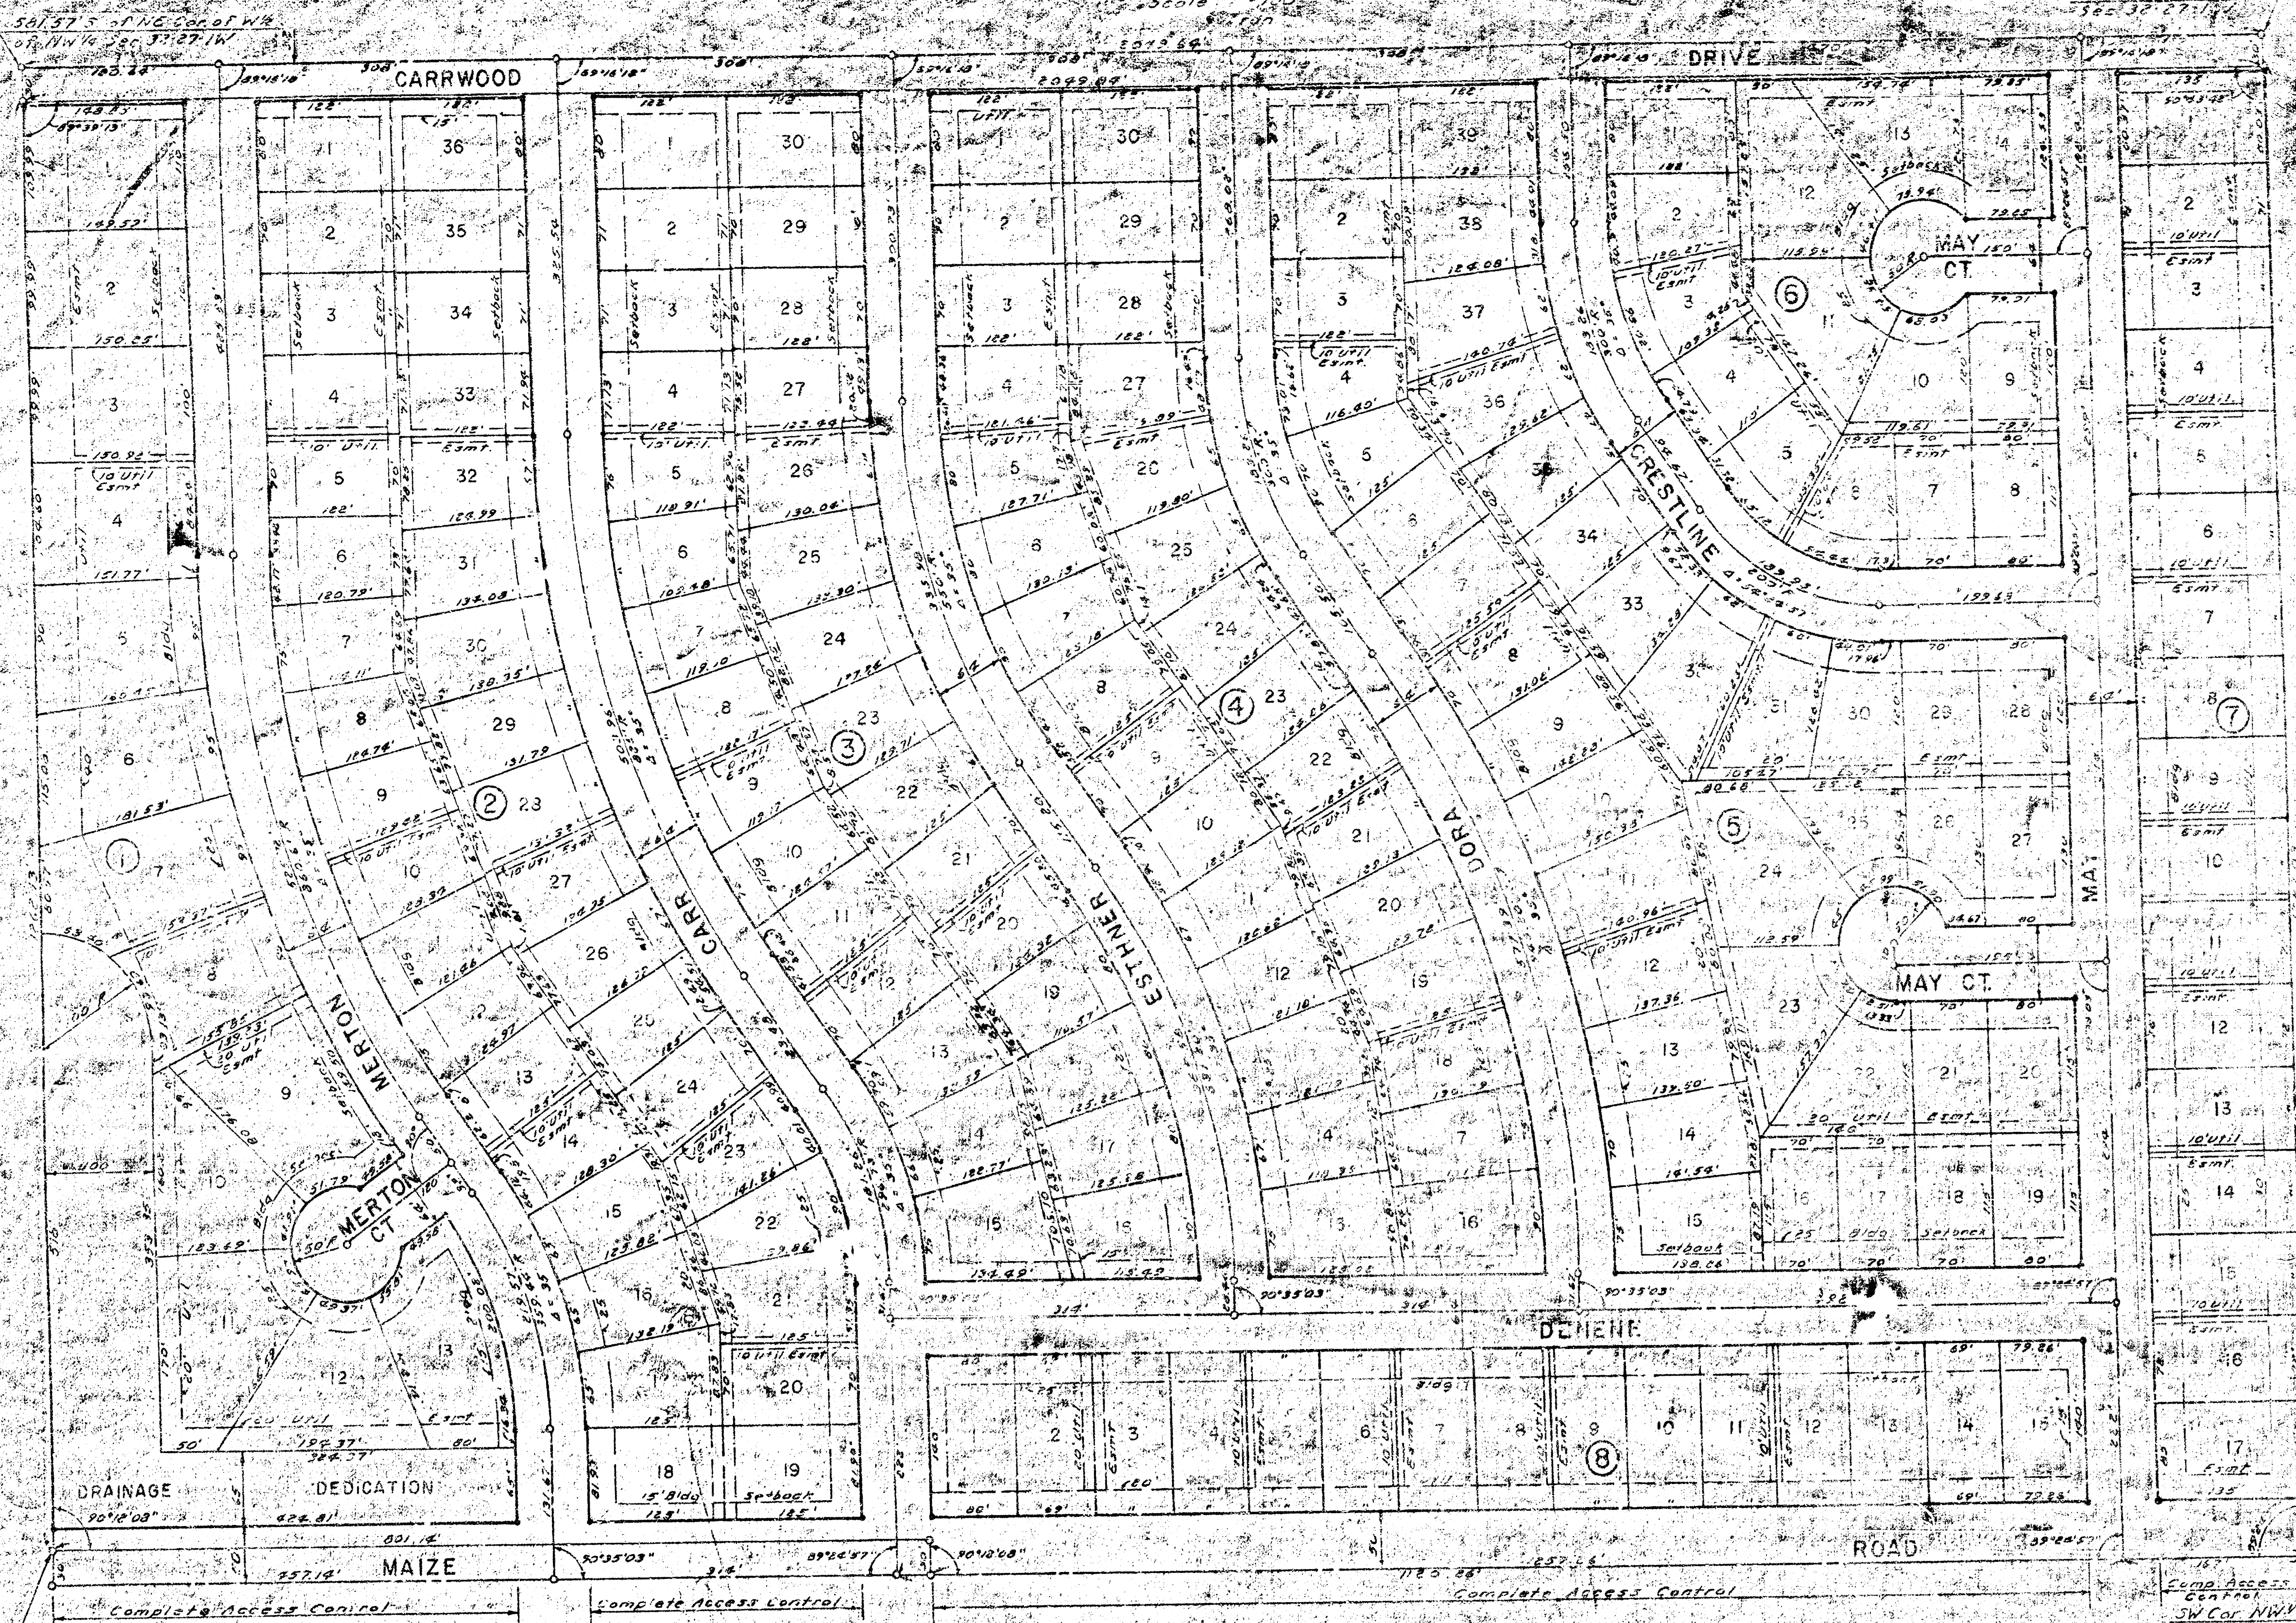

PRAIRIE PARK 2ND ADDITION WICHITA, KANSAS

This plat of "PRAIRIE PARK 2ND ADDITION",
Wichita, Kansas, has been submitted to and
approved by the Wichita-Sedgwick County Metro-
politan Area Planning Commission, Wichita, Kansas
dated this 2nd day of March, 1979.

Wichita-Sedgwick County Metropolitan Area
Planning Commission

August J. Taylor Chairman
Robert A. Lohm Secretary

This plat approved and all dedications shown
hereon accepted by the Board of City Commissioners,
Wichita, Kansas, this 17th day of March, 1979.

Charles A. Smith Mayor
Donald C. Glavin City Clerk

This plat approved and all dedications shown
hereon accepted by the Board of County Commissioners,
Sedgwick County, Kansas, this 17th day of April, 1979.

Dorothy K. White County Clerk

Entered on transfer record this day of
1979.

Dorothy K. White County Clerk

State of Kansas 355. This is to certify that this
Sedgwick County 355. This is to certify that this
plat has been filed for record in the Office of
the Register of Deeds this 17th day of April,
1979 at 10:00 o'clock A.M. and is duly recorded.

James E. Smith Register of Deeds
Paul Kestner Deputy

State of Kansas 355. We, Boughman Company,
Surveyors in aforesaid county and state do hereby
certify that we have surveyed and plotted "PRAIRIE
PARK 2ND ADDITION" Wichita, Kansas, and that the
accompanying plat is a true and correct exhibit
of the property surveyed, described as follows:
Beginning at the SW corner of the NW 1/4 of Section 36,
T27S, R1W, Sedgwick County, Kansas; thence north-
erly, along the west line of said NW 1/4, 127.26 feet
to a point 1382.71 feet south of the NW corner of
said NW 1/4; thence easterly, parallel with the north
line of said NW 1/4, 301.14 feet to a point
581.57 feet south of the north line of said NW 1/4;
thence easterly, parallel with the north line of said
NW 1/4, 1265.13 feet to a point 30 feet west of the east
line of the NW 1/4 of said NW 1/4; thence southerly,
parallel with said east line, 2049.64 feet to the south
line of said NW 1/4; thence westerly, along said
south line, 1287.03 feet to the point of beginning.

Dated 2-27-79 Boughman Company
William S. Boughman Surveyor

Know all men by these presents that we, the
undersigned, have caused the land described in
the surveyors certificate to be plotted into
lots, blocks, streets and a drainage dedication
to be known as "PRAIRIE PARK 2ND ADDITION",
Wichita, Kansas. The easements are hereby granted
as indicated for the construction and maintenance
of public utilities. The drainage dedication is here-
by dedicated for drainage purposes. The streets
are hereby dedicated to and for the use of the
public. All abutters rights of access over, and
across the east line of Maize Road, are hereby
granted to the City of Wichita, Kansas.

Pate Construction Co., Inc. Vice Pres.
John Lee Paul

State of Kansas 355. The foregoing instrument was
acknowledged before me this 17th day of April, 1979
by John Lee Paul and Pate Construction Co., Inc. by Corman
H. Pate, Vice Pres. In testimony whereof, I have
hereunto set my hand and affixed my notarial seal
the day and year above written.

Wm. A. Smith Notary Public
My Commission Expires 12-13-1982

Way the undersigned, holders of a mortgage
on the above described property do hereby consent
to this plat of "PRAIRIE PARK 2ND ADDITION".

Howard H. Hake Edna Ruby Hake

State of Kansas 355. The foregoing instrument was
acknowledged before me this 17th day of April,
1979, by Howard H. Hake and Edna Ruby Hake, his wife,
and Walter Palmer and Josephine Palmer, his wife
and George Richard Carr. In testimony whereof, I
have hereunto set my hand and affixed my notarial
seal the day and year above written.

Wm. A. Smith Notary Public
My Commission Expires 12-13-1982

State of California 355. The foregoing instrument
was acknowledged before me this 17th day of
January, 1979, by Edwin Dale Carr and Beola
D. Carr, his wife. In testimony whereof, I have
hereunto set my hand and affixed my notarial
seal the day and year above written.

Wm. A. Smith Notary Public
My Commission Expires 12-13-1982