
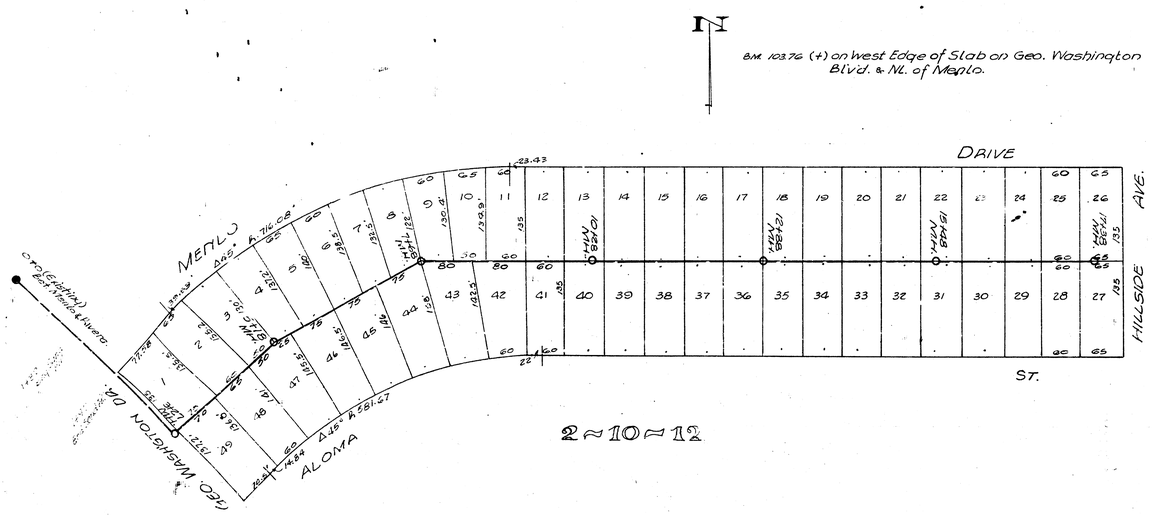


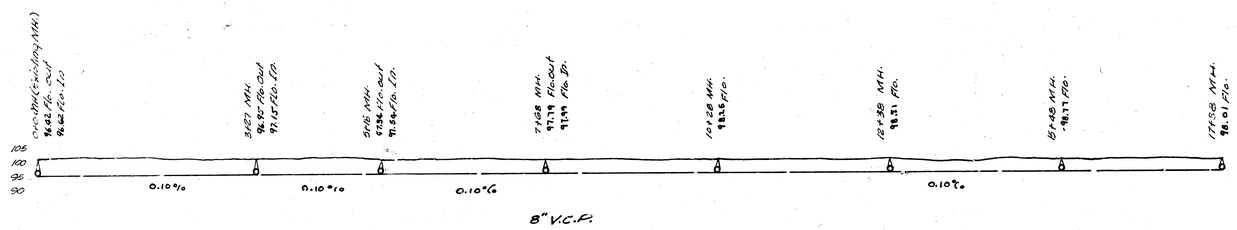

LAT. 2, DIST. 10, MAIN 12
CITY OF WICHITA, KANSAS
C.H. White City Engineer
June 1948 Proj No. C28-16