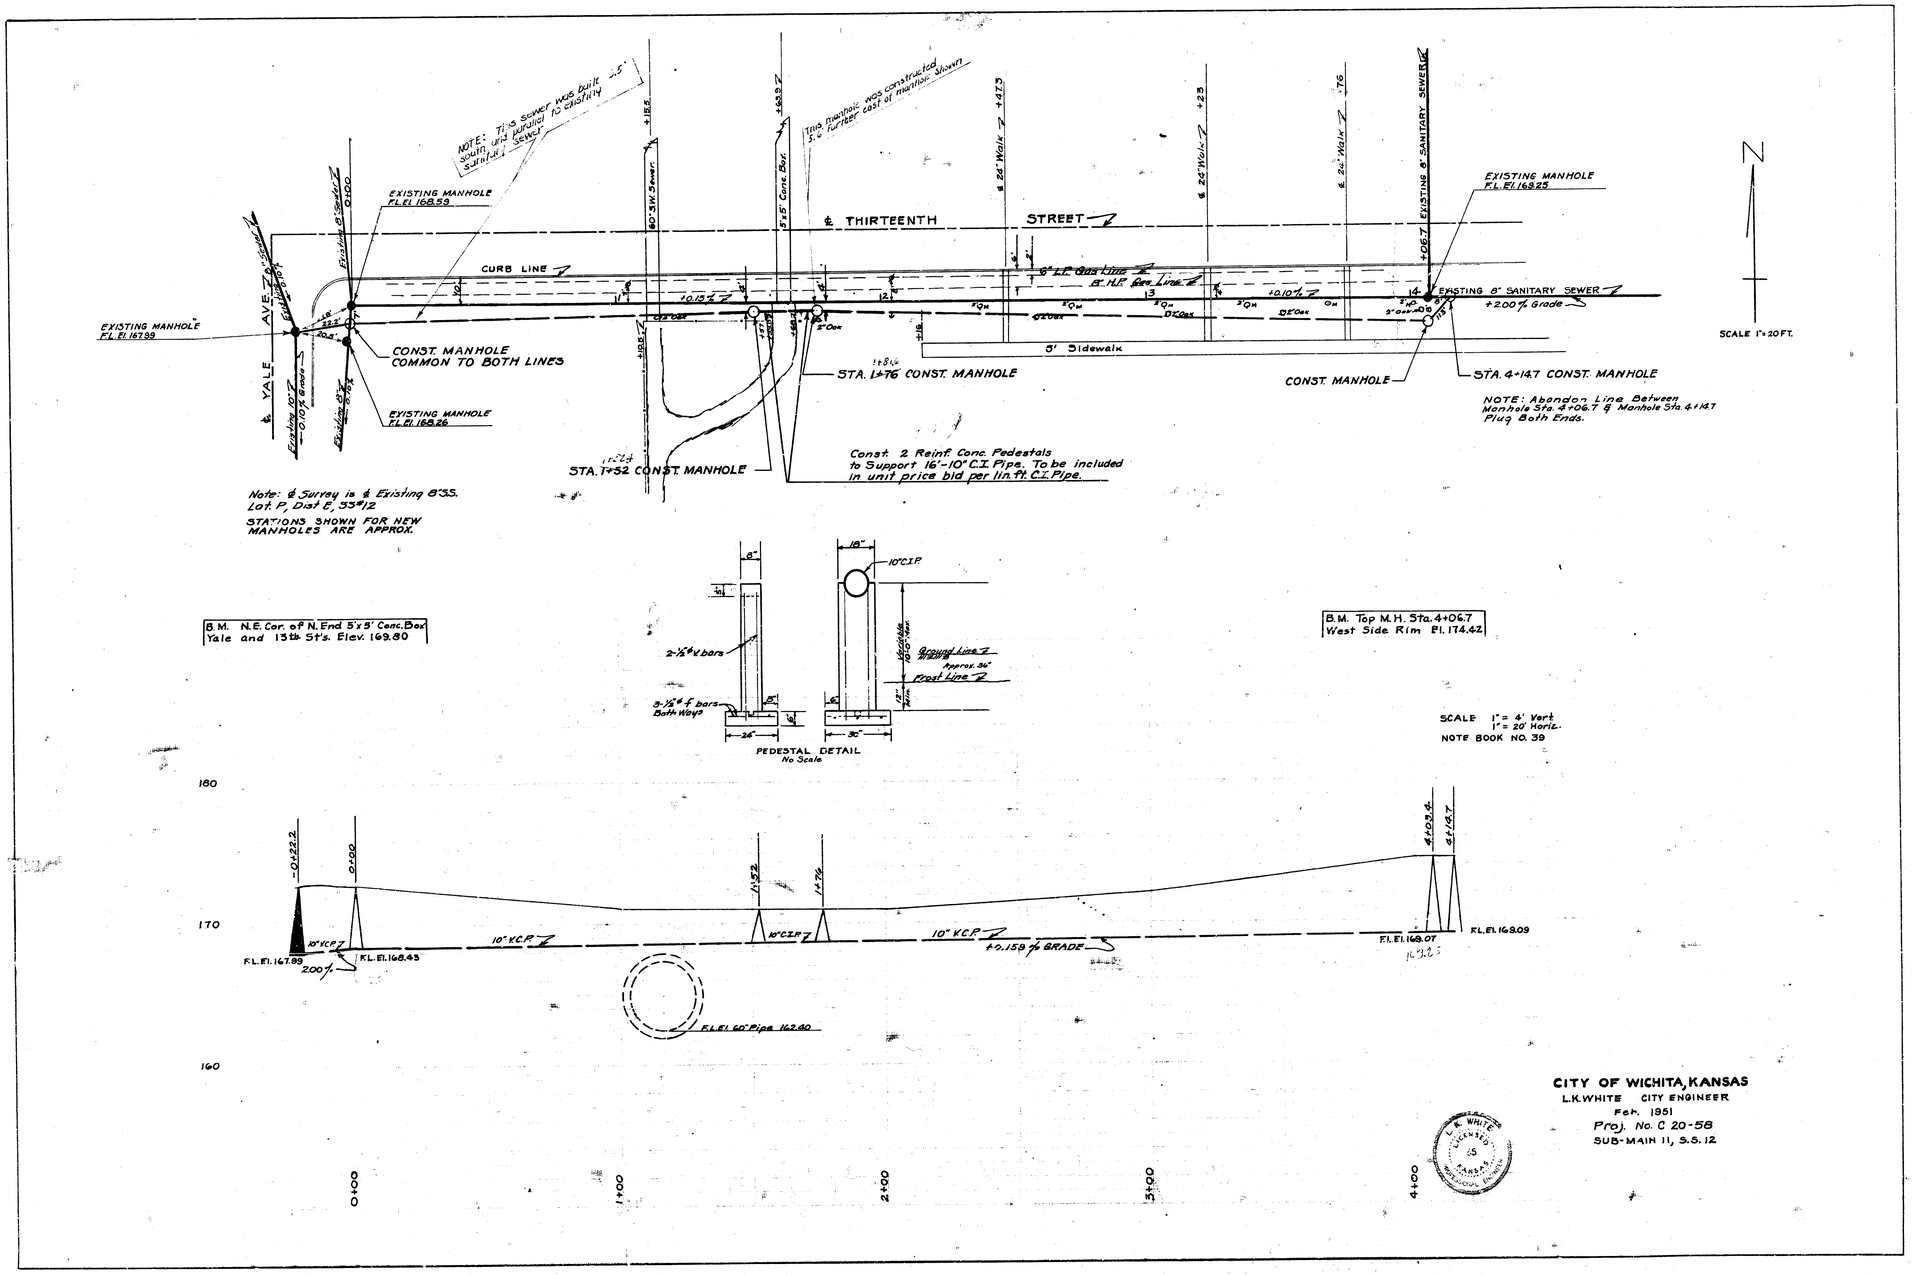

CITY OF WICHITA, KANSAS

L.K. WHITE CITY ENGINEER

Feb. 1951

Proj. No. C 20-58

SUB-MAIN 11, S.S. 12