

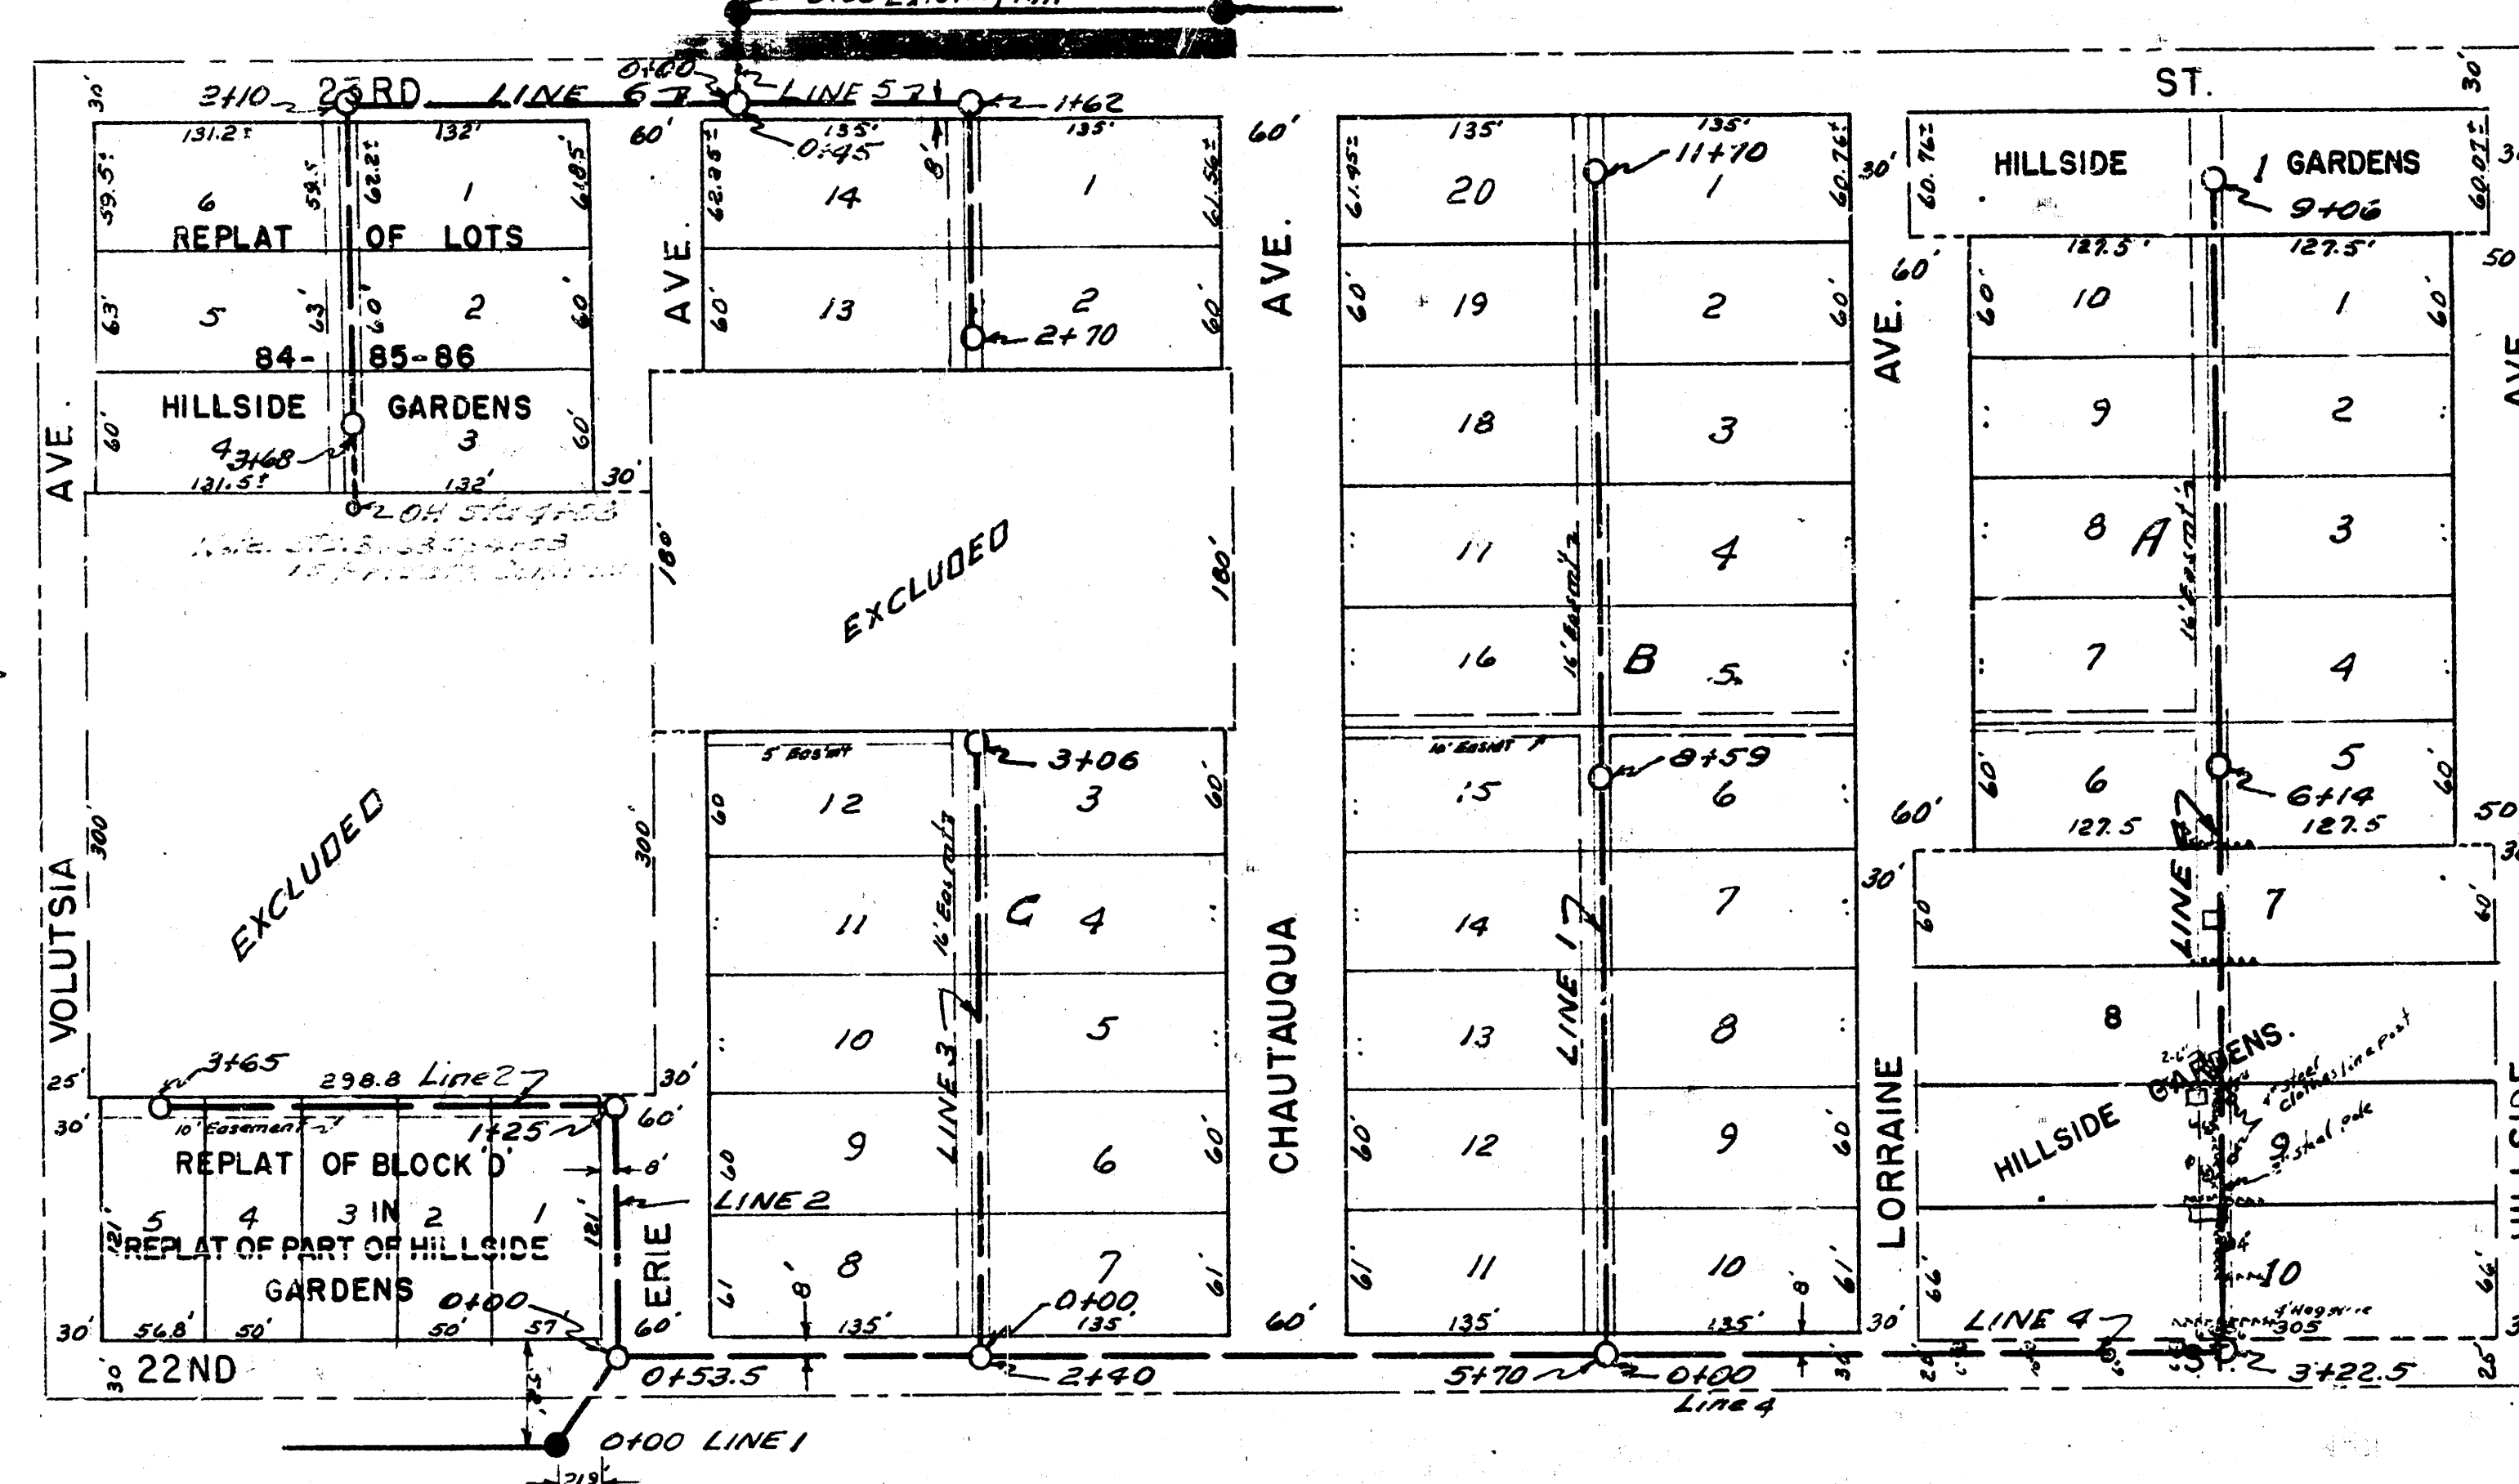


REPLAT OF PART OF HILLSIDE GARDENS WICHITA KANSAS.

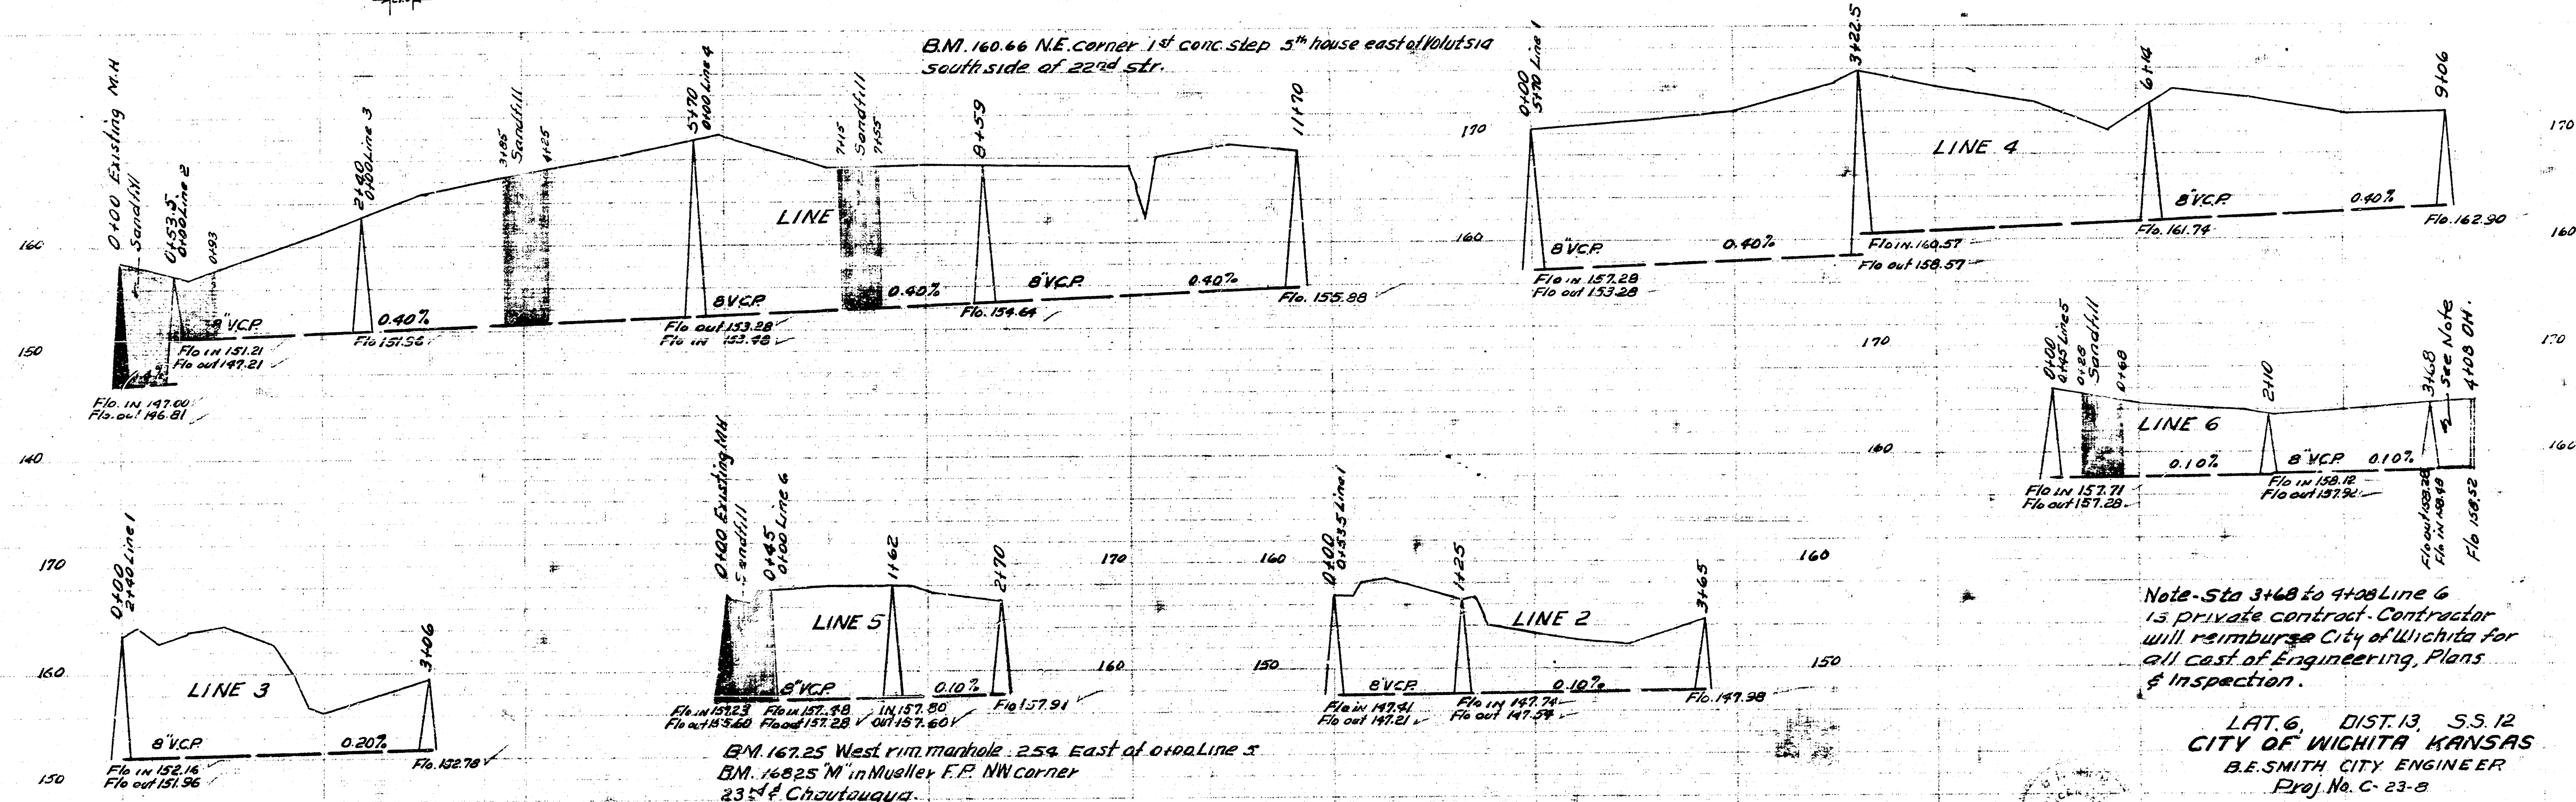

N

Scale: 1" = 80'

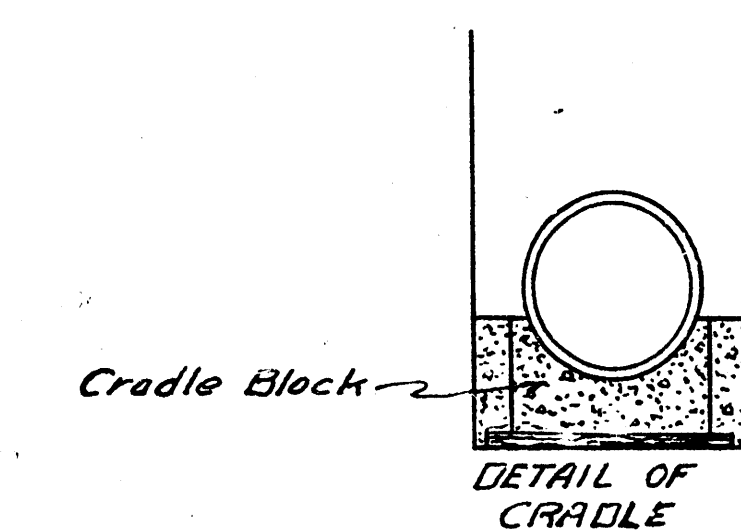

Note: Sta 3+68 to 4+28 Line 6 is private contract. Contractor will reimburse City of Wichita for all cost of Engineering, Plans & Inspection.

LAT. 6, DIST. 13, S.S. 12
CITY OF WICHITA KANSAS
B.E. SMITH CITY ENGINEER
Proj. No. C-23-8

Date 4-23-53
Drawn by McClain
Checked by
G. B. B.