
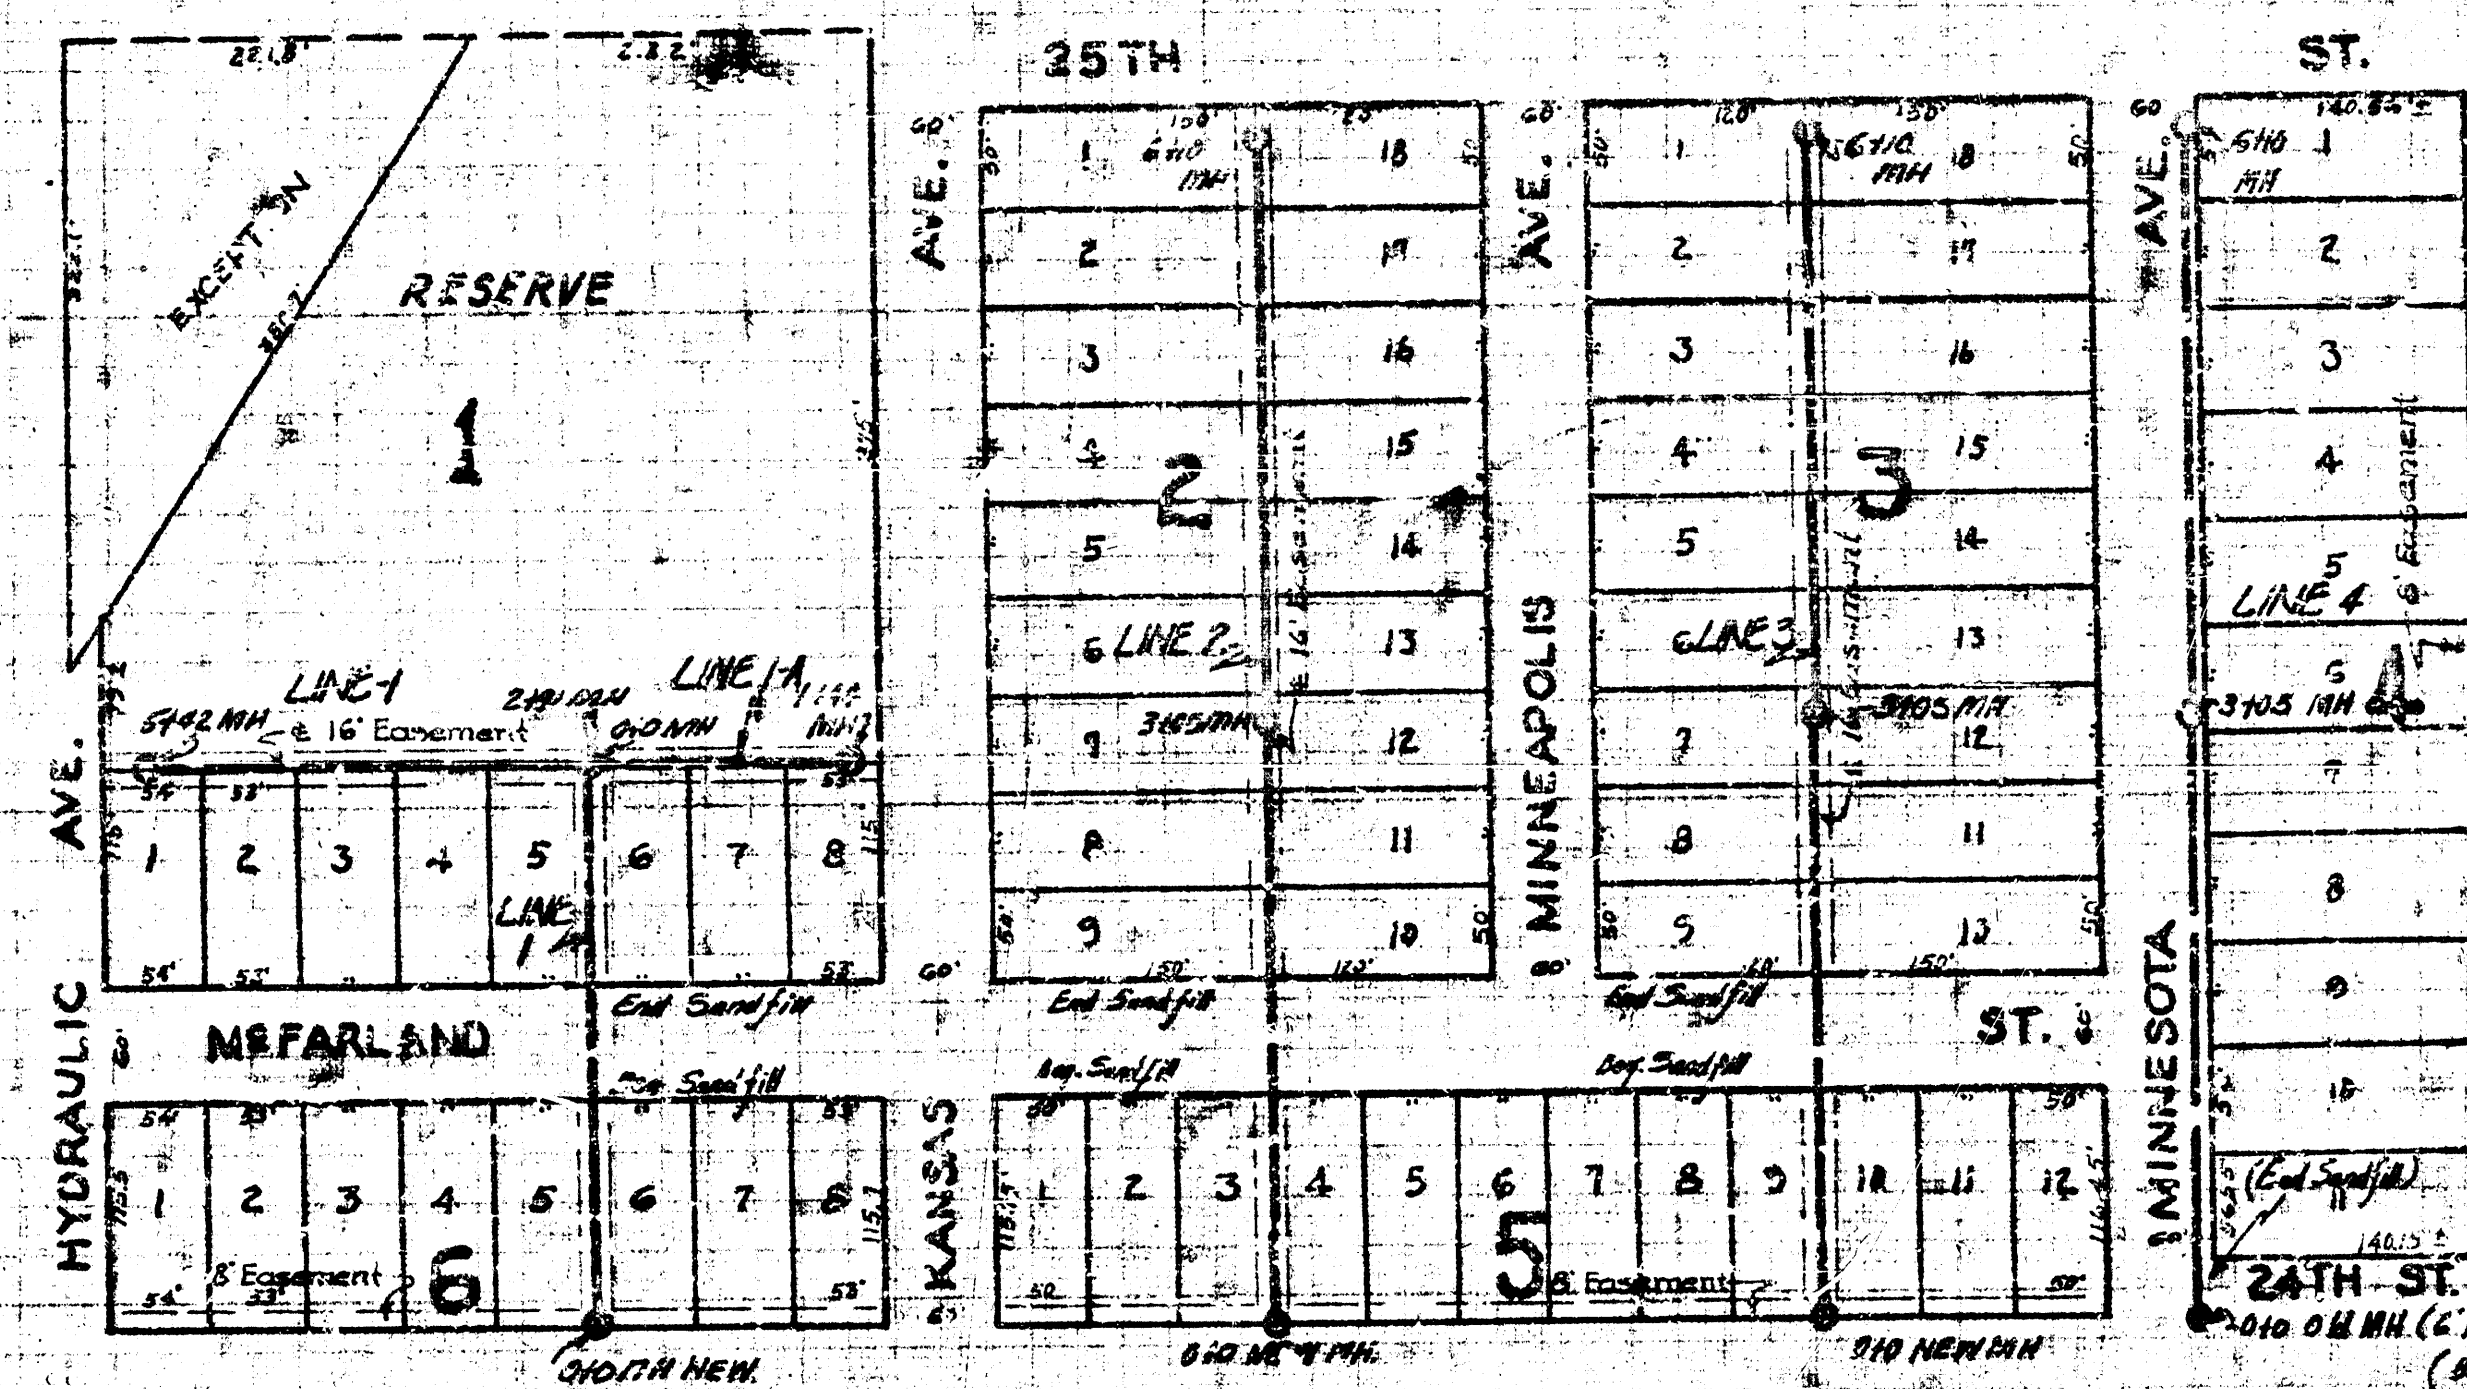


B.M. 12816 20" Spike N.S. K.G.E. Pole S.L. Dwyer's Add 150' E. of E.L. Kansas.

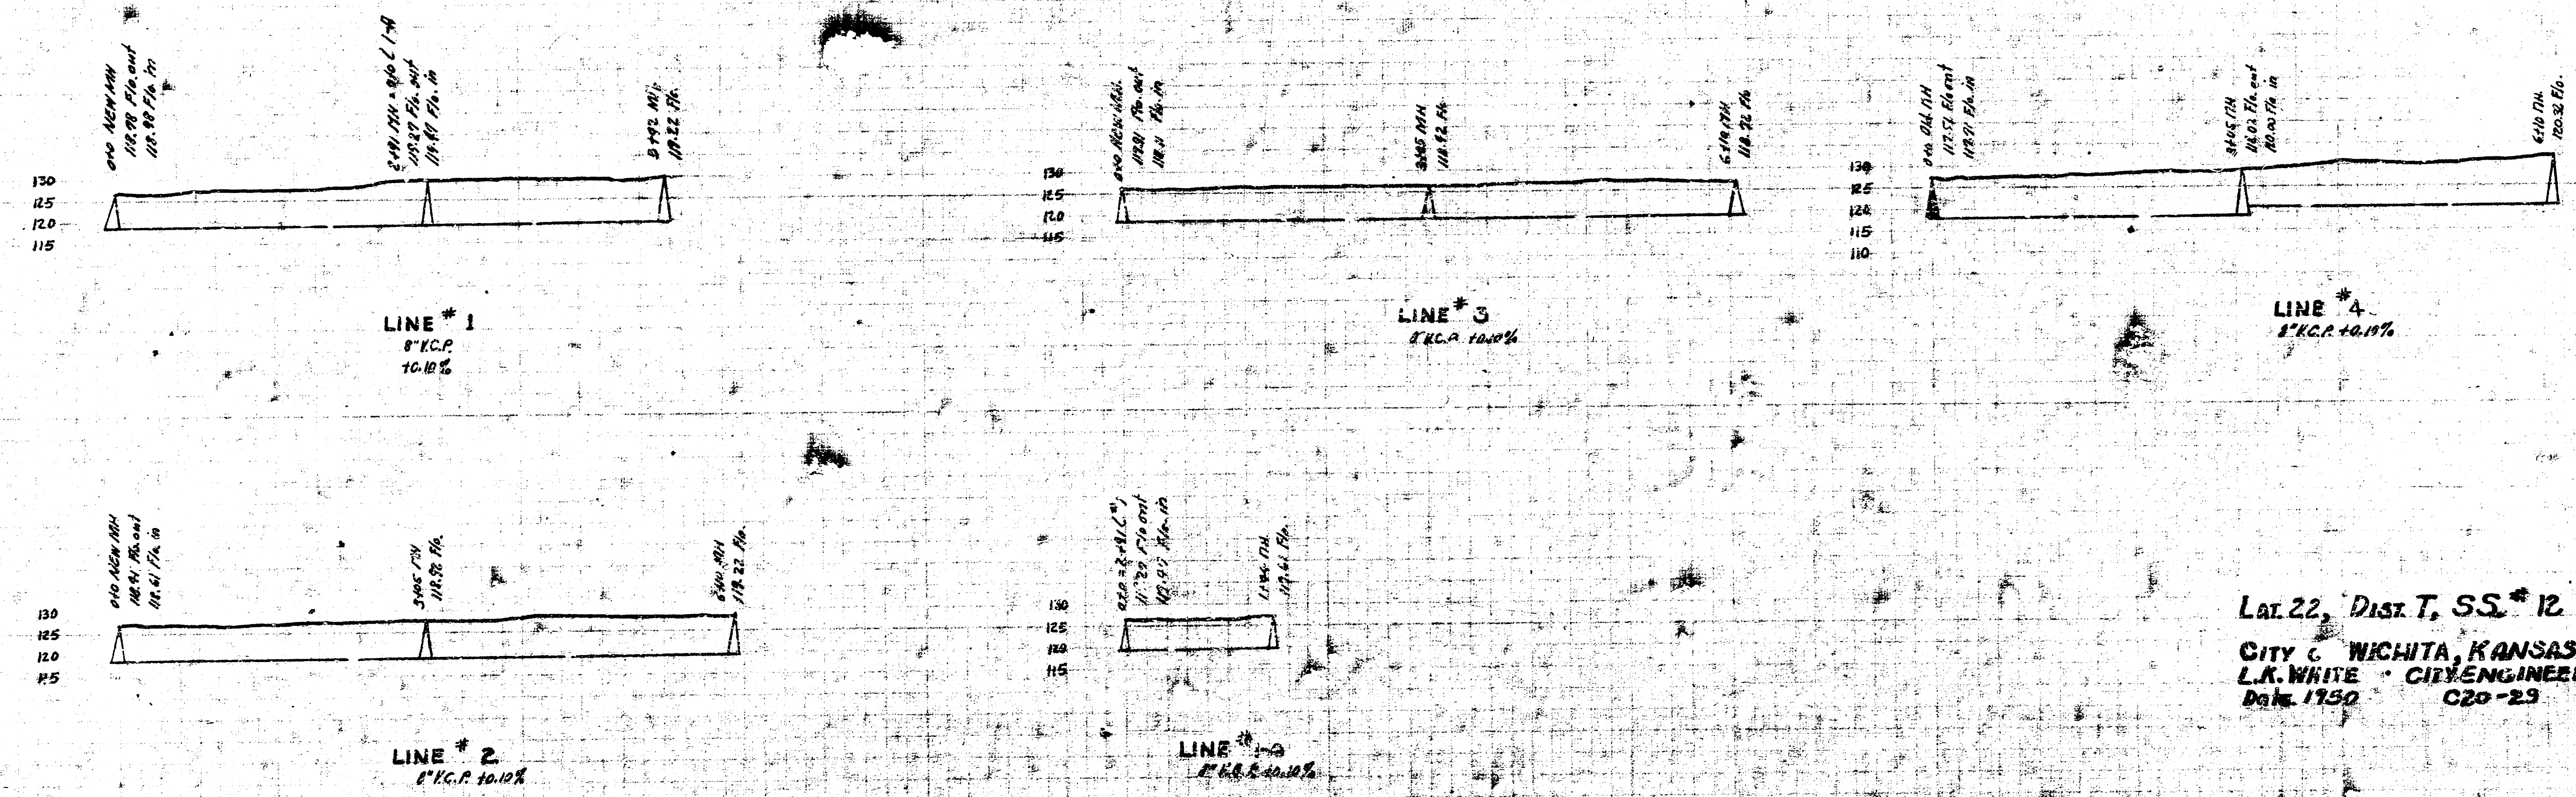

Lat. 22, Dist. T, SS. 12
CITY OF NICHITA, KANSAS
L.R. WHITE CITY ENGINEER
