




Date 7-18-52
 Drawn by L. McClain
 Checked by B. McKee
 11-24

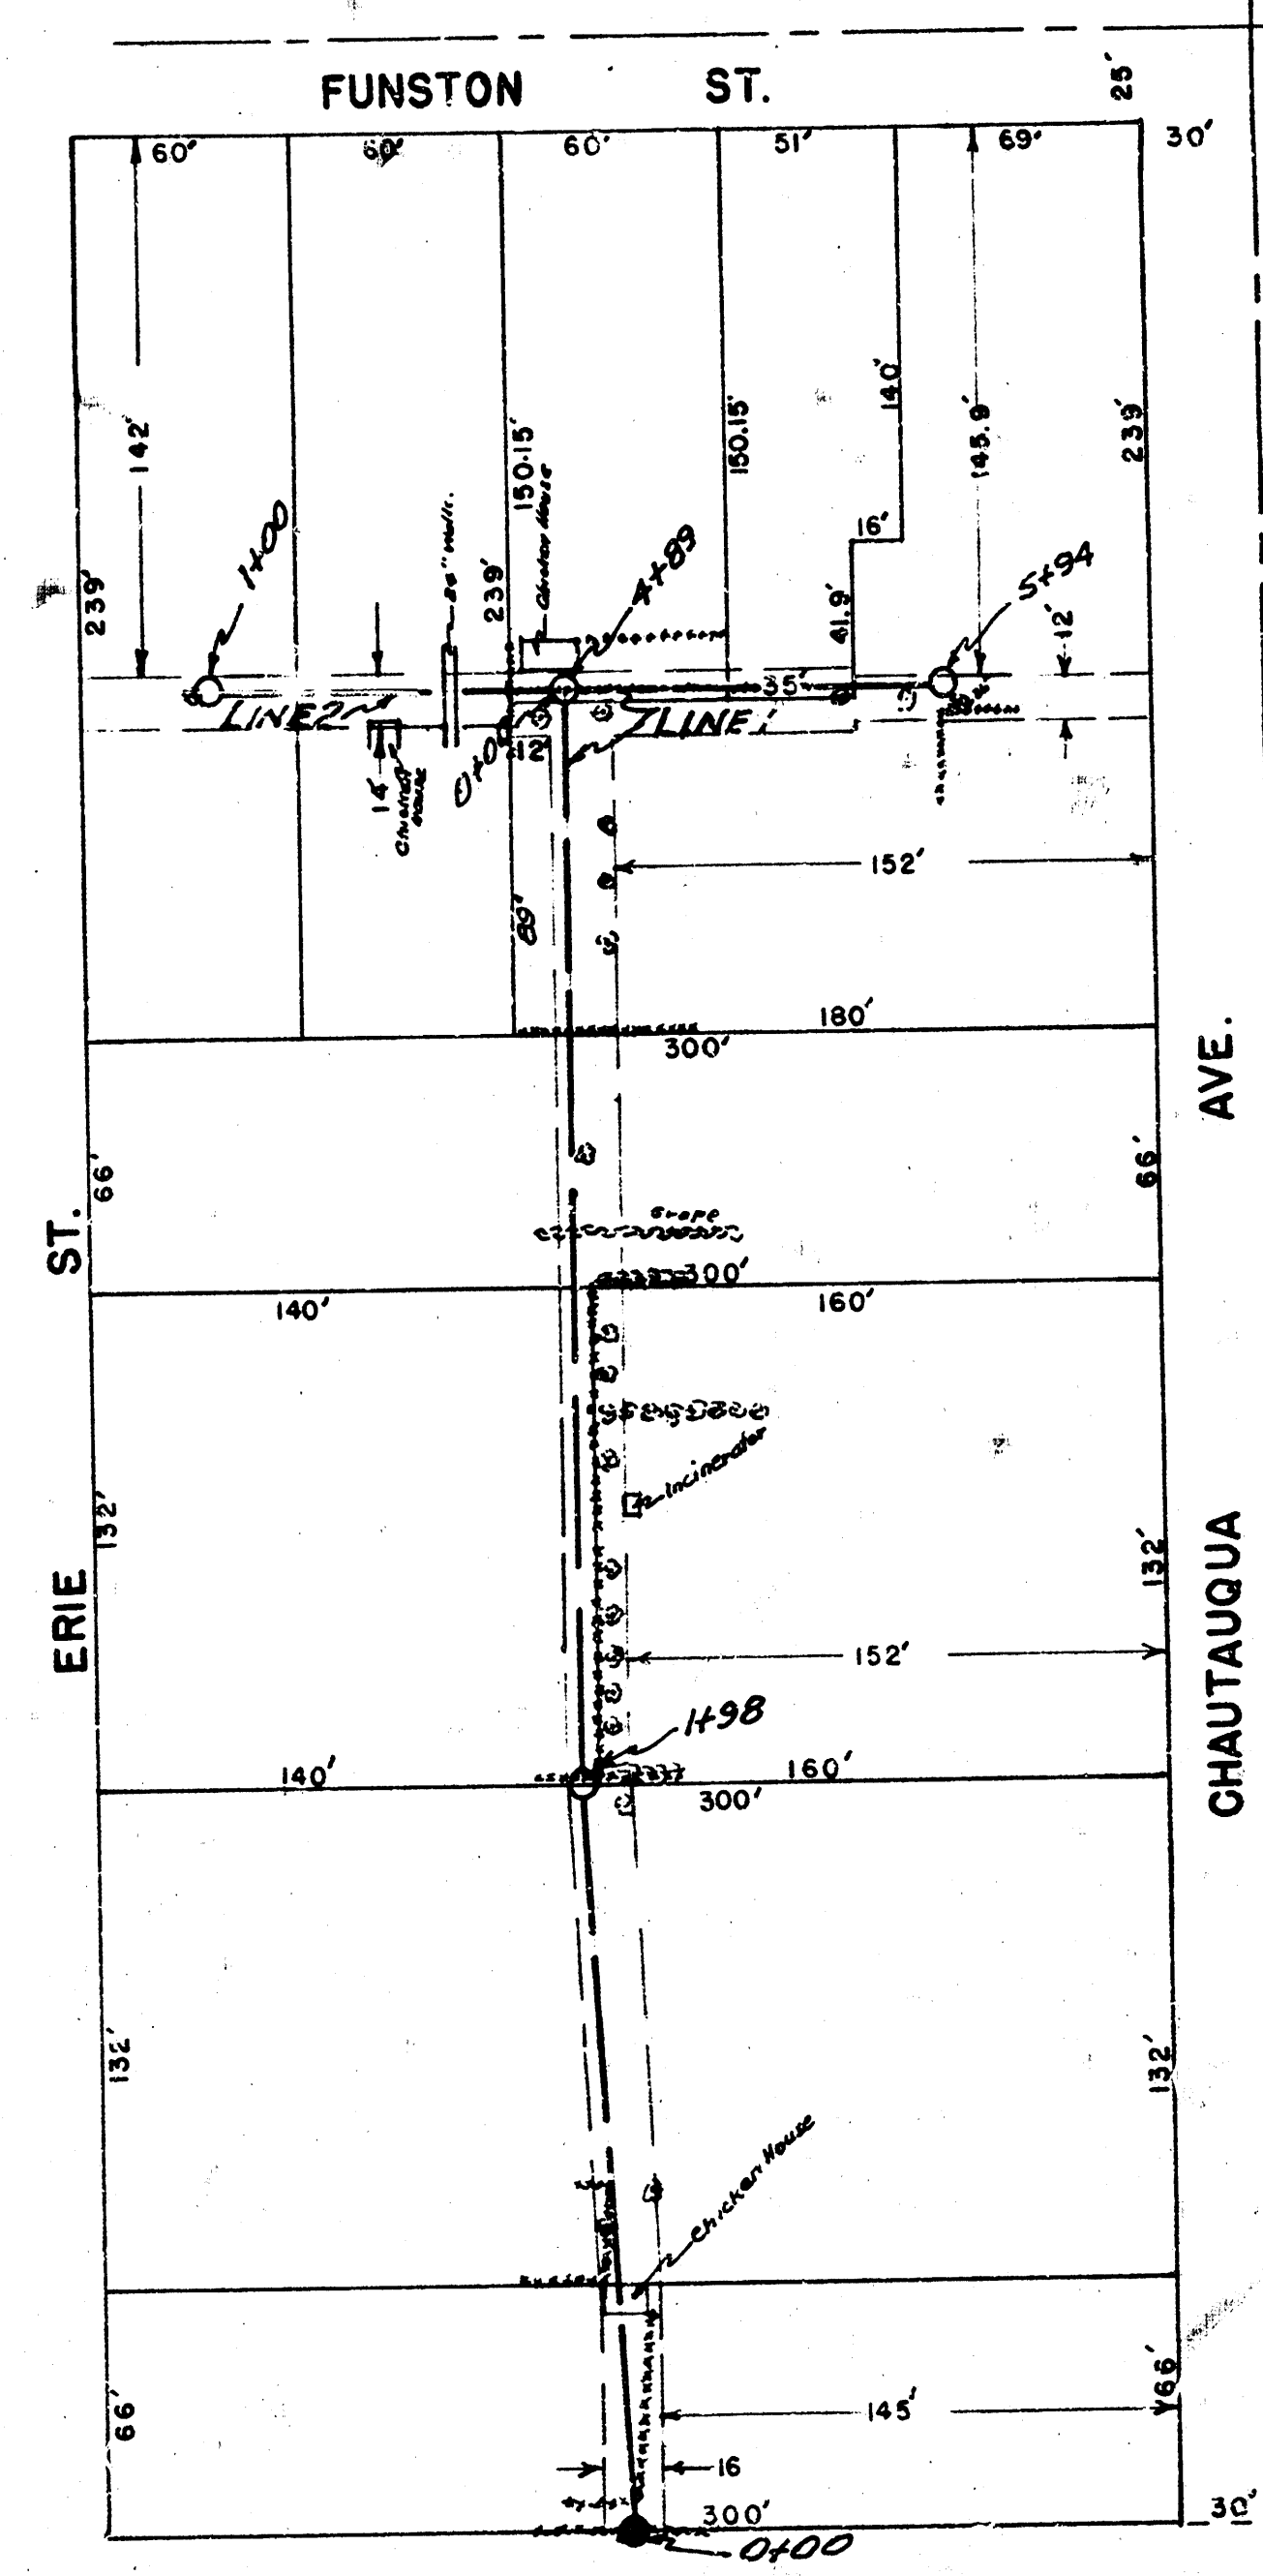


Scale 1"=50'

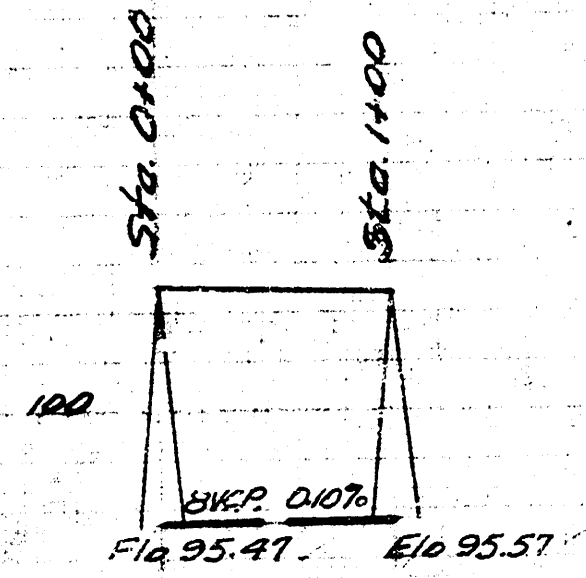


BM 100.72 Head #60 spike SW side Tel. pole #3000
 NE corner Chautauqua & Levy

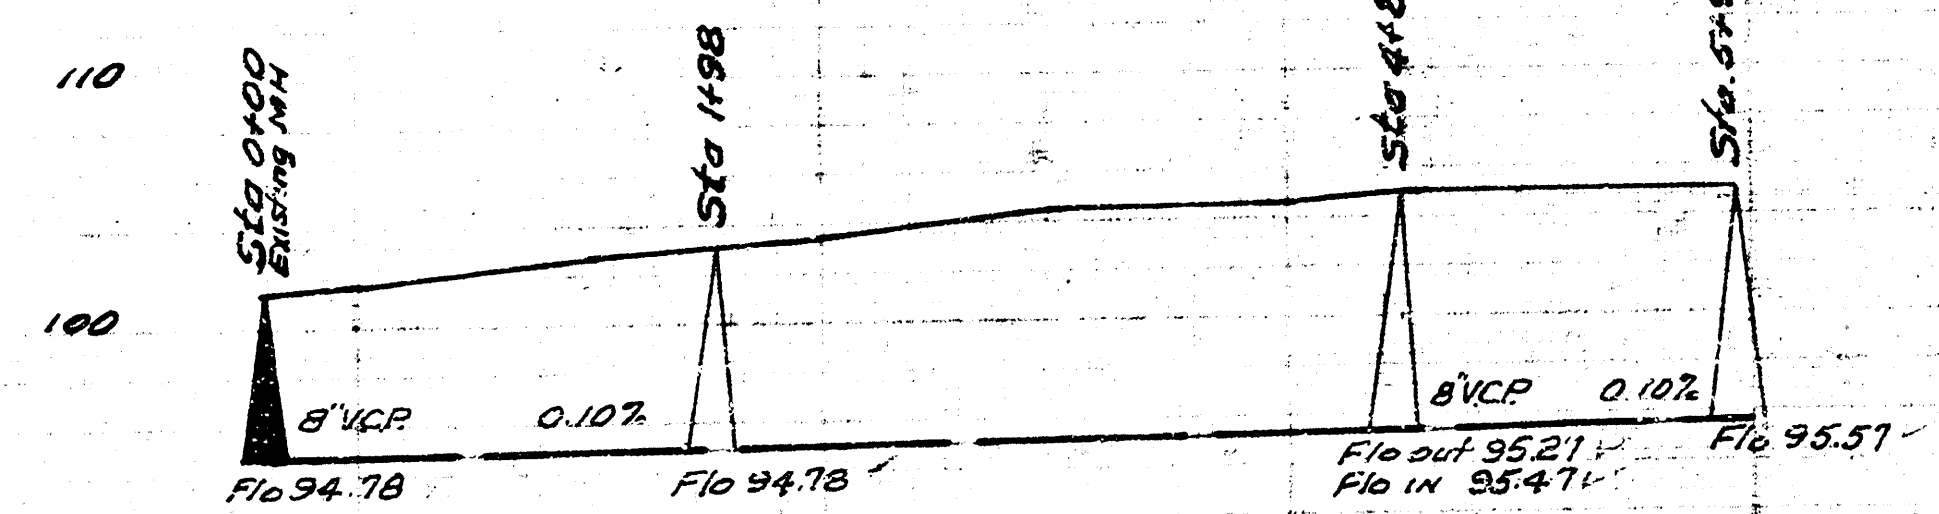

LAT 21 DCS2-5512
 CITY OF WICHITA KANSAS
 LK. WHITE CITY ENGINEER
 Proj No. C-22-44

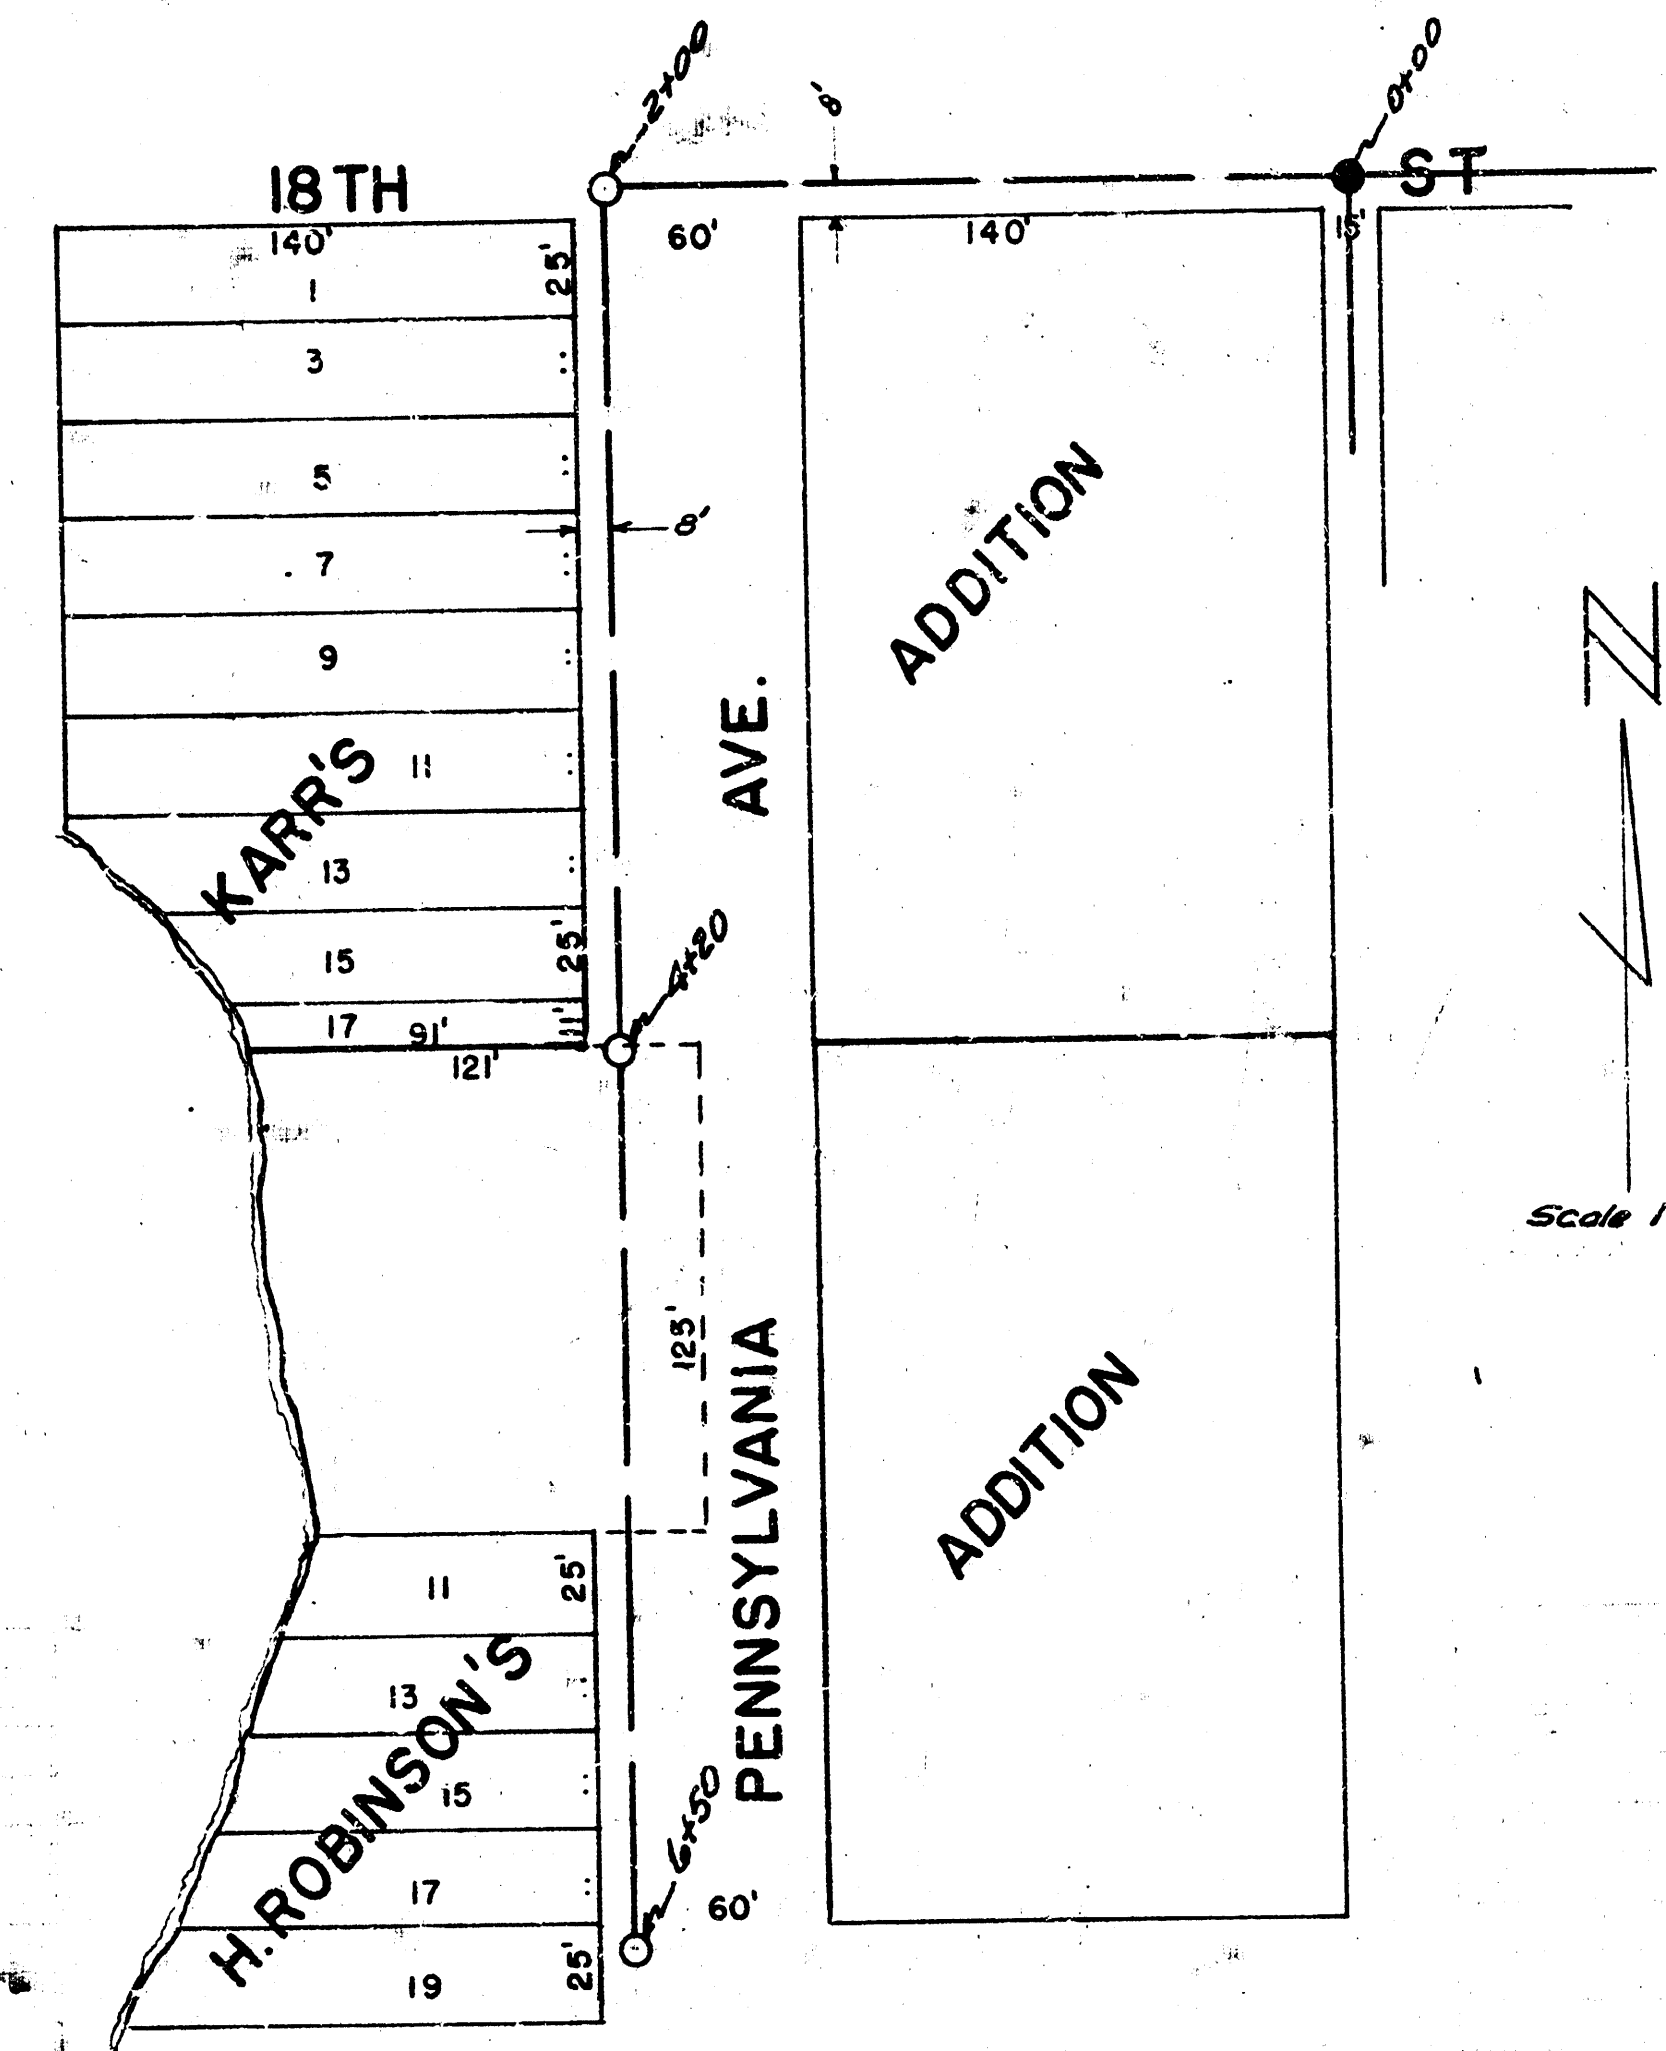

Scale 1"=50'

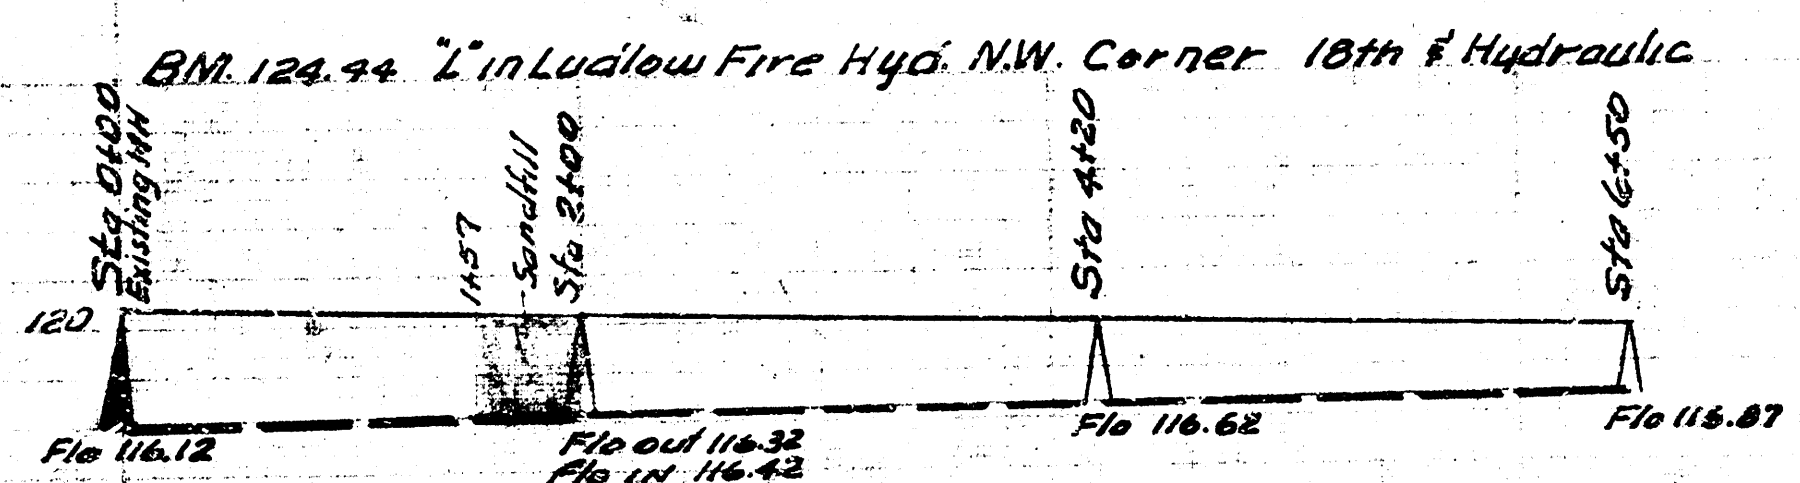

LAT 23 DIST. T. 5512
 CITY OF WICHITA KANSAS
 LK. WHITE CITY ENGINEER
 Proj No. C-20-32