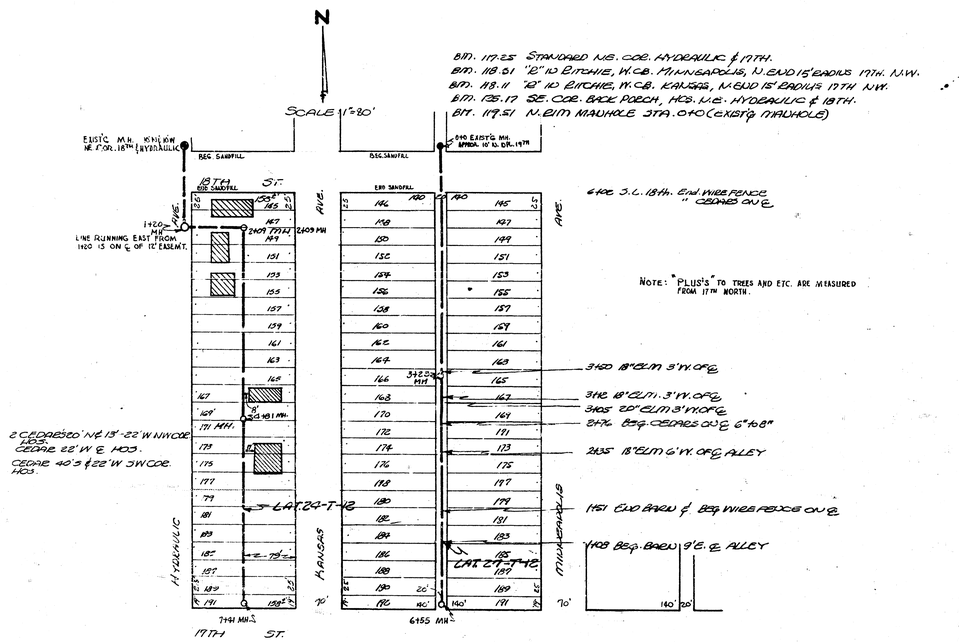

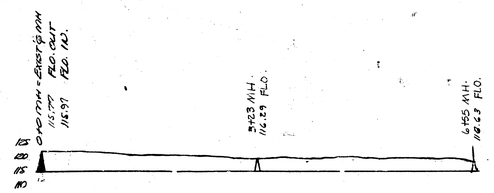

LAT. 27-T-12 to 10.10% 8" V.C.P.

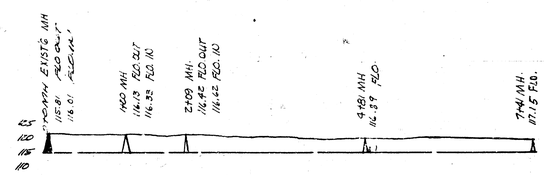

LAT. 24-T-12 to 10.10% 8" V.C.P.

LAT. 27, DIST. T, 55.12
LAT. 24, DIST. T, 55.12

CITY OF WICHITA, KANSAS
L.K. WHITE CITY ENGINEER
DATE 8-1-50